

2525 Paul E. & Mary E. Meyer  
 \* Harry Hegardt  
 Redmond, Ore. 97756

2525

**STATUS OF APPLICATION**

**DESCRIPTION OF WATER RIGHT**

**FEES PAID**

Change in Place of Use  
 Date filed May 18, 1971  
 Date of hearing \_\_\_\_\_  
 Place of hearing \_\_\_\_\_  
 Date of order 6-10-71 Vol. 21, page 128  
 Date for application of water 10-1-72  
 Proof mailed **JAN 14 1985**  
 Proof received 5-20-85  
 Certificate issued \_\_\_\_\_ Vol. \_\_\_\_\_, page \_\_\_\_\_

Name of stream Deschutes River  
 Trib. of \_\_\_\_\_ County of Deschutes  
 Use Irrigation  
 Quantity of water \_\_\_\_\_ No. of acres 4<sup>0</sup>  
 Name of ditch Pilot Butte Canal  
 Date of priority 10-31-00 & 12-2-07  
 In name of Herberta Clara Farquharson  
Deschutes Riv Adjudication, Vol. 16, page 98  
 App. No. \_\_\_\_\_ Per. No. \_\_\_\_\_ Cert. No. 29052  
 Certificate cancelled \_\_\_\_\_  
 Notation made on record by slu

Date	Amount	Receipt No.
<u>5-18-71</u>	<u>20.00</u>	<u>23619</u>
TOTAL . . .		
	\$1 Cert. Fee	

**FEES REFUNDED**

Date	Amount	Check No.



To Survey 9/29/71  
 Surveyed 8/29/84 (Hegardt)

**REMARKS**

\_\_\_\_\_  
 \_\_\_\_\_  
TO BE ENTERED WHERE CHECKED	INDEX CARDS:	
	Entered	Checked
<input checked="" type="checkbox"/> Name	<u>slu</u>	_____
<input checked="" type="checkbox"/> Stream	<u>slu</u>	_____
<input checked="" type="checkbox"/> Pt. of Div.	<u>slu</u>	_____
<input checked="" type="checkbox"/> Calendar	<u>slu</u>	_____
<input checked="" type="checkbox"/> Twp. & Rge.	<u>slu</u>	_____
<input checked="" type="checkbox"/> Decree-vault	<u>slu</u>	_____
<input checked="" type="checkbox"/> Decree-safe	<u>slu</u>	_____
<input checked="" type="checkbox"/> Cert. of W/R	<u>slu</u>	_____
<input type="checkbox"/> Per. Folder	_____	_____
<input type="checkbox"/> Chainindex	_____	_____
<input type="checkbox"/> Cross Ref.	_____	_____
<input type="checkbox"/> Power Claim	_____	_____
<input type="checkbox"/> Abstracts	_____	_____

T.15S., R.12E., W.M.

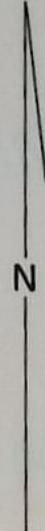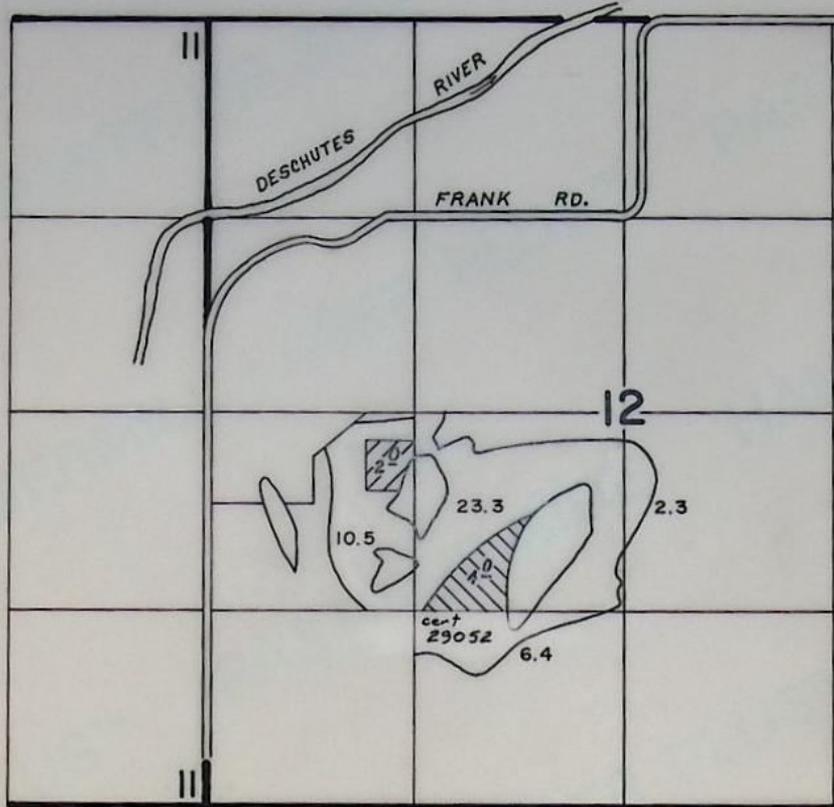

SCALE: 1" = 1320'

**FINAL PROOF SURVEY**  
UNDER



TRANSFER NO. 2525 & 3809  
Application No. .... Permit No. ....  
IN NAME OF

.....HARRY HEGARDT / C.O.I.D.....

Surveyed AUG. 29, 1984, by LESLIE OLSON.....

1966

BEFORE THE STATE ENGINEER OF OREGON

Deschutes County

IN THE MATTER OF THE APPLICATION )  
OF PAUL F. AND MARY E. MEYERS AND )  
HARRY HEGARDT (CENTRAL OREGON IR- )  
RIGATION DISTRICT) FOR THE APPROVAL )  
OF A CHANGE IN PLACE OF USE OF WATER )  
FROM DESCHUTES RIVER )  
-----

ORDER APPROVING  
TRANSFER NO. 2525

On May 18, 1971, Paul F. and Mary E. Meyers and Harry Hegardt filed an application in the office of the State Engineer for the approval of a change in place of use of water from Deschutes River, pursuant to the provisions of ORS 540.510 to 540.530.

By Decree of the Circuit Court for Deschutes County, Oregon, entered September 30, 1958, In the Matter of the Determination of the Relative Rights to the Use of the Waters of the Deschutes River and its Tributaries, a water right was established in the name of Central Oregon Irrigation District for the use of the waters of Deschutes River for the irrigation of, among other lands, 4.0 acres in SW¼ SE¼, Section 12, Township 15 South, Range 12 East, W.M., with dates of priority of October 31, 1900, and December 2, 1907, being tabulated in the name of Herbert and Clara Farquahrson as evidenced by certificate of water right recorded at page 29052, Volume 21, State Record of Water Right Certificates. These lands also have a supplemental right under permit No. 23256 to the use of the water stored in Crane Prairie Reservoir with a date of priority of February 28, 1913.

The applicants herein, owners of the lands above described, propose to transfer the water right therefrom, without loss of priority, to 4.0 acres in NE¼ SW¼, Section 12, Township 15 South, Range 12 East, W.M.

Notice by publication as provided by ORS 540.520 was not

given in connection with this application for the reason that said section provides notice is not required on an application for a change in place of use of water.

The lands involved herein are within the boundaries of the Central Oregon Irrigation District and the Board of Directors of said District approved the proposed change in place of use of water at a regular meeting held April 7, 1971.

No objections having been filed and it appearing that the proposed change in place of use of water may be made without injury to existing rights, the application should be approved.

NOW, THEREFORE, it hereby is ORDERED that the proposed change in place of use of water is approved and the water right hereinbefore described as appurtenant to 4.0 acres in SW $\frac{1}{4}$  SE $\frac{1}{4}$ , Section 12, Township 15 South, Range 12 East, W.M., with dates of priority of October 31, 1900, and December 2, 1907, be severed therefrom and simultaneously and without loss of priority transferred to 4.0 acres in NE $\frac{1}{4}$  SW $\frac{1}{4}$ , Section 12, Township 15 South, Range 12 East, W.M.

It is FURTHER ORDERED that said water so transferred shall be applied to beneficial use on or before October 1, 1972.

It is FURTHER ORDERED that upon receipt of proof satisfactory to the State Engineer of complete application of water to beneficial use on the lands to which the water is transferred hereby, certificate of water right shall be issued to Central Oregon Irrigation District at the time certificate is issued to the District confirming other transfers within the District.

Dated at Salem, Oregon, this 10<sup>th</sup> day of June, 1971.

/s/ CHRIS L. WHEELER  
State Engineer

**RECEIVED**  
 MAY 18 1971  
 STATE ENGINEER  
 SALEM, OREGON

## Application for Transfer of Water Right

To the STATE ENGINEER OF OREGON:

I, Paul F Meyers & Mary E Meyers, husband & wife and Harry Hegardt  
(Name of applicant)

of Redmond, County of Deschutes  
(Postoffice)

State of Oregon, do hereby make application for change

place of use  
(In point of diversion; place of use; use heretofore made of the water)

1. The source of present water right is Deschutes River  
(Name of stream)

2. The use to which the water is applied is Irrigation  
(Irrigation; Mining; Power; Manufacturing; etc.)

3. The name of the ditch, canal or pipe line is Pilot Butte Canal

4. The point of diversion is located \_\_\_\_\_ ft. \_\_\_\_\_ and \_\_\_\_\_ ft. \_\_\_\_\_ from the \_\_\_\_\_  
(N. or S.) (E. or W.)

corner of \_\_\_\_\_ being within the \_\_\_\_\_  
(Section or subdivision)

of Section \_\_\_\_\_ Tp. \_\_\_\_\_ R. \_\_\_\_\_ W. M., in the County of \_\_\_\_\_  
(No. N. or S.) (No. E. or W.)

5. List the number of acres irrigated in each smallest legal subdivision (40-acre tract) involved in this transfer. If for any other use, indicate place of use.

Twp.	Range	Sec.	NE 1-4				NW 1-4				SW 1-4				SE 1-4			
			NE $\frac{1}{4}$	NW $\frac{1}{4}$	SW $\frac{1}{4}$	SE $\frac{1}{4}$	NE $\frac{1}{4}$	NW $\frac{1}{4}$	SW $\frac{1}{4}$	SE $\frac{1}{4}$	NE $\frac{1}{4}$	NW $\frac{1}{4}$	SW $\frac{1}{4}$	SE $\frac{1}{4}$	NE $\frac{1}{4}$	NW $\frac{1}{4}$	SW $\frac{1}{4}$	SE $\frac{1}{4}$
15	12	12															4	

NOTE: If you own less than 40-acre tracts, attach a description of your land as it appears in your deed.

(Attach separate sheet if necessary)

6. Are you the legal owner of the above described lands? Yes  
(If not owner, explain your interest)

7. Has water been used beneficially for the purposes indicated herein during the past 5 years? Yes

8. What is the date of priority of your water right? Oct. 31, 1900 & Dec. 2, 1907

9. Was your water right acquired by State Engineer's Permit? No If so, give number  
(Yes or No)

of permit \_\_\_\_\_

10. Do you hold a water right certificate? No If so, give number of certificate 29052  
(Yes or No)

11. Was your water right determined by State Engineer's order of Determination or Decree of Court?

Yes If so, give title of proceedings Adjudication of Deschutes River  
(Yes or No)

12. Is the water right recorded in your name? Herbert & Clara Farquahrson- page 98 of decree  
(If not, give name)

13. I propose to transfer the water right to the following described lands: (Do not answer if your application is for change in point of diversion only.)

Twp.	Range	Sec.	NE 1-4				NW 1-4				SW 1-4				SE 1-4			
			NE $\frac{1}{4}$	NW $\frac{1}{4}$	SW $\frac{1}{4}$	SE $\frac{1}{4}$	NE $\frac{1}{4}$	NW $\frac{1}{4}$	SW $\frac{1}{4}$	SE $\frac{1}{4}$	NE $\frac{1}{4}$	NW $\frac{1}{4}$	SW $\frac{1}{4}$	SE $\frac{1}{4}$	NE $\frac{1}{4}$	NW $\frac{1}{4}$	SW $\frac{1}{4}$	SE $\frac{1}{4}$
15	12	12								4								

(Attach separate sheet if necessary)

NOTE: Answer questions 14, 15, 16 and 17, if the application is for change in point of diversion.

14. The proposed point of diversion is located \_\_\_\_\_ ft. \_\_\_\_\_ and \_\_\_\_\_ ft. \_\_\_\_\_ from the \_\_\_\_\_  
(N. or S.) (E. or W.)  
 corner of \_\_\_\_\_ being within the \_\_\_\_\_ of Section \_\_\_\_\_ Tp. \_\_\_\_\_ R. \_\_\_\_\_ W. M.,  
(Smallest legal subdivision) (No. N. or S.) (No. E. or W.)  
 in the county of \_\_\_\_\_ The name of the ditch to be used is \_\_\_\_\_

15. Are you the owner of the land on which the proposed point of diversion is to be located? \_\_\_\_\_

16. If not the owner of the land on which the proposed point of diversion is to be located, give the name and address of owner and submit evidence of your right-of-way for your proposed ditch, canal, or pipe line.

\_\_\_\_\_  
 \_\_\_\_\_  
 \_\_\_\_\_

17. Are there any diversions between your present point of diversion and the proposed point of diversion? \_\_\_\_\_

NOTE: Answer questions 18 and 19 if application is for change in use or place of use.

18. Are the lands from which you propose to transfer your water right free of all encumbrances, including taxes, mortgages, liens, etc.? Yes  
(Answer Yes or No)

19. If not, give below a description of existing encumbrances:

NATURE OF ENCUMBRANCE	HELD BY	AMOUNT

20. Reasons for the proposed changes are More beneficial use

\_\_\_\_\_  
 \_\_\_\_\_  
 \_\_\_\_\_

STATE ENGINEER  
 RECEIVED

AFFIDAVIT OF APPLICANT

STATE OF OREGON, }  
County of Deschutes } ss.

Harry Hegardt

I, We, Paul F. Meyer & Mary E. Meyer, husband & wife and....., the applicant herein, being first duly sworn, depose and say that I have read the above and foregoing application for transfer of water right; that I know the contents thereof and that the statements therein made are true and correct to the best of my knowledge and belief.

In Witness Whereof, I have hereunto set my hand this 9<sup>th</sup> day of March, 1971.

Paul F Meyer  
Mary E Meyer

Harry H. Hegardt  
(Name of applicant)

Subscribed and sworn to before me this 9<sup>th</sup> day of March, 1971.

[Notarial Seal]

Betty Steward  
NOTARY PUBLIC FOR OREGON

My commission expires May 28, 1973.

Remarks Approved by the Board of Directors of the Central Oregon Irrigation District at regular meeting held April 7, 1971.

THIS APPLICATION MUST BE ACCOMPANIED BY A MAP SHOWING THE LOCATION OF THE POINT OF DIVERSION, PLACE OF USE AND WORKS UTILIZED UNDER THE PRESENT WATER RIGHT. THE MAP SHOULD ALSO SHOW THE NEW POINT OF DIVERSION OR PLACE OF USE, AS THE CASE MAY BE.

RECEIVED

STATE OF OREGON MAY 20 1985

COUNTY OF

DESCHUTES

WATER RESOURCES DEPT  
SALEM, OREGON

# Proof of Appropriation of Water

Name: Harry N. Hegardt c/o Central Oregon Irrigation District

Address PO Box 548, Redmond, OR 97756

Source of Supply: Deschutes River

Permit: \_\_\_\_\_ Transfer: 2525

Tributary of: Columbia River

Amount of Water: \_\_\_\_\_

Priority Date: 10/31/1900 and 12/2/1907

Use: irrigation of 4.0 acres


Location and Point of Diversion: Pilot Butte Canal

The description of land given below and as shown on the attached map corresponds to that found to be irrigated:



4.0 acres NE $\frac{1}{4}$  SW $\frac{1}{4}$   
Section 12  
Township 15 South, Range 12 East, WM

I have read the above and foregoing proof of appropriation of water defining the extent of use of water under the change of Place of Use approved by the order of the Water Resources Director entered June 10, 1971; I know the contents thereof, and that the facts therein stated are true.

IN WITNESS WHEREOF, I have hereunto set my hand this \_\_\_\_\_ day of \_\_\_\_\_ 198 5.

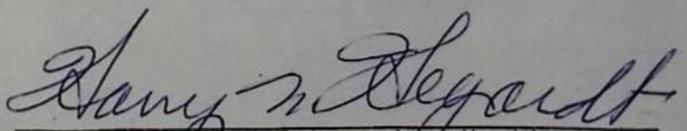  
\_\_\_\_\_  
Legal owner of the above described lands

# T.15S., R.12E., W.M.

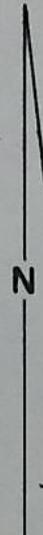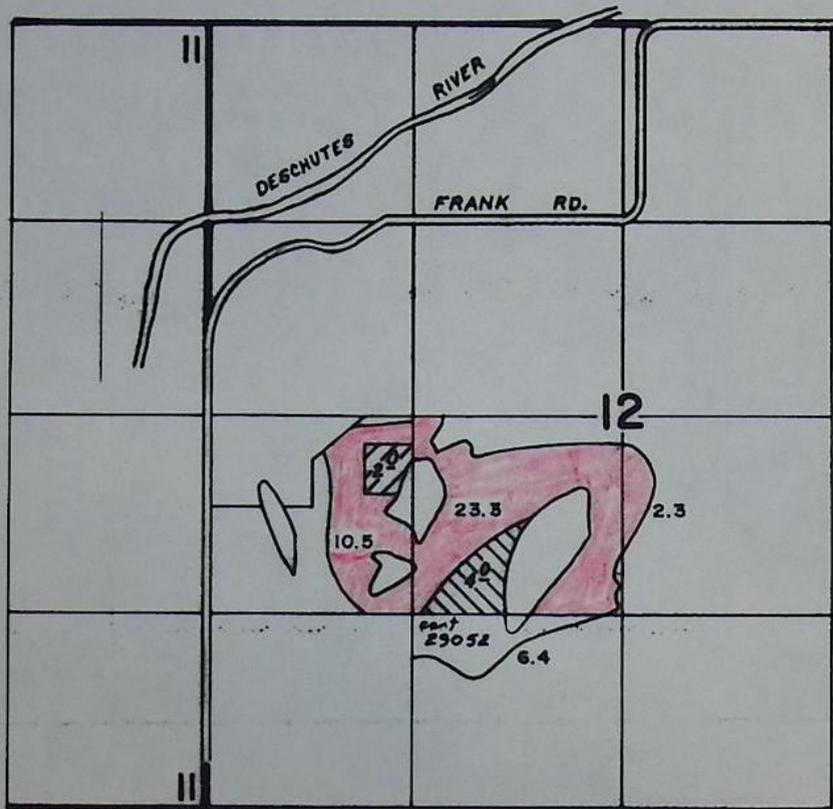

SCALE: 1" = 1320'

## FINAL PROOF SURVEY

UNDER



TRANSFER NO. 2525 & 3809

Application No. .... Permit No. ....

IN NAME OF

...HARRY HEGARDT / C.O.I.D. ....

Surveyed AUG. 29. 1984, by LESLIE OLSON...

1966



TRANSFER OF WATER RIGHTS  
CHANGE IN PLACE OF USE OF WATER

Info. Henry Hegardt

Crop Pasture


Flood irrigator all of the area below table shows  
on this application map. Also progressively  
irrigator surrounding pasture to keep the grass alive.

79-1246-15-11 and 15-12

see TR 3809

(also see 15-13)

8-29-84  
Seale Olsen  
WRE

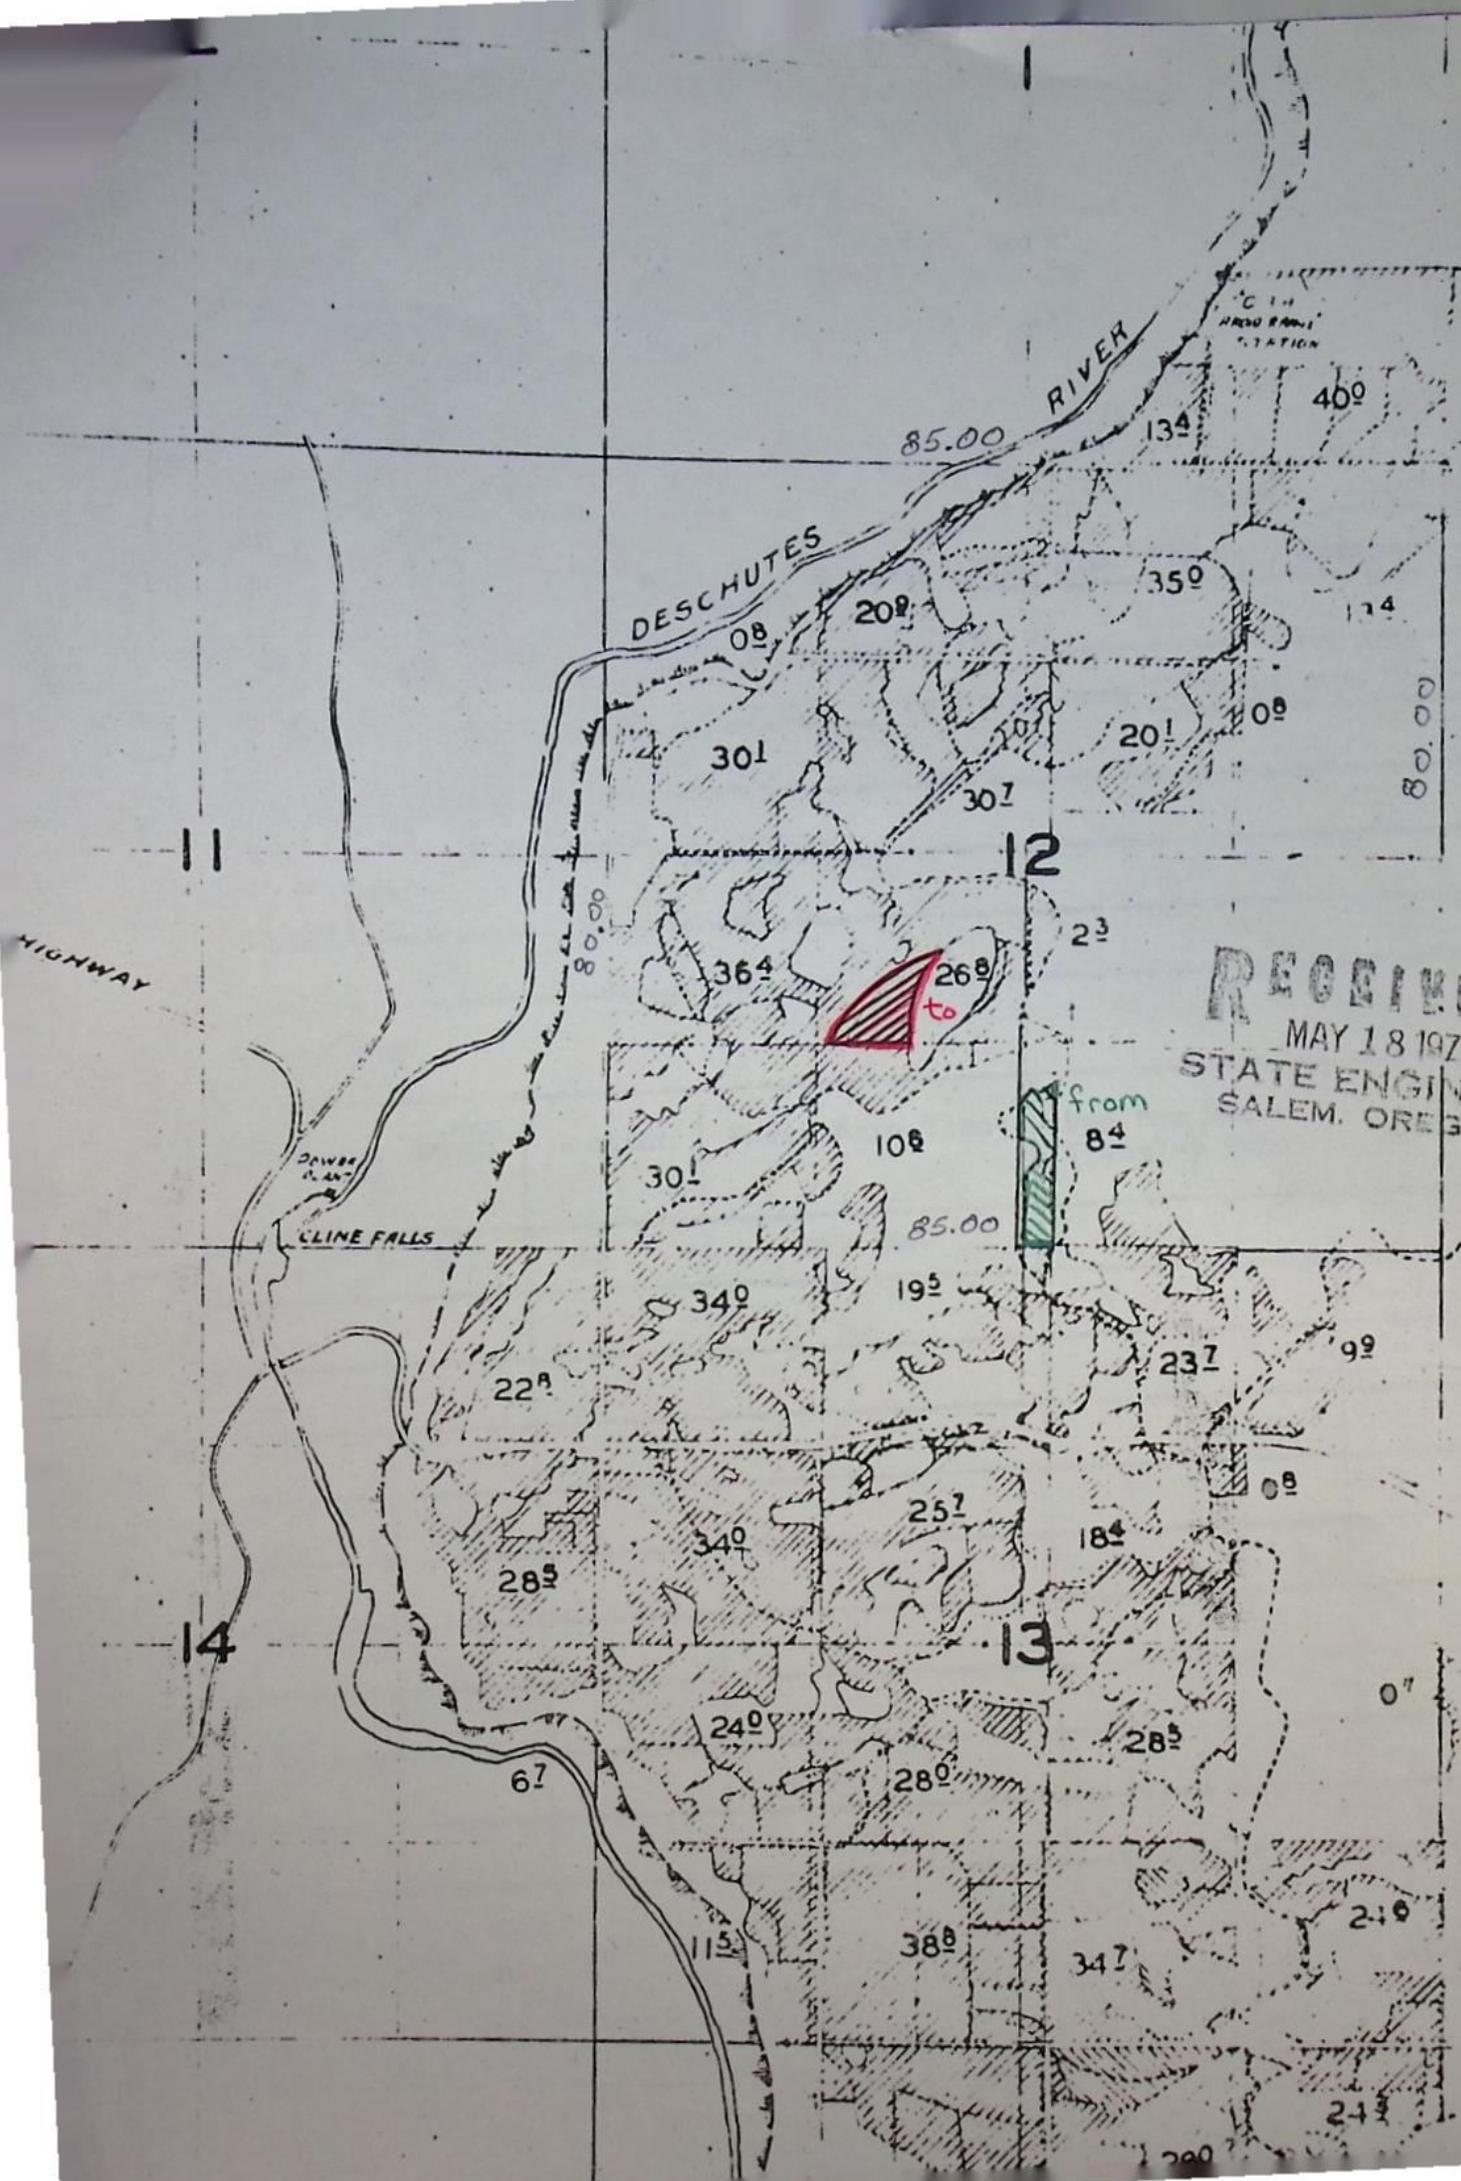

**RECEIVED**  
 MAY 18 1971  
 STATE ENGINEER  
 SALEM, OREGON

2

1

11

12

14


13

DESCHUTES RIVER

CLINE FALLS


RECEIVED  
MAY 18 1971  
STATE ENGINEER  
SALEM, OREGON

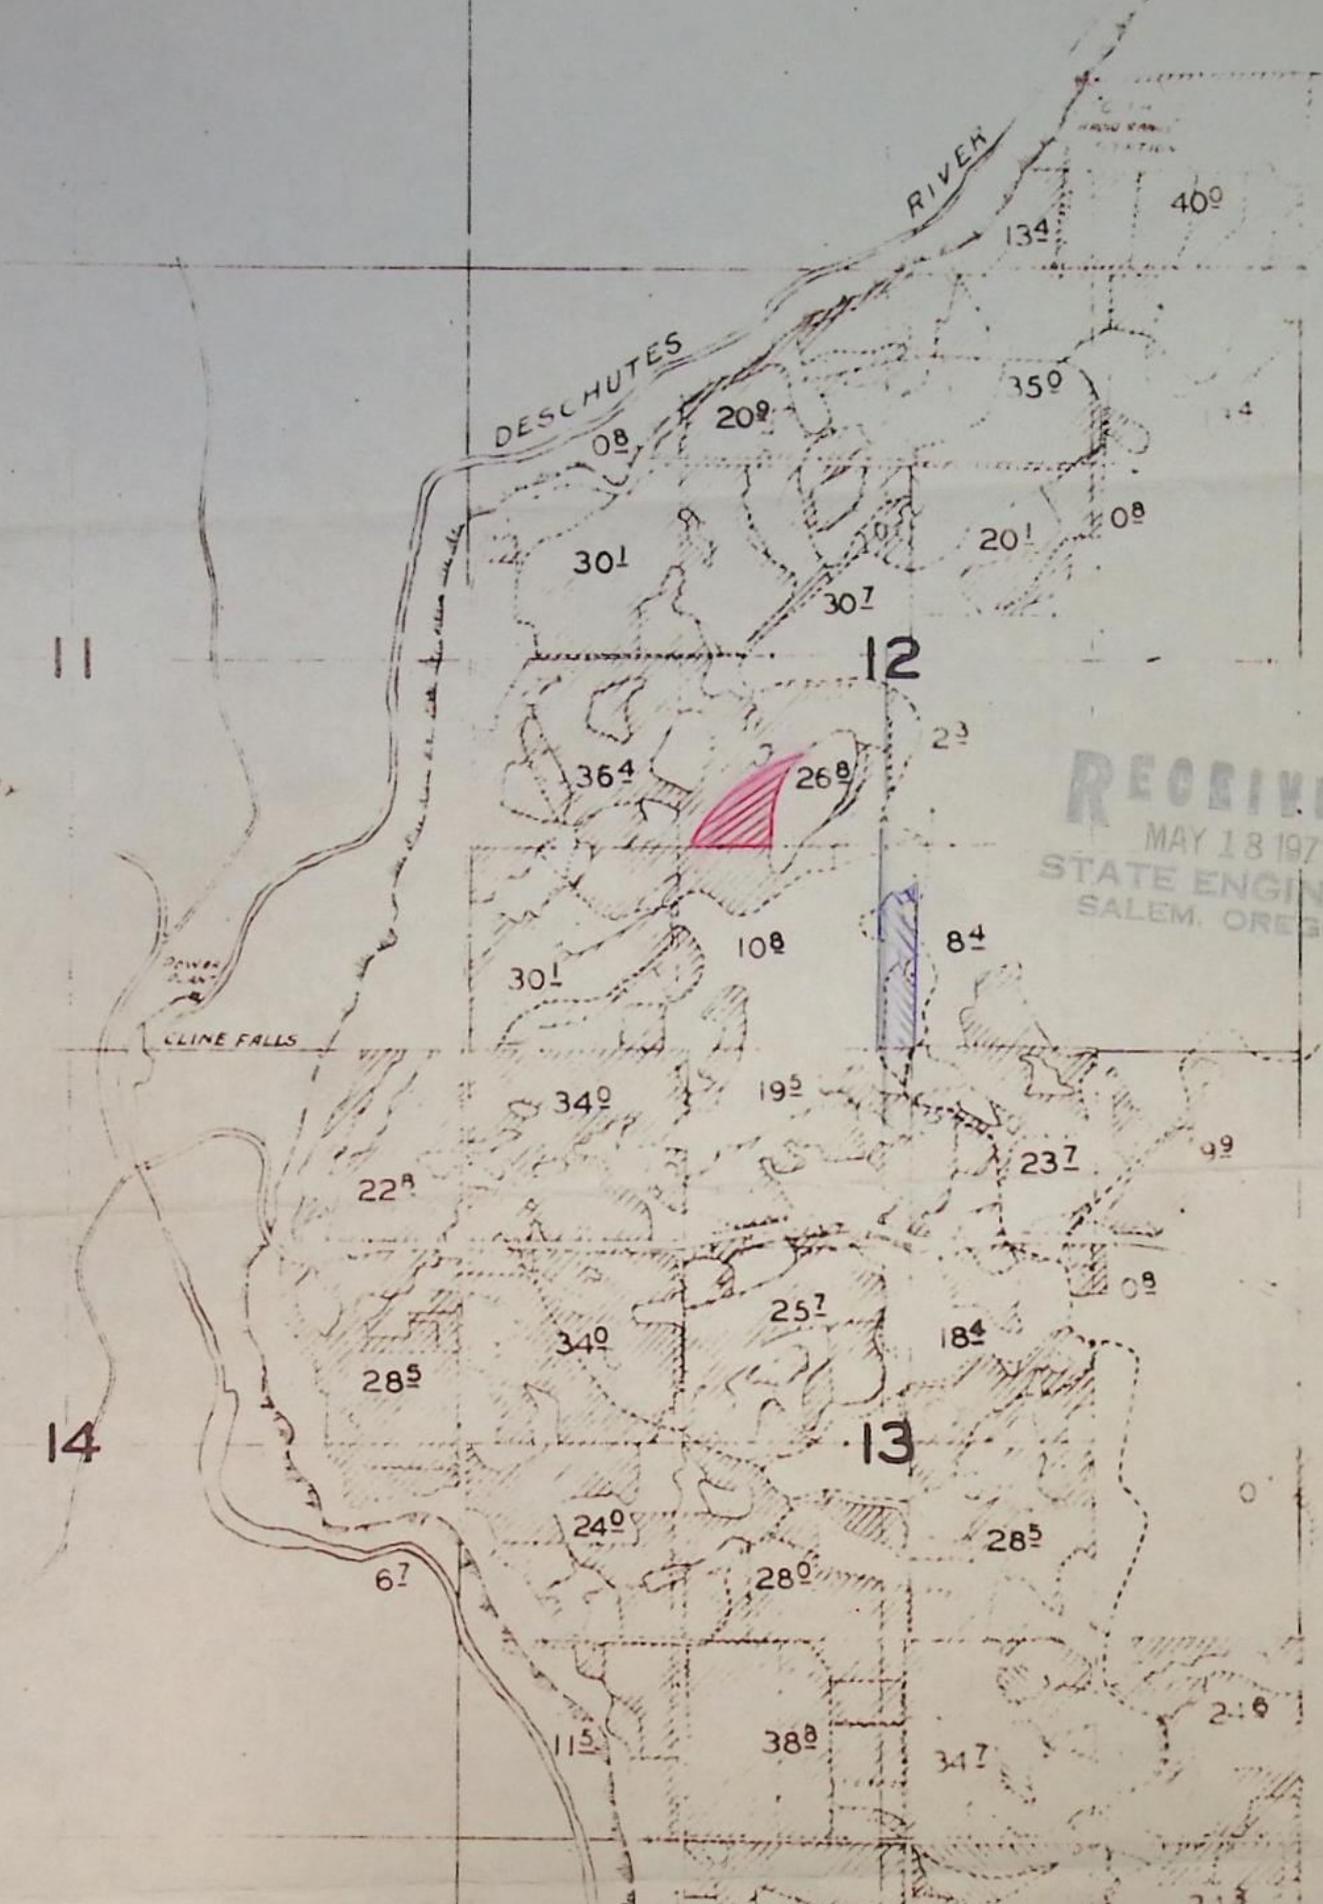



NOTICE OF COMPLETE APPLICATION  
OF WATER TO BENEFICIAL USE

Transfer No. 2525

I, HARRY N. HEGARDT hereby certify that  
on SEPT. 21, 1971, the water has been applied to the lands to  
which the water right was transferred by an order of the State Engineer  
dates June 10, 1971, approving an application for a change in place  
of use of water from \_\_\_\_\_ Deschutes River \_\_\_\_\_.

Harry N. Hegardt  
Signature

27/71  
Date

**RECEIVED**

SEP 29 1971

STATE ENGINEER  
SALEM, OREGON