


DISTRICT TRANSFER T-13509
Claim of Beneficial Use
Certificate 94882
T4S, R3W WM, Section 20
Yamhill County, Oregon

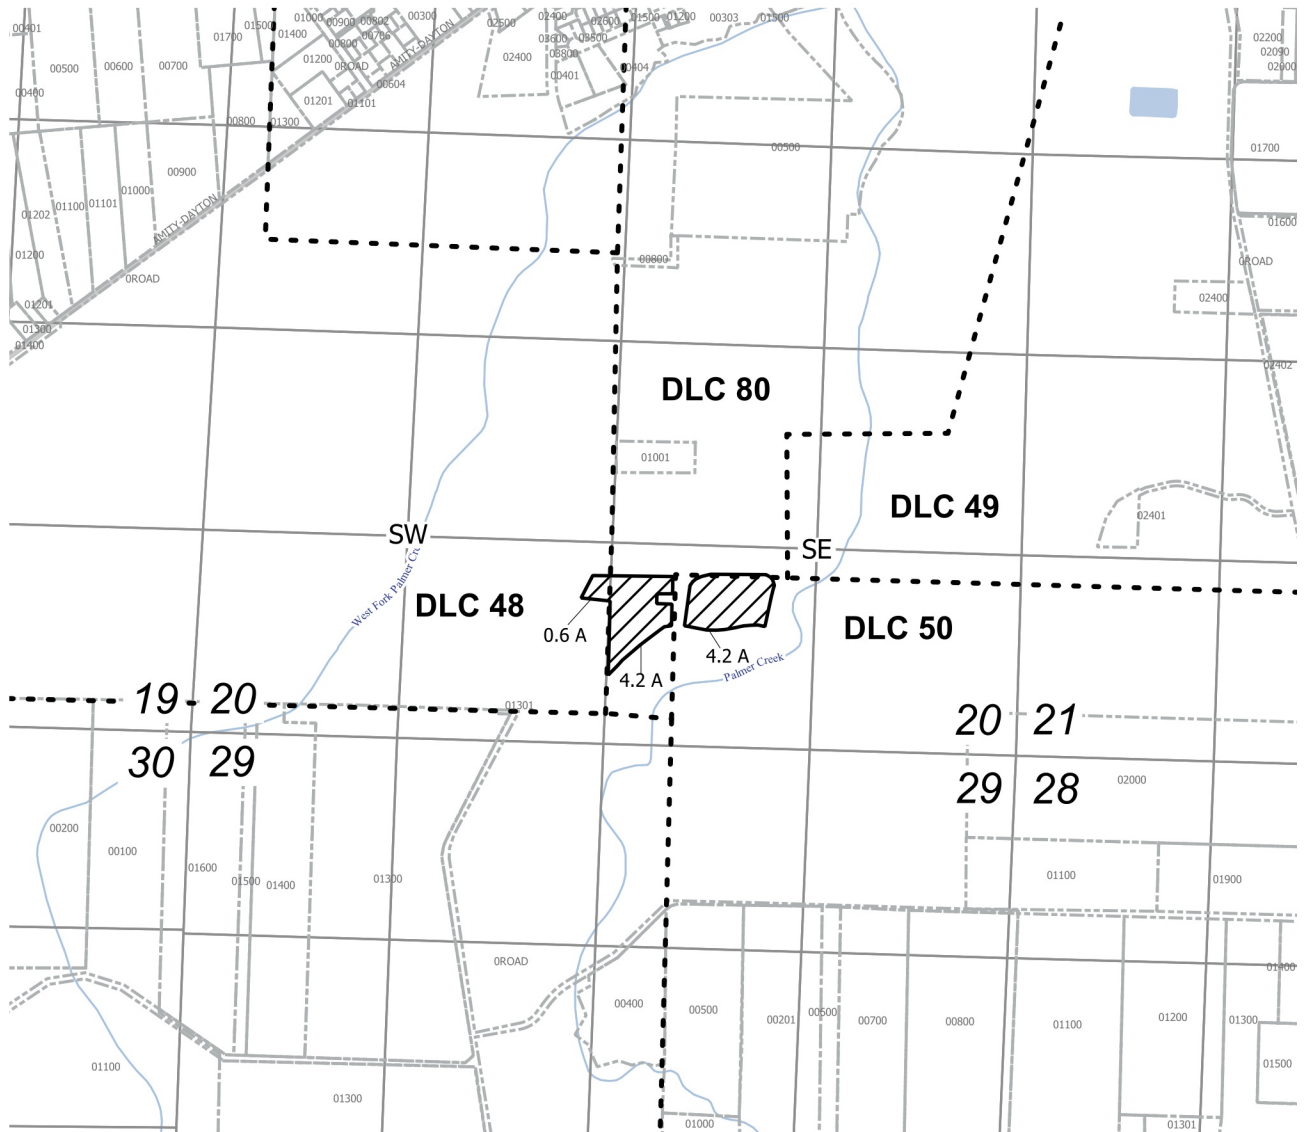

Explanation

- Streams
- Roads
- 9.0 Acres Supplemental Irrigation (Weil Farms LLC)
- Donation Land Claims
- County Tax Lots

NAD 1983 HARN/ Oregon North (ft)
Datum of 1983
Prepared June 03, 2024

Sources: BLM CadNSDI PLSS, roads, county lines & tax lots (Pacific Hydro-Geology), Oregon Spatial Data Library water features, DLC lines, et al.


This map was prepared for the purpose of identifying the location of a water right only and is not intended to provide legal dimensions or locations of a property.

EnviroLogic Resources, Inc.
ENVIRONMENTAL • WATER RESOURCES SCIENTISTS



COBU MAP T-13509
MAP 1 of 3
PALMER CREEK WATER
IMPROVEMENT DISTRICT

DISTRICT TRANSFER T-13509
Claim of Beneficial Use
Certificate 94882
T5S, R3W WM, Section 32
Yamhill County, Oregon

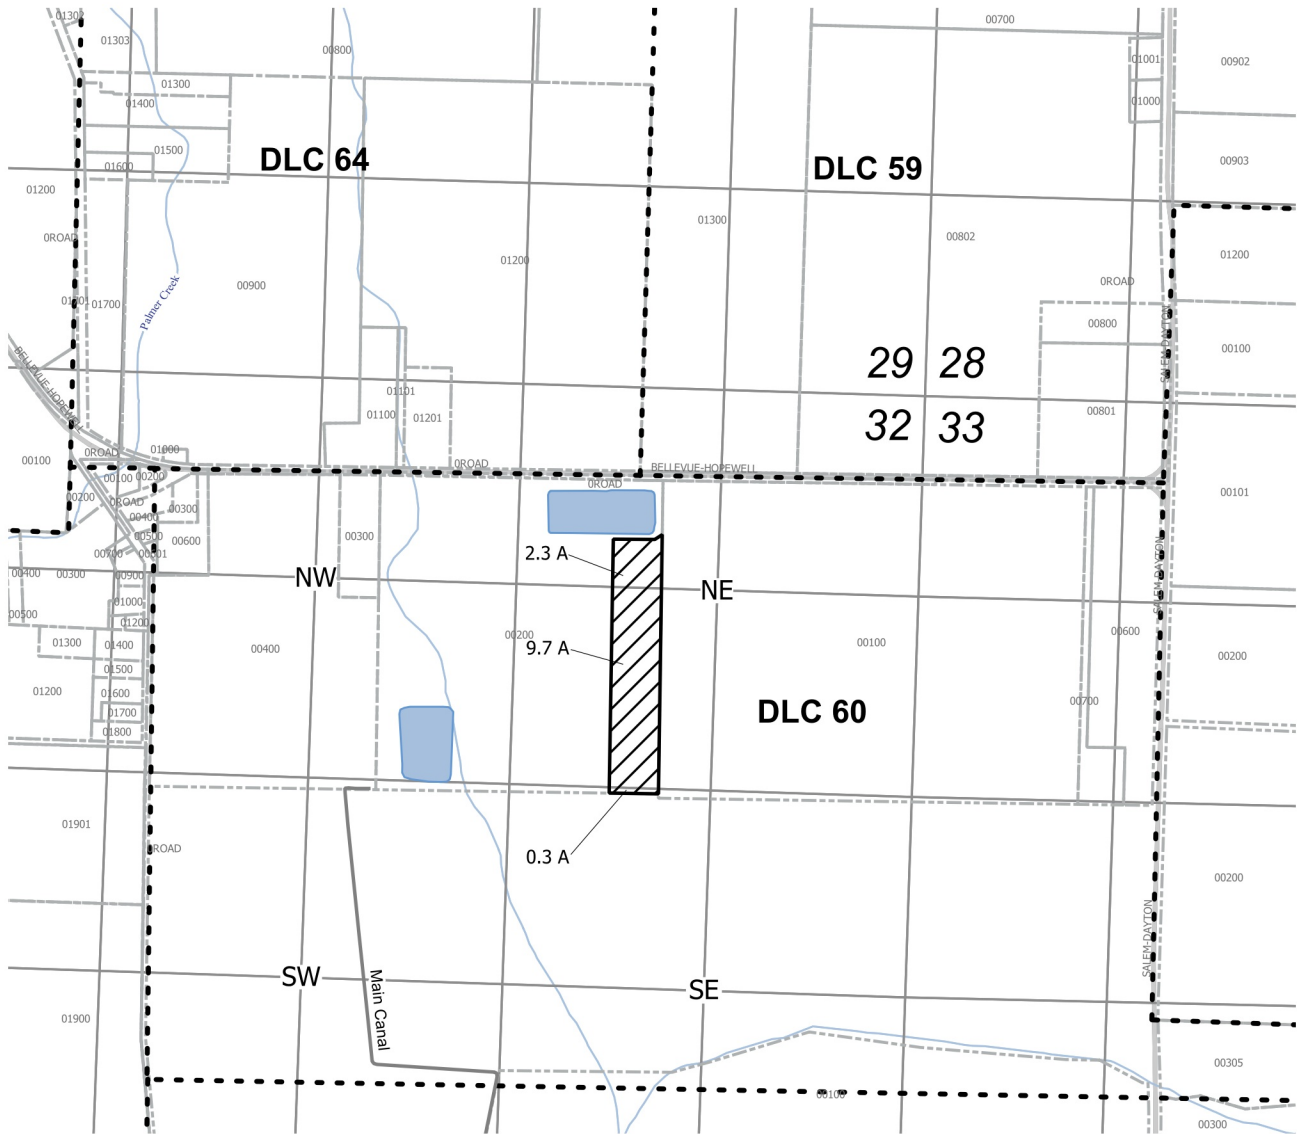

Explanation

- 12.3 Acres Supplemental Irrigation (Miersma Dairy)
- Donation Land Claims
- County Tax Lots
- Reservoir
- Streams
- Roads

0 330 660 990 1,320 ft


 1 inch = 1,320 feet

NAD 1983 HARN/ Oregon North (ft)
 Datum of 1983
 Prepared June 03, 2024

Sources: BLM CadNSDI PLSS, roads, county lines & tax lots (Pacific Hydro-Geology), Oregon Spatial Data Library water features, DLC lines, et al.
 This map was prepared for the purpose of identifying the location of a water right only and is not intended to provide legal dimensions or locations of a property.



DISTRICT TRANSFER T-13509
Claim of Beneficial Use
POD Location Certificate 94882
T6S, R3W WM, Section 4
Yamhill County, Oregon

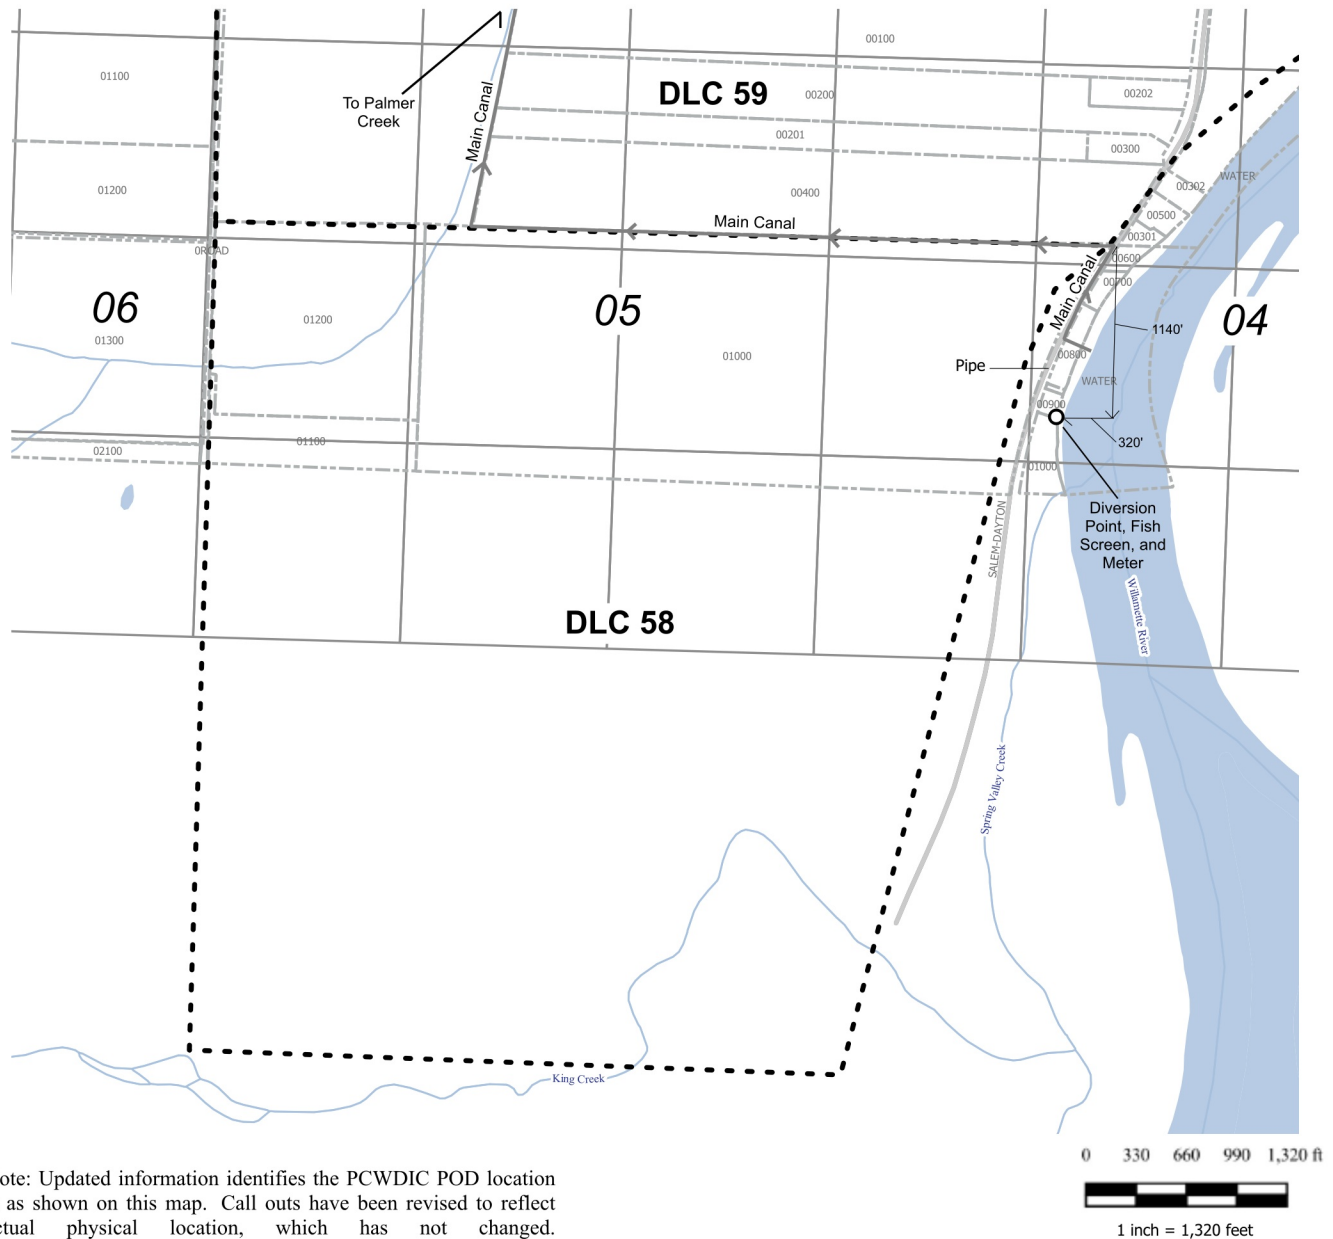

Note: Updated information identifies the PCWDIC POD location is as shown on this map. Call outs have been revised to reflect actual physical location, which has not changed. POD is located 1140 feet south and 320 feet west from the NE corner of Gay DLC 58

Explanation

- Point of Diversion (POD)
- Roads
- Streams
- Main Canal
- Donation Land Claims
- County Tax Lots

NAD 1983 HARN/ Oregon North (ft)
Datum of 1983
Prepared June 04, 2024

Sources: BLM CadNDSI PLSS, roads, county lines & tax lots (Pacific Hydro-Geology), Oregon Spatial Data Library water features, DLC lines, et al.
This map was prepared for the purpose of identifying the location of a water right only and is not intended to provide legal dimensions or locations of a property.

EnviroLogic Resources, Inc.
ENVIRONMENTAL • WATER RESOURCES SCIENTISTS



COBU MAP T-13509
MAP 3 of 3
POD LOCATION
PALMER CREEK WATER
IMPROVEMENT DISTRICT