

J. Lee Morgan & James E. Mitchell
P O Box 231
Union, Or 97883

STATUS OF APPLICATION

Change in place of use
Date filed 4-27-77
Date of hearing _____
Place of hearing _____
✓ Date of order 9-12-77 Vol. 29, page 300
Date for application of water 10-1-79
Proof mailed _____
Proof received _____
Certificate issued July 29 '88 Vol. _____, page 57412 ✓

to survey 9/77

See T#3256 & PoD - Guild United Ditches

See also T#3647 & 9

REMARKS

✓
"FINIS"

Surveyed 7-9-84

3648

DESCRIPTION OF WATER RIGHT

Name of stream Catherine Creek
Trib. of _____ County of Union
Use irrigation
Quantity of water _____ No. of acres _____
Name of ditch _____
Date of priority _____
In name of _____
_____ Adjudication, Vol. 8, page 70
App. No. _____ Per. No. _____ Cert. No. 6449
Certificate cancelled _____
Notation made on record by _____

3648
MORGAN & MITCHELL

FEES PAID

Date	Amount	Receipt No.
<u>4-27-77</u>	<u>\$ 35-</u>	<u>60092</u>
TOTAL . . .		
	No Cert. Fee	


FEES REFUNDED

Date	Amount	Check No.

TO BE ENTERED WHERE CHECKED	INDEX CARDS:		Entered	Checked
✓	Name		<u>lg</u>	_____
✓	Stream		<u>lg</u>	_____
✓	Pt. of Div.		<u>lg</u>	_____
✓	Calendar		<u>lg</u>	_____
CHECKED TO RECORDS:				
✓	Twp. & Rge.		<u>lg</u>	_____
✓	Decree-vault		<u>lg</u>	_____
✓	Decree-safe		<u>lg</u>	_____
✓	Cert. of W/R		<u>lg</u>	_____
✓	Per. Folder		<u>lg</u>	_____
✓	Chainindex		<u>lg</u>	_____
✓	Cred. Ref.		<u>lg</u>	_____
✓	Abstracts		<u>lg</u>	_____

CCB

T. 4S., R. 40E., W.M.

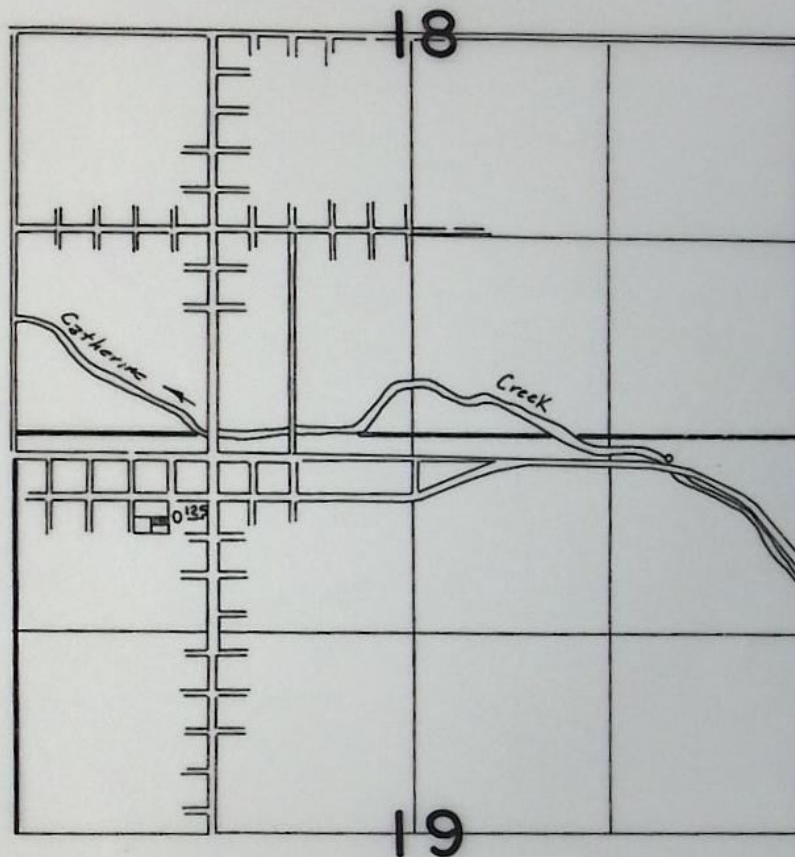

SCALE: 1" = 1320'

FINAL PROOF SURVEY
UNDER

TRANSFER 3648
IN NAME OF

.....JAMES E. MITCHELL.....

Surveyed ..7..10.... 1984., by V.L. CHURCH.....

BEFORE THE WATER RESOURCES DIRECTOR OF OREGON
UNION COUNTY

IN THE MATTER OF THE APPLICATION OF)
J. LEE MORGAN AND JAMES E. MITCHELL)
FOR APPROVAL OF A CHANGE IN PLACE OF)
USE OF WATER FROM CATHERINE CREEK)

ORDER APPROVING
TRANSFER NO. 3648

On April 27, 1977, an application was filed in the office of the Water Resources Director by J. Lee Morgan and James E. Mitchell for a change in place of use under an existing water right of record, pursuant to the provisions of ORS 540.510 to 540.530.

The certificate recorded at page 6449, Volume 6, State Record of Water Right Certificates, in the name of E. L. and Jennie McIntosh, describes a right which includes the use of water from Catherine Creek for irrigation of a certain 0.125 acres in SE $\frac{1}{4}$ NW $\frac{1}{4}$ of Section 19, Township 4 South, Range 40 East, W.M., with a date of priority of 1891.

The authorized point of diversion, pursuant to the provisions of an order of the Water Resources Director entered on December 23, 1976, approving transfer application No. 3256, is located 157.5 feet South and 1866 feet East from the North quarter corner of Section 19, being within the NE $\frac{1}{4}$ NE $\frac{1}{4}$ of Section 19, Township 4 South, Range 40 East, W.M.

The applicants herein, one of whom is the owner of the lands above described, propose to change the place of use therefrom and, without loss of priority, to irrigate in lieu thereof a certain 0.125 acres in NW $\frac{1}{4}$ NW $\frac{1}{4}$ of Section 19, Township 4 South, Range 40 East, W.M., further described as within Lot 3, Block 9, town of West Union.

Mr. H. Boyd Hadden, Watermaster, has filed a statement to the effect that the proposed change in place of use may be made without injury to existing

V29
P300-201

rights.

No objections having been filed and it appearing that the proposed change in place of use may be made without injury to existing rights, the application should be approved.

NOW, THEREFORE, it hereby is ORDERED that the requested change in place of use, as described herein, without loss of priority, is approved.

It is FURTHER ORDERED that said water so transferred shall be applied to beneficial use on or before October 1, 1979.

The order of the Water Resources Director entered on December 23, 1976, approving transfer application No. 3256 for a change in point of diversion of water for this and other water rights served through a common ditch system, provided for the cancellation of the certificate recorded at page 6449, Volume 6, State Record of Water Right Certificates, and for the issuance of a new confirming certificate upon receipt of proof satisfactory of the completion of the works so authorized.

THEREFORE, it is FURTHER ORDERED that upon proof satisfactory to the Water Resources Director of completion of works and beneficial use of water to the extent intended under the provisions of this order and the orders approving transfer applications 3256, 3647 and 3649, a confirming certificate of water right shall be issued.

Dated at Salem, Oregon, this 12th day of September, 1977.

/s/ James E. Sexson
Director