## 3498

STATUS OF APPLICATION	DESCRIPTION OF WATER RIGHT			
Change in	Name of stream Turnelo Creek et al  Trib. of County of Reschuttor Use registron  Quantity of water No. of acres 2  Name of ditch Turnelo Feel Canal  Date of priority  In name of Adjudication, Vol. page  App. No. Per. No. 19628 Cert. No. 26050  Certificate cancelled  Notation made on record by			
Surveyed 7/10/85 (Johnson)  REMARKS  Earm 130 sent JUL 27 1987 - Galance Proof not necessary — finis —				

#### FEES PAID


Date	Amount	Receipt No.
12-10-76	30.00	57180
TOTAL		
	Cert. Fee	

#### FEES REFUNDED

Date	Amount	Check No.

	INDEX CARDS:	Entered	Checked
B 47	Name	7	_
10 - W	Stream Pt. of Div.		-
S WH	CHECKED TO RE	CORDS	
WHERE	Twp. & Rge.	GLS	-
ERED	Decree-vault Decree-safe		
TER	Cert, of W/R	~	
BE EN	Chaindex		_
2	Cross Ref. Power Claim		_
-	Abstracts	~	-

# T. 16S., R.IIE., W.M.

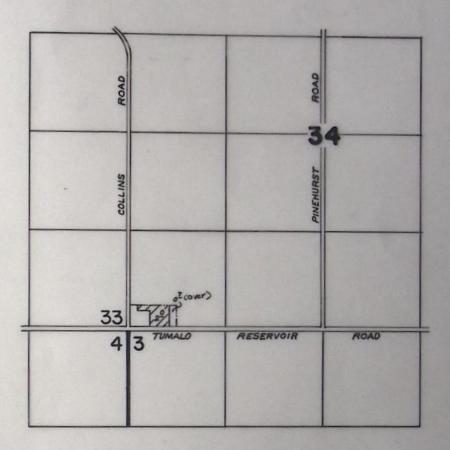

SCALE: I" = 1320'

### **FINAL PROOF SURVEY**

UNDER

TRANSFER NO. 3498 IN NAME OF

CLARENCE JOHNSON

Surveyed JULY 10. 19.85, by LESLIE OLSON...

BEFORE THE WATER RESOURCES DEPARTMENT OF OREGON
Deschutes County

IN THE MATTER OF THE APPLICATION OF BARBARA MACARTHUR (TUMALO IRRIGATION DISTRICT) FOR THE APPROVAL OF A CHANGE IN PLACE OF USE OF WATER FROM TUMALO CREEK, DESCHUTES RIVER, CRATER CREEK, LITTLE CRATER CREEK, AND THREE SPRINGS AND CRESCENT LAKE RESERVOIR

ORDER APPROVING TRANSFER NO. 3498

On December 8, 1976, Barbara MacArthur filed an application in the office of the Water Resources Director for the approval of a change in place of use of water from Tumalo Creek, Deschutes River, Crater Creek, Little Crater Creek and Three Springs and Crescent Lake Reservoir, pursuant to the provisions of ORS 540.510 to 540.530.

Certificate of water right issued to Tumalo Irrigation District and recorded at Page 25050, Volume 18, State Record of Water Right Certificates, confirms a right to the use of not to exceed 136.0 cubic feet per second of water from Tumalo Creek supplemented by the use of not to exceed 40.0 cubic feet per second of water from Crater Creek and not to exceed 34.0 cubic feet per second of water from Little Crater Creek and not to exceed 1.0 cubic foot per second from three spring branches for irrigation of, among other lands, 2.0 acres in NE4 NE4, Section 33, Township 16 South, Range 11 East, W.M., with a date of priority of October 29, 1913.

These lands also have supplemental rights evidenced by certificate recorded at Page 31412, Volume 23, State Record of Water Right Certificates, to the use of water from Deschutes River, with a date of priority of 1905; certificate recorded at Page 26051, Volume 18, State Record of Water Right Certificates, to the use of the waters of Crescent Lake Reservoir, with a date of priority of April 7, 1911; and permit No. 27841 for the use of waters of Crescent Lake Reservoir, with a date of priority of December 8, 1961.

The applicant herein, owner of the lands above described, proposes to transfer the water rights therefrom, without loss of priority, to 2.0 acres in SW4 SW4, Section 34, Township 16 South, Range 11 East, W.M.

The lands involved herein are within the boundaries of the Tumalo

Irrigation District and the Board of Directors of said District approved the

proposed change in place of use of water at a regular meeting held November 9, 1976

No objection having been filed and it appearing that the proposed change in place of use may be made without injury to existing rights, the application should be approved.

NOW, THEREFORE, it hereby is ORDERED that the requested change in place of use described herein, without loss of priority, is approved.

It is FURTHER ORDERED that said water so transferred shall be applied to beneficial use on or before October 1, 1978.

It is FURTHER ORDERED that upon receipt of proof satisfactory to the Water Resources Director of complete application of water to beneficial use on the lands to which the water is transferred hereby, certificate of water right shall be issued to Tumalo Irrigation District confirming this and prior changes within the District.

Dated at Salem, Oregon, this 28th day of December, 1976.

JAMES E. SEXSON Director