

Name Wild Horse Ranch, Inc.

% By Laverne M. Johnson

Address P.O. Box 907

Corvallis, OR 97330

Change in POU

Date filed Dec. 14, 1977

Date of hearing _____

Place of hearing _____

Date of order 2-23-78 Vol. 30, page 429

Date for application of water 10-1-79

Proof mailed _____

Proof received _____

Certificate issued APR 12 1978 Vol. 37, page 45388

7-21-05

to survey

3850

DESCRIPTION OF WATER RIGHT

Name of stream Stonehouse Creek

Trib. of _____ County of Harney

Use _____

Quantity of water _____ No. of acres 18.0

Name of ditch _____

Date of priority 1886

In name of John Henry Penland

Wildhorse Cr. Adjudication, Vol. 15, page 371

App. No. _____ Per. No. _____ Cert. No. 20924 v.15

81542

Certificate cancelled _____

Notation made on record by _____

FEES PAID

Date	Amount	Receipt No.
<u>12-14-77</u>	<u>\$ 30.00</u>	<u>258</u>
TOTAL . . .		
<u>2-15-78</u>	<u>\$2 Cert. Fee</u>	<u>1131</u>

FEES REFUNDED

Date	Amount	Check No.

REMARKS



MAP IN APP G-3379

W.R.I.S.	
Assembled <u>6-28-85</u> by <u>SR</u>	
Entered _____ by _____	
Verified _____ by _____	

	INDEX CARDS:	
	Entered	Checked
☒ Name	<u>lg</u>	_____
☒ Stream	<u>lg</u>	_____
☐ Pt. of Div.	_____	_____
☒ Calendar	<u>lg</u>	_____
CHECKED TO RECORDS:		
☒ Twp. & Rpt.	<u>lg</u>	_____
☒ Decree-vault	<u>lg</u>	<u>lg</u>
☒ Decree-safe	<u>lg</u>	_____
☒ Cert. of W/R	<u>lg</u>	_____
☒ Per. Folder	_____	_____
☐ Chaindex	_____	_____
☐ Cross Ref.	_____	_____
☒ Power Claim	_____	_____
☒ Abstracts	<u>lg</u>	_____

CC: T3850	
WA	
DC	
WM #10	
Steve Applegate	
Original - applicant	
7-21-05	

T.35S., R.33E., W.M.

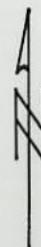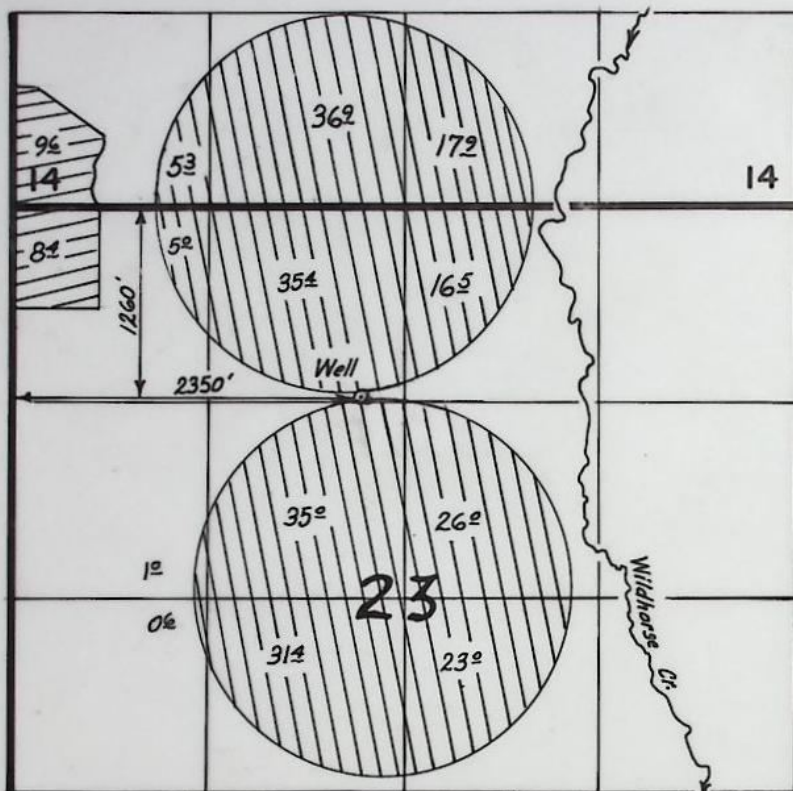

Scale : 1" = 1320'

FINAL PROOF SURVEY

UNDER

TRANSFER 3850

Application No. G-8379 Permit No. G-8052...

IN NAME OF

.....WILD HORSE RANCH, INC.....

Surveyed ...7-17... 1988, by Vern Church.....



P# G-8052



Transfer 3850

STATE OF OREGON

COUNTY OF HARNEY

CERTIFICATE OF WATER RIGHT

THIS CERTIFICATE ISSUED TO

WILD HORSE RANCH, INC.
ANDREWS STAR ROUTE
BURNS, OREGON 97720

confirms the right to use the waters of STONEHOUSE CREEK, a tributary of WILDHORSE CREEK, for the purpose of IRRIGATION.

The right has been confirmed by decree of the Circuit Court of the State of Oregon for HARNEY County. The decree is of record at Salem, in the Order Record of the WATER RESOURCES DIRECTOR, in Volume 15, at page 331. The date of priority is 1886.

The right is limited to not more than 0.3 CUBIC FOOT PER SECOND.

The point of diversion is located as follows:

NW 1/4 SE 1/4, SECTION 15, TOWNSHIP 35 SOUTH, RANGE 33 EAST,
W.M.; 500 FEET SOUTH AND 820 FEET EAST FROM THE CENTER 1/4
CORNER, SECTION 15.

The amount of water used for irrigation, together with the amount secured under any other right existing for the same lands, shall be limited to ONE-SIXTIETH of one cubic foot per second per acre, or its equivalent for each acre irrigated and shall be further limited to a diversion of not to exceed 2.5 acre-feet per acre for each acre irrigated during the irrigation season of each year.

A description of the place of use under the right, and to which such right is appurtenant, is as follows:

SW 1/4 SW 1/4 9.6 ACRES
SECTION 14
TOWNSHIP 35 SOUTH, RANGE 33 EAST, W.M.


This is a final order in other than a contested case. This order is subject to judicial review under ORS 183.484. Any petition for judicial review must be filed within the 60 day time period specified by ORS 183.484(2). Pursuant to ORS 536.075 and OAR 137-004-0080 you may either petition for judicial review or petition the Director for reconsideration of this order. A petition for reconsideration may be granted or denied by the Director, and if no action is taken within 60 days following the date the petition was filed, the petition shall be deemed denied.

NW 1/4 NW 1/4 8.4 ACRES
SECTION 23
TOWNSHIP 35 SOUTH, RANGE 33 EAST, W.M.

This certificate is issued to confirm a change in PLACE OF USE approved by an order of the Water Resources Director entered FEBRUARY 23, 1978, and together with certificate 45388, supersedes certificate 20924, State Record of Water Right Certificates.

The right to the use of the water for the above purpose is restricted to beneficial use on the lands or place of use described and shall be subject to all other conditions and limitations contained in said decree.

Issued July 21, 2005.

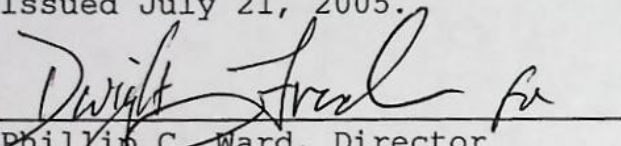
Phillip C. Ward, Director
Water Resources Department



Recorded in State Record of Water Right Certificates Number 81542.

T-3850.VG

BEFORE THE WATER RESOURCES DIRECTOR OF OREGON

HARNEY COUNTY

IN THE MATTER OF THE APPLICATION OF)
WILD HORSE RANCH, INC., BY JOHN S.)
BRANDIS, PRESIDENT, FOR APPROVAL OF)
A CHANGE IN PLACE OF USE OF WATER)

ORDER APPROVING
TRANSFER NO. 3850

On December 14, 1977, an application was filed in the office of the Water Resources Director by Wild Horse Ranch, Inc., by John S. Brandis, President, for approval of a change in place of use of water from Stonehouse Creek, pursuant to the provisions of ORS 540.510 to 540.530.

The certificate recorded at page 20924, Volume 15, State Record of Water Right Certificates, in the name of John Henry Penland, describes a right which includes the use of not to exceed 0.3 cubic foot per second from Stonehouse Creek for irrigation of a certain 5.0 acres in SW $\frac{1}{4}$ SW $\frac{1}{4}$ and 13.0 acres in SE $\frac{1}{4}$ SW $\frac{1}{4}$ of Section 14, Township 35 South, Range 33 East, W.M., with a date of priority of 1886.

Water for the said right is diverted from a point located 500 feet South and 820 feet East from the Center Corner of Section 15, being within the NW $\frac{1}{4}$ SE $\frac{1}{4}$ of Section 15, Township 35 South, Range 33 East, W.M.

The applicant herein proposes to change the place of use therefrom and, without loss of priority, to irrigate in lieu thereof a certain 6.0 acres in SW $\frac{1}{4}$ SW $\frac{1}{4}$ of Section 14, and 12.0 acres in NW $\frac{1}{4}$ NW $\frac{1}{4}$ of Section 23, Township 35 South, Range 33 East, W.M.

Mr. William H. Beal, Watermaster, has filed a statement to the effect that the proposed change in place of use may be made without injury to existing rights.


No objections having been filed and it appearing that the proposed change in place of use may be made without injury to existing rights, the application should be approved.

NOW, THEREFORE, it hereby is ORDERED that the requested change in place of use, as described herein, without loss of priority, is approved.

It is FURTHER ORDERED that the said water so transferred shall be applied to beneficial use on or before October 1, 1979.

It is FURTHER ORDERED that the certificate of water right heretofore issued to John Henry Penland and recorded at page 20924, Volume 15, State Record of Water Right Certificates, is canceled, and in lieu thereof a new certificate be issued covering the balance of the right NOT involved in this proceeding, and upon proof satisfactory to the Water Resources Director of completion of works and beneficial use of water to the extent intended under the provisions of this order, a confirming certificate of water right shall be issued to the applicant herein.

Dated at Salem, Oregon, this 23rd day of February, 1978.

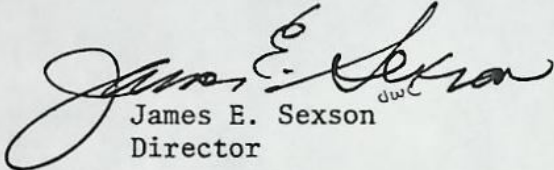
James E. Sexson
Director

W/D