

3235

STATUS OF APPLICATION

Change in point of diversion
 Date filed 5-23-75
 Date of hearing 3-30-76
 Place of hearing Jessil
 Date of order 10-6-76 Vol. 27, page 488
 Date for application of water 10-1-77
 Proof mailed _____
 Proof received _____
 Certificate issued JAN 19 1979 Vol. 40, page 47232

Survey 11/76

DESCRIPTION OF WATER RIGHT

Name of stream John Day River
 Trib. of _____ County of Wheeler
 Use irrigation
 Quantity of water 1.54 ~~0.37~~ No. of acres 76 ~~814~~
 Name of ditch _____
 Date of priority Jan 19, 1959 ~~Aug 21, 1962~~
 In name of William L. Chapman
 _____ Adjudication, Vol. _____, page _____
 App. No. 32846 Per. No. 26002 Cert. No. 30235
 Certificate cancelled _____
 Notation made on record by _____

FEES PAID

Date	Amount	Receipt No.
5-23-75	30.00	47007
1-6-76	45.00 p.o.n.	50968
3-17-76	25.59 p.o.n.	52000
TOTAL . . .		
3-17-76	4.00 Cert. Fee	52001

FEES REFUNDED

Date	Amount	Check No.
5-25-77	2.00	3438

REMARKS


See 32846
See T-5276 A POD part of C-47232

W.R.I.S.

Assembled 7-18-84 by 5/6
 Entered _____ by _____
 Verified _____ by _____

INDEX CARDS:	Entered	Checked
☒ Name	☒	☐
☒ Stream	☒	☐
☒ Pt. of Div.	☒	☐
☒ Calendar	☒	☐
CHECKED TO RECORDS:		
☒ Twp. & Rge.	☒	☐
☐ Decree-vault	☐	☐
☐ Decree-safe	☐	☐
☒ Cert. of W/R	☒	☐
☒ Per. Folder	☒	☐
☐ Chainindex	☐	☐
☐ Cross Ref.	☐	☐
☐ Power Claim	☐	☐
☐ Abstracts	☐	☐

T.9S.,R.24&25E.,W.M.

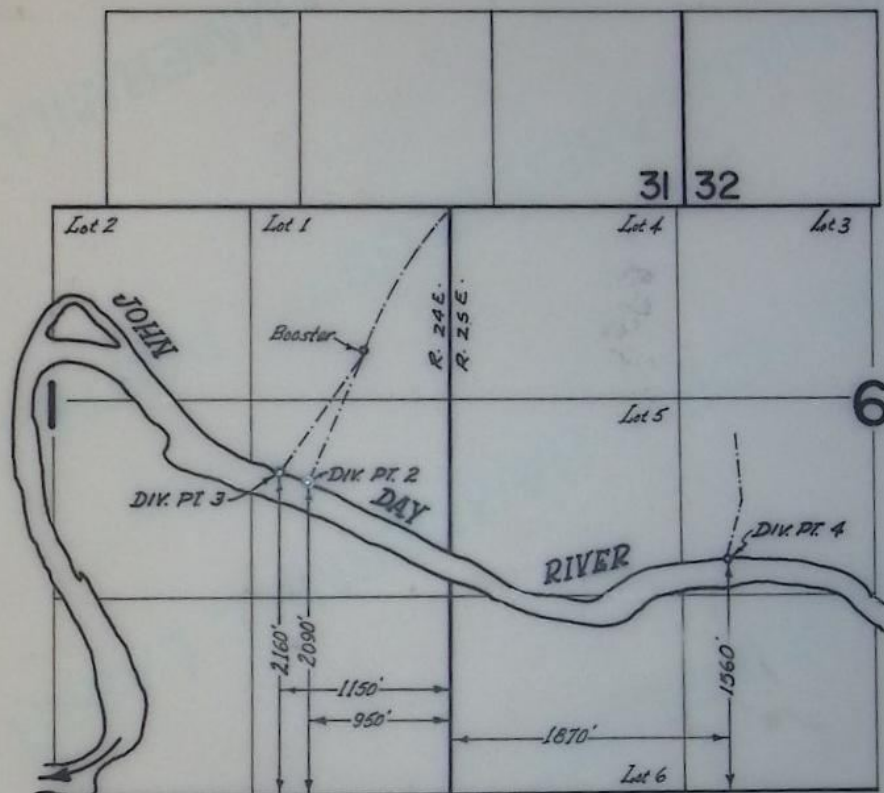

FINAL PROOF SURVEY

UNDER

Transfer No. 3235

Application No. _____ Permit No. _____
IN NAME OF _____

WILLIAM J. CHAPMAN

Surveyed Aug. 25 1977, by R.G. Mucken.....

Dr. *[Signature]*REPORT ON INSPECTION UNDER
TRANSFER OF WATER RIGHT FORTransfer No. 3235County Wheeler

1. Name William I. Chapman Address Box 173, Spray, Oregon 97874
2. Source of Supply John Day River, Trib. of Columbia River
3. Amount of Water 1.5 c.f.s. Priority Date Jan. 19, 1959
4. Use irrigation of 81+ ac.

Points of Diversion Located: #2 - 2090' N. & 950' W.; #3 - 2160' N. & 1150' W.;
#4 - 1560' N. & 1870' E., all from the SE cor. Sec. 1.

#2 & #3 - NE 1/4 SE 1/4 Sec. 1, T. 9S, R. 24E, W.M.

#4 - NE 1/4 SW 1/4 Sec. 6, T. 9S, R. 25E, W.M.

Township	Range	Section	Forty Acre Tract	Use for Which Transfer Made	
8S	25E	31	SE 1/4 SW 1/4		0.1 acre
9S	24E	1	SE 1/4 NE 1/4 (Lot 1)		12.0 acres
9S	24E	1	SW 1/4 NE 1/4 (Lot 2)		22.6 acres
9S	24E	1	NE 1/4 SE 1/4		20.1 acres
9S	24E	1	NW 1/4 SE 1/4		2.4 acres
9S	25E	6	NE 1/4 SW 1/4		9.0 acres
9S	25E	6	NW 1/4 SW 1/4 (Lot 5)		14.6 acres
9S	25E	6	NW 1/4 SE 1/4		0.6 acre

32846
37992GE 200 3540
Carnell C.P.P.
3 x 33" steel 21 RB 30 13/64 54 PSI
actual

Info: Mr. Ted. Thompson, leases land irrigated
Div. Pts. are as filed. Land is same as
applied on before.

Div. Pts. #2 & #3 are tied into common mainline
with booster pump

Div Pt #4 on separate system with buried mainline

Source: John Day River

~~Div. Pts.~~
Div. Pts: #2, 3, 4 Direct from river

motors: Div GE 25 hp @ 3500 Div GE 20 hp @ 3500 Div GE 20 hp @ 3500
#2 #3 #4

pumps: Cornell CDD #3 Pacific CDD #4 Cornell CDD
4" x 3" 3" x 3"

Booster pump #2 & #3 Div Pts.
GE 10 hp Cornell CDD 3" x 2"

heads: 200 RB 30's 125 max from Div #2 & #3, 50 max Div #4
 $\frac{11}{64} \times 0$, $\frac{11}{64} \times \frac{3}{32}$, $\frac{13}{64} \times 0$

pipe: 800' 6" PVC buried mainline

800' 5" Steel " "

2200' 4" Steel " "

2000' 4" wheel line

6000' 3 1/4" alum. lateral


crop: ~~Alfalfa~~ Alfalfa, pasture

lift: +15 to +100 most +20 to +50

tie: DOV-4JJ-138

Steve Donaldson
Field Engineer
8-25-77

T.88&9S.R.24&25E.W.M.

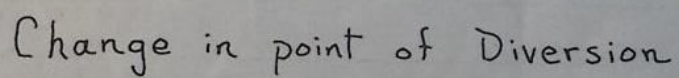

T-3235

BEFORE THE WATER RESOURCES DIRECTOR OF OREGON

Wheeler County

IN THE MATTER OF THE APPLICATION)
OF WILLIAM I. CHAPMAN FOR THE)
APPROVAL OF A CHANGE IN POINTS)
OF DIVERSION OF WATER FROM JOHN)
DAY RIVER)

ORDER APPROVING
TRANSFER NO. 3235

On May 23, 1975, William I. Chapman filed an application for transfer of water right in the office of the Water Resources Director proposing a change in points of diversion under an existing right of record from John Day River.

Certificate of water right issued to William I. Chapman and recorded at Page 30235, Volume 22, State Record of Water Right Certificates, confirms a right to the use of 1.5 cubic feet per second of water from John Day River for the irrigation of 0.1 acre in $SE\frac{1}{4} SW\frac{1}{4}$, Section 31, Township 8 South, Range 25 East, 12.0 acres Lot 1 ($SE\frac{1}{4} NE\frac{1}{4}$), 22.6 acres Lot 2 ($SW\frac{1}{4} NE\frac{1}{4}$), 20.1 acres $NE\frac{1}{4} SE\frac{1}{4}$ and 2.4 acres $NW\frac{1}{4} SE\frac{1}{4}$, Section 1, Township 9 South, Range 24 East, 9.0 acres in $NE\frac{1}{4} SW\frac{1}{4}$, 14.6 acres Lot 5 ($NW\frac{1}{4} SW\frac{1}{4}$) and 0.6 acre $NW\frac{1}{4} SE\frac{1}{4}$, Section 6, Township 9 South, Range 25 East, W.M., with a date of priority of January 19, 1959.

These lands are irrigated from point of diversion No. 1 located 1870 feet North and 540 feet West from the Southeast corner of Section 1, and from point of diversion No. 2 located 2070 feet North and 930 feet West from the Southeast corner of Section 1, both being located within the $NE\frac{1}{4} SE\frac{1}{4}$ of Section 1, Township 9 South, Range 24 East, W.M.

The applicant herein, owner of the lands above described, proposes to abandon point of diversion No. 1, maintain use of point of diversion No. 2, and establish point of diversion No. 3 to be located 2150 feet North and 1275 feet West from the Southeast corner of Section 1, being within the $NE\frac{1}{4} SE\frac{1}{4}$ of

Section 1, Township 9 South, Range 24 East, W.M., and establish point of diversion No. 4 to be located 1550 feet North and 1850 feet East from the Southeast corner of Section 1, being within the NE $\frac{1}{4}$ SW $\frac{1}{4}$, Section 6, Township 9 South, Range 25 East, W.M.

Notice of the application, pursuant to ORS 540.510 was published in the Gilliam-Wheeler Times-Journal, a newspaper printed and having general circulation in Wheeler County, Oregon, for a period of three weeks in the issues of January 30, February 6 and 13, 1976.

Mr. Robert F. Main, Jr., Watermaster of District No. 4, has filed a statement to the effect that the proposed change in points of diversion may be made without injury to existing rights.

No objection having been filed and it appearing that the proposed changes in points of diversion may be made without injury to existing rights, the application should be approved.

NOW, THEREFORE, it hereby is ORDERED that the requested change in points of diversion from the John Day River, described herein, without loss of priority, is approved.

It is FURTHER ORDERED that the quantity of water diverted at the new points of diversion shall not exceed the quantity of water available at the old points of diversion, and shall not exceed 1.50 cubic feet per second.

It is FURTHER ORDERED that the following provisions shall be effective when in the judgement of the watermaster it becomes necessary to install head-gates and measuring devices:

That the diversion works shall include an in line flow meter, a weir, or other suitable device for measuring the water to which the applicant is entitled;

That the type and plans of the measuring device be approved by the watermaster before the beginning of construction work and that the weir or measuring device be installed under the general supervision of said watermaster.

It is FURTHER ORDERED that the construction work shall be completed and the change in point of diversion of water made on or before October 1, 1977.

It is FURTHER ORDERED that the certificate of water right heretofore issued to William I. Chapman and recorded at Page 30235, Volume 22, State Record of Water Right Certificates, is canceled, and upon proof satisfactory to the Water Resources Director of completion of works and beneficial use of water to the extent intended under the provisions of this order, a confirming certificate of water right shall be issued to William I. Chapman.

Dated at Salem, Oregon, this 6th day of October, 1976.

/s/ JAMES E. SEXSON
Director

RECEIVED

MAY 23 1975
STATE ENGINEER
SALEM, OREGON

T-3235

Application for Transfer of Water Right

To the STATE ENGINEER OF OREGON:

I, William I. Chapman

(Name of applicant)

Box 173

of Spray

(Postoffice)

County of Wheeler

State of Oregon 97874, do hereby make application for change in point of diversion

(In point of diversion; place of use; use heretofore made of the water)

1. The source of present water right is John Day River

(Name of stream)

2. The use to which the water is applied is Irrigation

(Irrigation; Mining; Power; Manufacturing; etc.)

3. The name of the ditch, canal or pipe line is Pipeline

4. The point of diversion is located #1-1870' N 540' W and #2-2070' N 930' ft. W from the SE
(N. or S.) (E. or W.)

corner of Section 1 being within the NE $\frac{1}{4}$ SE $\frac{1}{4}$
(Section or subdivision)

of Section 1 Tp. 9 S. R. 24 E. W. M., in the County of Wheeler
(No. N. or S.) (No. E. or W.)

5. List the number of acres irrigated in each smallest legal subdivision (40-acre tract) involved in this transfer. If for any other use, indicate place of use.

Twp.	Range	Sec.	NE 1-4				NW 1-4				SW 1-4				SE 1-4			
			NE $\frac{1}{4}$	NW $\frac{1}{4}$	SW $\frac{1}{4}$	SE $\frac{1}{4}$	NE $\frac{1}{4}$	NW $\frac{1}{4}$	SW $\frac{1}{4}$	SE $\frac{1}{4}$	NE $\frac{1}{4}$	NW $\frac{1}{4}$	SW $\frac{1}{4}$	SE $\frac{1}{4}$	NE $\frac{1}{4}$	NW $\frac{1}{4}$	SW $\frac{1}{4}$	SE $\frac{1}{4}$
9 S.	24 E	1	Lot 1 12.0	Lot 2 12.0	23.2	22.6									20.1		2.4	
8 S.	25 E	31												0.1			0.2	
9 S.	25 E	6	Lot 4 14.6	Lot 5 14.6	2.6	15.2				9.0						0.6		

NOTE: If you own less than 40-acre tracts, attach a description of your land as it appears in your deed.

1.50 cfs

(Attach separate sheet if necessary)

6. Are you the legal owner of the above described lands? Yes

(If not owner, explain your interest)

7. Has water been used beneficially for the purposes indicated herein during the past 5 years? Yes

Jan. 19, 1959

8. What is the date of priority of your water right? 1/19/59 and 8/21/62

9. Was your water right acquired by State Engineer's Permit? Yes If so, give number
(Yes or No)

of permit 26002 & 28328

10. Do you hold a water right certificate? Yes If so, give number of certificate 30235 & 31020
(Yes or No)

11. Was your water right determined by State Engineer's order of Determination or Decree of Court?

No If so, give title of proceedings
(Yes or No)

12. Is the water right recorded in your name? Yes
(If not, give name)

13. I propose to transfer the water right to the following described lands: (Do not answer if your application is for change in point of diversion only.)

Twp.	Range	Sec.	NE 1-4				NW 1-4				SW 1-4				SE 1-4			
			NE $\frac{1}{4}$	NW $\frac{1}{4}$	SW $\frac{1}{4}$	SE $\frac{1}{4}$	NE $\frac{1}{4}$	NW $\frac{1}{4}$	SW $\frac{1}{4}$	SE $\frac{1}{4}$	NE $\frac{1}{4}$	NW $\frac{1}{4}$	SW $\frac{1}{4}$	SE $\frac{1}{4}$	NE $\frac{1}{4}$	NW $\frac{1}{4}$	SW $\frac{1}{4}$	SE $\frac{1}{4}$

(Attach separate sheet if necessary)

NOTE: Answer questions 14, 15, 16 and 17, if the application is for change in point of diversion.

14. The proposed point of diversion is located #3-2150' N 1275' W
#3-NE $\frac{1}{4}$ SE $\frac{1}{4}$ section 1 9 S. 24 E from the SE
corner of Section 1 being within the #1-NE $\frac{1}{4}$ SW $\frac{1}{4}$ of Section 6 Tp. 9 S. R. 25 E. W. M.,
(Smallest legal subdivision) (No. N. or S.) (No. E. or W.)
in the county of Wheeler The name of the ditch to be used is

15. Are you the owner of the land on which the proposed point of diversion is to be located? Yes

16. If not the owner of the land on which the proposed point of diversion is to be located, give the name and address of owner and submit evidence of your right-of-way for your proposed ditch, canal, or pipe line.

17. Are there any diversions between your present point of diversion and the proposed point of diversion? No

NOTE: Answer questions 18 and 19 if application is for change in use or place of use.

18. Are the lands from which you propose to transfer your water right free of all encumbrances, including taxes, mortgages, liens, etc.? (Answer Yes or No)

19. If not, give below a description of existing encumbrances:

NATURE OF ENCUMBRANCE	HELD BY	AMOUNT

20. Reasons for the proposed changes are Change from flood to Spinkler irrigation

AFFIDAVIT OF APPLICANT

STATE OF OREGON,

County of _____ } ss.

I, William J Chapman, the applicant herein, being first duly sworn, depose and say that I have read the above and foregoing application for transfer of water right; that I know the contents thereof and that the statements therein made are true and correct to the best of my knowledge and belief.


In Witness Whereof, I have hereunto set my hand this 15th day of May, 1975.

William J Chapman
(Name of applicant)

Subscribed and sworn to before me this 15th day of May, 1975.

Robert F. Main
NOTARY PUBLIC FOR OREGON

My commission expires April 1, 1979

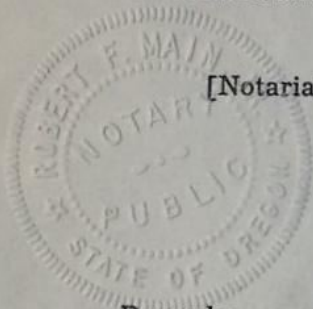

[Notarial Seal]

Remarks _____

THIS APPLICATION MUST BE ACCOMPANIED BY A MAP SHOWING THE LOCATION OF THE POINT OF DIVERSION, PLACE OF USE AND WORKS UTILIZED UNDER THE PRESENT WATER RIGHT. THE MAP SHOULD ALSO SHOW THE NEW POINT OF DIVERSION OR PLACE OF USE, AS THE CASE MAY BE.


It is desired to dispense with diversion point #1 and add diversion points #3 and #4, keeping #2 as originally filed.

RECEIVED

MAY 23 1975

STATE ENGINEER
SALEM, OREGON.

T.8&9S.R.24&25E.W.M.

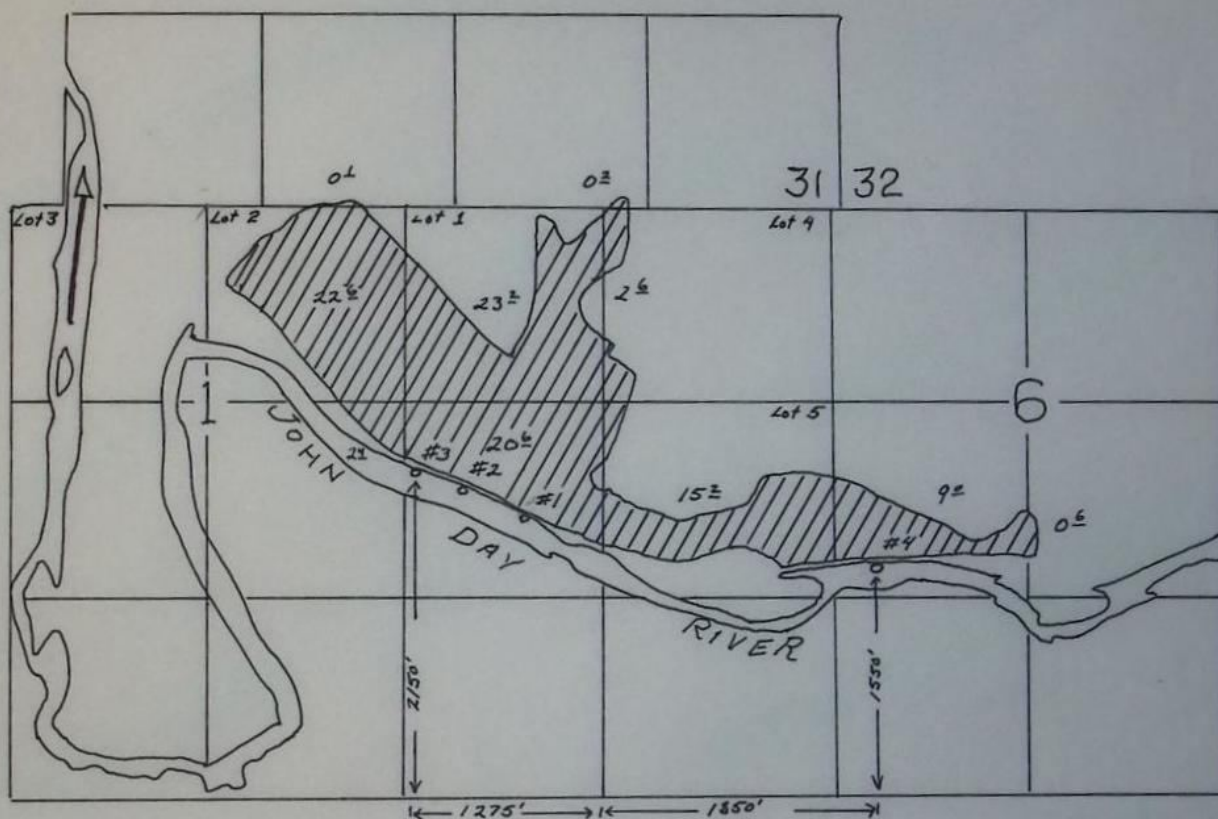

Superseded


Change in point of Diversion

T-3235

1871
575-0119

MAY 23 1975
STATE ENGINEER
SALEM, OREGON.

T.8&9S.R.24&25E.W.M.

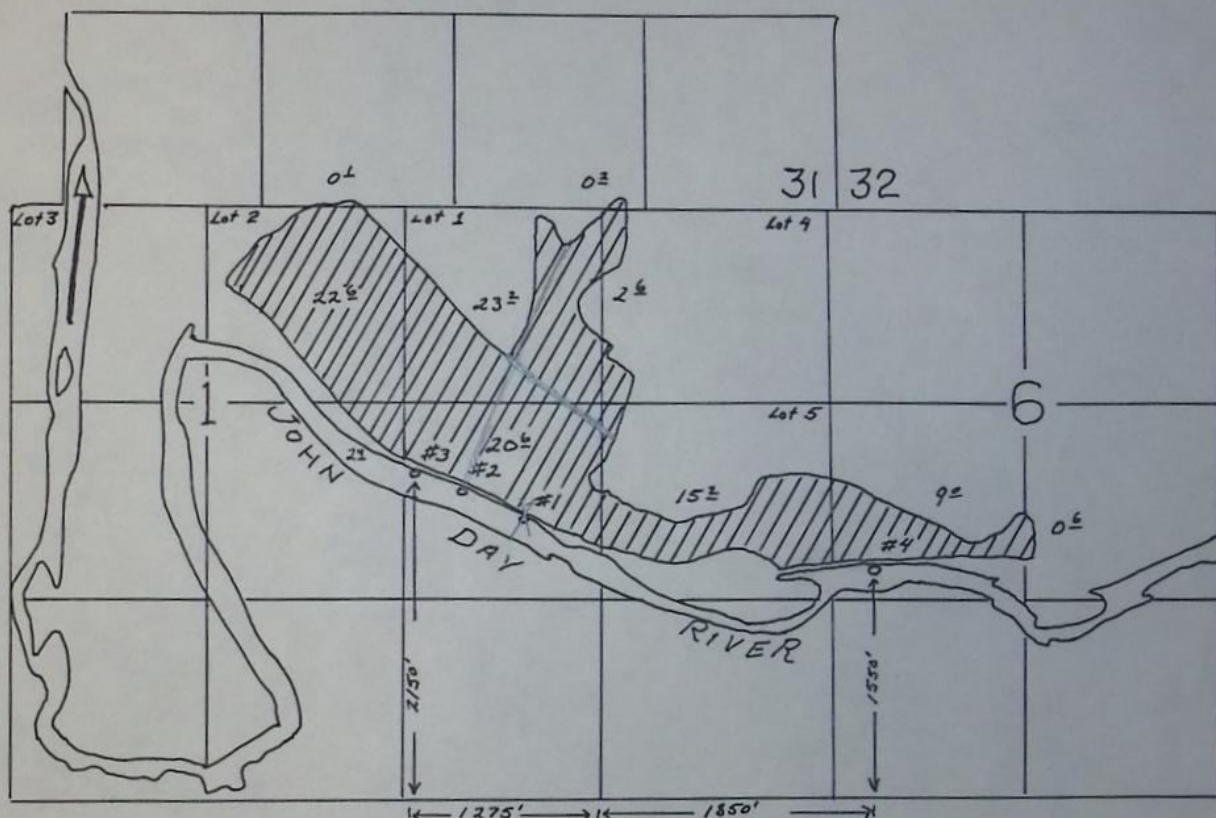

Change in point of Diversion

T-3235

Transfer No. 3235

NOTICE OF COMPLETION OF CONSTRUCTION

I, William D Chapman hereby certify
that the construction work has been completed and the change in point
of diversion of water made as set forth in the order of the Water
Resources Director dated May 23, 1975, approving an application
for a change in point of diversion of water from John Day,
River.

11-3-76
Date

William D Chapman
Name

RECEIVED

NOV - 81976

WATER RESOURCES DEPT.
SALEM, OREGON

AFFIDAVIT OF PUBLICATION

STATE OF OREGON, COUNTY OF GILLIAM, ss:

I,David.Gould.....
 being first duly sworn, depose and say that I am the
Editor..... of the
 GILLIAM-WHEELER TIMES-JOURNAL, a newspa-
 per of general circulation as defined by Sections 1-509,
 1-510, Oregon Code; printed and published at Condon in
 the aforesaid county and state; that theState.of.....
 Oregon-Water Resources Div.(Chapman)
a printed
 copy of which is hereto annexed, was published in the
 entire issue of said newspaper for ...three.....
 successive and consecutive weeks in the following is-
 sues:

.....January 30, 1976.....
February 6, 1976.....
February 13, 1976.....

.....David Gould.....

Subscribed and sworn to before me this^{6th}
 day ofFeb....., 1976..

.....Margaret Bennett.....
 Notary Public for Oregon

(My commission expires8-4....., 1976..)

LEGAL NOTICE . . .

**NOTICE OF FILING APPLICATION
 FOR CHANGES IN POINTS OF
 DIVERSION OF WATER**

Notice is given hereby that William I. Chapman has filed an application for approval of changes in points of diversion of water from John Day River.

Certificate of water right issued to William I. Chapman and recorded at page 30235, Volume 22, State Record of Water Right Certificates, confirms a right to the use of 1.5 cubic feet per second of water from John Day River for the irrigation of 0.1 acre in SE¼ SW¼, Sec. 31, T. 8 S., R. 25 E., 12.0 acres Lot 1 (SE¼ NE¼), 22.6 acres Lot 2 (SW¼ NE¼), 20.1 acres NE¼ SE¼ and 2.4 acres NW¼ SE¼, Sec. 1, T. 9 S., R. 24 E., 9.0 acres in NE¼ SW¼, 14.6 acres Lot 5 (NW¼ SW¼) and 0.6 acre NW¼ SE¼, Sec. 6, T. 9 S., R. 25 E., W.M., with a date of priority of Jan. 19, 1959.

Certificate of water right issued to William I. Chapman and recorded at page 31020, Volume 23, State Record of Water Right Certificates, confirms a right to the use of 0.37 cubic foot per second of water from John Day River for the irrigation of 11.2 acres Lot 1 (SE¼ NE¼) and 0.5 acre NE¼ SE¼, Sec. 1, T. 9 S., R. 24 E., 2.6 acres Lot 4 (SW¼ NW¼) and 0.6 acre Lot 5 (NW¼ SW¼), Sec. 6, T. 9 S., R. 25 E., W.M., with

Going to Redmond January 27 were
 January 23. Many people attended.
 in the cafeteria after the basketball game
 a birthday party for her son Jimmy Keys.
 Mrs. Bob Keys was the hostess for
 Sheila, of John Day.
 Lambert and their children, Marie and
 January 23 were Mr. and Mrs. Jerry
 Visiting Mr. and Mrs. Randal Smith
 the group.
 Vic Camp, school clerk, also meet with
 Superintendent Glenn Scofield and Mrs.
 Mrs. Myran Bohannon and Bud Taylor.
 Bob Keys, Harry Smith, Bob Powell,
 members of the school board, who are
 Humphreys. Meeting with them are the
 Norton, Dick Seaton, Zack Keys and Bob
 who are Mrs. Sherla Collins, Mrs. Cell
 are the members of the budget committee.
 Meeting on Thursday nights at 7 p.m.
 Rothell, 3.0.
 Welty, 3.23; Pat Keys, 3.14; and Kevin
 Cox, 3.29; Barbara Schmidt, 3.23; Kathy
 Eric Clark, 4.0; Jim Keys, 3.86; Tim

RECEIVED

MAR - 3 1976

WATER RESOURCES DEPT.
 SALEM, OREGON

AFFIDAVIT OF PUBLICATION

STATE OF OREGON, COUNTY OF GILLIAM, ss:

I,David Gould.....
being first duly sworn, depose and say that I am the
.....Editor..... of the
GILLIAM-WHEELER TIMES-JOURNAL, a newspaper
of general circulation as defined by Sections 1-509,
1-510, Oregon Code; printed and published at Condon in
the aforesaid county and state; that the State of.....
Oregon-Water Resources Div. (Chapman) a printed
copy of which is hereto annexed, was published in the
entire issue of said newspaper for ...three.....
successive and consecutive weeks in the following is-
sues:

January 30, 1976

February 6, 1976

February 13, 1976

.....David Gould.....

Subscribed and sworn to before me this ...6th.....
day of ...Feb....., 1976.

.....Margaret J. Bennett.....
Notary Public for Oregon

(My commission expires8-4....., 1976...)

LEGAL NOTICE . . .

NOTICE OF FILING APPLICATION FOR CHANGES IN POINTS OF DIVERSION OF WATER

Notice is given hereby that William I. Chapman has filed an application for approval of changes in points of diversion of water from John Day River.

Certificate of water right issued to William I. Chapman and recorded at page 30235, Volume 22, State Record of Water Right Certificates, confirms a right to the use of 1.5 cubic feet per second of water from John Day River for the irrigation of 0.1 acre in SE $\frac{1}{4}$ SW $\frac{1}{4}$, Sec. 31, T. 8 S., R. 25 E., 12.0 acres Lot 1 (SE $\frac{1}{4}$ NE $\frac{1}{4}$), 22.6 acres Lot 2 (SW $\frac{1}{4}$ NE $\frac{1}{4}$), 20.1 acres NE $\frac{1}{4}$ SE $\frac{1}{4}$ and 2.4 acres NW $\frac{1}{4}$ SE $\frac{1}{4}$, Sec. 1, T. 9 S., R. 24 E., 9.0 acres in NE $\frac{1}{4}$ SW $\frac{1}{4}$, 14.6 acres Lot 5 (NW $\frac{1}{4}$ SW $\frac{1}{4}$) and 0.6 acre NW $\frac{1}{4}$ SE $\frac{1}{4}$, Sec. 6, T. 9 S., R. 25 E., W.M., with a date of priority of Jan. 19, 1959.

Certificate of water right issued to William I. Chapman and recorded at page 31020, Volume 23, State Record of Water Right Certificates, confirms a right to the use of 0.37 cubic foot per second of water from John Day River for the irrigation of 11.2 acres Lot 1 (SE $\frac{1}{4}$ NE $\frac{1}{4}$) and 0.5 acre NE $\frac{1}{4}$ SE $\frac{1}{4}$, Sec. 1, T. 9 S., R. 24 E., 2.6 acres Lot 4 (SW $\frac{1}{4}$ NW $\frac{1}{4}$) and 0.6 acre Lot 5 (NW $\frac{1}{4}$ SW $\frac{1}{4}$), Sec. 6, T. 9 S., R. 25 E., W.M., with a date of priority of Aug. 24, 1962.

These lands are irrigated from point of diversion No. 1 located 1870 ft. N. and 540 ft. W. from the SE corner of Sec. 1 and from point of diversion No. 2 located 2070 ft. N. and 930 ft. W. from the SE corner of Sec. 1, both being located within the NE $\frac{1}{4}$ SE $\frac{1}{4}$ of Sec. 1, T. 9 S., R. 24 E., W.M.

The applicant herein, owner of the lands above described, proposes to abandon point of diversion No. 1, maintain use of point of diversion No. 2, and establish point of diversion No. 3 to be located 2150 ft. N. and 1275 ft. W. from the SE corner of Sec. 1, being within the NE $\frac{1}{4}$ SE $\frac{1}{4}$ of Sec. 1, T. 9 S., R. 24 E., W.M., and establish point of diversion No. 4 to be located 1550 ft. N. and 1850 ft. E. from the SE corner of Sec. 1, being within the NE $\frac{1}{4}$ SW $\frac{1}{4}$, Sec. 6, T. 9 S., R. 25 E., W.M.

All persons interested are notified hereby that a hearing will be held at the county courthouse at Fossil, Or., on March 30, 1976, at 9:30 a.m. All objections to the proposed change, if any there are, will be heard at said time and place. Any and all objections shall be prepared in writing, one copy to be served on William I. Chapman, Spray, Oregon 97874, and one copy filed with the Water Resources Department, Salem, Or. 97310, together with a \$10 filing fee, at least 10 days prior to the date set for hearing. If no objections are filed, the application may be approved by the Water Resources Director without a hearing. Administrative rules pertaining to the filing of a protest will be furnished by the Water Resources Department upon request.

Dated at Salem, Oregon, this 21st day of January, 1976.

JAMES E. SEXSON

Director

Published January 30, February 6 and 13, 1976

TJ-11

RECEIVED

MAR - 3

WATER RESOURCES
SALEM, O