

3855 Young

Name Lorine M. Young

3855

DESCRIPTION OF WATER RIGHT

FEES PAID

By \_\_\_\_\_

Address 1005 Meadow View Dr.

Williams, Or 97544

Name of stream W. Fk. Williams Cr.

Trib. of \_\_\_\_\_ County of Josephine

Use Irr

Quantity of water \_\_\_\_\_ No. of acres 3

Name of ditch Chapman

Date of priority 1908

In name of W. G. Records

Rogue <sup>Findings</sup> Adjudication, Vol. 13, page 422 (T-2743)

App. No. \_\_\_\_\_ Per. No. \_\_\_\_\_ Cert. No. 43767 (32955)

Certificate cancelled \_\_\_\_\_

Notation made on record by \_\_\_\_\_

Date	Amount	Receipt No.
12-28-77	\$ 90 -	447
TOTAL . . .		
2-14-78	#2 Cert. Fee	Tent. from 447
Valley News \$ 29.86 pd 2-16-78 ck #1995		

FEES REFUNDED

Date	Amount	Check No.
2-16-78	\$ 23.14	1996
	Exam 20	
	POD 15	
	Cert 2	
	PON 29.86	
	66.86	

Change in POD

Date filed Dec. 28, 1977

Date of hearing March 7, 1978

Place of hearing Grants Pass

Date of order 3-7-78 Vol. 30, page 450

Date for application of water 10-1-79

Proof mailed \_\_\_\_\_

Proof received \_\_\_\_\_

Certificate issued MAY 1 1978 Vol. 30, page 45515

OCT 13 1986

50

54970

DEC 12 1986

50

55286

to Survey 9/79

REMARKS

(See T#2743 re Retylloff partition maps.)

W.R.I.S.	
Assembled <u>6-28-85</u>	by <u>SW</u>
Entered _____	by _____
Verified _____	by _____

INDEX CARDS:		Entered	Checked
<input checked="" type="checkbox"/>	Name	<u>lg</u>	_____
<input checked="" type="checkbox"/>	Stream	<u>lg</u>	_____
<input checked="" type="checkbox"/>	Pt. of Div.	<u>lg</u>	_____
<input checked="" type="checkbox"/>	Calendar	<u>lg</u>	_____
CHECKED TO RECORDS:			
<input checked="" type="checkbox"/>	Twp. & Rge.	<u>lg</u>	_____
<input checked="" type="checkbox"/>	Decree-vault	<u>lg</u>	<u>lg</u>
<input checked="" type="checkbox"/>	Decree-safe	<u>lg</u>	_____
<input checked="" type="checkbox"/>	Cert. of W/R	<u>lg</u>	_____
<input checked="" type="checkbox"/>	Per. Folder	_____	_____
<input checked="" type="checkbox"/>	Chaindex	_____	_____
<input checked="" type="checkbox"/>	Cross Ref.	_____	_____
<input checked="" type="checkbox"/>	Power Claim	<u>lg</u>	_____
<input checked="" type="checkbox"/>	Abstracts	<u>lg</u>	_____


TO BE ENTERED WHERE CHECKED



T. 39 S., R. 5 W., W.M.

Sec. 3

SE 1/4 NW 1/4

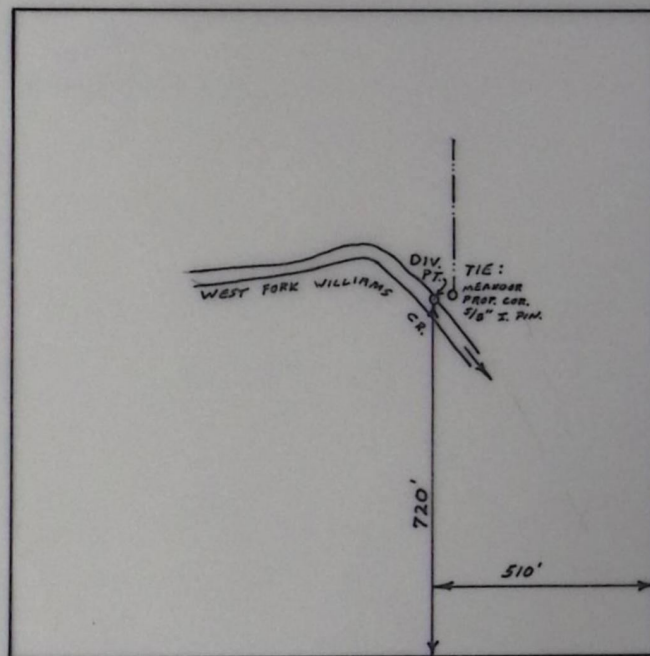

Scale: 1" = 400'

**FINAL PROOF SURVEY**  
UNDER

Transfer no. 3855

Application No. .... Permit No. ....  
IN NAME OF

.....LORINE.....M.....YOUNG.....

Surveyed Oct...2... 19.80, by B.R.SUND.....



## STATE OF OREGON

COUNTY OF

JOSEPHINE

RECEIVED

NOV 6 1986

## CERTIFICATE OF WATER RIGHT

WATER RESOURCES DEPT.,  
SALEM, OREGON

This Is to Certify, That

LORINE M. YOUNG

of 1005 Meadow View Drive, Williams, State of OR 97544, has  
a right to the use of the waters of West Fork Williams Creek

a tributary of Williams Creek  
irrigation of 3.0 acres

for the purpose of

and that said right has been confirmed by decree of the Circuit Court of the State of Oregon for  
Jackson County, and the said decree entered of record at Salem, in the Order Record of  
the WATER RESOURCES DIRECTOR, in Volume 16, at page 523; that the priority of the right  
thereby confirmed dates from December 1908

that the amount of water to which such right is entitled, for the purposes aforesaid, is limited to an  
amount actually beneficially used for said purposes, and shall not exceed 0.04 cubic foot  
per second, if available at the original point of diversion; NE 1/4 SE 1/4,  
Section 4, T39S, R5W, WM; Chapman Ditch - 440 feet South and 1200 feet West  
from E 1/4 corner Section 4

The point of diversion is located in the SE 1/4 NW 1/4, Section 3, T39S, R5W, WM; 720  
feet North and 510 feet West from SE corner, SE 1/4 NW 1/4, Section 3.

A description of the place of use under the right, and to which such right is appurtenant, is as  
follows:

SE 1/4 NW 1/4  
3.0 acres Lot 20 (NE 1/4 NW 1/4)  
Section 3  
Township 39 South, Range 5 West, WM

RECEIVED

OCT 22 1986

WM DIST. 14  
GRANTS PASS, ORE.

Note: Lot refers to Retzloff partition of the NW 1/4 of Section 3, T39S, R5W,  
WM., recorded in Josephine County.

So as to correctly describe the place of use  
This certificate is issued to confirm a change in point of diversion approved  
by an order of the Water Resources Director entered March 7, 1978, and  
together with certificate of water right recorded at page 45515, Volume 38,  
State Record of Water Right Certificates, supersedes certificate 43767,  
Volume 35, State Record of Water Right Certificates.

and supersedes certificate of water right recorded at page 54970 Vol. 49 Salem  
The issuance of this superseding certificate does not confirm the status of  
the water right in regard to the provisions of ORS 540.610 pertaining to  
forfeiture or abandonment.

And said right shall be subject to all other conditions and limitations contained in said decree.  
The right to the use of the water for the purposes aforesaid is restricted to the lands or place of use herein  
described.

WITNESS the signature of the Water Resources Director, affixed

this date October 13, 1986.

William N. Young  
Water Resources Director

Cert 54970

6247-D

Basin "15" Vol. 69

W.F. Williams Cr.



## STATE OF OREGON

COUNTY OF JOSEPHINE

SUPERSEDED  
CERTIFICATE NO. 45515

T-3855

## CERTIFICATE OF WATER RIGHT

LORINE M. YOUNG

This Is to Certify, That

CHARLES H. RETZLOFF, RICHARD W. &  
VIVIAN C. LATHAN, AND RONDEL C. BRIDGES1005 MEADOW VIEW DR WILLIAMS  
of 1991 SE Portola Drive, Grants Pass, State of Oregon, 97526, has  
a right to the use of the waters of West Fork Williams Creeka tributary of Williams Creek  
irrigation of 26.2 acres  
3.0

for the purpose of

and that said right has been confirmed by decree of the Circuit Court of the State of Oregon for  
Jackson County, and the said decree entered of record at Salem, in the Order Record of  
the WATER RESOURCES DIRECTOR, in Volume 16, at page 523; that the priority of the  
right thereby confirmed dates from December, 1908;that the amount of water to which such right is entitled, for the purposes aforesaid, is limited to an  
amount actually beneficially used for said purposes, and shall not exceed 0.37 cubic foot per  
second, if available at the original point of diversion 0.04The point of diversion is located in the NE 1/4, Section 4, T. 39 S., R. 5 W., W. M.  
CHAPMAN DITCH - 440'S E 1200'W from E 1/4 cor Sec 4A description of the place of use under the right, and to which such right is appurtenant, is as  
follows:3.1 acres Lot 4  
4.0 acres Lot 5  
4.0 acres Lot 6  
3.0 acres Lot 7  
3.0 acres Lot 8  
3.0 acres Lot 9  
3.0 acres Lot 20 (NE 1/4 NW 1/4)  
3.1 acres Lot 21NE 1/4 NW 1/4  
Section 3  
T. 39 S., R. 5 W., W. M.Lot refers to Retzliff part of NW 1/4  
Sec 3 T39S R5W Wm recorded in  
Josephine CountyThis certificate is issued to confirm a change in place of use and point  
of diversion approved by an order of the Water Resources Director entered  
3-7-78 and together with certificate of water right recorded on page  
45515, Volume 38, SRWRC supersedes certificate of water right recorded on  
at page 43767, Volume 35, SRWRC.

THE ISSUANCE ETC

And said right shall be subject to all other conditions and limitations contained in said decree.  
The right to the use of the water for the purposes aforesaid is restricted to the lands or place of  
use herein described.

WITNESS the signature of the Water Resources Director, affixed

this date October 18, 1976.

James E. Sisson  
Water Resources Director

Recorded in State Record of Water Right Certificates, Volume 35, page 43767

54970  
55286

T-3855

6247D

Pop: db sec 3 T39S R 5W Wm  
720' N E 510' W from SE cor db sec 3Cat  
-bc



702

## STATE OF OREGON

COUNTY OF

JOSEPHINE

## CERTIFICATE OF WATER RIGHT

This Is to Certify, That

CHARLES H. RETZLOFF, RICHARD W. &  
VIVIAN C. LATHAN, AND RONDEL C. BRIDGESof 1991 SE Portola Drive, Grants Pass, State of Oregon, 97526, has  
a right to the use of the waters of West Fork Williams Creeka tributary of Williams Creek  
irrigation of ~~26.2~~ acres  
23.2

for the purpose of

and that said right has been confirmed by decree of the Circuit Court of the State of Oregon for  
Jackson County, and the said decree entered of record at Salem, in the Order Record of  
the WATER RESOURCES DIRECTOR, in Volume 16, at page 523; that the priority of the  
right thereby confirmed dates from December, 1908;that the amount of water to which such right is entitled, for the purposes aforesaid, is limited to an  
amount actually beneficially used for said purposes, and shall not exceed ~~0.37~~ cubic foot per  
second. 0.33The point of diversion is located in the NE $\frac{1}{4}$  SE $\frac{1}{4}$ , Section 4, T. 39 S., R. 5 W., W. M., being  
440 ft S and 1200 ft W from the E $\frac{1}{4}$  Corner of Sec. 4A description of the place of use under the right, and to which such right is appurtenant, is as  
follows:

3.1 acres Lot 4  
4.0 acres Lot 5  
4.0 acres Lot 6  
3.0 acres Lot 7  
3.0 acres Lot 8  
3.0 acres Lot 9  
~~3.0 acres Lot 20~~ — 30  
3.1 acres Lot 21

SE $\frac{1}{4}$  NE $\frac{1}{4}$  NW $\frac{1}{4}$ 

Section 3

T. 39 S., R. 5 W., W. M.

Note: Lots within forty acre tracts refer to Retzloff partition of the NW $\frac{1}{4}$  of  
Section 3, T. 39 S., R. 5 W., W. M., recorded in Josephine County.

*This certificate is issued to correctly show the place of use as well as to*  
This certificate describes that portion of the water right confirmed by the prior  
certificate recorded at page 43767, Volume 35, State Record of Water Right  
Certificates, NOT modified by the provisions of an order of the Water Resources  
Director entered on March 7, 1978, approving transfer application No. 3855.

The issuance of this superseding certificate does not confirm the status of the  
water right in reference to ORS 540.610.The right to the use of the water for the purposes aforesaid is restricted to the lands or place of  
use herein described.

WITNESS the signature of the Water Resources Director, affixed

this date October 18, 1976

James E. Saxon  
Water Resources Director

Recorded in State Record of Water Right Certificates, Volume 35, page 43767



BEFORE THE WATER RESOURCES DIRECTOR OF OREGON

JOSEPHINE COUNTY

IN THE MATTER OF THE APPLICATION )  
OF LORINE M. YOUNG FOR APPROVAL )  
OF A CHANGE IN POINT OF DIVER- )  
SION OF WATER )  
-----

ORDER APPROVING  
TRANSFER NO. 3855

On December 28, 1977, an application was filed in the office of the Water Resources Director by Lorine M. Young for approval of a change in point of diversion from West Fork Williams Creek, pursuant to the provisions of ORS 540.510 to 540.530.

The certificate recorded at page 43767, Volume 35, State Record of Water Right Certificates, in the name of Charles H. Retzloff, et. al., describes a right which includes the use of not to exceed 0.04 cubic foot per second from West Fork Williams Creek for irrigation of 3.0 acres in Lot 20, Retzloff partition, being within the SE $\frac{1}{4}$  NW $\frac{1}{4}$  of Section 3, Township 39 South, Range 5 West, W.M., with a date of priority of December, 1908.

Water for the said right is diverted, through the Chapman Ditch, from a point located 440 feet South and 1200 feet West from the East Quarter Corner of Section 4, being within the NE $\frac{1}{4}$  SE $\frac{1}{4}$  of Section 4, Township 39 South, Range 5 West, W.M.

The applicant herein, owner of the lands above described, proposes to change the point of diversion therefrom, without loss of priority, to a point located 700 feet North and 500 feet West from the Center Corner of Section 3, being within the SE $\frac{1}{4}$  NW $\frac{1}{4}$  of said Section 3.

Notice of the application, pursuant to ORS 540.510, was published in the Illinois Valley News, a newspaper printed and having general circulation in Josephine County, Oregon, for a period of three weeks in the issues of January 12, 19 and 26, 1978.

Mr. Robert B. Steimer, Watermaster, has filed a statement to the effect that the proposed change in point of diversion may be made without injury to existing rights.

No objections having been filed and it appearing that the proposed change in point of diversion may be made without injury to existing rights, the application should be approved.



NOW, THEREFORE, it hereby is ORDERED that the requested change in point of diversion, as described herein, is approved.

It is FURTHER ORDERED that the quantity of water diverted at the new point of diversion shall not exceed the quantity of water available at the old point of diversion under the subject right, and shall not exceed 0.04 cubic foot per second.

It is FURTHER ORDERED that the following provisions shall be effective when in the judgment of the watermaster it becomes necessary to install heagdages and measuring devices:


That the diversion works shall include an in line flow meter, a weir, or other suitable device for measuring the water to which the applicant is entitled;

That the type and plans of the measuring device be approved by the watermaster before the beginning of construction work and that the weir or measuring device be installed under the general supervision of said watermaster.

It is FURTHER ORDERED that the construction work shall be completed and the change in point of diversion of water made on or before October 1, 1979.

It is FURTHER ORDERED that the certificate of water right heretofore issued to Charles H. Retzloff, et. al., and recorded at page 43767, Volume 35, State Record of Water Right Certificates, is canceled, and in lieu thereof a new certificate be issued covering the balance of the right NOT involved in this proceeding, and upon proof satisfactory to the Water Resources Director of completion of works and beneficial use of water to the extent intended under the provisions of this order, a confirming certificate of water right shall be issued to the applicant herein.

Dated at Salem, Oregon, this 7th day of March, 1978.

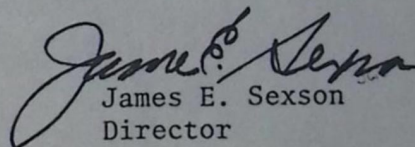  
James E. Sexson  
Director

V30, V451



## LEGAL NOTICE

### NOTICE OF WATER RIGHT TRANSFER APPLICATION NO. 3855

Notice is given hereby that an application has been filed in the office of the Water Resources Director by Lorine M. Young for approval of a change in point of diversion from W. Fork Williams Creek, pursuant to the provisions of ORS 540.510 to 540.530.

The certificate recorded at page 43767, Volume 35, State Record of Water Right Certificates, in the name of Charles H. Retzlaff, et al, describes a right which includes the use of not to exceed 0.04 cubic foot per second from W. Fork Williams Creek for irrigation of 3.0 acres in Lot 20, Retzlaff partition, being within the SE $\frac{1}{4}$  NW $\frac{1}{4}$  of Sec 3, T 39 S, R 5 W, WM, with a date of priority of December 1908.

Water for the said right is diverted, through the Chapman Ditch, from a point located 440 ft S and 1200 ft W from the E $\frac{1}{4}$  Corner of Sec 4, being within the NE $\frac{1}{4}$  SE $\frac{1}{4}$  of Sec 4, T 39 S, R 5 W, WM.

The applicant herein, owner of the lands above described, proposes to change the point of diversion therefrom, without loss of priority, to a point located 700 ft N and 500 ft W from the Center Corner of Sec 3, being within the SE $\frac{1}{4}$  NW $\frac{1}{4}$  of said Sec 3.

All persons interested are notified hereby that a hearing will be held at the county courthouse at Grants Pass, Oregon, on March 7, 1978, at 9:30 a.m. All objections to the proposed change, if any there are, will be heard at said time and place. Any and all objections shall be prepared in writing, one copy to be served on Lorine M. Young, 1005 Meadow View Dr., Williams, OR 97544 and one copy filed with the Water Resources Department, Salem, OR 97310, together with a \$10 filing fee, at least 10 days prior to the date set for hearing. IF NO OBJECTIONS ARE FILED, THE APPLICATION MAY BE APPROVED BY THE WATER RESOURCES DIRECTOR WITHOUT HEARING. Instructions regarding the filing of a protest will be furnished by the Water Resources Department upon request.

Dated at Salem, Oregon, this 3rd day of January, 1978.

James E. Sexson  
Director

Publish January 12, 19, 26, 1978

## Affidavit of Publication

STATE OF OREGON,  
County of Josephine

} ss.

I, Virginia L. Gilliam, being first duly sworn, depose and say I am the forman of the printers of the Illinons Valley News, a newspaper of general circulation printed and published at Cave Junction in the aforesaid county and state, as defined

in Section 58, Oregon Laws, that Notice of Water Right Transfer

Application # 3855 (Young) a printed copy of which is hereto annexed, was published in the entire issue of said newspaper for 3 successive and consecutive

issues on the following dates:

Jan. 12, 19, 26, 1978

Virginia L. Gilliam

Subscribed and sworn to before me this 9th day

of Feb, 1978

Walter E. McLean  
Notary Public for Oregon

(My Commission expires June 16, 1978).