

WILLA MAE TEEL

3607

20/13

STATUS OF APPLICATION

Change in point of diversion
 Date filed 3-30-77
 Date of hearing _____
 Place of hearing _____
 Date of order 5-31-77 Vol. 29, page 75
 Date for application of water 10-1-78
 Proof mailed _____
 Proof received _____
 Certificate issued JAN 22 1987 Vol. 51, page 55433

DESCRIPTION OF WATER RIGHT

Name of stream Tennile Creek
 Trib. of _____ County of Douglas
 Use irrigation
 Quantity of water _____ No. of acres 16
 Name of ditch _____
 Date of priority _____
 In name of _____
 _____ Adjudication, Vol. _____, page _____
 App. No. 20495 Per. No. 15999 Cert. No. 21152
 Certificate cancelled _____
 Notation made on record by _____

FEES PAID

Date	Amount	Receipt No.
<u>3/30/77</u>	<u>33.00</u>	<u>59399</u>
<u>5-26-77</u>	<u>2.00</u>	<u>60807</u>
TOTAL . . .		
	Cert. Fee	

FEES REFUNDED

Date	Amount	Check No.


REMARKS

TO BE ENTERED WHERE CHECKED	INDEX CARDS:		Entered	Checked
	WH	Name	<input checked="" type="checkbox"/>	<input type="checkbox"/>
	WH	Stream	<input checked="" type="checkbox"/>	<input type="checkbox"/>
	WH	Pt. of Div.	<input type="checkbox"/>	<input type="checkbox"/>
	WH	Calendar	<input checked="" type="checkbox"/>	<input type="checkbox"/>
CHECKED TO RECORDS:				
	TX	Twp. & Rce.	<input type="checkbox"/>	<input type="checkbox"/>
		Decree-vault	<input type="checkbox"/>	<input type="checkbox"/>
		Decree-safe	<input type="checkbox"/>	<input type="checkbox"/>
	<input checked="" type="checkbox"/>	Cert. of W/R	<input checked="" type="checkbox"/>	<input type="checkbox"/>
	<input checked="" type="checkbox"/>	Per. Folder	<input checked="" type="checkbox"/>	<input type="checkbox"/>
		Chaindex	<input type="checkbox"/>	<input type="checkbox"/>
		Cross Ref.	<input type="checkbox"/>	<input type="checkbox"/>
		Power Claim	<input type="checkbox"/>	<input type="checkbox"/>
	<input checked="" type="checkbox"/>	Abstracts	<input checked="" type="checkbox"/>	<input type="checkbox"/>

Carver phoned Mr Teel 5/24/77
re need for add \$2⁰⁰ fees.

He will send it. *Just*

T.28S., R.7W., W.M.

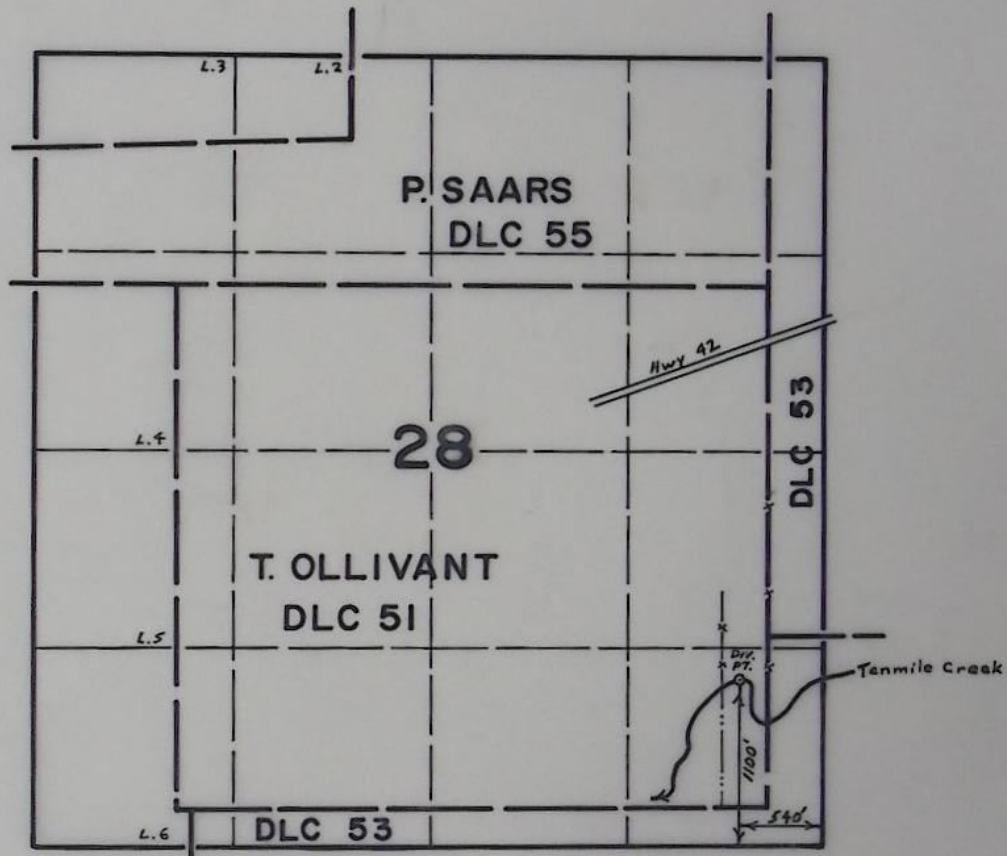

SCALE 4"=1 mile

FINAL PROOF SURVEY

UNDER


Transfer no. 3607

Application No. Permit No.
IN NAME OF

.....WILLA MAE TEEL.....

Surveyed June 6, 1979, by S. Donaldson.....

T.28S.R.7W.WM

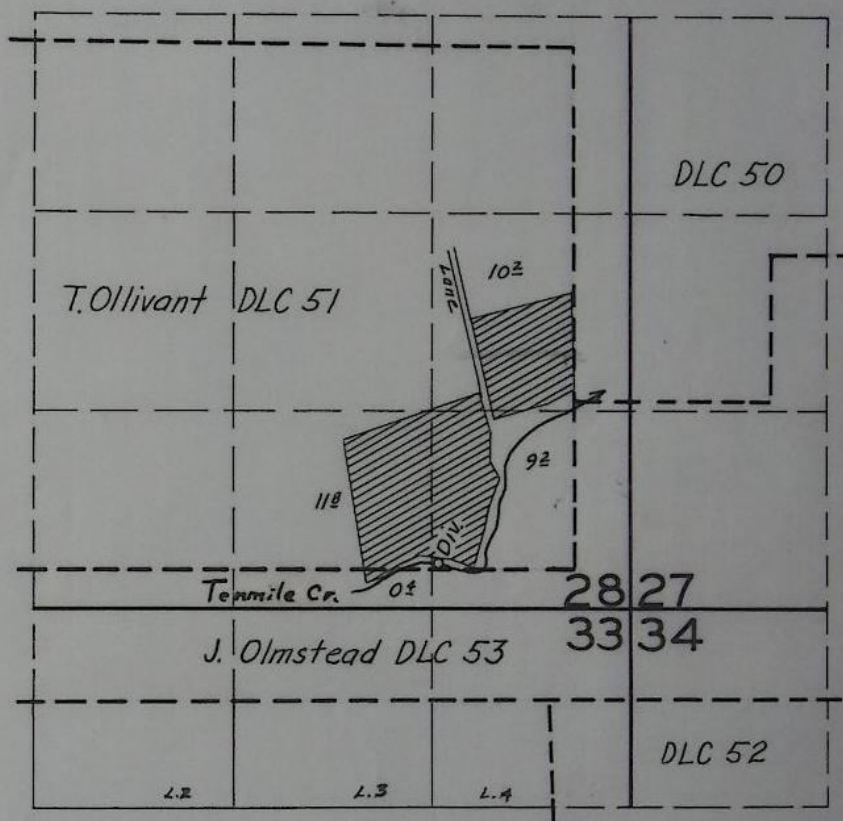

FINAL PROOF SURVEY
UNDER

Application No. 20495 Permit No. 15999
IN NAME OF

James H. Stackhouse

Surveyed July 23, 1954, by T. Jones

STATE OF OREGON

COUNTY OF

DOUGLAS

CERTIFICATE OF WATER RIGHT

This is to certify, That WILLIE MAE TEEL

of PO Box 92, Tenmile, State of OR 97481, has made
proof to the satisfaction of the Water Resources Director, of a right to the use of the waters of
Tenmile Creek

a tributary of Olalla Creek for the purpose of
irrigation of 1.6 acres

under Permit No. 15999 and that said right to the use of said waters has been perfected in
accordance with the laws of Oregon; that the priority of the right hereby confirmed dates from
September 25, 1944

that the amount of water to which such right is entitled and hereby confirmed, for the purposes aforesaid, is
limited to an amount actually beneficially used for said purposes, and shall not exceed

0.02 cubic foot per second, if available at the original point of diversion;
SE 1/4 SE 1/4, as projected within T. Ollivant DLC 51, Section 28, T28S, R7W,
WM; 300 feet North and 1275 feet West from SE corner Section 28

or its equivalent in case of rotation, measured at the point of diversion from the stream. The point of
diversion is located in the SE 1/4 SE 1/4, as projected within T.
Ollivant DLC 51, Section 28, T28S, R7W, WM; 1100 feet North and 540 feet West
from SE corner Section 28.

The amount of water used for irrigation, together with the amount secured under any other right
existing for the same lands, shall be limited to one-eightieth of one cubic foot per second per
acre, or its equivalent for each acre irrigated and shall be
further limited to a diversion of not to exceed 2.5 acre-feet per acre for
each acre irrigated during the irrigation season of each year,

and shall
conform to such reasonable rotation system as may be ordered by the proper state officer.

A description of the place of use under the right hereby confirmed, and to which such right is
appurtenant, is as follows:

1.6 acres S 1/4 NE 1/4 SE 1/4
Section 28
Township 28 South, Range 7 West, WM

This certificate is issued to confirm a change in point of diversion approved
by an order of the Water Resources Director entered May 31, 1977, and together
with certificate of water right recorded at page 48648, Volume 42, State
Record of Water Right Certificates, supersedes certificate of water right
recorded at page 21152, Volume 15.

The issuance of this superseding certificate does not confirm the status of
the water right in regard to the provisions of ORS 540.610 pertaining to
forfeiture or abandonment.

The right to the use of the water for the purposes aforesaid is restricted to the lands or place of use
herein described and is subject to minimum flows established by the Water Resources Commission with an
effective date prior to this right.

WITNESS the signature of the Water Resources Director, affixed

this date. January 22, 1987

William N. Young
Water Resources Director

Recorded in State Record of Water Right Certificates, Volume 51, page 55433

8145D/TS
T-3607

BEFORE THE WATER RESOURCES DIRECTOR OF OREGON

Douglas County

IN THE MATTER OF THE APPLICATION }
OF WILLA MAE TEEL FOR APPROVAL OF A }
CHANGE IN POINT OF DIVERSION OF }
WATER FROM TENMILE CREEK }

ORDER APPROVING
TRANSFER NO. 3607

On March 30, 1977, Willa Mae Teel filed an application in the office of the Water Resources Director for approval of a change in point of diversion under an existing water right of record, pursuant to the provisions of ORS 540.510 to 540.530.

The certificate recorded at Page 21152, Volume 15, State Record of Water Right Certificates, in the name of James R. Stackhouse, describes a right which includes the use of not to exceed 0.02 cubic foot per second from Tenmile Creek for irrigation of 1.6 acres in $S\frac{1}{4}$ NE $\frac{1}{4}$ SE $\frac{1}{4}$ of Section 28, Township 28 South, Range 7 West, W.M., with a date of priority of September 25, 1944.

Water for the said right is diverted from a point located 300 feet North and 1275 feet West from the Southeast corner of Section 28, being within the SE $\frac{1}{4}$ SE $\frac{1}{4}$ of said Section 28.

The applicant herein, contract buyer of the lands above described, proposes to change the point of diversion and, without loss of priority, to divert from a point located 1270 feet North and 540 feet West from the Southeast corner of Section 28, being within the SE $\frac{1}{4}$ SE $\frac{1}{4}$ of Section 28, Township 28 South, Range 7 West, W.M.

Mr. M. John Youngquist, Watermaster, has filed a statement to the effect that the proposed change in point of diversion may be made without injury to existing rights.

No objection having been filed and it appearing that the proposed change in point of diversion may be made without injury to existing rights, the application should be approved.

NOW, THEREFORE, it hereby is ORDERED that the requested change in point of diversion from Tenmile Creek described herein, without loss of priority, is approved.

It is FURTHER ORDERED that the quantity of water diverted at the new point of diversion shall not exceed the quantity of water available at the old point of diversion under the subject right, and shall not exceed 0.02 cubic foot per second.

It is FURTHER ORDERED that the following provisions shall be effective when in the judgement of the watermaster it becomes necessary to install head-gates and measuring devices:

That the diversion works shall include an in line flow meter, a weir, or other suitable device for measuring the water to which the applicant is entitled;

That the type and plans of the measuring device be approved by the watermaster before the beginning of construction work and that the weir or measuring device be installed under the general supervision of said watermaster.

It is FURTHER ORDERED that the construction work shall be completed and the change in point of diversion of water made on or before October 1, 1978.

An administrative order of the Water Resources Director approving transfer application No. 3444 provides for cancelation of the certificate recorded at Page 21152, Volume 15, State Record of Water Right Certificates.

It is FURTHER ORDERED that upon proof satisfactory to the Water Resources Director of completion of works and beneficial use of water to the extent intended under the provisions of this order, a confirming certificate of water right shall be issued to the applicant herein.

Dated at Salem, Oregon, this 31st day of May, 1977.

/s/ JAMES E. SEXSON
Director

STATE OF OREGON
COUNTY OF DOUGLAS

CERTIFICATE OF WATER RIGHT

This Is to Certify, That JAMES R. STACKHOUSE

of Tenmile, State of Oregon, has made proof to the satisfaction of the STATE ENGINEER of Oregon, of a right to the use of the waters of Tenmile Creek, a tributary of Looking Glass Creek, a tributary of S. Umpqua River for the purpose of irrigation under Permit No. 75949 of the State Engineer, and that said right to the use of said waters has been perfected in accordance with the laws of Oregon; that the priority of the right hereby confirmed dates from September 25, 1944,

that the amount of water to which such right is entitled and hereby confirmed, for the purposes aforesaid, is limited to an amount actually beneficially used for said purposes, and shall not exceed 0.313 cubic foot per second,

or its equivalent in case of rotation, measured at the point of diversion from the stream. The point of diversion is located in the SE¹ SE¹, as projected within T. Ollivant L.L.C. No. 51, Section 28, Township 28 South, Range 7 West, S. W.

The amount of water used for irrigation, together with the amount secured under any other right existing for the same lands, shall be limited to one-eightieth of one cubic foot per second per acre, or its equivalent for each acre irrigated and shall be further limited to a diversion of not to exceed 2¹/₂ acre feet per acre for each acre irrigated during the irrigation season of each year,

and shall conform to such reasonable rotation system as may be ordered by the proper state officer.

A description of the place of use under the right hereby confirmed, and to which such right is appurtenant, is as follows:

4.0 acres in the S¹/₂ NE¹/₂ SE¹/₂
11.8 acres in the E¹/₂ SE¹/₂ SE¹/₂
9.2 acres in the W¹/₂ SE¹/₂ SE¹/₂
All as projected within T. Ollivant L.L.C. No. 51
Section 28
Township 28 South, Range 7 West, S. W.

The right to the use of the water for the purposes aforesaid is restricted to the lands or place of use as described.

WITNESS the signature of the State Engineer, affixed

this 5th day of April, 1956.

WILLIAM A. STANLEY State Engineer