

3807

Name Bryan H. & Helen O. Fronabarger

By C O I D

Address _____

DESCRIPTION OF WATER RIGHT

FEES PAID

Name of stream Deschutes Riv.

Trib. of _____ County of Deschutes

Use Irr.

Quantity of water _____ No. of acres 60

Name of ditch Central Oregon Canal

Date of priority _____

In name of E. W. Paul

Deschutes Adjudication, Vol. 16, page 66

App. No. _____ Per. No. _____ Cert. No. 29052

Certificate cancelled _____

Notation made on record by _____

Date	Amount	Receipt No.
<u>9-28-77</u>	<u>\$ 30-</u>	<u>64152</u>
TOTAL . . .		
	Cert. Fee	

Change in POU

Date filed 9-28-77

Date of hearing _____

Place of hearing _____

Date of order 11-6-78 Vol. 31, page 386

Date for application of water 10-1-80

Proof mailed AUG 27 1984 ^{Green} _{Foster}

Proof received 9-27-84

Certificate issued _____ Vol. _____, page _____

FEES REFUNDED

Date	Amount	Check No.

Surveyed 8-16-84 (Foster & Green) ^{to survey 10/80}
8/14/84

REMARKS

GREEN PORTION - FINIS 9/27/84



W.R.I.S.	
Assembled <u>6-25-85</u> by <u>SOA</u>	
Entered _____ by _____	
Verified _____ by _____	

TO BE ENTERED WHERE CHECKED	<input checked="" type="checkbox"/>	INDEX CARDS:	Entered	Checked
	<input checked="" type="checkbox"/>	Name	<u>lg</u>	_____
	<input checked="" type="checkbox"/>	Stream	<u>lg</u>	_____
	<input checked="" type="checkbox"/>	Pt. of Div.	<u>lg</u>	_____
	<input checked="" type="checkbox"/>	Calendar	<u>lg</u>	_____
	<input checked="" type="checkbox"/>	Twp. & Rge.	<u>lg</u>	_____
	<input checked="" type="checkbox"/>	Decree-vault	<u>just</u>	<u>lg</u>
	<input checked="" type="checkbox"/>	Decree-safe	<u>lg</u>	_____
	<input checked="" type="checkbox"/>	Cert. of W/R	<u>lg</u>	_____
	<input checked="" type="checkbox"/>	Per. Folder	<u>lg</u>	_____
<input checked="" type="checkbox"/>	Chaindex	_____	_____	
<input checked="" type="checkbox"/>	Cross Ref.	_____	_____	
<input checked="" type="checkbox"/>	Power Claim	_____	_____	
<input checked="" type="checkbox"/>	Abstracts	<u>lg</u>	_____	

T.17 S., R.13 E., W.M.

SEC. 32

SW 1/4 NW 1/4

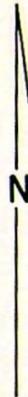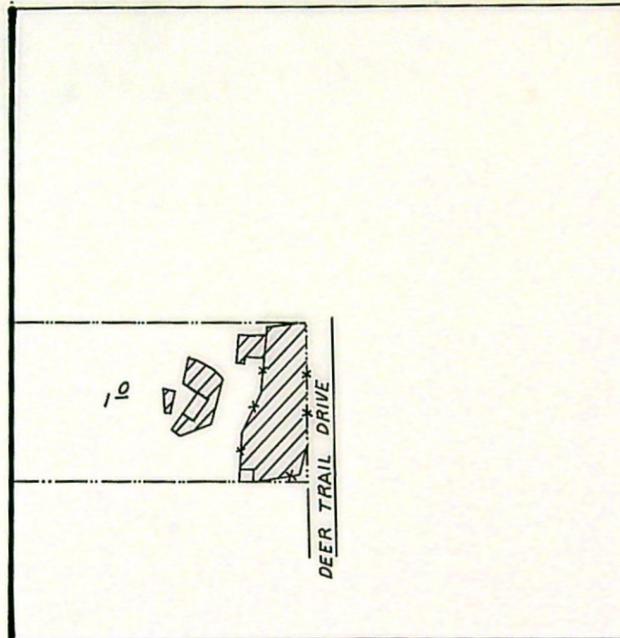

SCALE: 1" = 400'

FINAL PROOF SURVEY

UNDER

PART OF

TRANSFER 3807

Application No. Permit No.

IN NAME OF

.....DAN GREEN, JR. / COID.....

Surveyed AUG. 14... 19.84, by .LESLIE. OLSON....

BEFORE THE WATER RESOURCES DIRECTOR OF OREGON

DESCHUTES COUNTY

IN THE MATTER OF THE APPLICATION OF)
BRYAN H. & HELEN O. FRONABARGER)
(CENTRAL OREGON IRRIGATION DISTRICT))
FOR APPROVAL OF A CHANGE IN PLACE)
OF USE OF WATER)

ORDER APPROVING
TRANSFER NO. 3807

On September 28, 1978, an application was filed in the office of the Water Resources Director by Bryan H. and Helen O. Fronabarger for approval of a change in place of use from Deschutes River, pursuant to the provisions of ORS 540.510 to 540.530.

By Decree of the Circuit Court for Deschutes County, Oregon, entered September 30, 1958, In the Matter of the Determination of the Relative Rights to the Use of the waters of Deschutes River and Its Tributaries, a water right was allowed in the name of Central Oregon Irrigation District for the use of the waters of Deschutes River for irrigation of, among other lands, a certain 6.0 acres in NE $\frac{1}{4}$ NE $\frac{1}{4}$ of Section 10, Township 18 South, Range 12 East, W.M., being tabulated in the name of E. W. Paul at Volume 16, page 66, with dates of priority of October 31, 1900 and December 1, 1907, as evidenced by certificate of water right recorded at page 29052, Volume 21, State Record of Water Right Certificates. These lands also have a supplemental right under permit No. 23256 to the use of water stored in Crane Prairie Reservoir with a date of priority of February 28, 1913. These lands are irrigated by means of the Central Oregon Canal.

The applicants herein, owners of the lands above described, propose to transfer the water right therefrom, without loss of priority, to a certain 5.0 acres in NE $\frac{1}{4}$ NW $\frac{1}{4}$ of Section 3, Township 18 South, Range 13 East, W.M.; and 1.0 acre in SW $\frac{1}{4}$ NW $\frac{1}{4}$ of Section 32, Township 17 South, Range 13 East, W.M.

The lands involved herein are within the boundaries of the Central Oregon Irrigation District and the Board of Directors of said District approved the proposed change in place of use of water at a regular meeting held June 1, 1977.

No objections having been filed and it appearing that the proposed change in place of use of water may be made without injury to existing rights, the application should be approved.


D31, P356

NOW, THEREFORE, it hereby is ORDERED that the requested change in place of use, as described herein, without loss of priority, is approved.

It is FURTHER ORDERED that said water so transferred shall be applied to beneficial use on or before October 1, 1980.

It is FURTHER ORDERED that upon receipt of proof satisfactory to the Water Resources Director of complete application of water to beneficial use on the lands to which the water right is transferred hereby, a certificate of water right shall be issued to Central Oregon Irrigation District confirming this and prior changes within the District.

Dated at Salem, Oregon, this 6th day of November, 1978.

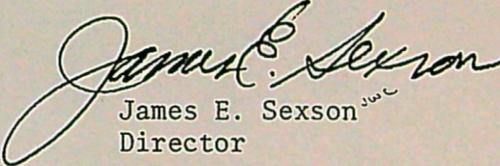
James E. Sexson
Director