

3760 JOHNSON

3760

Name Hulette Johnson

By \_\_\_\_\_

Address Rt 2, Box 237

Milton-Freewater, OR 97162

Change in POU

Date filed August 18, 1977

Date of hearing \_\_\_\_\_

Place of hearing \_\_\_\_\_

Date of order 12-8-77 Vol. 30, page 159

Date for application of water 10-1-79

Proof mailed \_\_\_\_\_

Proof received \_\_\_\_\_

Certificate issued May 2, 1980 Vol. 43, page 49219

OK Cert

# DESCRIPTION OF WATER RIGHT

Name of stream Little Walla Walla River

Trib. of \_\_\_\_\_ County of Umatilla

Use Irr

Quantity of water \_\_\_\_\_ No. of acres 50

Name of ditch Forsythe - Lytle

Date of priority 1886

In name of W. V. Staley

Walla Walla Adjudication, Vol. 12, page 237

App. No. \_\_\_\_\_ Per. No. \_\_\_\_\_ Cert. No. 13225

Certificate cancelled \_\_\_\_\_

Notation made on record by \_\_\_\_\_

## FEE PAID

Date	Amount	Receipt No.
<u>8-18-77</u>	<u>30-</u>	<u>63338</u>
TOTAL . . .		
	Cert. Fee	

## FEE REFUNDED

Date	Amount	Check No.

## REMARKS

W.R.I.S.

Assembled 6-21-85 by SKH


Entered \_\_\_\_\_ by \_\_\_\_\_

Verified \_\_\_\_\_ by \_\_\_\_\_

INDEX CARDS:	Entered	Checked
<input checked="" type="checkbox"/> Name	<u>lg</u>	_____
<input checked="" type="checkbox"/> Stream	<u>lg</u>	_____
<input checked="" type="checkbox"/> Pt. of Div.	<u>lg</u>	_____
<input checked="" type="checkbox"/> Calendar	<u>lg</u>	_____
CHECKED TO RECORD		
<input checked="" type="checkbox"/> Trp. & Rge.	<u>lg</u>	<u>lg</u>
<input checked="" type="checkbox"/> Decree-vault	<u>lg</u>	_____
<input checked="" type="checkbox"/> Decree-safe	<u>lg</u>	_____
<input checked="" type="checkbox"/> Cert. of W/R	<u>lg</u>	_____
Per. Folder	_____	_____
Chaindex	_____	_____
Gross Ref.	_____	_____
Power Claim	_____	_____
<input checked="" type="checkbox"/> Abstracts	<u>lg</u>	_____

TO BE ENTERED WHERE CHECKED

T. 6N. R. 35E. W.M.

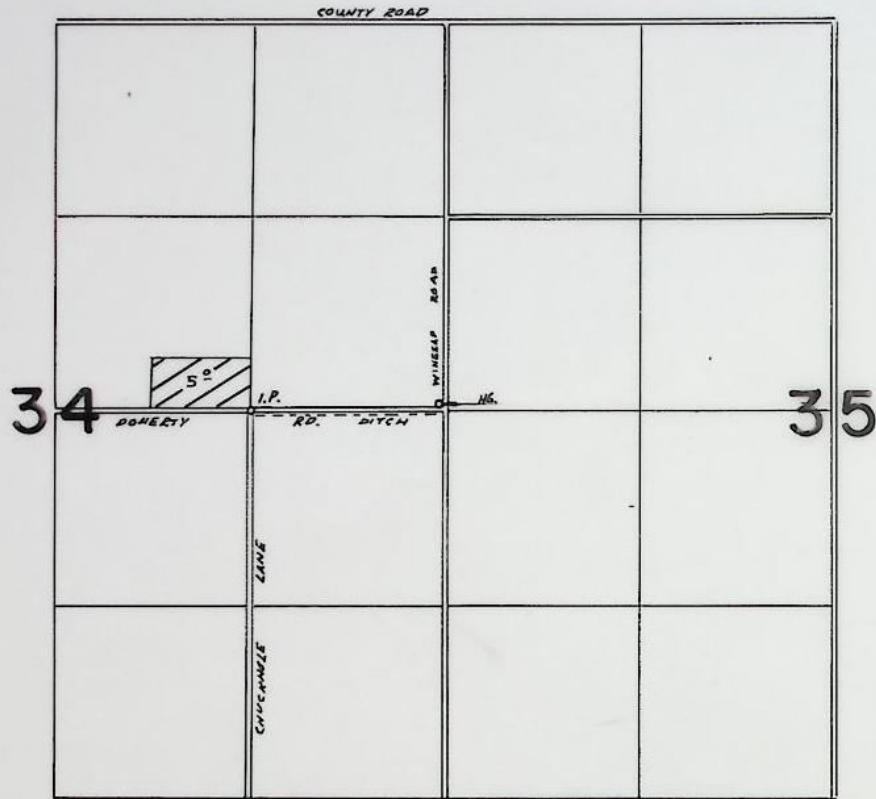

**FINAL PROOF SURVEY**  
UNDER

**TRANSFER 3760**

Application No. .... Permit No. ....  
IN NAME OF

**HULETTE JOHNSON**

Surveyed 6-26-1979, by V. CHURCH

## STATE OF OREGON

COUNTY OF UMATILLA

## CERTIFICATE OF WATER RIGHT

This Is to Certify, That HUELETTE JOHNSONW. V. STALEY

Route 2, Box 237

of R. #2, Freewater, State of Oregon 97862, has a right to the use ofMILTON - FREEWATERthe waters of Little Walla Walla River, TRIB. WALLA WALLA RIVERfor the purpose of Irrigation of 5.0 ACRES

and that said right has been confirmed by decree of the Circuit Court of the State of Oregon for Umatilla County, and the said decree entered of record at Salem, in the Order Record of the STATE ENGINEER, in Volume 12, at page 9; that the priority of the right thereby confirmed dates from 1886;

that the amount of water to which such right is entitled, for the purposes aforesaid, is limited to an amount actually beneficially used for said purposes, and shall not exceed one and one-half miner's inches per acre measured at the point of diversion.

A description of the lands irrigated under such right, and to which the water is appurtenant (or, if for other purposes, the place where such water is put to beneficial use), is as follows:

5.0 acres SW 1/4 NE 1/4Section 33, 34

T. 6 N., R. 35 E. W. M., being within the following described tract: Commencing at the quarter-section corner on the line between Secs. 33 and 34, and running thence north 20 chains; thence west 33.16 chains; thence S. 50° 30' E. 32.16 chains; thence east 7 chains to the place of beginning, being part of the S 1/2 of NE 1/4, Sec. 33, T. 6 N., R. 35 E. W. M., RESERVING therefrom the NE 1/4 of the SE 1/4 of said Sec. 33.

This certificate is issued to confirm a change in place of use and point of diversion approved by an order of the WRD entered Dec. 8, 1977 and supersedes certificate of water right recorded on page 13225, Volume 11, SRWRC.

AND said right shall be subject to all other conditions and limitations contained in said decree.

The right to the use of the water for irrigation purposes is restricted to the lands or place of use herein described.

WITNESS the signature of the State Engineer,

affixed this 5th day

of April, 1940.

CHAS. E. STRICKLIN

State Engineer.

Recorded in State Record of Water Right Certificates, Volume 11, page 13225.

P.O.D.: NE 1/4 SW 1/4 Section 35, T. 6 N., R. 35 E., W. M.  
10 feet South and 650 feet West from the Center, Section 35

OK  
UP

BEFORE THE WATER RESOURCES DIRECTOR OF OREGON

UMATILLA COUNTY

IN THE MATTER OF THE APPLICATION )  
OF HULETTE JOHNSON FOR APPROVAL OF )  
A CHANGE IN PLACE OF USE OF WATER )  
FROM LITTLE WALLA WALLA RIVER )  
-----

ORDER APPROVING  
TRANSFER NO. 3760

On August 18, 1977, an application was filed in the office of the Water Resources Director by Hulette Johnson for a change in place of use under an existing water right of record, pursuant to the provisions of ORS 540.510 to 540.530.

The certificate recorded at page 13225, Volume 11, State Record of Water Right Certificates, in the name of W. V. Staley, describes a right for the use of not to exceed 0.19 cubic foot per second from Little Walla Walla River for irrigation of 5.0 acres in SE $\frac{1}{4}$  NE $\frac{1}{4}$  of Section 33, Township 6 North, Range 35 East, W.M., with a date of priority of 1886.

Water for the said right is diverted, through the Forsythe, Lytle Ditch, from a point located 10 feet South and 650 feet <sup>WEST</sup> East from the Center Corner of Section 35, being within the NE $\frac{1}{4}$  SW $\frac{1}{4}$  of Section 35, Township 6 North, Range 35 East, W.M.

The applicant herein, owner of the lands above described, proposes to change the place of use therefrom and, without loss of priority, to irrigate in lieu thereof 5.0 acres in S $\frac{1}{2}$  SE $\frac{1}{4}$  SW $\frac{1}{4}$  NE $\frac{1}{4}$  of Section 34, Township 6 North, Range 35 East, W.M.

Mr. William I. Porfily, Watermaster, has filed a statement to the effect that the proposed change in place of use may be made without injury to existing rights.


No objections having been filed and it appearing that the proposed change in place of use may be made without injury to existing rights, the application should be approved.

NOW, THEREFORE, it hereby is ORDERED that the requested change in place of use as described herein, without loss of priority, is approved.

It is FURTHER ORDERED that said water so transferred shall be applied to beneficial use on or before October 1, 1979.

It is FURTHER ORDERED that the certificate of water right heretofore issued to W.V. Staley and recorded at page 13225, Volume 11, State Record of Water Right Certificates, is canceled, and upon proof satisfactory to the Water Resources Director of completion of works and beneficial use of water to the extent intended under the provisions of this order, a confirming certificate of water right shall be issued to the applicant herein.

Dated at Salem, Oregon, this 8th day of December, 1977.

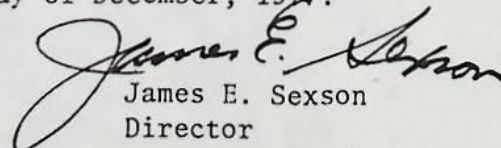  
James E. Sexson  
Director