

3837 COOPER
(Squaw Creek I.D.)

Name Glenn L. Cooper
By (Squaw Creek I. D.)
Address Rt 1, Box 252
Terrebonne, OR 97760

3837
DESCRIPTION OF WATER RIGHT

Name of stream Squaw Creek
Trib. of _____ County of Jefferson
Use Irr.
Quantity of water _____ No. of acres 91⁰
Name of ditch Black Butte Ditch
Date of priority 1904
In name of Squaw Creek I. D.
Squaw Creek Adjudication, Vol. _____, page _____
App. No. _____ Per. No. _____ Cert. No. 850a
Certificate cancelled _____
Notation made on record by _____

Change in POU
Date filed 11-15-77
Date of hearing _____
Place of hearing _____
Date of order 3-16-78 Vol. 30, page 473
Date for application of water 10-1-79
Proof mailed _____
Proof received 2-9-87
Certificate issued _____ Vol. _____, page _____

SUR REG. 3-26-80
2-26-80

REMARKS

CARD FOR C DEC 26 1979

FINIS See F-2496

W.R.I.S.
Assembled 6-25-85 by SM
Entered _____ by _____
Verified _____ by _____

FEEES PAID

Date	Amount	Receipt No.
<u>9-15-77</u>	<u>45.25</u>	<u>63874</u>
TOTAL		
	Cert. Fee	

FEEES REFUNDED

Date	Amount	Check No.
------	--------	-----------

INDEX CARDS: Entered Checked

<input checked="" type="checkbox"/>	Name	<u>lgj</u>	_____
<input checked="" type="checkbox"/>	Stream	<u>lgj</u>	_____
<input checked="" type="checkbox"/>	Pt. of Div.	<u>lgj</u>	_____
<input checked="" type="checkbox"/>	Calendar	<u>lgj</u>	_____
CHECKED TO RECORDS:			
<input checked="" type="checkbox"/>	Twp. & Rge.	<u>lgj</u>	_____
<input checked="" type="checkbox"/>	Acres-wait	<u>lgj</u>	_____
<input checked="" type="checkbox"/>	Acres-sec	<u>lgj</u>	_____
<input checked="" type="checkbox"/>	Cont. of W/R	<u>lgj</u>	_____
<input type="checkbox"/>	Per. Order	_____	_____
<input type="checkbox"/>	Order	_____	_____
<input type="checkbox"/>	Cont. W/R	_____	_____
<input type="checkbox"/>	Per. Order	_____	_____
<input checked="" type="checkbox"/>	Abstract	<u>lgj</u>	_____

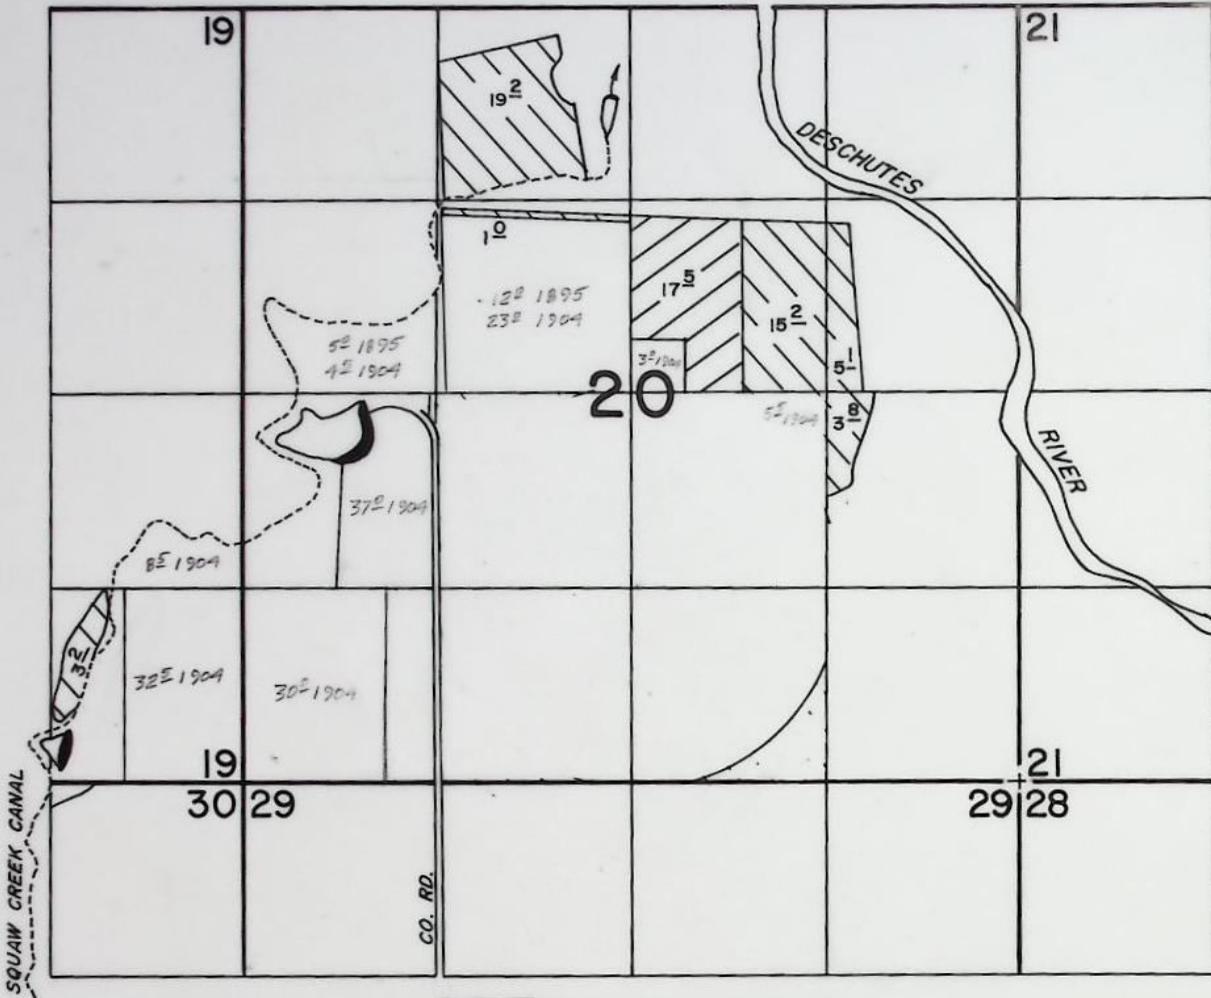
JWC Entered in Squaw Cr. map book

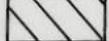
378

3-9-78

Cooper sending affidavit to clear 1912 right
under C# 2398 (A# 2565) from Sec. 20.

T.13S. R.12E. W.M.



 T 2496
 T 3837

FINAL PROOF SURVEY
UNDER

TRANSFERS NO. 2496 & 3837

Application No. Permit No.
IN NAME OF

GLENN L. COOPER

Surveyed MAY 8 1980, by L.H. NUNN

BEFORE THE WATER RESOURCES DIRECTOR OF OREGON

JEFFERSON COUNTY

IN THE MATTER OF THE APPLICATION)
OF GLENN L. COOPER (SQUAW CREEK)
IRRIGATION DISTRICT) FOR APPROVAL)
OF CHANGES IN PLACE OF USE OF)
WATER FROM SQUAW CREEK)

ORDER APPROVING
TRANSFER NO. 3837

On November 15, 1977, an application was filed in the office of the Water Resources Director by Glenn L. Cooper for approval of changes in place of use of water from Squaw Creek, pursuant to the provisions of ORS 540.510 to 540.530.

By Decree of the Circuit Court for Crook County, Oregon, entered May 1, 1911, In the Matter of the Determination of the Relative Rights to the Use of the Waters of Squaw Creek, a water right was established in the name of Squaw Creek Irrigation Company (now Squaw Creek Irrigation District) for the use of the waters of Squaw Creek for the irrigation of, among other lands, 5.0 acres in SW $\frac{1}{4}$ SW $\frac{1}{4}$ of Section 20, Township 13 South, Range 12 East, W.M., tabulated in the name of Sarah Thomson, with a date of priority of November, 1904, as evidenced by the certificate recorded at page 302, Volume 1, State Record of Water Right Certificates. (Vol. 1, P. 302)

The applicant herein proposes to transfer said water right from the above described 5.0 acres in SW $\frac{1}{4}$ SW $\frac{1}{4}$ of said Section 20, without loss of priority, to a certain 5.0 acres in NE $\frac{1}{4}$ SE $\frac{1}{4}$ of said Section 20.

By Decree of the Circuit Court for Crook County, Oregon, entered September 19, 1914, In the Matter of the Determination of the Relative Rights to the Use of the Waters of Squaw Creek, a water right was established in the name of Squaw Creek Irrigation Company (now Squaw Creek Irrigation District) for the use of water of Squaw Creek for the irrigation of, among other lands, 39.5 acres in NE $\frac{1}{4}$ SW $\frac{1}{4}$, 5.0 acres in SW $\frac{1}{4}$ SW $\frac{1}{4}$, 10.0 acres in SE $\frac{1}{4}$ SW $\frac{1}{4}$ and 3.0 acres in NW $\frac{1}{4}$ SE $\frac{1}{4}$ of Section 20, Township 13 South, Range 12 East, W.M., tabulated in the name of Black Butte Land Company, with a date of priority of 1904, as evidenced by the certificate recorded at page 850 (a), Volume 1, State Record of Water Right Certificates. (Vol. 1, P. 850)

The applicant herein proposes to transfer said water right from the above described 39.5 acres in NE $\frac{1}{4}$ SW $\frac{1}{4}$, 5.0 acres in SW $\frac{1}{4}$ SW $\frac{1}{4}$, 10.0 acres in SE $\frac{1}{4}$ SW $\frac{1}{4}$ and 3.0 acres in NW $\frac{1}{4}$ SE $\frac{1}{4}$ of said Section 20, without loss of priority, to a certain 19.5 acres in SW $\frac{1}{4}$ NE $\frac{1}{4}$, 11.5 acres in NE $\frac{1}{4}$ NW $\frac{1}{4}$, 9.5 acres in SW $\frac{1}{4}$ NW $\frac{1}{4}$, 1.0 acres in

NE $\frac{1}{4}$ SE $\frac{1}{4}$, 8.5 acres in SW $\frac{1}{4}$ SE $\frac{1}{4}$ of Section 20, and 7.5 acres in SE $\frac{1}{4}$ SE $\frac{1}{4}$ of Section 19, Township 13 South, Range 12 East, W.M.

As modified in accord with the provisions of the order of the State Engineer entered October 23, 1944, approving transfer application No. S-38, a water right previously allowed by Decree of the Circuit Court for Crook County, Oregon, entered September 19, 1914, In the Matter of the Determination of the Relative Rights to the Use of the Waters of Squaw Creek, in the name of Squaw Creek Irrigation Company (now Squaw Creek Irrigation District) and tabulated under the name of Black Butte Land Company, as evidenced by the certificate recorded at page 850(a), Volume 1, State Record of Water Right Certificates, now exists for the use of water from Squaw Creek, with a date of priority of 1904, for the irrigation of, among other lands, a certain 28.5 acres in NW $\frac{1}{4}$ SE $\frac{1}{4}$ of Section 20, Township 13 South, Range 12 East, W.M.

(original)
Vol 1 P 850
SE 1/4
T 13 S R 12 E

The applicant herein proposes to transfer said water right from the above described 28.5 acres in NW $\frac{1}{4}$ SE $\frac{1}{4}$ of said Section 20, without loss of priority, to a certain 28.5 acres in NE $\frac{1}{4}$, NW $\frac{1}{4}$ of said Section 20.

The lands involved herein are within the boundaries of the Squaw Creek Irrigation District and the Board of Directors of said District approved the proposed changes in place of use September 14, 1977.

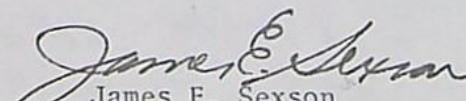
No objections having been filed and it appearing that the proposed changes in place of use of water may be made without injury to existing rights, the application should be approved.

NOW, THEREFORE, it hereby is ORDERED that the requested changes in place of use described herein, without loss of priority, are approved.

It is FURTHER ORDERED that said water so transferred shall be applied to beneficial use on or before October 1, 1979.

It is FURTHER ORDERED that upon receipt of proof satisfactory to the Water Resources Director of complete application of water to beneficial use on the lands to which the water is transferred hereby, certificates of water right will be issued to the Squaw Creek Irrigation District confirming this and prior changes within the District.

Dated at Salem, Oregon, this 16th day of March, 1978.


James E. Sexson
Director

V30, P474

BEFORE THE STATE ENGINEER OF OREGON

Deschutes County

IN THE MATTER OF THE APPLICATION OF)
SQUAW CREEK IRRIGATION DISTRICT)
FOR THE APPROVAL OF A CHANGE IN)
PLACE OF USE OF WATER FROM SQUAW)
CREEK PURSUANT TO THE PROVISIONS OF)
SECTION 116-606, U. C. L. A.)

O R D E R

APPROVING APPLICATION

On September 15, 1944, the Squaw Creek Irrigation District of Sisters, Oregon, filed an application for the approval of a change in place of use of water from Squaw Creek.

By decree of the Circuit Court for Crook County in the matter of the determination of the relative rights to the use of the waters of Squaw Creek and its tributaries a right was recognized in the name of the Squaw Creek Irrigation Company, now Squaw Creek Irrigation District, for the irrigation of, among other lands, 40 acres in the SE $\frac{1}{4}$ NE $\frac{1}{4}$, Section 30, Township 13 South, Range 12 East, W. M., with a date of priority of 1904.

The applicants herein, owners of the above described lands propose to transfer the water right appurtenant thereto without loss of priority to 3 acres in the NW $\frac{1}{4}$ SW $\frac{1}{4}$, and 37 acres in the NW $\frac{1}{4}$ SE $\frac{1}{4}$, Section 20, Township 13 South, Range 12 East, W. M.

The NW $\frac{1}{4}$ SE $\frac{1}{4}$, Section 20, Township 13 South, Range 12 East, W. M., to which it is proposed to transfer water for the irrigation of 37 acres, has a water right from Squaw Creek for the irrigation of 37 acres, with a date of priority of September 9, 1912, said right being evidenced by certificate of water right recorded at Page 2398, Volume 3, State Record of Water Right Certificates. In order that the aggregate area in this tract having a water right will not exceed 40 acres when the transfer is consummated, the board of directors of the Squaw Creek Irrigation District, at a regular meeting held on the 3rd day of October 1944, authorized the cancellation of said 37 acre water right, having a date of priority of September 9, 1912.

Notice by publication as provided by Section 116-606 O. C. L. A., was not given in connection with this application for the reason that said section provides that notice is not required on application for only a change in place of use of water.

All the lands involved herein are within the boundaries of the Squaw Creek Irrigation District.

It appearing that the proposed change in place of use of water may be made without injury to existing rights, the application should be approved.

NOW, THEREFORE, it hereby is ORDERED that the proposed change in place of use of water be and the same hereby is approved and the water right hereinbefore described as appurtenant to 40 acres in the SE $\frac{1}{4}$ NE $\frac{1}{4}$, Section 30, Township 13 South, Range 12 East, W. M., with a date of priority of 1904, be severed therefrom and simultaneously and without loss of priority transferred to 3 acres in the NW $\frac{1}{4}$ SW $\frac{1}{4}$, and 37 acres in the NW $\frac{1}{4}$ SE $\frac{1}{4}$, Section 20, Township 13 South, Range 12 East, W. M.

It is FURTHER ORDERED that complete application of water to beneficial use upon the land to which the water hereby is transferred shall be made on or before October 1, 1946, or such extension of time as may be granted by the State Engineer for good cause shown.

It is FURTHER ORDERED that the water right appurtenant to 37 acres in the NW $\frac{1}{4}$ SE $\frac{1}{4}$, Section 20, Township 13 South, Range 12 East, W. M., with a date of priority of September 9, 1912, be and the same hereby is cancelled and that notations of said cancellation be made on certificate of water right recorded at Page 2398, Volume 3, State Record of Water Right Certificates.

Dated at Salem, Oregon, this 23rd day of October, 1944.

CHAS. E. STRICKLIN
State Engineer