

4006

Name Virginia M. McCain Funkner
 By C.O.I.D.
 Address Po Box 548
Redmond, OR 97756

DESCRIPTION OF WATER RIGHT

Name of stream Deschutes River
 Trib. of _____ County of Deschutes
 Use _____
 Quantity of water _____ No. of acres _____
 Name of ditch Pilot Butte Canal
 Date of priority Oct 31, 1900 & Dec. 2, 1907
 In name of C.O.I.D. Tab in: M.D. Butler
Deschutes Riv. Adjudication, Vol. 16, page 135
 App. No. _____ Per. No. _____ Cert. No. 29052
 Certificate cancelled _____
 Notation made on record by _____

FEEES PAID

Date	Amount	Receipt No.
<u>8-1-78</u>	<u>30-</u>	<u>5191</u>
TOTAL . . .		
	Cert. Fee	

Change in POU
 Date filed Aug. 1, 1978
 Date of hearing _____
 Place of hearing _____
 Date of order 8-15-78 Vol. 31, page 153
 Date for application of water 10-1-79 ^{EXT:} 10-1-81 10-1-82
 P. Cat MAR 17 1989 10-1-83
 Proof mailed _____
 Proof received OK No more!
 Certificate issued _____ Vol. _____, page _____

FEEES REFUNDED

Date	Amount	Check No.

Surveyed 8/22/84 (Weiden)

REMARKS

— finis —

W.R.I.S.



Assembled 6-19-85 by _____

Entered _____ by _____

Verified _____ by _____

TO BE ENTERED WHERE CHECKED	INDEX CARDS:	Entered	Checked
<input checked="" type="checkbox"/>	Name	<u>lgj</u>	_____
<input checked="" type="checkbox"/>	Stream	<u>lgj</u>	_____
<input checked="" type="checkbox"/>	Pt. of Div.	<u>lgj</u>	_____
<input checked="" type="checkbox"/>	Calendar	<u>lgj</u>	_____
<input checked="" type="checkbox"/>	CHECKED TO RECORDS:		
<input checked="" type="checkbox"/>	Twp. & Rge.	<u>lgj</u>	_____
<input checked="" type="checkbox"/>	Decree-vault	<u>lgj</u>	<u>lgj</u>
<input checked="" type="checkbox"/>	Decree-safe	<u>lgj</u>	_____
<input checked="" type="checkbox"/>	Cert. of W/R	<u>lgj</u>	_____
<input type="checkbox"/>	Per. Folder	_____	_____
<input type="checkbox"/>	Chainindex	_____	_____
<input type="checkbox"/>	Cross Ref.	_____	_____
<input type="checkbox"/>	Power Claim	_____	_____
<input checked="" type="checkbox"/>	Abstracts	<u>lgj</u>	_____

T.14S., R.13E., W.M.

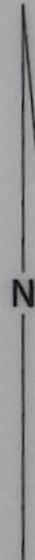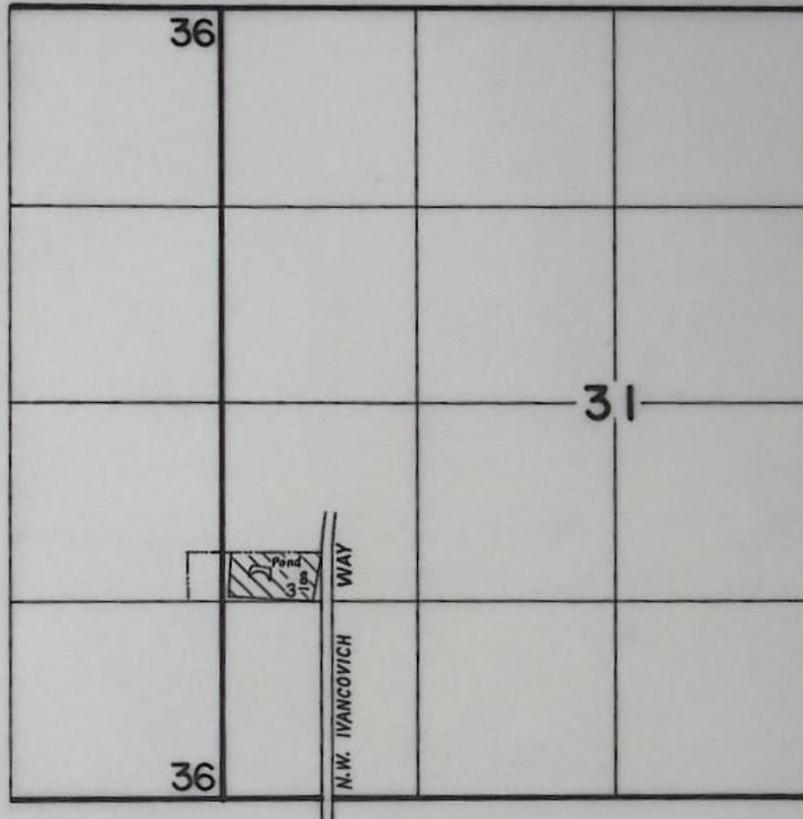

SCALE: 1" = 1320'

FINAL PROOF SURVEY
UNDER

TRANSFER NO. 4006
Application No. Permit No.
IN NAME OF

.....JAMES G. WIEDEN / C.O.I.D.....

Surveyed AUG. 22. 19.84, by LESLIE OLSON...

BEFORE THE WATER RESOURCES DIRECTOR OF OREGON

DESCHUTES COUNTY

IN THE MATTER OF THE APPLICATION OF)
VIRGINIA M. McCOIN FUNKNER (CENTRAL)
OREGON IRRIGATION DISTRICT) FOR AP-)
PROVAL OF A CHANGE IN PLACE OF USE)
OF WATER FROM DESCHUTES RIVER)

ORDER APPROVING
TRANSFER NO. 4006

On August 1, 1978, Virginia M. McCoin Funkner filed an application in the office of the Water Resources Director for approval of a change in place of use of water from Deschutes River, pursuant to the provisions of ORS 540.510 to 540.530.

By Decree of the Circuit Court for Deschutes County, Oregon, entered September 30, 1958, In the Matter of the Determination of the Relative Rights to the Use of the waters of Deschutes River and Its Tributaries, a water right was established in the name of Central Oregon Irrigation District for the use of waters of Deschutes River for the irrigation of, among other lands, a certain 4.0 acres in the NE $\frac{1}{4}$ NW $\frac{1}{4}$ of Section 29, Township 15 South, Range 13 East, W.M., being tabulated in the name of M. D. Butler, with dates of priority of October 31, 1900 and December 2, 1907, as evidenced by the certificate of water right recorded at page 29052, Volume 21, State Record of Water Right Certificates. These lands also have a supplemental right under permit No. 23256 to the use of the water stored in Crane Prairie Reservoir with a date of priority of February 28, 1913. These lands are irrigated by means of the Pilot Butte Canal.

The applicant herein, owner of the lands above described, proposes to transfer the water right therefrom, without loss of priority, to a certain 4.0 acres in NW $\frac{1}{4}$ SW $\frac{1}{4}$ of Section 31, Township 14 South, Range 13 East, W.M. (James Wieden).

The lands involved herein are within the boundaries of the Central Oregon Irrigation District and the Board of Directors of said District approved the pro-

posed change in place of use of water at a regular meeting held March 2, 1977.


No objections having been filed and it appearing that the proposed change in place of use of water may be made without injury to existing rights, the application should be approved.

NOW, THEREFORE, it hereby is ORDERED that the requested change in place of use described herein, without loss of priority, is approved.

It is FURTHER ORDERED that said water so transferred shall be applied to beneficial use on or before October 1, 1979.

It is FURTHER ORDERED that upon receipt of proof satisfactory to the Water Resources Director of complete application of water to beneficial use on the lands to which the water is transferred hereby, a certificate of water right will be issued to Central Oregon Irrigation District confirming this and prior changes within the District.

Dated at Salem, Oregon this 15th day of August, 1978.

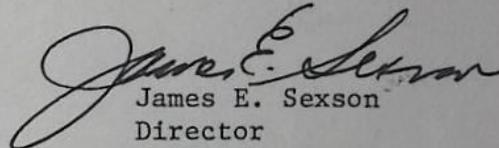
James E. Sexson
Director

110
P154