

4007

Name E.W. Williamson
By C.O.I.D.
Address PO Box 548
Redmond, OR 97756

Change in POU
Date filed Aug. 1, 1978
Date of hearing _____
Place of hearing _____
Date of order 8-15-78 Vol. 31, page 155
Date for application of water 10-1-79
Proof mailed _____
Proof received _____
Certificate issued _____ Vol. _____, page _____

DESCRIPTION OF WATER RIGHT

Name of stream Deschutes River
Trib. of _____ County of Deschutes
Use _____
Quantity of water _____ No. of acres _____
Name of ditch Central Oregon Canal
Date of priority Oct 31, 1900 + Dec 2, 1907
In name of C.O.I.D. tab in: Peder Pederson
Deschutes Riv. Adjudication, Vol. 16, page 54
App. No. _____ Per. No. _____ Cert. No. 29052
Certificate cancelled _____
Notation made on record by _____

FEES PAID

Date	Amount	Receipt No.
<u>8-1-78</u>	<u>30-</u>	<u>5192</u>
TOTAL . . .		
	Cert. Fee	

FEES REFUNDED

Date	Amount	Check No.

HB 3111

to survey 10/79


Surveyed 9/10/84 (Kennel)

REMARKS

W.R.I.S.	
Assembled <u>6-17-85</u> by <u>500</u>	
Entered _____ by _____	
Verified _____ by _____	

TO BE ENTERED WHERE CHECKED	INDEX CARDS:	
	Entered	Checked
<input checked="" type="checkbox"/> Name	<u>lgj</u>	---
<input checked="" type="checkbox"/> Stream	<u>lgj</u>	---
<input checked="" type="checkbox"/> Pt. of Div.	---	---
<input checked="" type="checkbox"/> Calendar	<u>lgj</u>	---
CHECKED TO RECORDS:		
<input checked="" type="checkbox"/> Twp. & Rge.	<u>lgj</u>	---
<input checked="" type="checkbox"/> Decree-vault	<u>lgj</u>	<u>lgj</u>
<input checked="" type="checkbox"/> Decree-safe	<u>lgj</u>	---
<input checked="" type="checkbox"/> Copy of W/R	<u>lgj</u>	---
<input type="checkbox"/> Per. order	---	---
<input type="checkbox"/> Ch/index	---	---
<input type="checkbox"/> Cross Ref.	---	---
<input checked="" type="checkbox"/> Power Claim	---	---
<input checked="" type="checkbox"/> Abstracts	<u>lgj</u>	---

T.18S., R.13E., W.M.

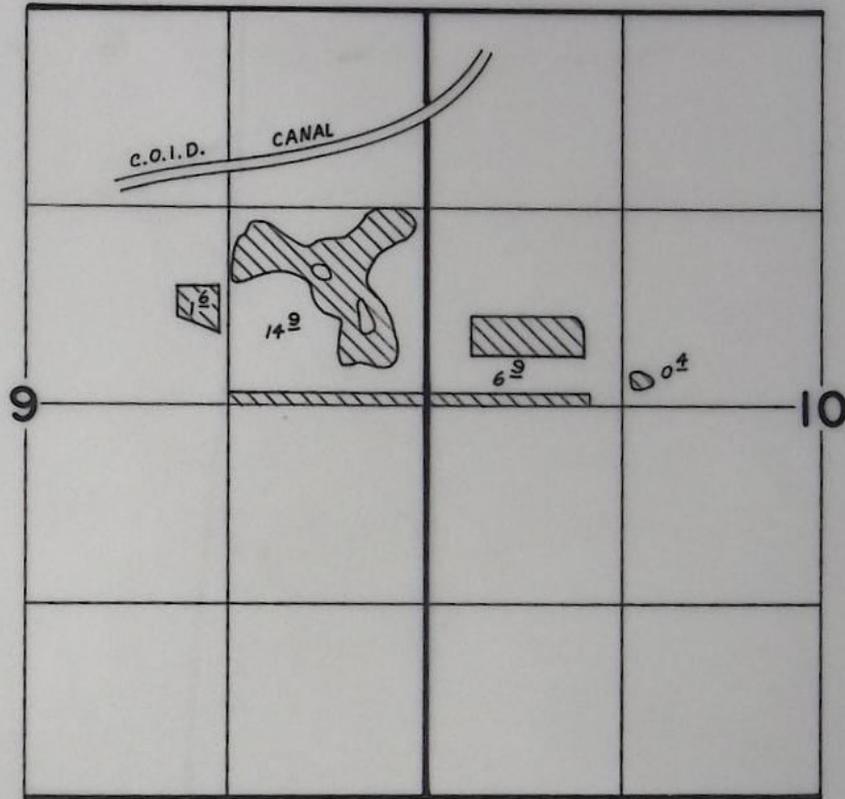

SCALE: 1" = 1320'

FINAL PROOF SURVEY UNDER

TRANSFER NO. 4007
Application No. Permit No.
IN NAME OF

DELMAR KENNEL / C.O.I.D.

Surveyed SEPT. 19. 19.84, by LESLIE OLSON.

BEFORE THE WATER RESOURCES DIRECTOR OF OREGON

DESCHUTES COUNTY

IN THE MATTER OF THE APPLICATION OF)
E. W. WILLIAMSON (CENTRAL OREGON)
IRRIGATION DISTRICT) FOR APPROVAL OF)
A CHANGE IN PLACE OF USE OF WATER)
FROM DESCHUTES RIVER)

ORDER APPROVING
TRANSFER NO. 4007

On August 1, 1978, E. W. Williamson filed an application in the office of the Water Resources Director for approval of a change in place of use of water from Deschutes River, pursuant to the provisions of ORS 540.510 to 540.530.

By Decree of the Circuit Court for Deschutes County, Oregon, entered September 30, 1958, In the Matter of the Determination of the Relative Rights to the Use of the waters of Deschutes River and Its Tributaries, a water right was established in the name of Central Oregon Irrigation District for the use of waters of Deschutes River for the irrigation of, among other lands, a certain 5.0 acres in the NW $\frac{1}{4}$ NE $\frac{1}{4}$, 14.0 acres in the NE $\frac{1}{4}$ SE $\frac{1}{4}$ and 6.0 acres in the NW $\frac{1}{4}$ SE $\frac{1}{4}$ of Section 34, Township 17 South, Range 12 East, W.M., being tabulated in the name of Peder Pederson, with dates of priority of October 31, 1900 and December 2, 1907, as evidenced by the certificate of water right recorded at page 29052, Volume 21, State Record of Water Right Certificates. These lands also have a supplemental right under permit No. 23256 to the use of the water stored in Crane Prairie Reservoir with a date of priority of February 28, 1913. These lands are irrigated by means of the Central Oregon Canal.

The applicant herein, owner of the lands above described, proposes to transfer the water right therefrom, without loss of priority, to a certain 20.0 acres in SE $\frac{1}{4}$ NE $\frac{1}{4}$ of Section 9 and 5.0 acres in SW $\frac{1}{4}$ NW $\frac{1}{4}$ of Section 10, Township 18 South, Range 13 East, W.M. (Del Kennel).

The lands involved herein are within the boundaries of the Central Oregon Irrigation District and the Board of Directors of said District approved the proposed change in place of use of water at a regular meeting held March 2, 1977.


No objections having been filed and it appearing that the proposed change in place of use of water may be made without injury to existing rights, the application should be approved.

NOW, THEREFORE, it hereby is ORDERED that the requested change in place of use described herein, without loss of priority, is approved.

It is FURTHER ORDERED that said water so transferred shall be applied to beneficial use on or before October 1, 1979.

It is FURTHER ORDERED that upon receipt of proof satisfactory to the Water Resources Director of complete application of water to beneficial use on the lands to which the water is transferred hereby, a certificate of water right will be issued to Central Oregon Irrigation District confirming this and prior changes within the District.

Dated at Salem, Oregon this 15th day of August, 1978.

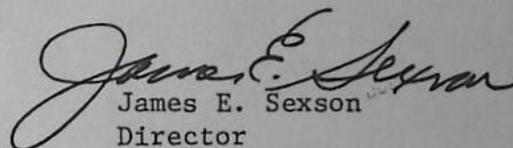
James E. Sexson
Director