

Name John David Pickrel

By \_\_\_\_\_

Address 6303 Fish Hatchery Road  
Grants Pass, OR 97526Change in PODDate filed Aug 16, 1978

Date of hearing \_\_\_\_\_

Place of hearing \_\_\_\_\_

Date of order 9-27-78 Vol. 31, page 266Date for application of water 10-1-80 10-1-81

Proof mailed \_\_\_\_\_

Proof received \_\_\_\_\_

Certificate issued OCT 20 1978 Vol. 39, page 46676  
JUL 10 1985 48 53231

## REMARKS

4024

## DESCRIPTION OF WATER RIGHT

Name of stream Slate CreekTrib. of Applegate River County of JosephineUse irrigationQuantity of water \_\_\_\_\_ No. of acres 3.5

Name of ditch \_\_\_\_\_

Date of priority Sept. 19, 1945In name of Frank C. Sullivan

\_\_\_\_\_ Adjudication, Vol. \_\_\_\_\_, page \_\_\_\_\_

App. No. 21177 Per. No. 16596 Cert. No. 15674

Certificate cancelled \_\_\_\_\_

Notation made on record by \_\_\_\_\_

## FEES PAID

Date	Amount	Receipt No.
<u>8-16-78</u>	<u>35-</u>	<u>5526</u>
TOTAL . . .		
<u>9-21-78</u>	<u>\$2 Cert. Fee</u>	<u>6251</u>

## FEES REFUNDED

Date	Amount	Check No.

CARD FOR C NOV 4 1980

CARD FOR C NOV 20 1981


TO BE ENTERED WHERE CHECKED	INDEX CARDS:		Entered	Checked
<input checked="" type="checkbox"/>	Name		<u>lg</u>	_____
<input checked="" type="checkbox"/>	Stream		<u>lg</u>	_____
<input checked="" type="checkbox"/>	Pt. of Div.		<u>lg</u>	_____
<input checked="" type="checkbox"/>	Calendar		<u>lg</u>	_____
CHECKED TO RECORDS:				
<input checked="" type="checkbox"/>	Twp. & Rge.		<u>lg</u>	_____
<input checked="" type="checkbox"/>	Decree-vault		<u>lg</u>	_____
<input checked="" type="checkbox"/>	Decree-safe		<u>lg</u>	_____
<input checked="" type="checkbox"/>	Cert. of W/R		<u>lg</u>	_____
<input checked="" type="checkbox"/>	Per. Folder		<u>lg</u>	_____
<input checked="" type="checkbox"/>	Chainindex		<u>lg</u>	_____
<input checked="" type="checkbox"/>	Cross Ref.		<u>lg</u>	_____
<input checked="" type="checkbox"/>	Power Claim		<u>lg</u>	_____
<input checked="" type="checkbox"/>	Abstracts		<u>lg</u>	_____

Pickrel

518



T. 37 S., R. 7 W., W.M.

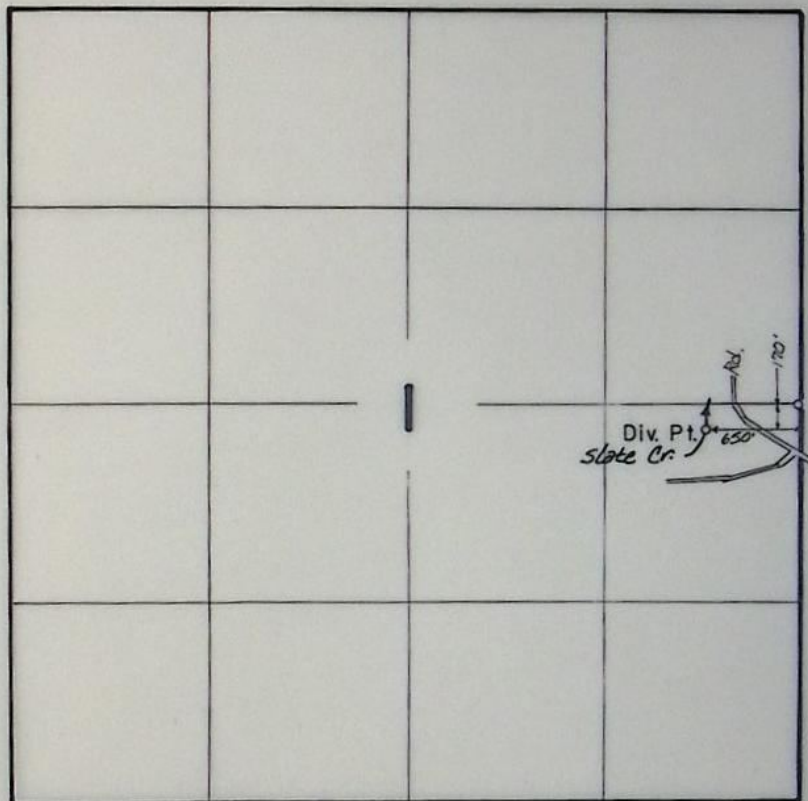

**FINAL PROOF SURVEY**  
UNDER

TRANSFER NO. 4024

IN NAME OF  
**JOHN DAVID PICKREL**

Surveyed AUG. 13, 1982, by B. S. JAMES



## STATE OF OREGON

COUNTY OF JOSEPHINE

## CERTIFICATE OF WATER RIGHT

This Is to Certify, That ~~JOHN DAVID PICKREL~~ ~~FRANK C. SULLIVAN~~

~~6363 FISH HATCHERY Rd., GRANTS PASS, OR 97526~~  
 of ~~1130 Sacramento St., San Francisco, State of California~~, has made proof  
 to the satisfaction of the STATE ENGINEER of Oregon, of a right to the use of the waters of  
~~Slate Creek~~

a tributary of ~~Applegate River~~ for the purpose of  
 irrigation of ~~12.5 acres~~ ~~3.5 ac~~  
 under Permit No. ~~16596~~ of the State Engineer, and that said right to the use of said waters  
 has been perfected in accordance with the laws of Oregon; that the priority of the right hereby  
 confirmed dates from ~~September 19, 1945~~

that the amount of water to which such right is entitled and hereby confirmed, for the purposes  
 aforesaid, is limited to an amount actually beneficially used for said purposes, and shall not exceed

~~0.04~~ ~~0.20~~ cubic foot per second, ~~if available at the original point of diversion~~;  
~~NE 1/4 Sec 1, T. 37 S., R. 7 W., W. M.; 300 ft. south & 1200 ft. W.~~  
~~from the E 1/4 Cor. Sec 1.~~

or its equivalent in case of rotation, measured at the point of diversion from the stream.  
 The point of diversion is located in the ~~NE 1/4 SE 1/4, Section 1, Township 37 South, Range 7 West,~~  
~~W. M.; 300 S. & 1200 W. from the E 1/4 cor Sec 1 170 ft. S. & 650 ft. W.~~  
~~from the E 1/4 Cor. Sec 1.~~

The amount of water used for irrigation, together with the amount secured under any other  
 right existing for the same lands, shall be limited to ~~one-eightieth~~ of one cubic foot per second  
 per acre, or its equivalent for each acre irrigated and shall be further limited to  
 a diversion of not to exceed ~~1 1/2~~ acre feet per acre for each acre irrigated during the  
 irrigation season from April 2, to October 31, of each year,

and shall  
 conform to such reasonable rotation system as may be ordered by the proper state officer.

A description of the place of use under the right hereby confirmed, and to which such right is  
 appurtenant, is as follows:

~~3.5~~ ~~12.5~~ ~~36~~ acres in the ~~NE 1/4 SE 1/4,~~  
 Section 1,  
 T. 37 S., R. 7 W., W. M.

T 4024

3.5  
0.04 cfs

This certificate is issued to confirm a change in ~~place of use and point of~~  
 diversion approved by an order of the Water Resources Director  
 entered ~~9-27-78~~ and together with certificate of water right  
 recorded at page ~~46676~~, Volume ~~39~~, State Record of Water  
 Right Certificates, supersedes certificate ~~15674~~.

The issuance of this superseding certificate does not confirm the status of  
 the water right in regard to the provisions of ORS 540.610 pertaining to  
 forfeiture or abandonment.  
 use heretofore described.

WITNESS the signature of the State Engineer, affixed

this ~~1st~~ day of ~~March~~, 194~~9~~CHAS. E. STRICKLIN  
State EngineerRecorded in State Record of Water Right Certificates, Volume ~~13~~ page ~~15674~~

53231



STATE OF OREGON  
COUNTY OF JOSEPHINE

# CERTIFICATE OF WATER RIGHT

This Is to Certify, That FRANK C. SULLIVAN

of 1130 Sacramento St., San Francisco, <sup>8</sup>State of California, has made proof to the satisfaction of the STATE ENGINEER of Oregon, of a right to the use of the waters of Slate Creek a tributary of Applegate River for the purpose of irrigation of 12.5 acres under Permit No. 16596 of the State Engineer, and that said right to the use of said waters has been perfected in accordance with the laws of Oregon; that the priority of the right hereby confirmed dates from September 19, 1945

that the amount of water to which such right is entitled and hereby confirmed, for the purposes aforesaid, is limited to an amount actually beneficially used for said purposes, and shall not exceed 0.29 cubic foot per second  
0.16

or its equivalent in case of rotation, measured at the point of diversion from the stream. The point of diversion is located in the NE $\frac{1}{4}$  SE $\frac{1}{4}$ , Section 1, Township 37 South, Range 7 West, W. M., 300'S & 1200'W from the E $\frac{1}{4}$  cor Sec 1

The amount of water used for irrigation, together with the amount secured under any other right existing for the same lands, shall be limited to one-eightieth of one cubic foot per second per acre, or its equivalent for each acre irrigated and shall be further limited to a diversion of not to exceed  $4\frac{1}{2}$  acre feet per acre for each acre irrigated during the irrigation season from April 2, to October 31, of each year,

and shall conform to such reasonable rotation system as may be ordered by the proper state officer.

A description of the place of use under the right hereby confirmed, and to which such right is appurtenant, is as follows:

12.5 ~~16~~ acres in the NE $\frac{1}{4}$  SE $\frac{1}{4}$ ,  
Section 1,  
T. 37 S., R. 7 W., W. M.

T 4024  
3.5  
0.094fs

This certificate describes that portion of the water right confirmed by the prior certificate recorded at page 15674, Volume 13, State Record of Water Right Certificates, NOT modified by the provisions of an order of the Water Resources Director entered on Sept 27, 1978, approving transfer application No. 4024.

The issuance of this superseding certificate does not confirm the status of the water right in reference to ORS 540.610.

The right to the use of the water for the purposes aforesaid is restricted to the lands or place of use herein described.

WITNESS the signature of the State Engineer, affixed

this 1st day of March, 1949

CHAS. E. STRICKLIN

State Engineer

Recorded in State Record of Water Right Certificates, Volume 13, page 15674

C-40676

T 4024



BEFORE THE WATER RESOURCES DIRECTOR OF OREGON

JOSEPHINE COUNTY

IN THE MATTER OF THE APPLICATION )  
OF JOHN DAVID PICKREL FOR APPROVAL )  
OF A CHANGE IN POINT OF DIVERSION )  
OF WATER FROM SLATE CREEK )  
-----

ORDER APPROVING  
TRANSFER NO. 4024

On August 15, 1978, an application was filed in the office of the Water Resources Director by John David Pickrel for approval of a change in point of diversion from Slate Creek, pursuant to the provisions of ORS 540.510 to 540.530.

The certificate recorded at page 15674, Volume 13, State Record of Water Right Certificates, in the name of Frank C. Sullivan, describes a right which includes the use of not to exceed 0.04 cubic foot per second from Slate Creek for irrigation of 3.5 acres in NE $\frac{1}{4}$  SE $\frac{1}{4}$  of Section 1, Township 37 South, Range 7 West, W.M., with a date of priority of September 19, 1945.

The authorized point of diversion of record for said right is located 300 feet South and 1200 feet West from the East Quarter Corner of Section 1, being within the NE $\frac{1}{4}$  SE $\frac{1}{4}$  of Section 1, Township 37 South, Range 7 West, W.M.

The applicant herein, owner of the lands above described, proposes to change the point of diversion therefrom, without loss of priority, to a point located 150 feet South and 650 feet West from the East Quarter Corner of Section 1, being within the NE $\frac{1}{4}$  SE $\frac{1}{4}$  of Section 1, Township 37 South, Range 7 West, W.M.

Mr. Robert B. Steimer, Watermaster, has filed a statement to the effect that the proposed change in point of diversion may be made without injury to existing rights.

No objections having been filed and it appearing that the proposed change in point of diversion may be made without injury to existing rights, the application should be approved.

NOW, THEREFORE, it hereby is ORDERED that the requested change in point of diversion, as described herein, without loss of priority, is approved.

It is FURTHER ORDERED that the quantity of water diverted at the new point of diversion shall not exceed the quantity of water available at the old point of diversion under the subject right.

V31, P266



It is FURTHER ORDERED that the following provisions shall be effective when in the judgment of the watermaster it becomes necessary to install headgates and measuring devices:


That the diversion works shall include an in line flow meter, a weir, or other suitable device for measuring the water to which the applicant is entitled;

That the type and plans of the measuring device be approved by the watermaster before the beginning of construction work and that the weir or measuring device be installed under the general supervision of said watermaster.

It is FURTHER ORDERED that the construction work shall be completed and the change in point of diversion of water made on or before October 1, 1980.

It is FURTHER ORDERED that the certificate of water right recorded at page 15674, Volume 13, State Record of Water Right Certificates, is canceled; and in lieu thereof a new certificate be issued covering the balance of the right NOT involved in this proceeding; and upon proof satisfactory to the Water Resources Director of completion of works and beneficial use of water to the extent intended under the provisions of this order, a confirming certificate of water right shall be issued to the applicant herein.

Dated at Salem, Oregon this 27th day of September, 1978.

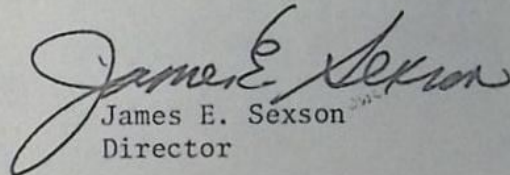  
James E. Sexson  
Director