


Groundwater Registration Modification Application GR 1543 - Case Family LLC

All GR 1543 1950 Priority Date

Township 10S, Range 3W, W.M.

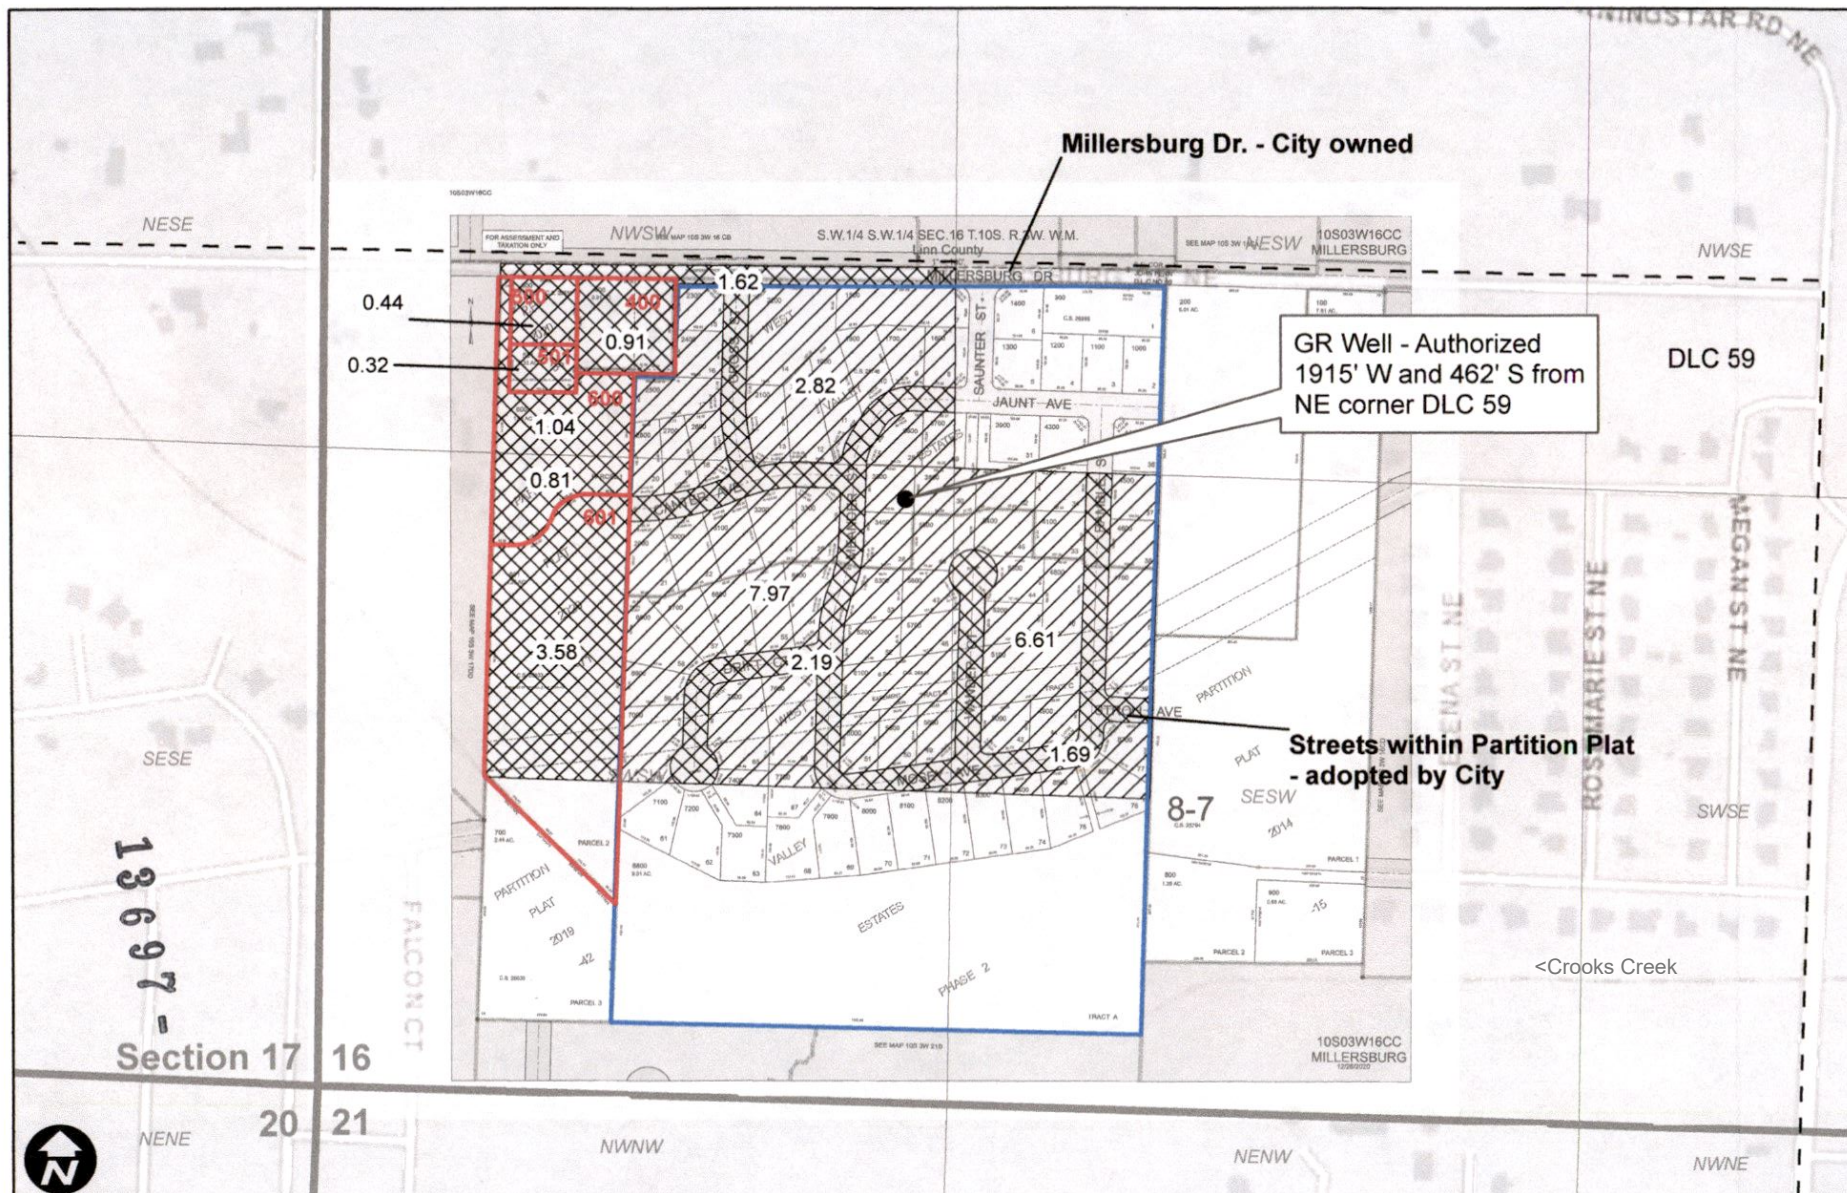

-  GR 1543 - FROM - 12.6 acres Irrigation
-  GR 1543 - No Change - 17.4 acres Irrigation


-  West Valley Estates Partition Plat - - - DLC
-  Tax Lots

0 200 400 800 Feet

SUPERSEDING 8/7/23

Groundwater Registration Modification Application GR 1543 - Case Family LLC

Township 10S, Range 3W, W.M.

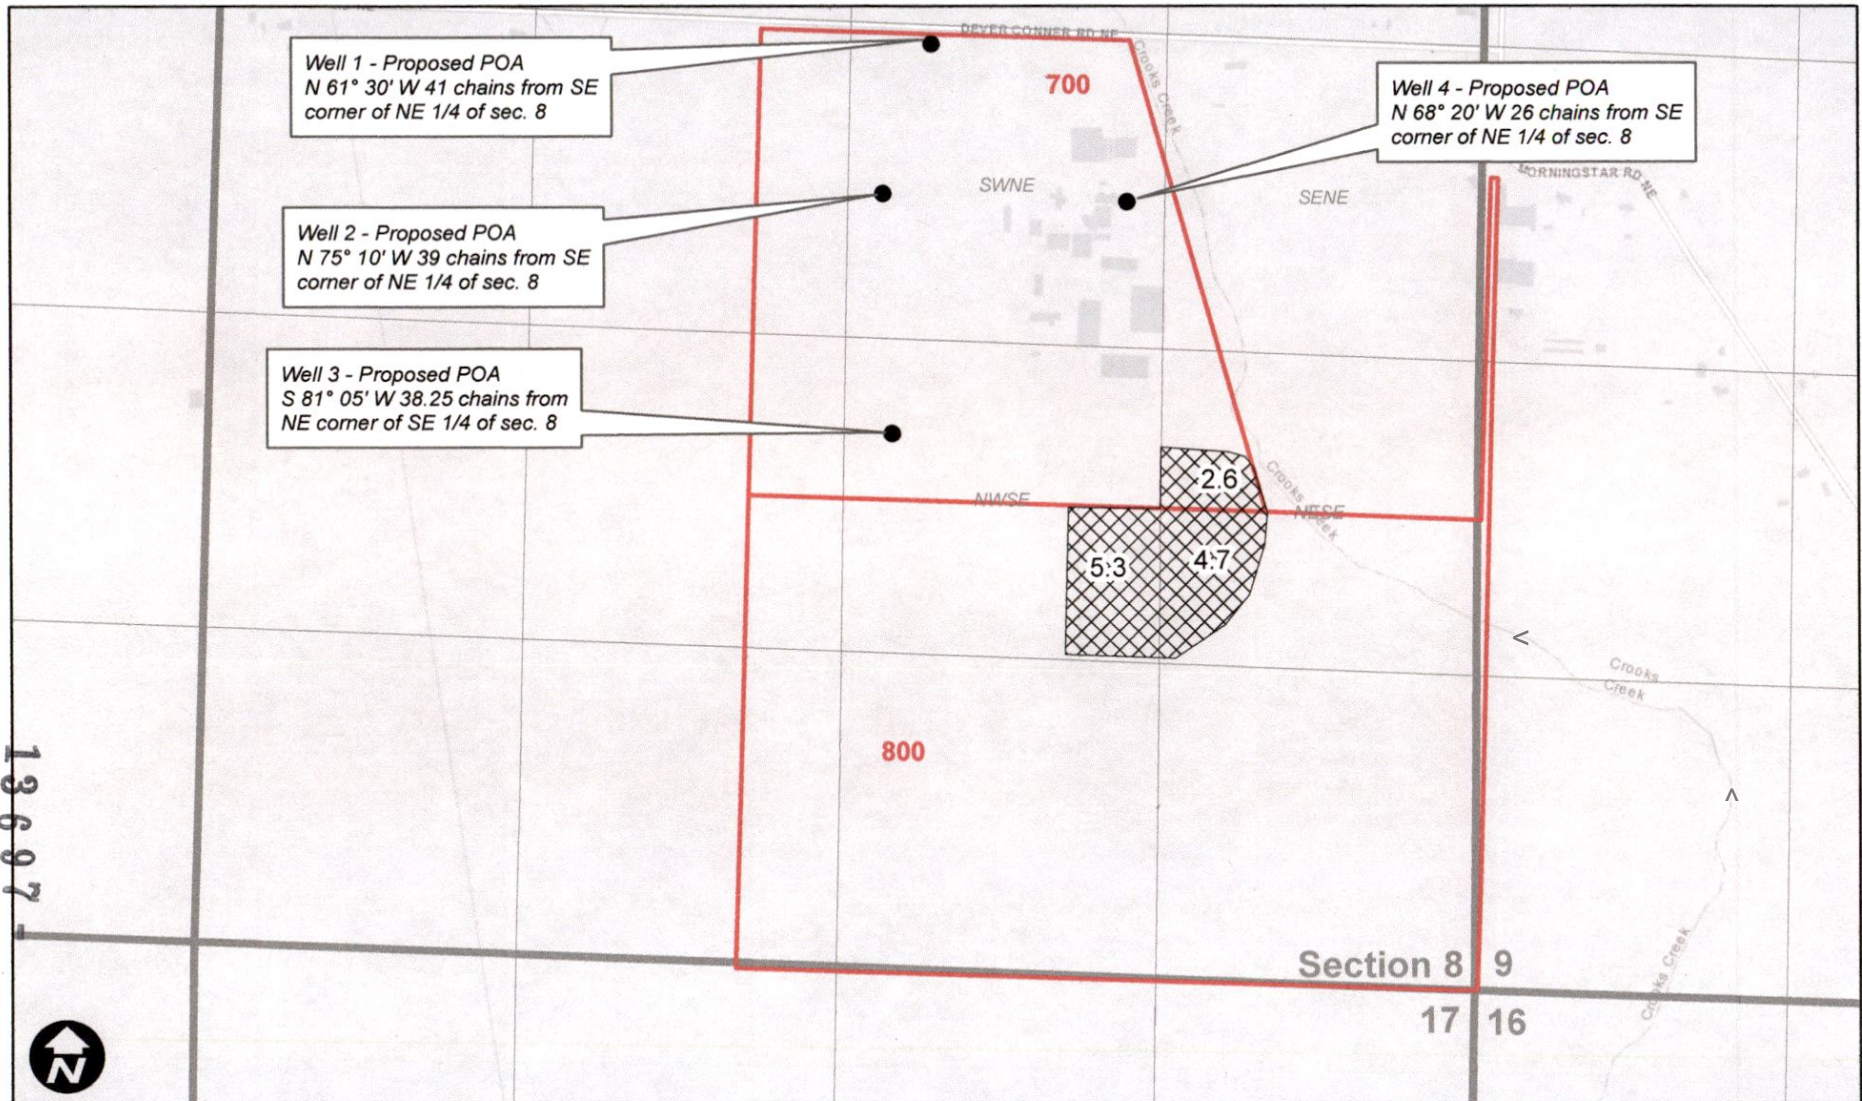

Legend

All GR 1543 1950 Priority Date


 GR 1543 - TO - 12.6 acres
Irrigation  Tax Lot

0 400 800 1,600 Feet

Groundwater Registration Modification Application GR 1543 - Case Family LLC

SUPERSEDED 8/7/23

Township 10S, Range 3W, W.M.

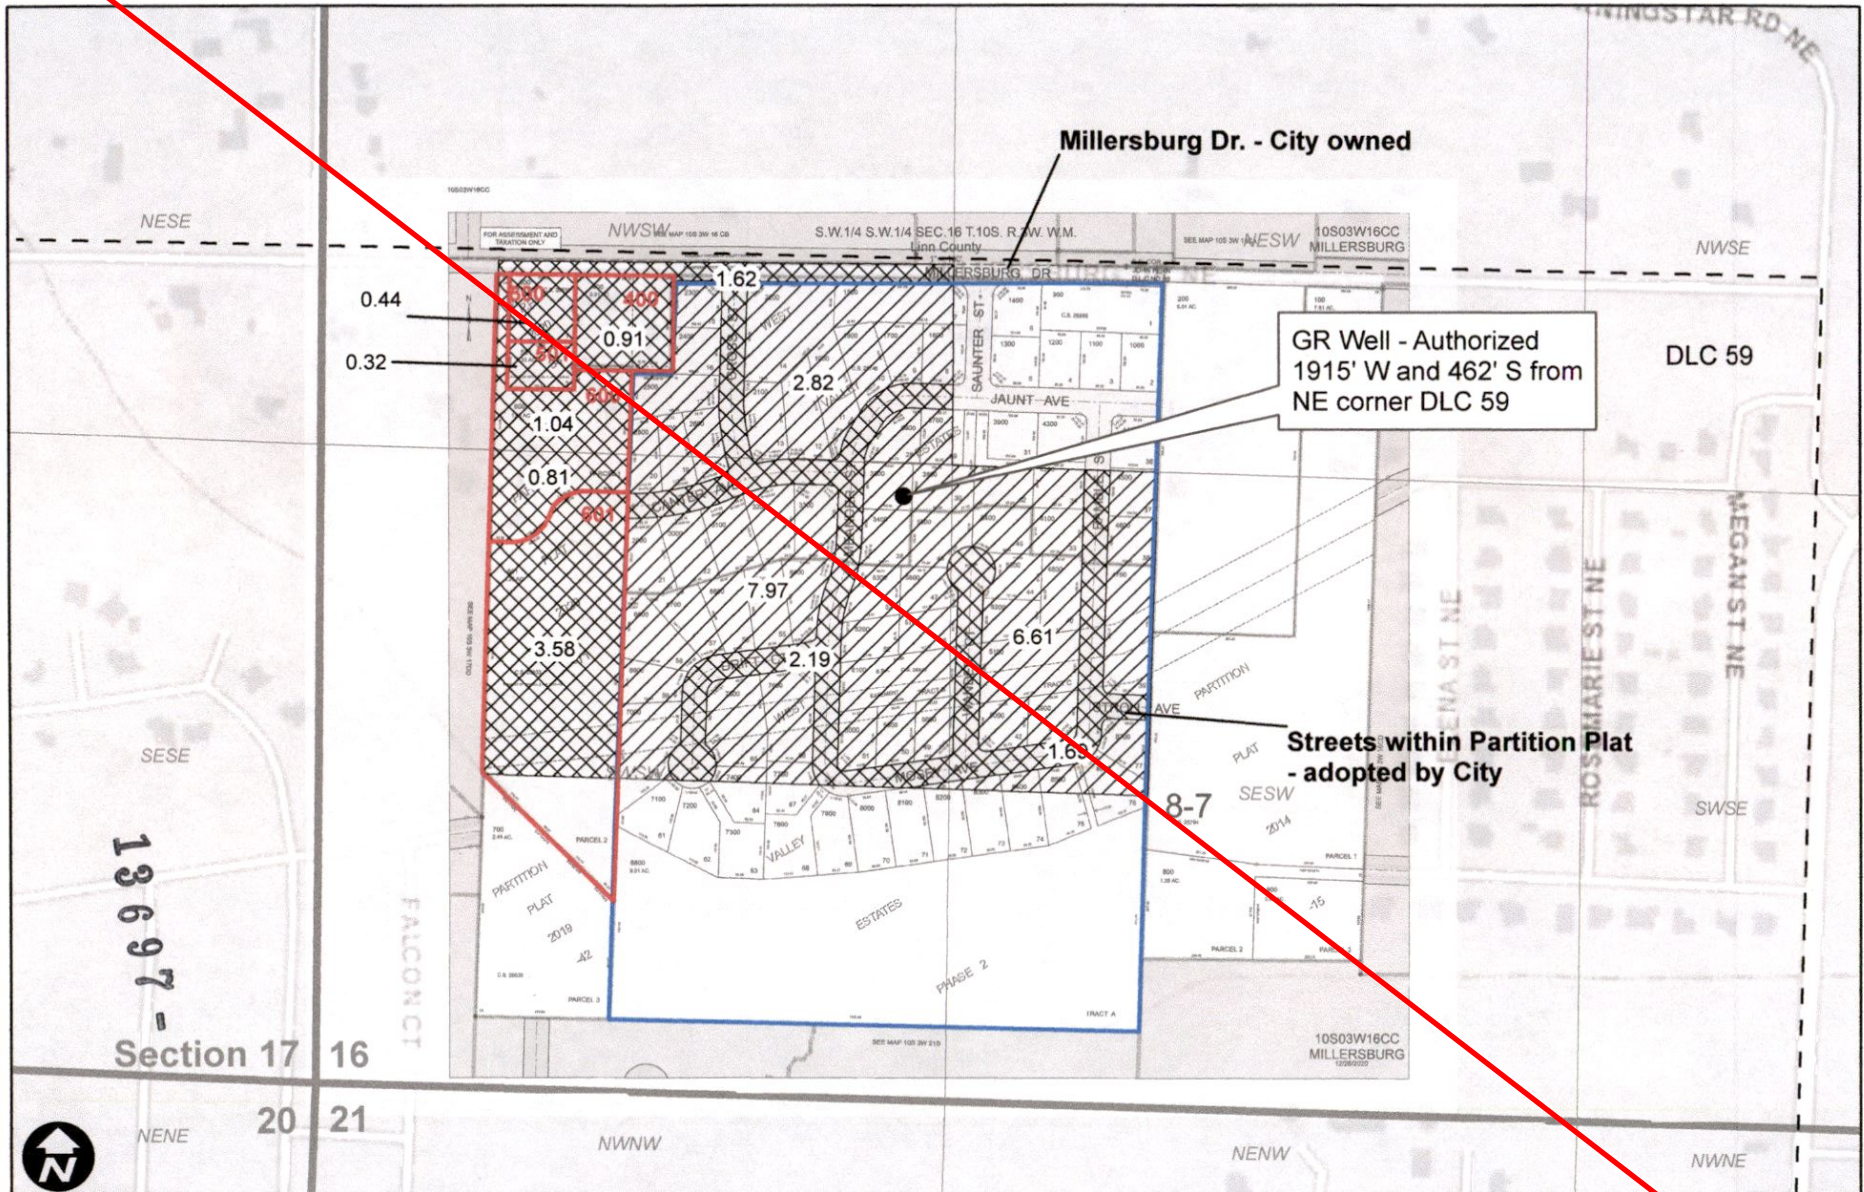

RECEIVED


APR 28 2021

WILL MCGILL SURVEYING LLC

SUPERSEDED 8/7/23

Groundwater Registration Modification Application GR 1543 - Case Family LLC

Township 10S, Range 3W, W.M.

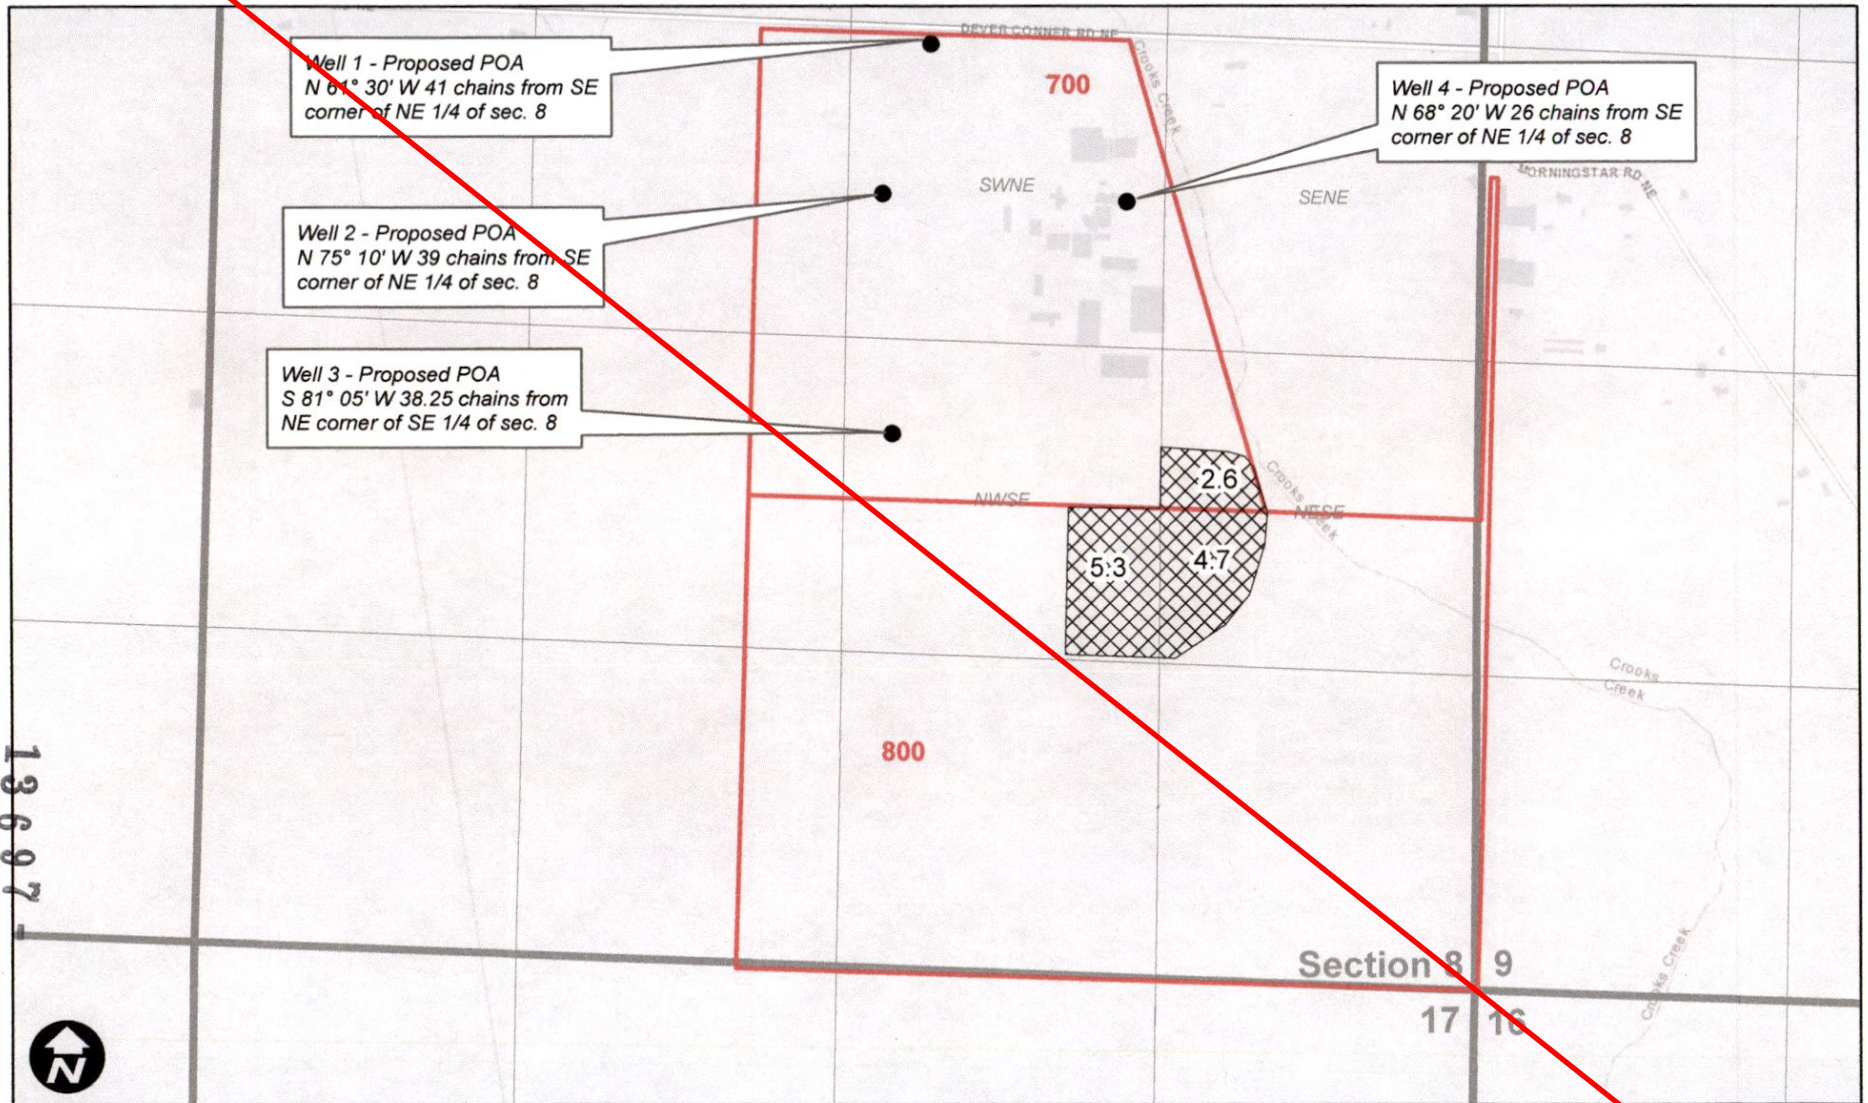

Legend

 GR 1543 - TO - 12.6 acres  Tax Lot

RECEIVED

APR 28 2021

OWRD

0 400 800 1,600 Feet

 **WILL MCGILL SURVEYING LLC**