


Groundwater Registration Modification - GR 1703 FROM - Perlenfein

Township 10S, Range 3W

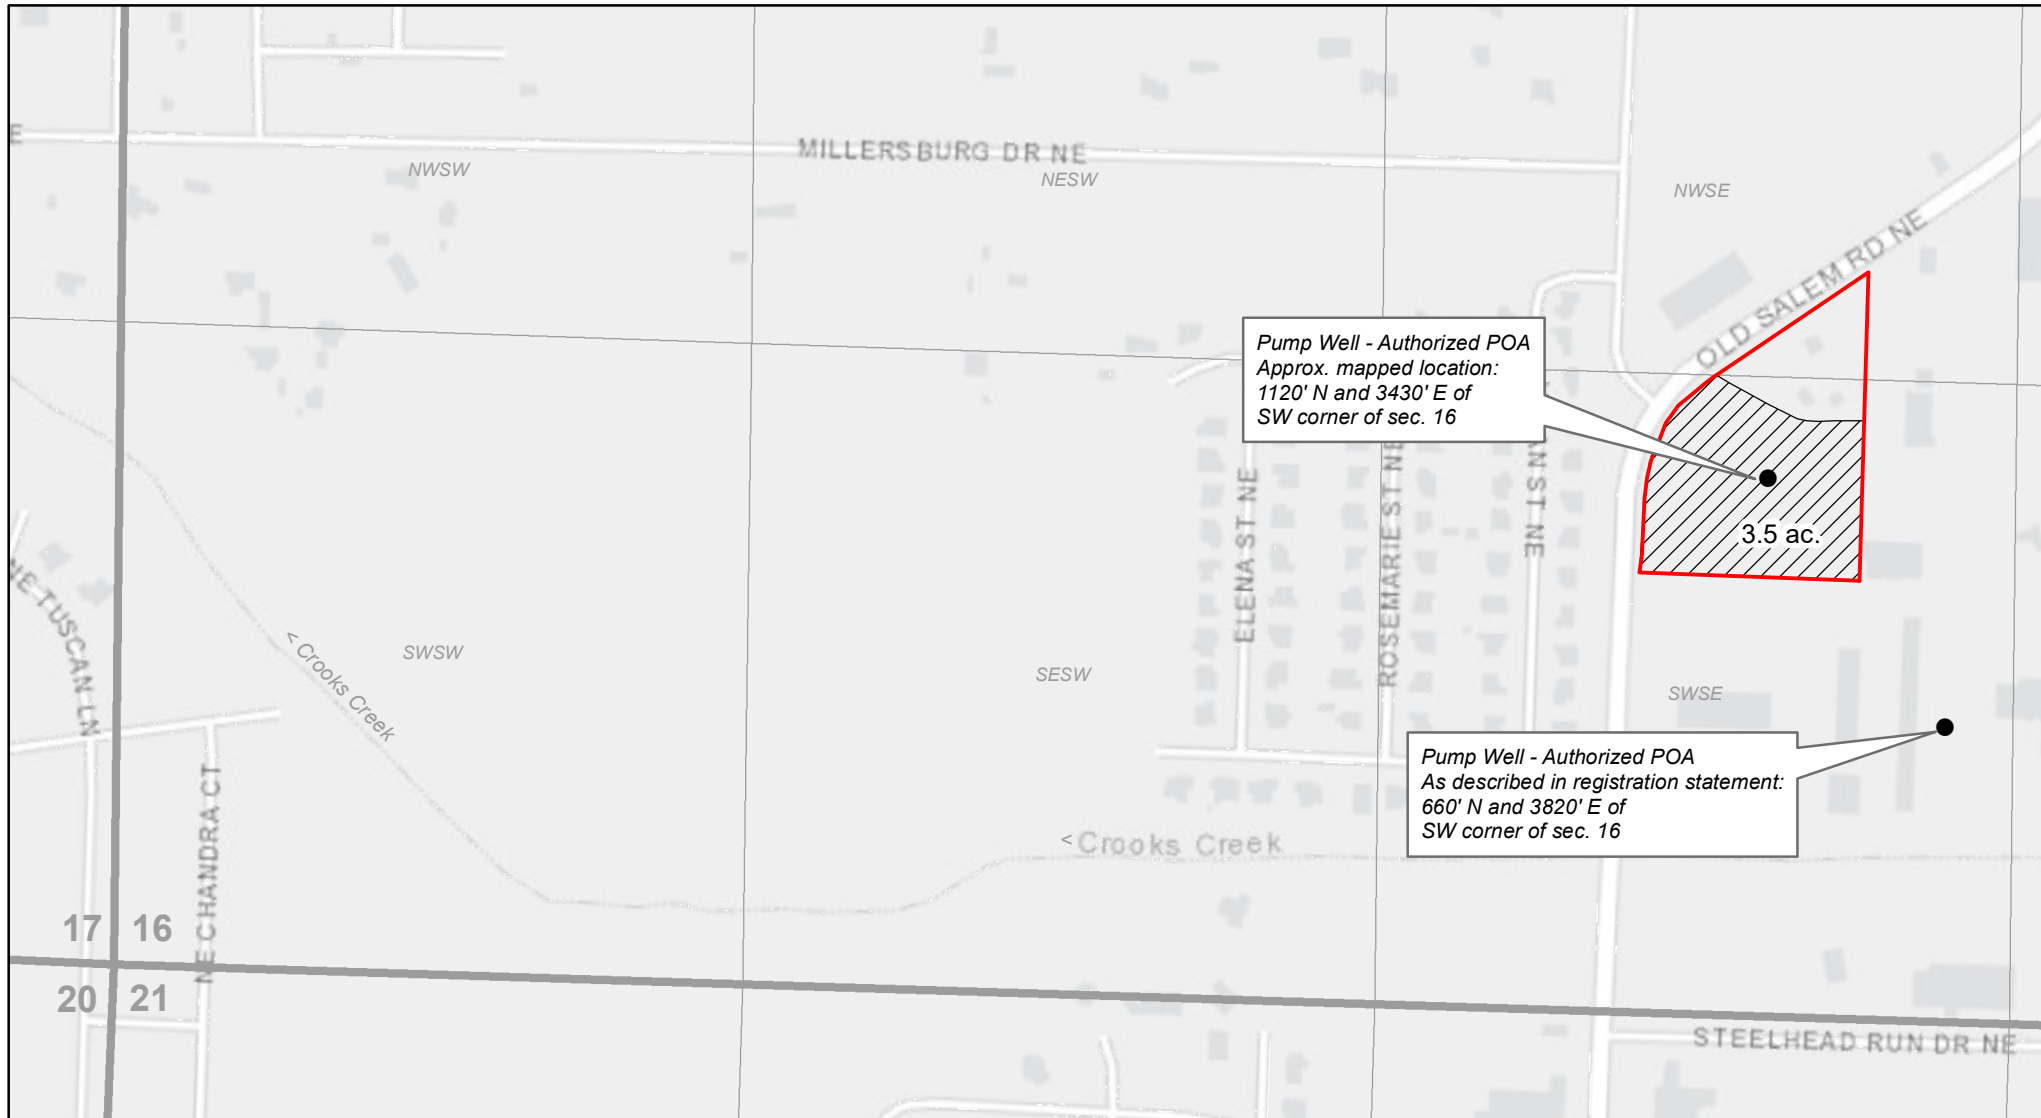

All GR 1703 1951 Priority Date

Legend


 GR 1703 FROM - Irrigation  Tax Lot 2200

0 200 400 800 Feet



Groundwater Registration Modification - GR 1703 TO - Case

Township 10S, Range 3W

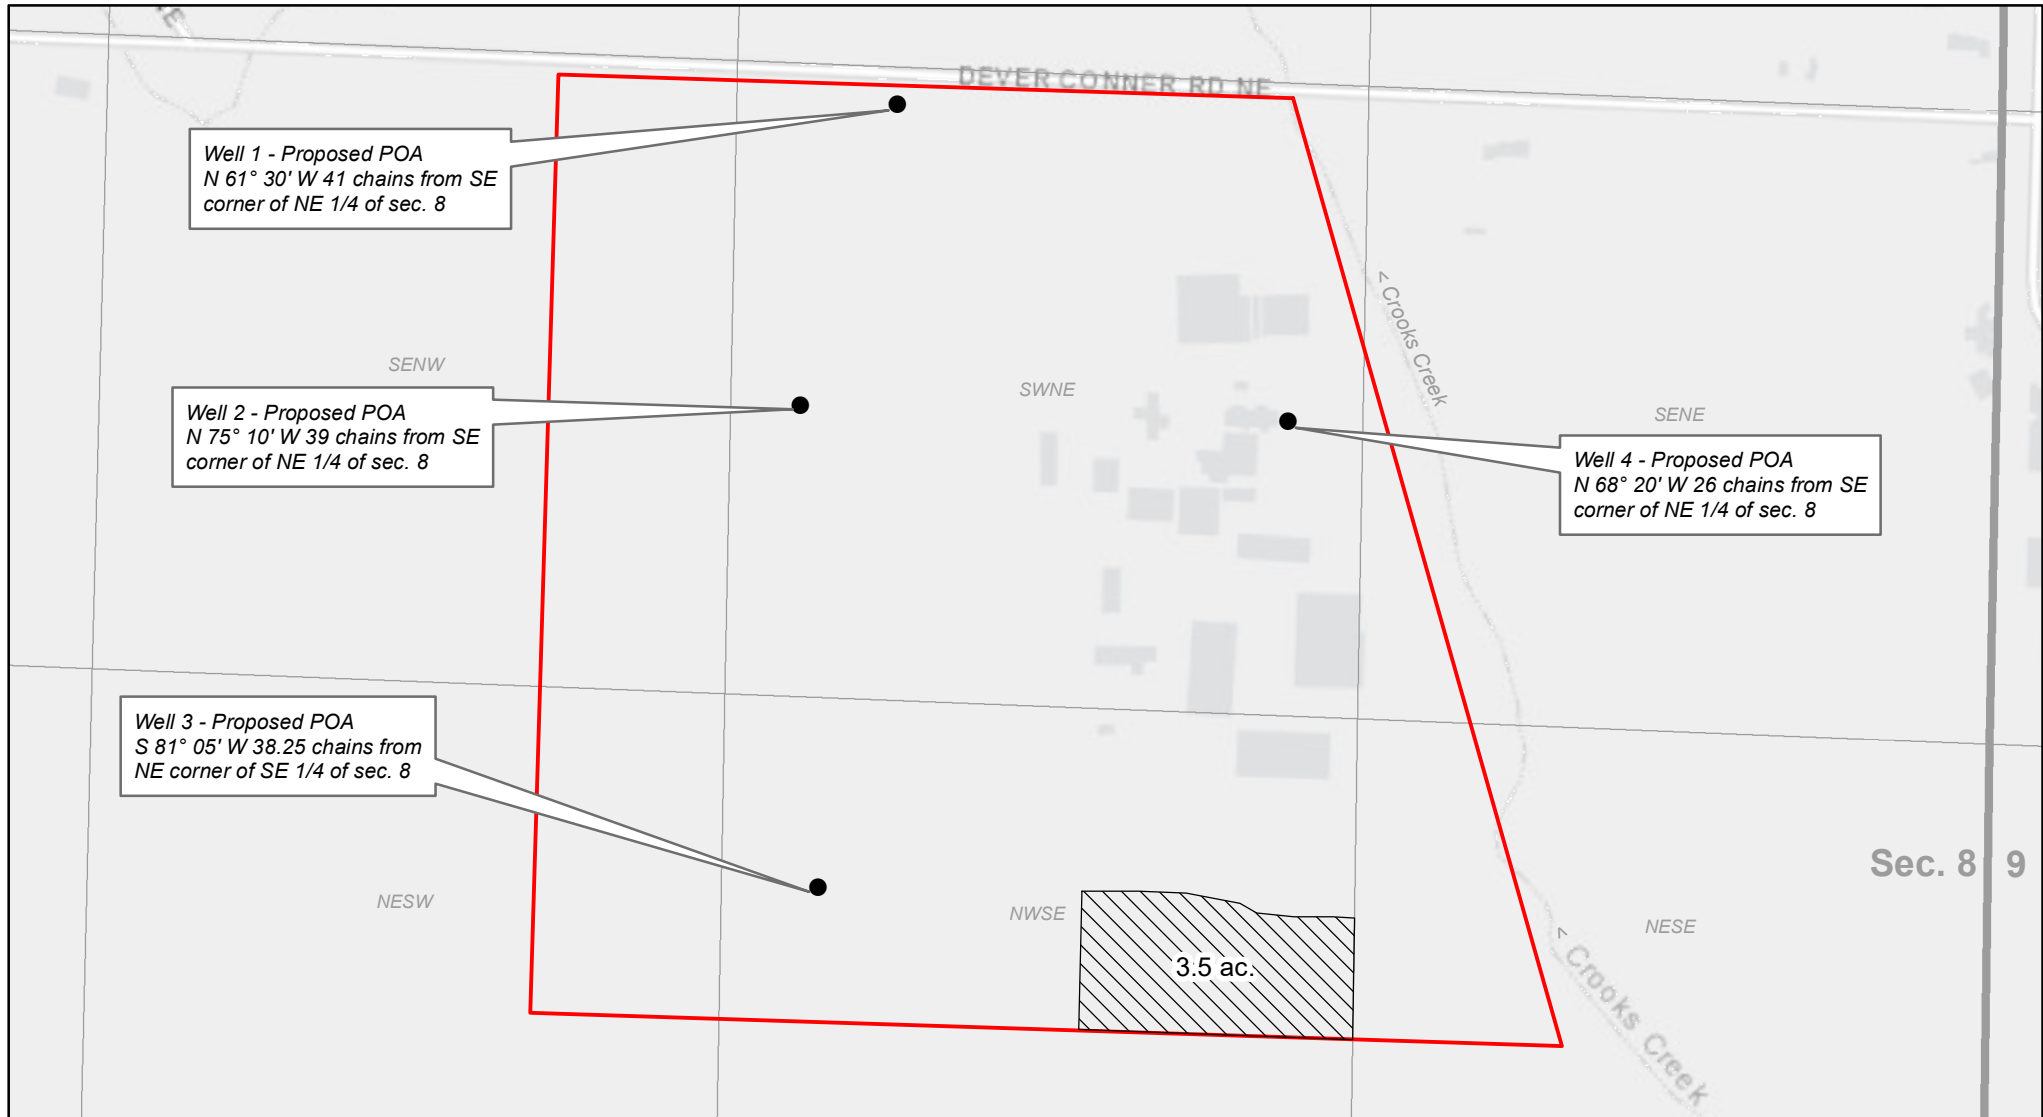

All GR 1703 1951 Priority Date

Legend

GR 1703 TO - Irrigation Tax Lot 700


0 200 400 800 Feet



SUPERSEDED

Groundwater Registration Modification - GR 1703 FROM - Perlenfein


Township 10S, Range 3W

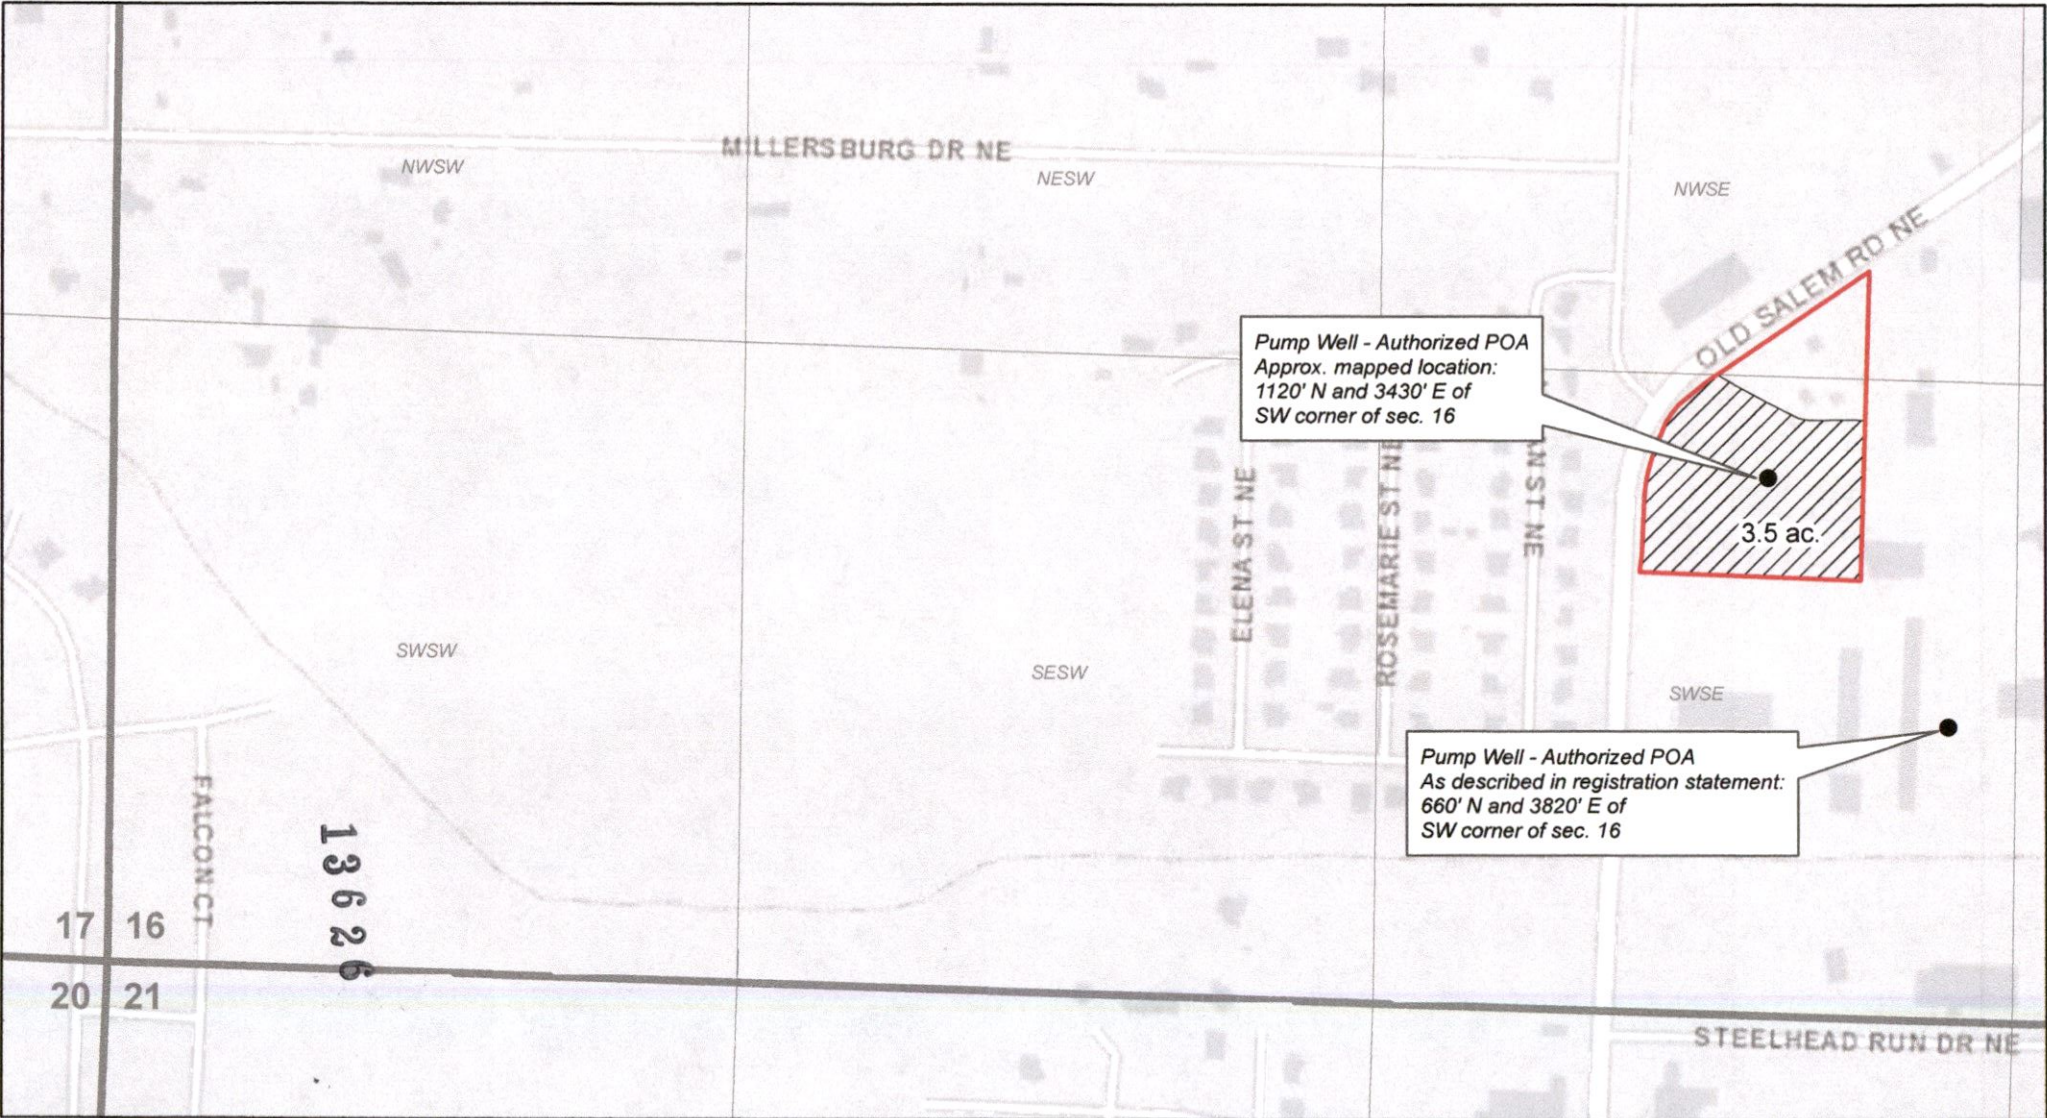

Legend

GR 1703 FROM Tax Lot 2200

RECEIVED
FEB 16 2021
OWRD

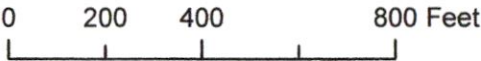

SUPERSEDED

GR 1703 FROM

OLD PACIFIC HIGHWAY

N

X
35

EXISTING WELL

J. H. LYON
PT. 2, BOX 408, ALBANY, ORE

S. 16, T. 10 S., R. 3 W.

← SW COR S. 16
26 40'

← S 1/4


13620

RECEIVED
FEB 16 2021
OWRD

SUPERSEDED

Groundwater Registration Modification - GR 1703 TO - Case

Township 10S, Range 3W

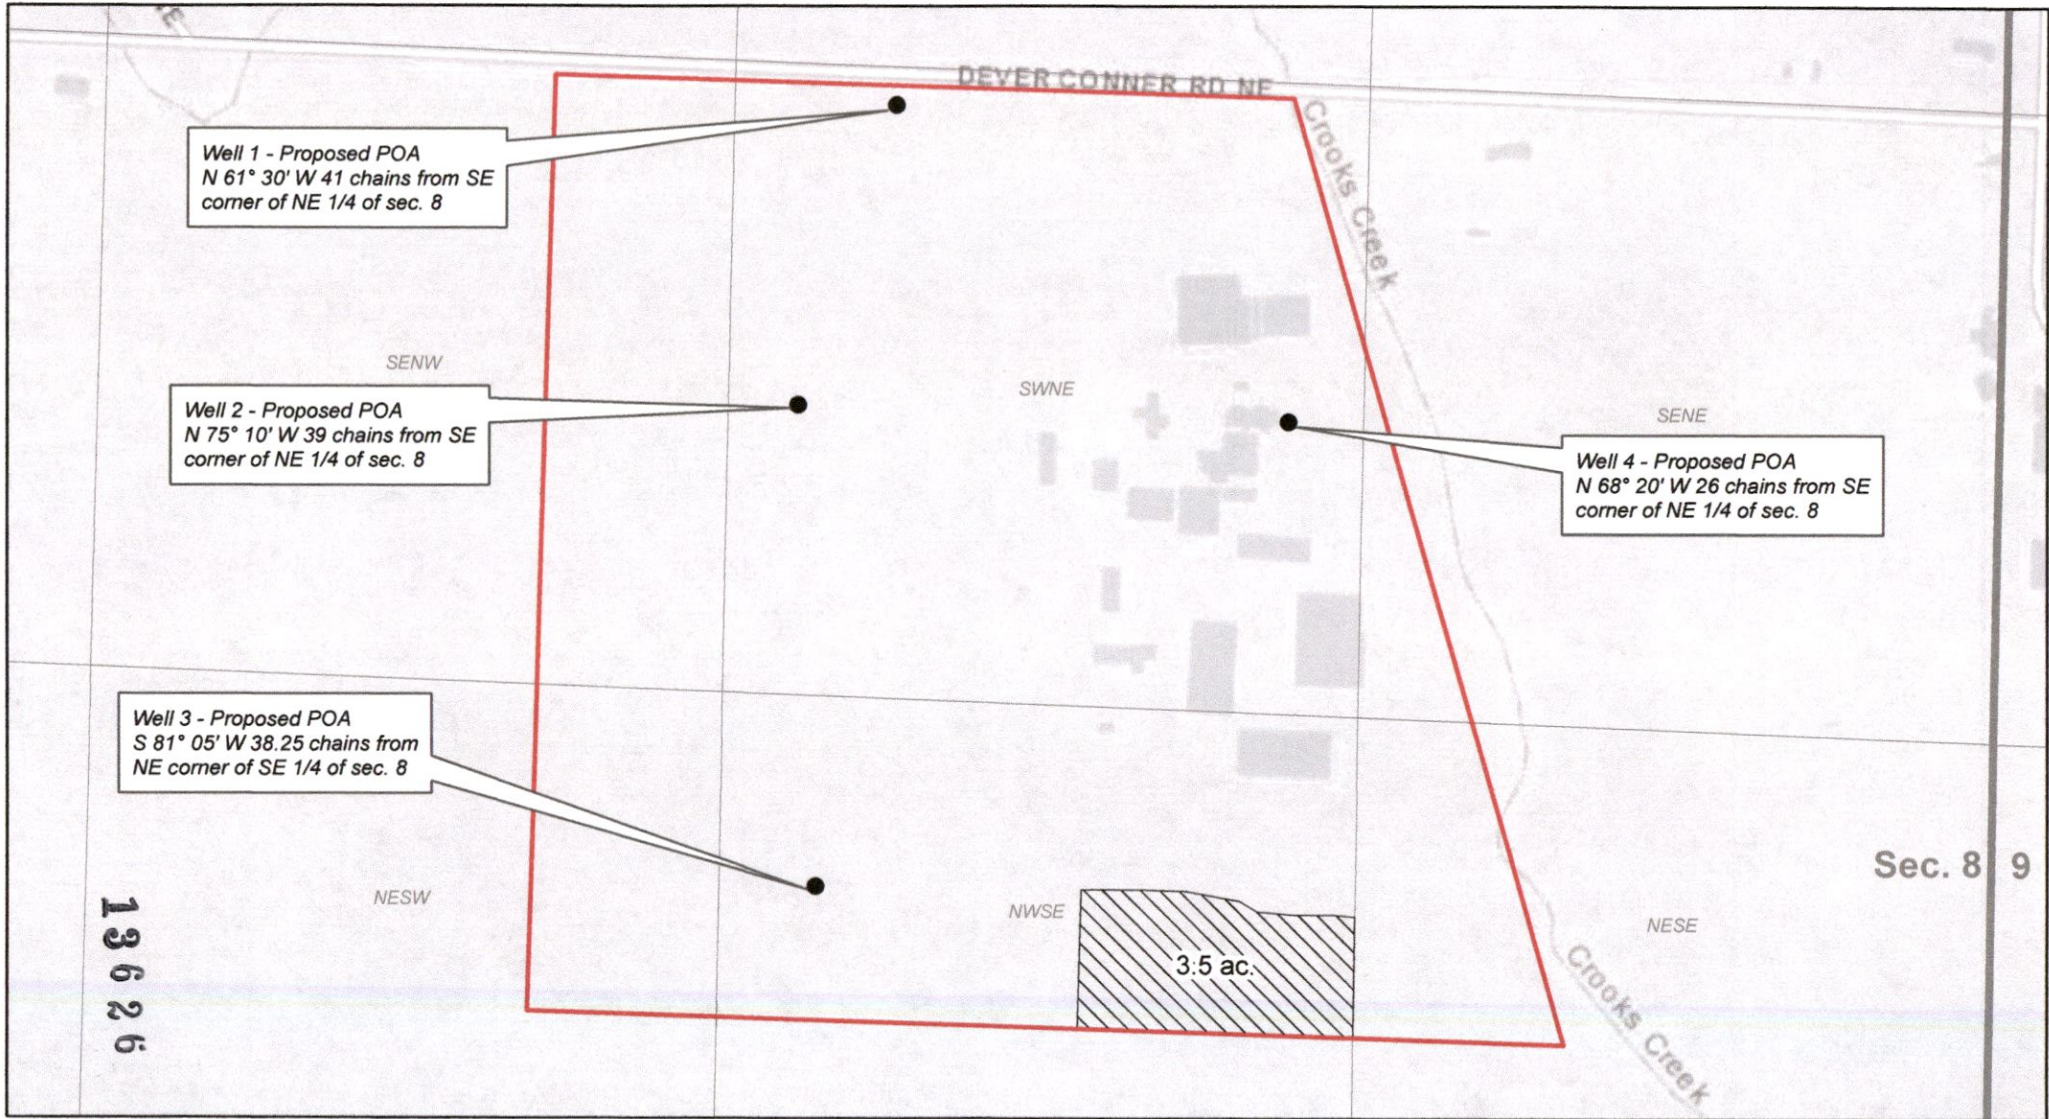

Legend

 GR 1703 TO  Tax Lot 700

RECEIVED

FEB 16 2021

OWRD

0 200 400 800 Feet



 WILL MCGILL SURVEYING LLC