


Temporary Transfer - Certificate 36427

Farmland Reserve, Inc.

AMENDED 7/18/25

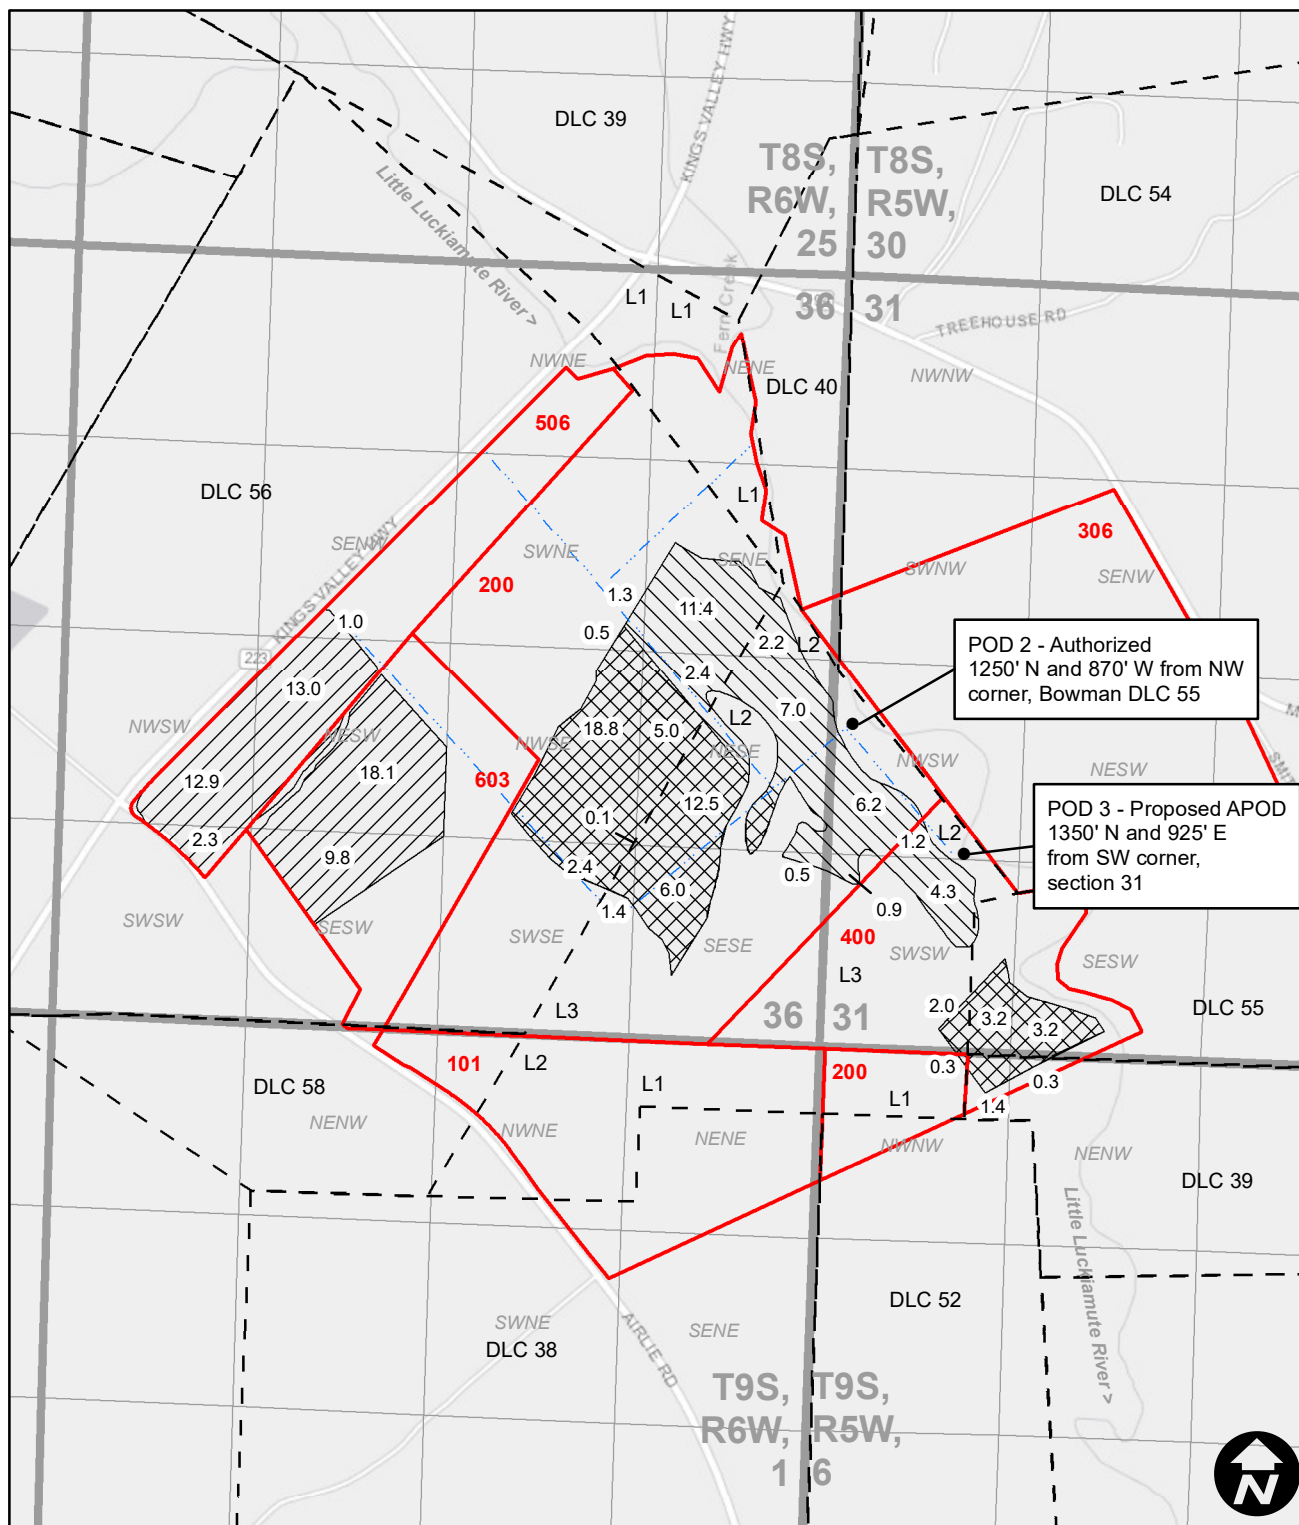


Legend

-  36427 From
-  36427 To
-  36427 No Change
-  Mainline
-  DLC
-  Taxlot

0 660 1,320 2,640 Feet

Temporary Transfer - Certificate 36427 Farmland Reserve, Inc.

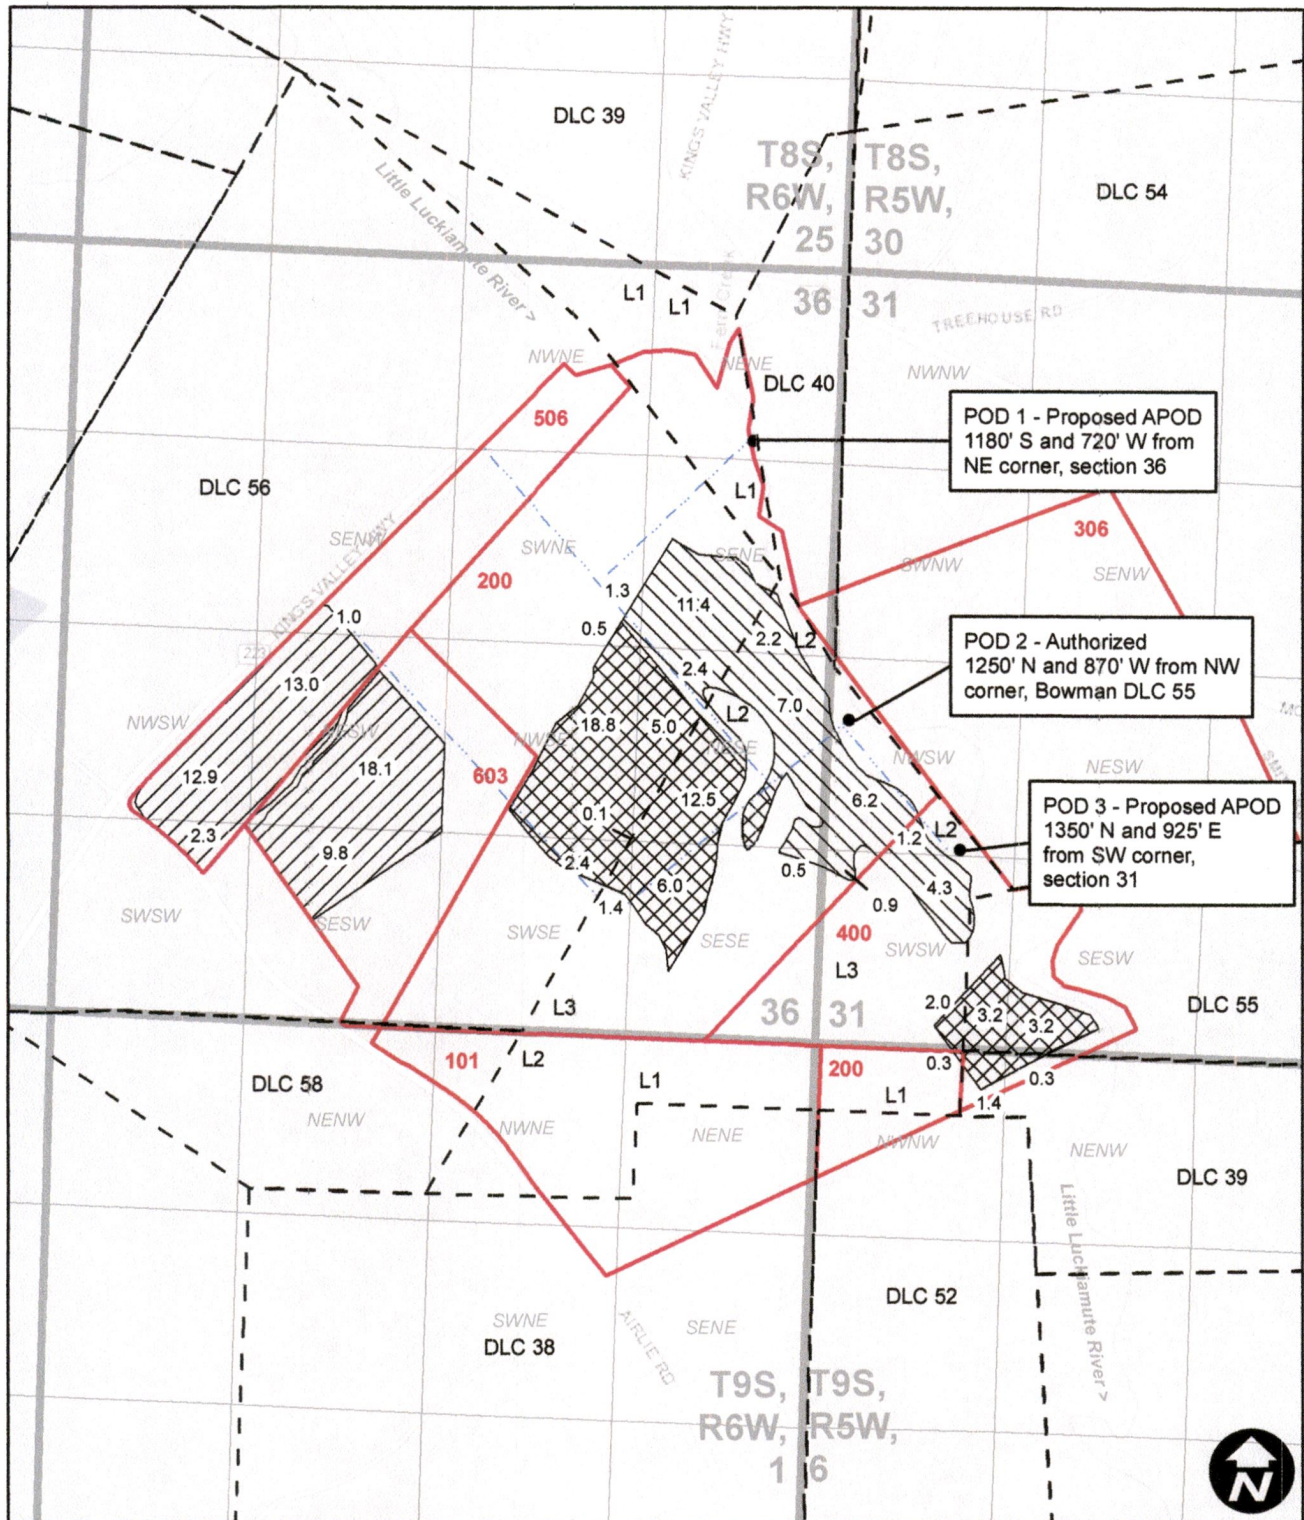

Legend

- | | | | |
|--|-----------------|--|----------|
| | 36427 From | | Mainline |
| | 36427 To | | DLC |
| | 36427 No Change | | Taxlot |

Received by OWRD

MAY 23 2025

Salem, OR


WILL MCGILL SURVEYING LLC

14659 -

Temporary Transfer - Certificate 37470

Farmland Reserve, Inc.

AMENDED 7/18/25

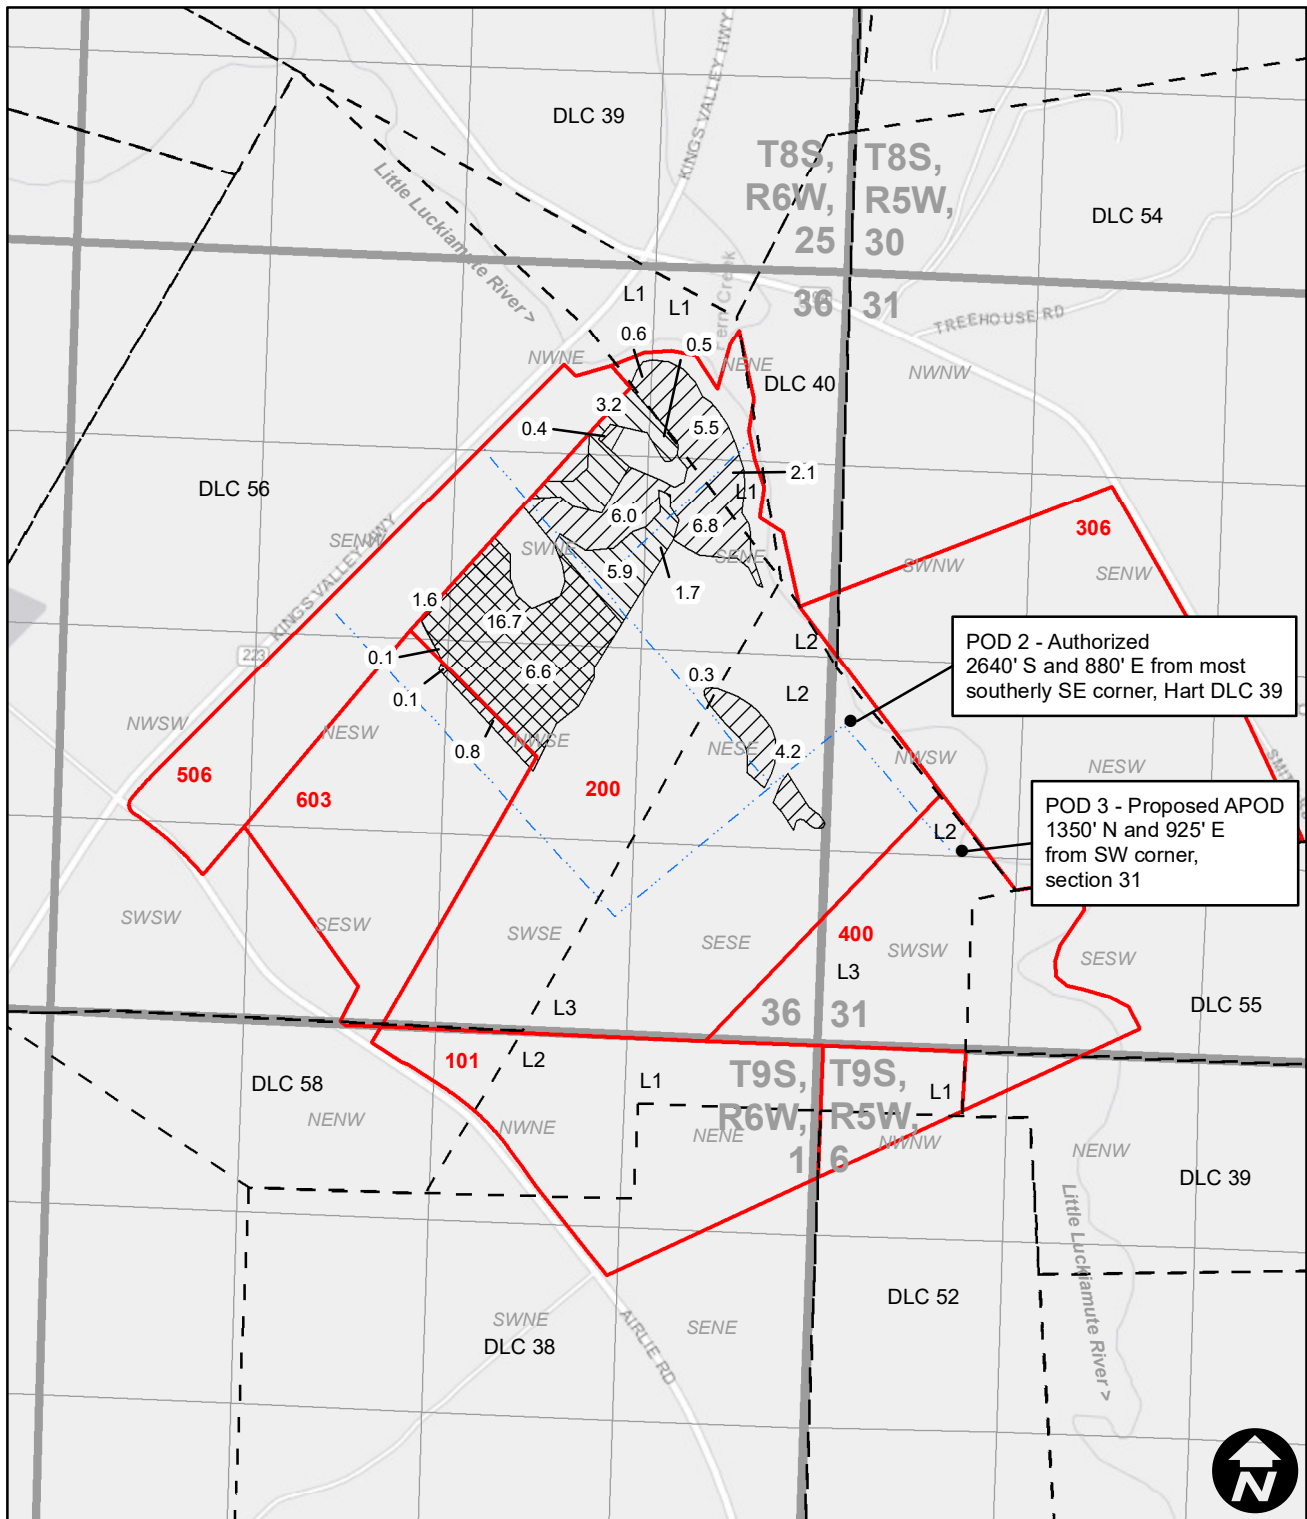


Legend

- 37470 From
- 37470 To
- 37470 No Change
- Mainline
- DLC
- Taxlot

0 660 1,320 2,640 Feet

SUPERSEDED

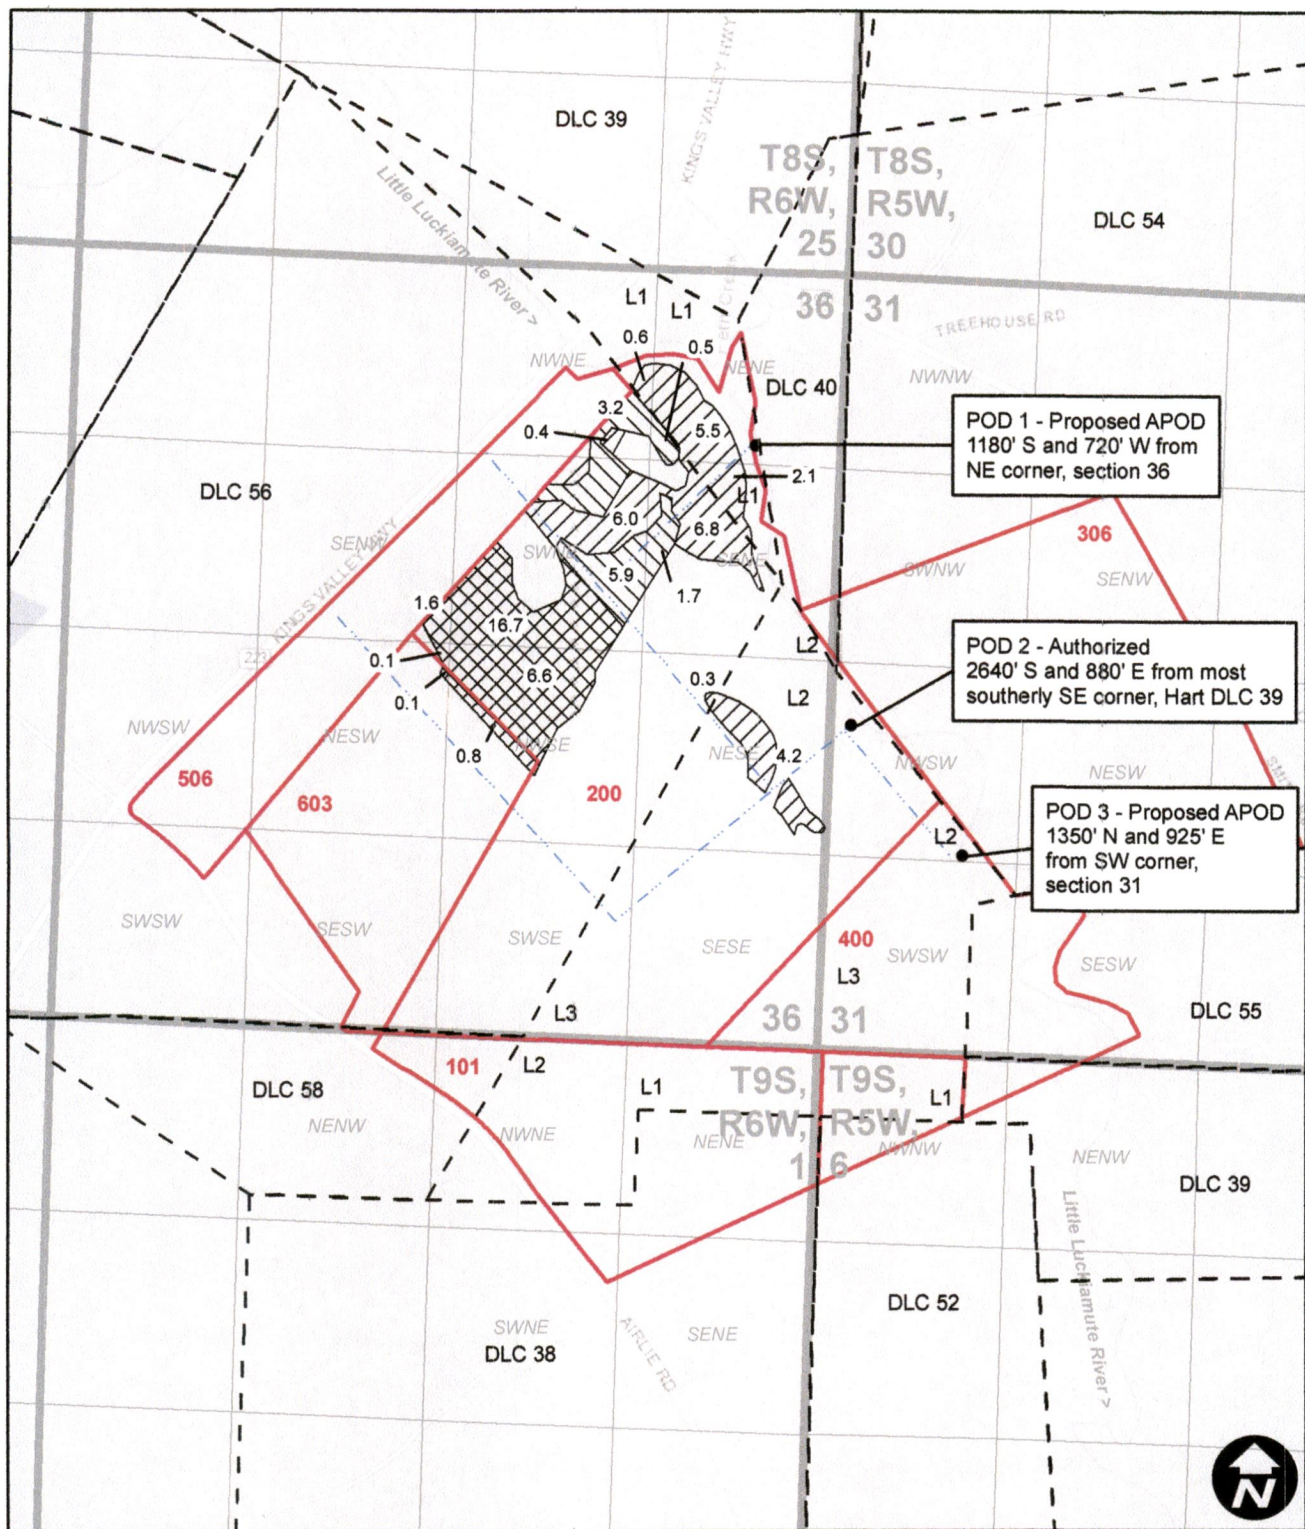

Legend

- | | | | |
|---|-----------------|---|----------|
|  | 37470 From |  | Mainline |
|  | 37470 To |  | DLC |
|  | 37470 No Change |  | Taxlot |

Received by OWRD

MAY 23 2025

Salem, OR



WILL MCGILL SURVEYING LLC


[illegible]


	39185 From		Mainline
	39185 To		DLC
	39185 No Change		Taxlot



WILL MCGILL SURVEYING LLC

Temporary Transfer - Certificate 39185 Farmland Reserve, Inc.

SUPERSEDED

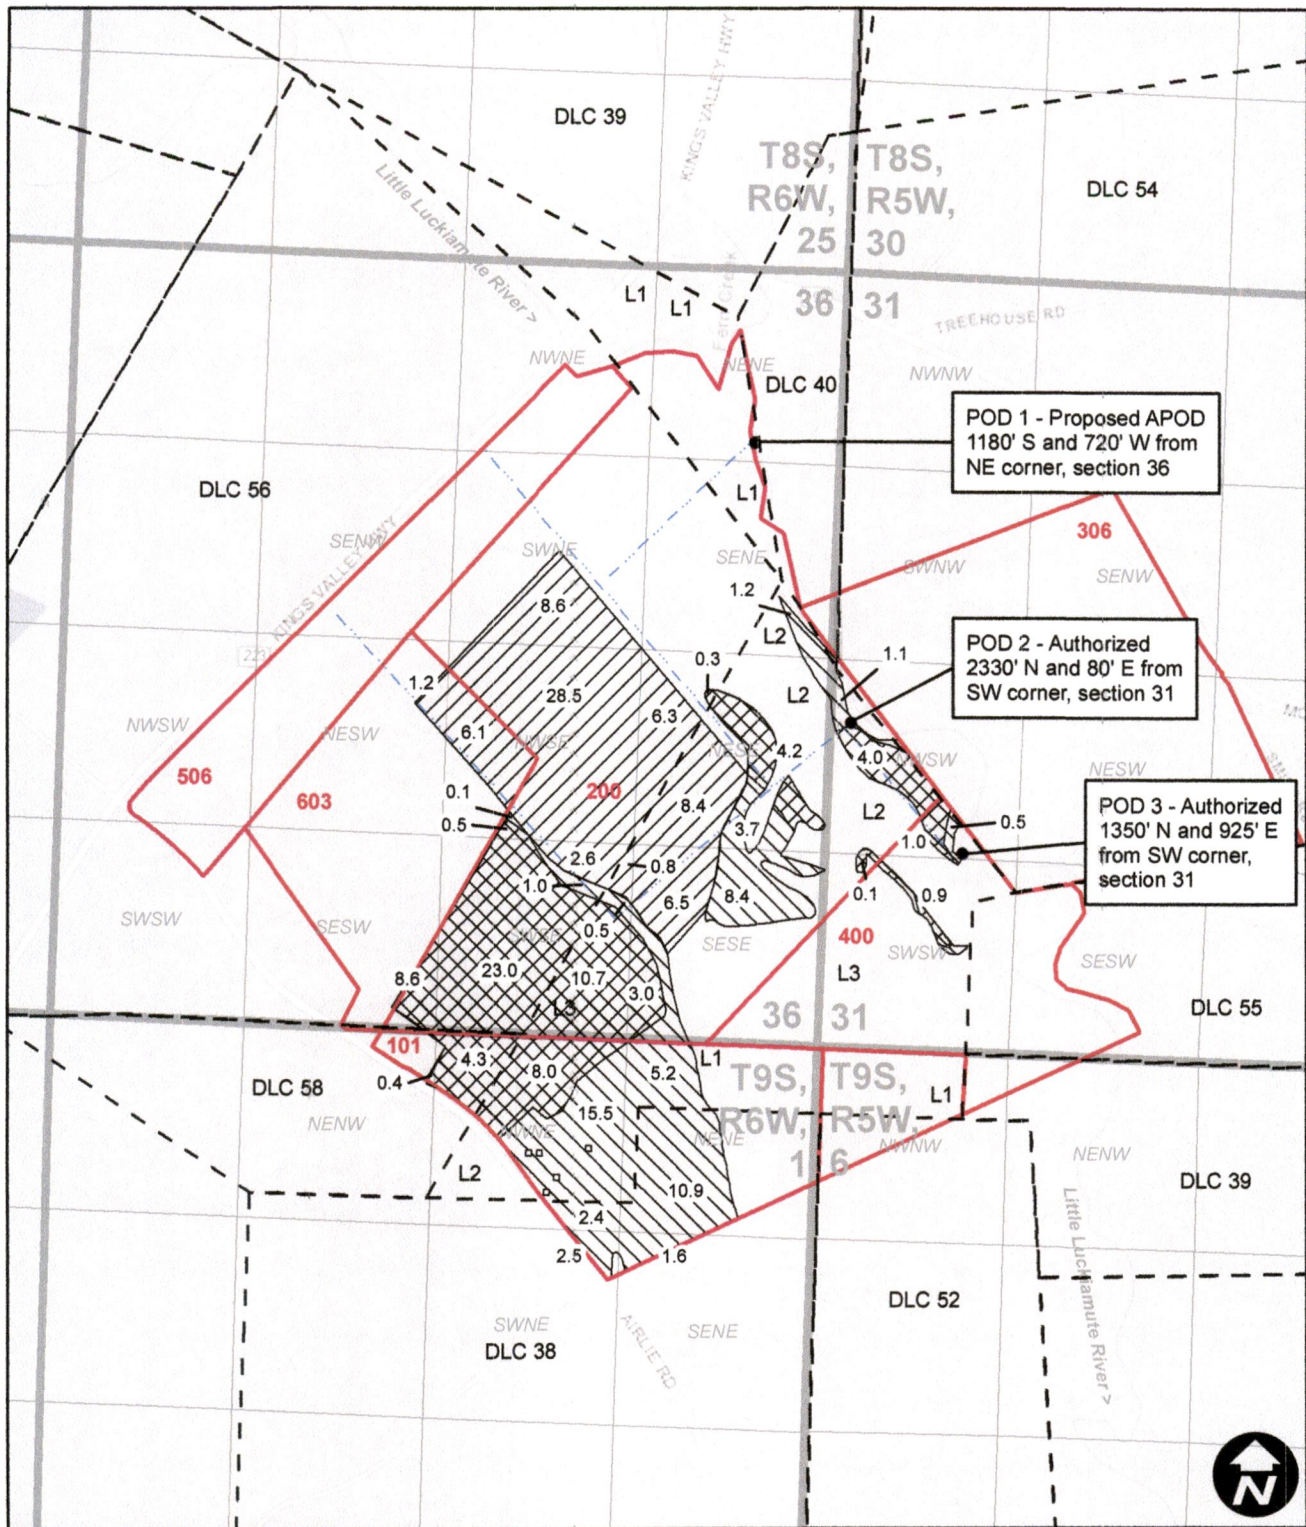

Legend

- 39185 From
- 39185 To
- 39185 No Change
- Mainline
- DLC
- Taxlot

Received by OWRD

MAY 23 2025


Salem, OR

WILL MCGILL SURVEYING LLC
14659 -

Temporary Transfer - Certificate 44888

Farmland Reserve, Inc.

AMENDED 7/18/25

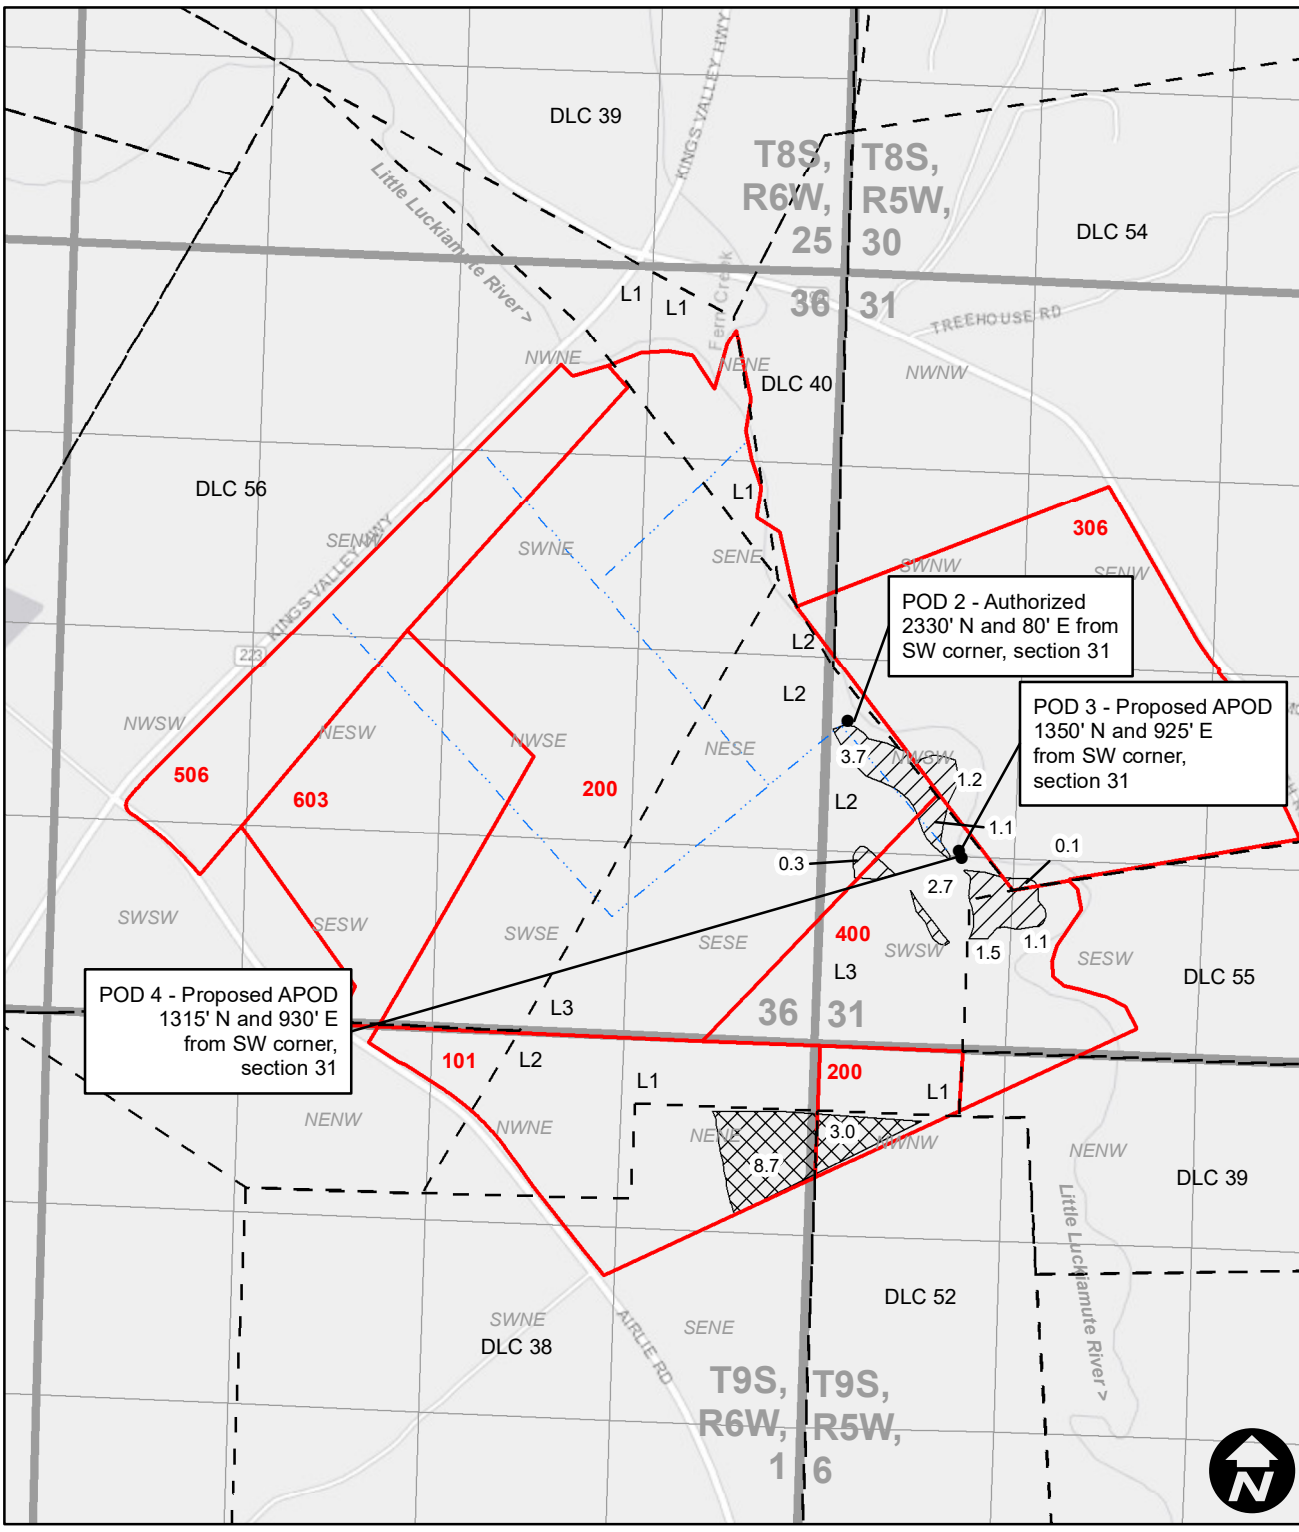


Legend

- 44888 From
- Mainline
- Taxlot
- 44888 To
- DLC

0 660 1,320 2,640 Feet

Temporary Transfer - Certificate 44888
Farmland Reserve, Inc.

SUPERSEDED

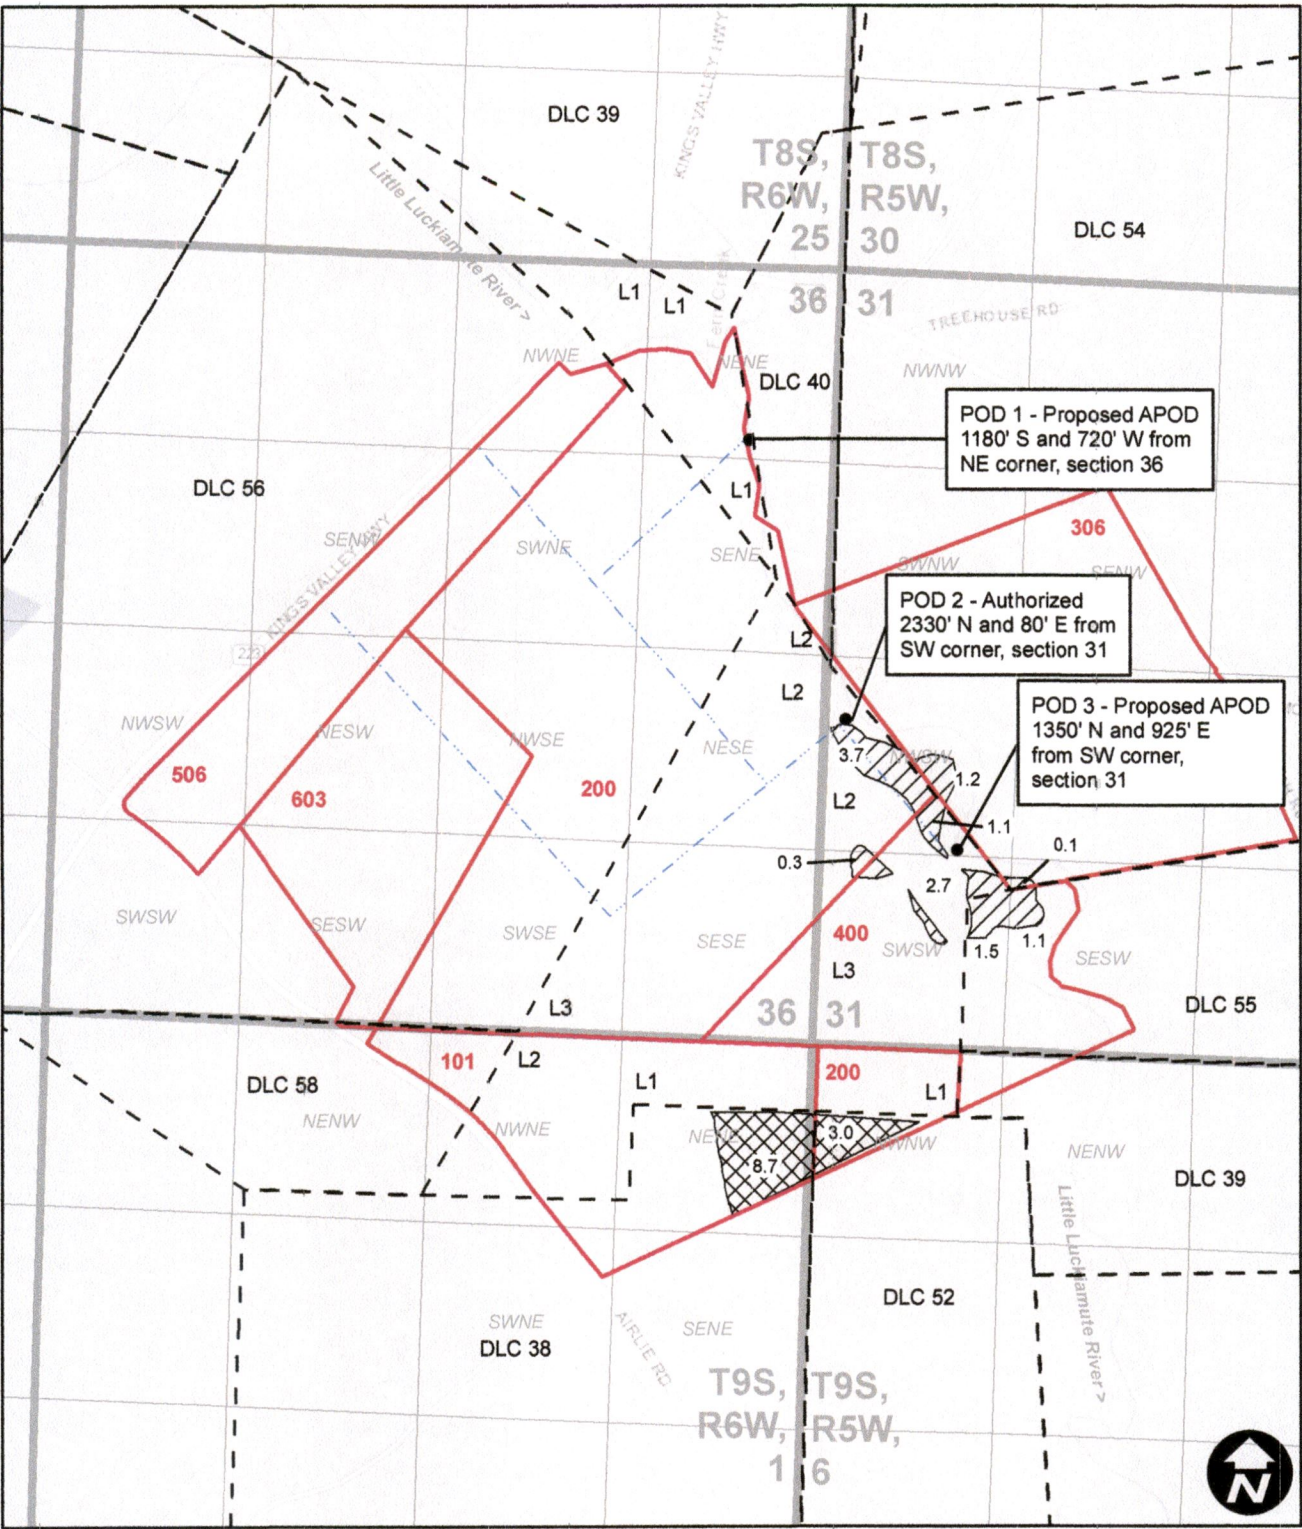

Legend

- 44888 From
- Mainline
- Taxlot
- 44888 To
- DLC


0 660 1,320 2,640 Feet

Received by OWRD
MAY 23 2025
Salem, OR

WILL MCGILL SURVEYING LLC
14659 -

Temporary Transfer - Certificate 47648

Farmland Reserve, Inc.

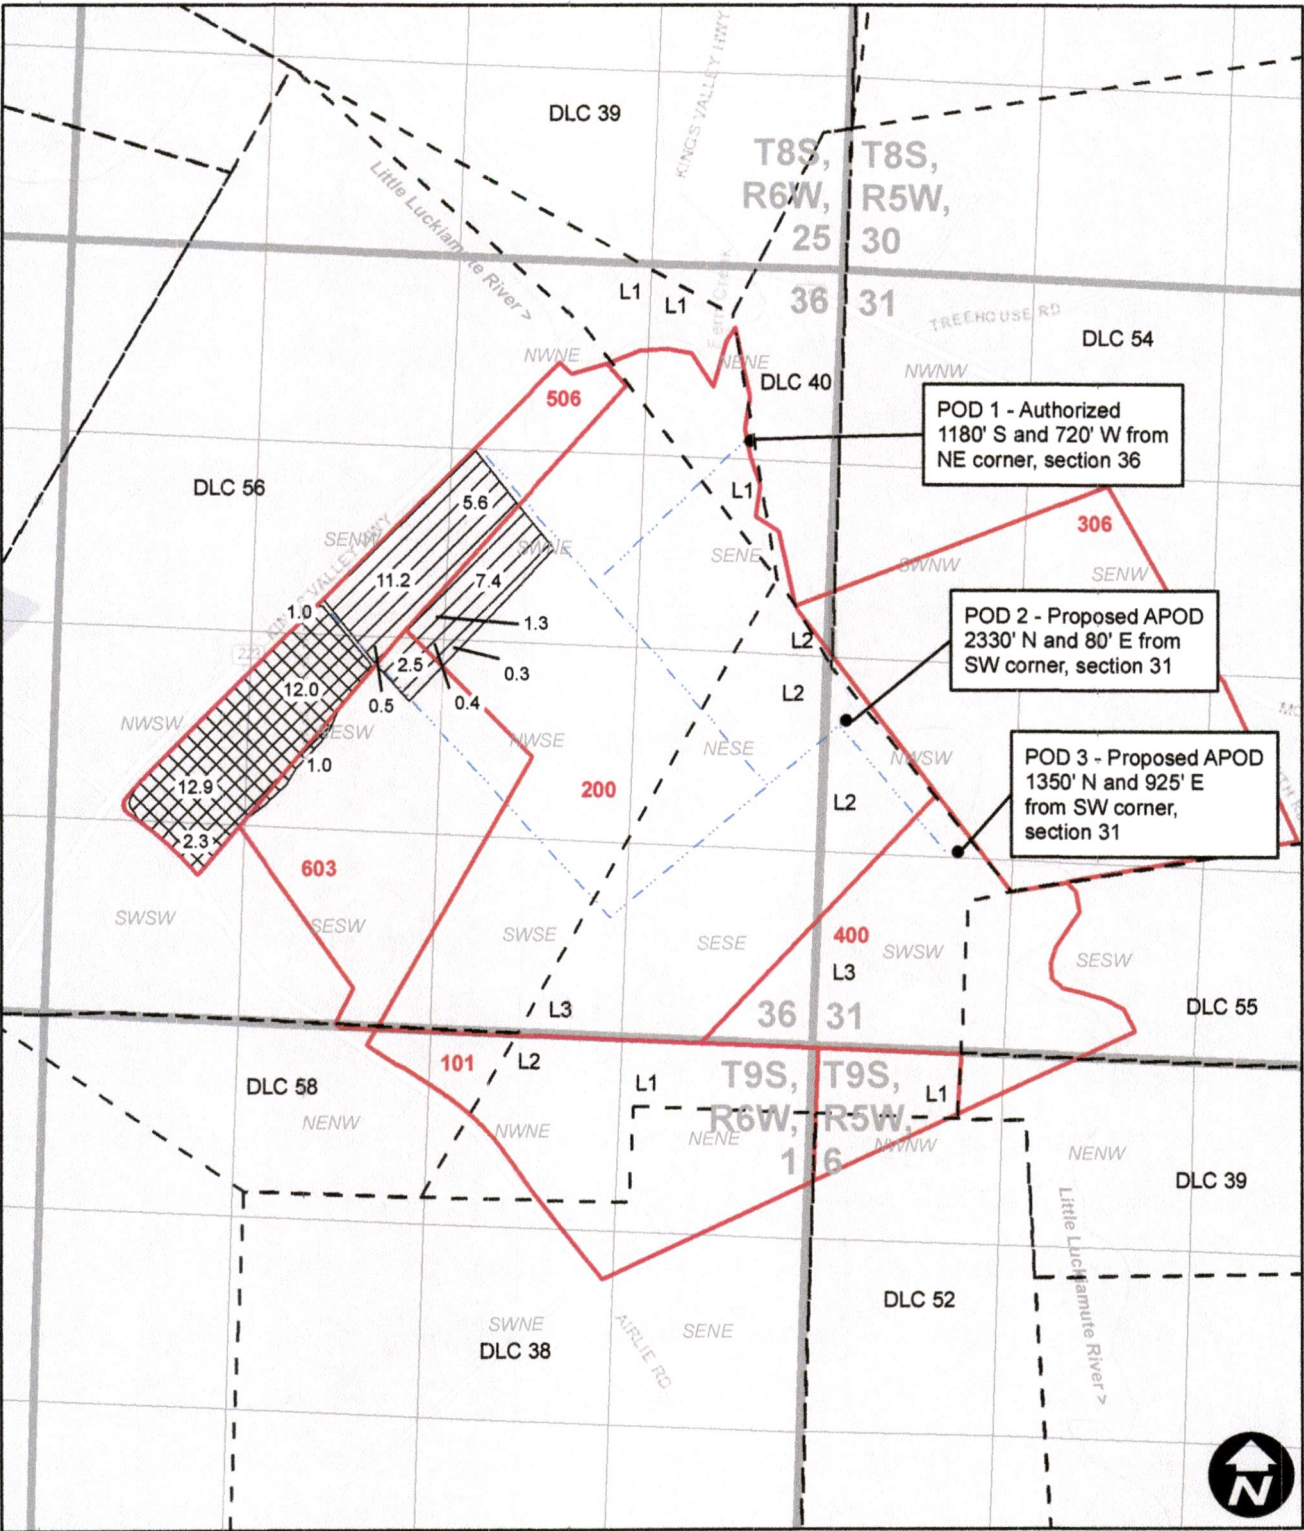

Legend

- 47648 From
- Mainline
- Taxlot
- 47648 To
- DLC


MAY 23 2025

Salem, OR

Temporary Transfer - Certificate 57711

Farmland Reserve, Inc.

AMENDED 7/18/25

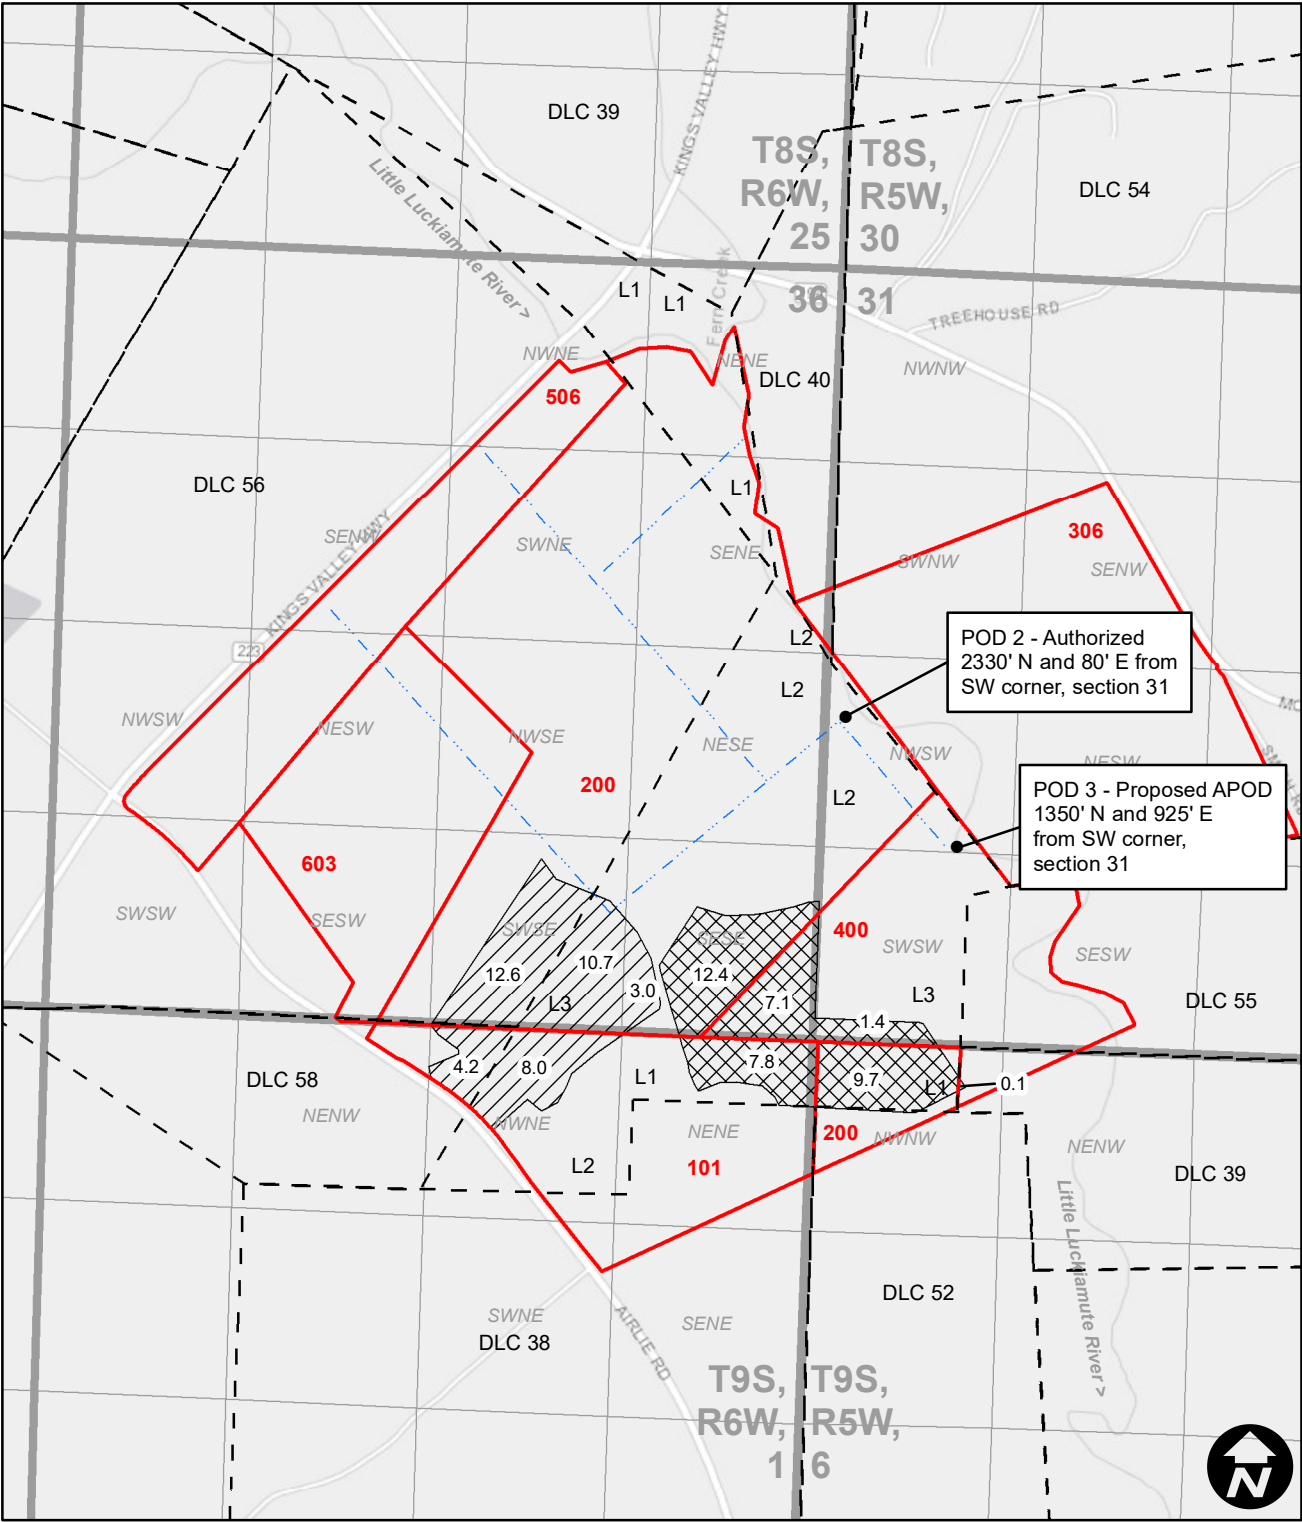

Legend


- 57711 From
- Mainline
- Taxlot
- 57711 To
- DLC

0 660 1,320 2,640 Feet

Temporary Transfer - Certificate 57711

Farmland Reserve, Inc.

SUPERSEDED

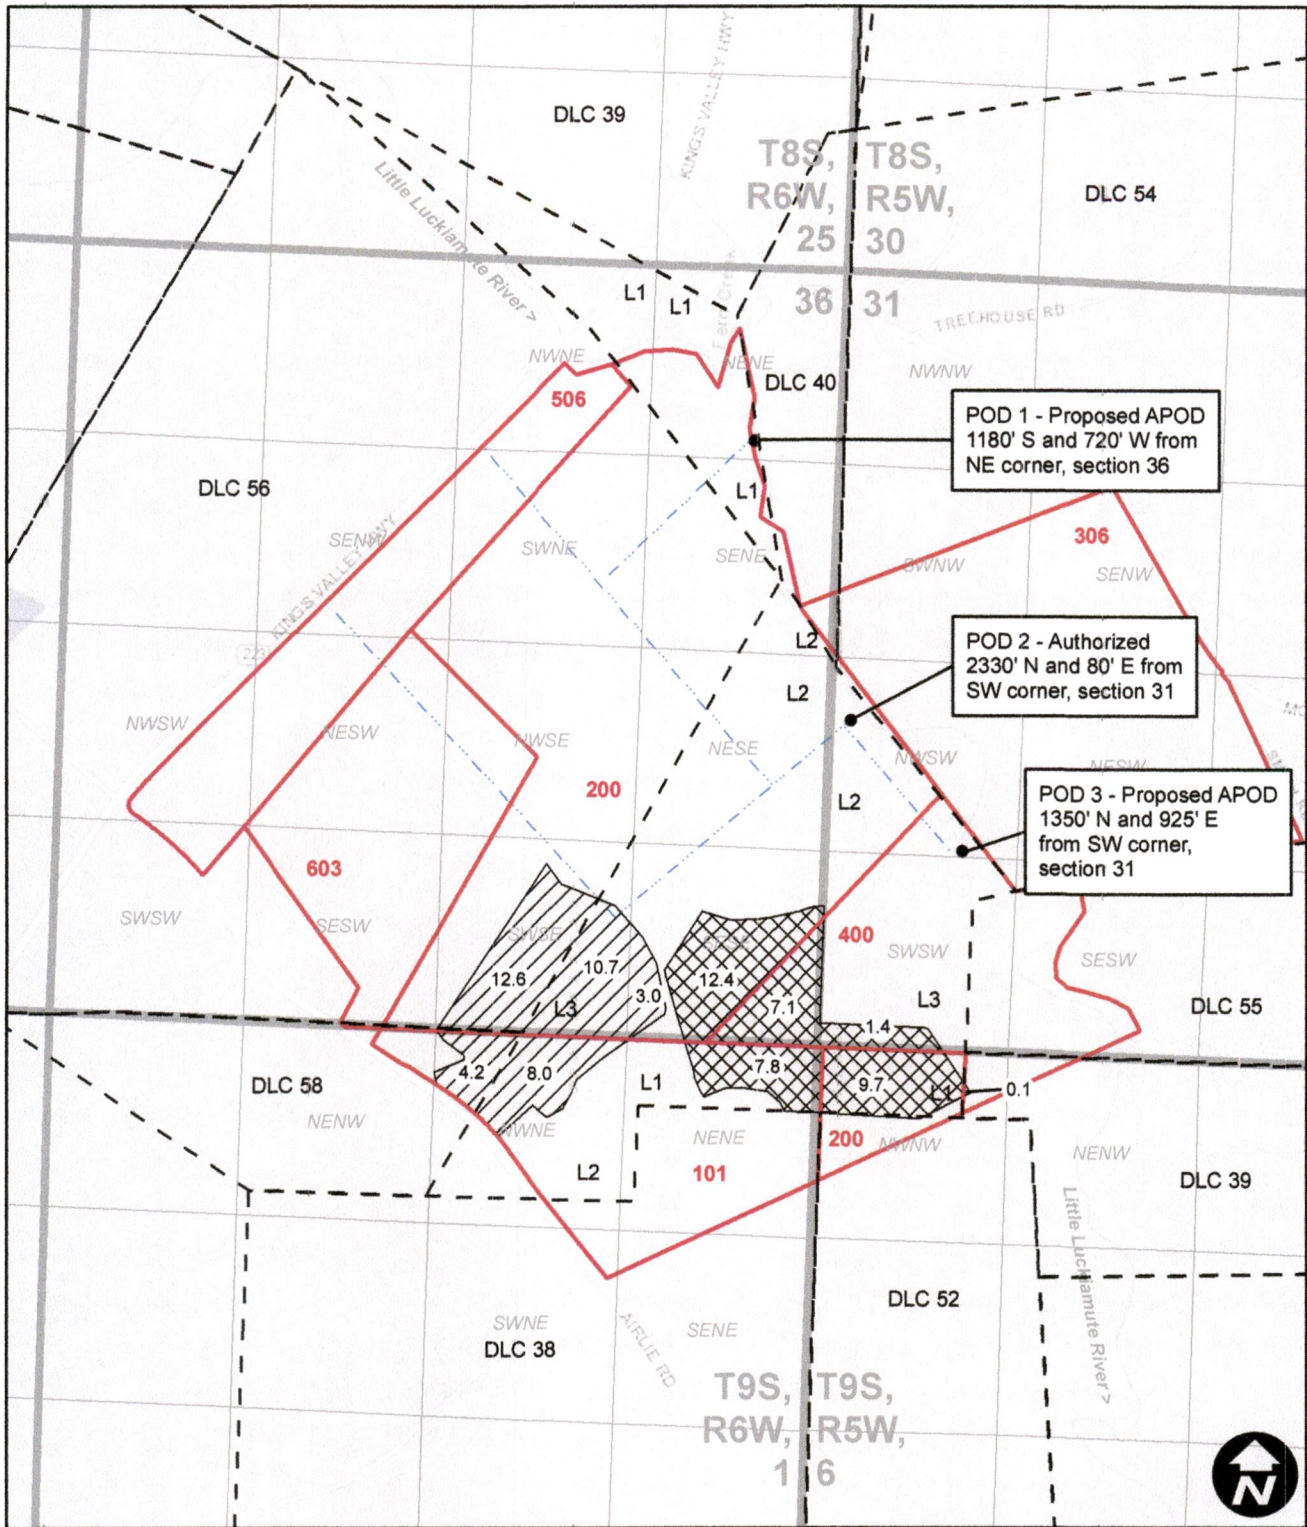

Legend

- 57711 From Mainline Taxlot Received by OWRD
- 57711 To DLC

0 660 1,320 2,640 Feet


MAY 23 2025

Salem, OR

WILL MCGILL SURVEYING LLC
14659 -

Temporary Transfer - Certificate 58749

Farmland Reserve, Inc.

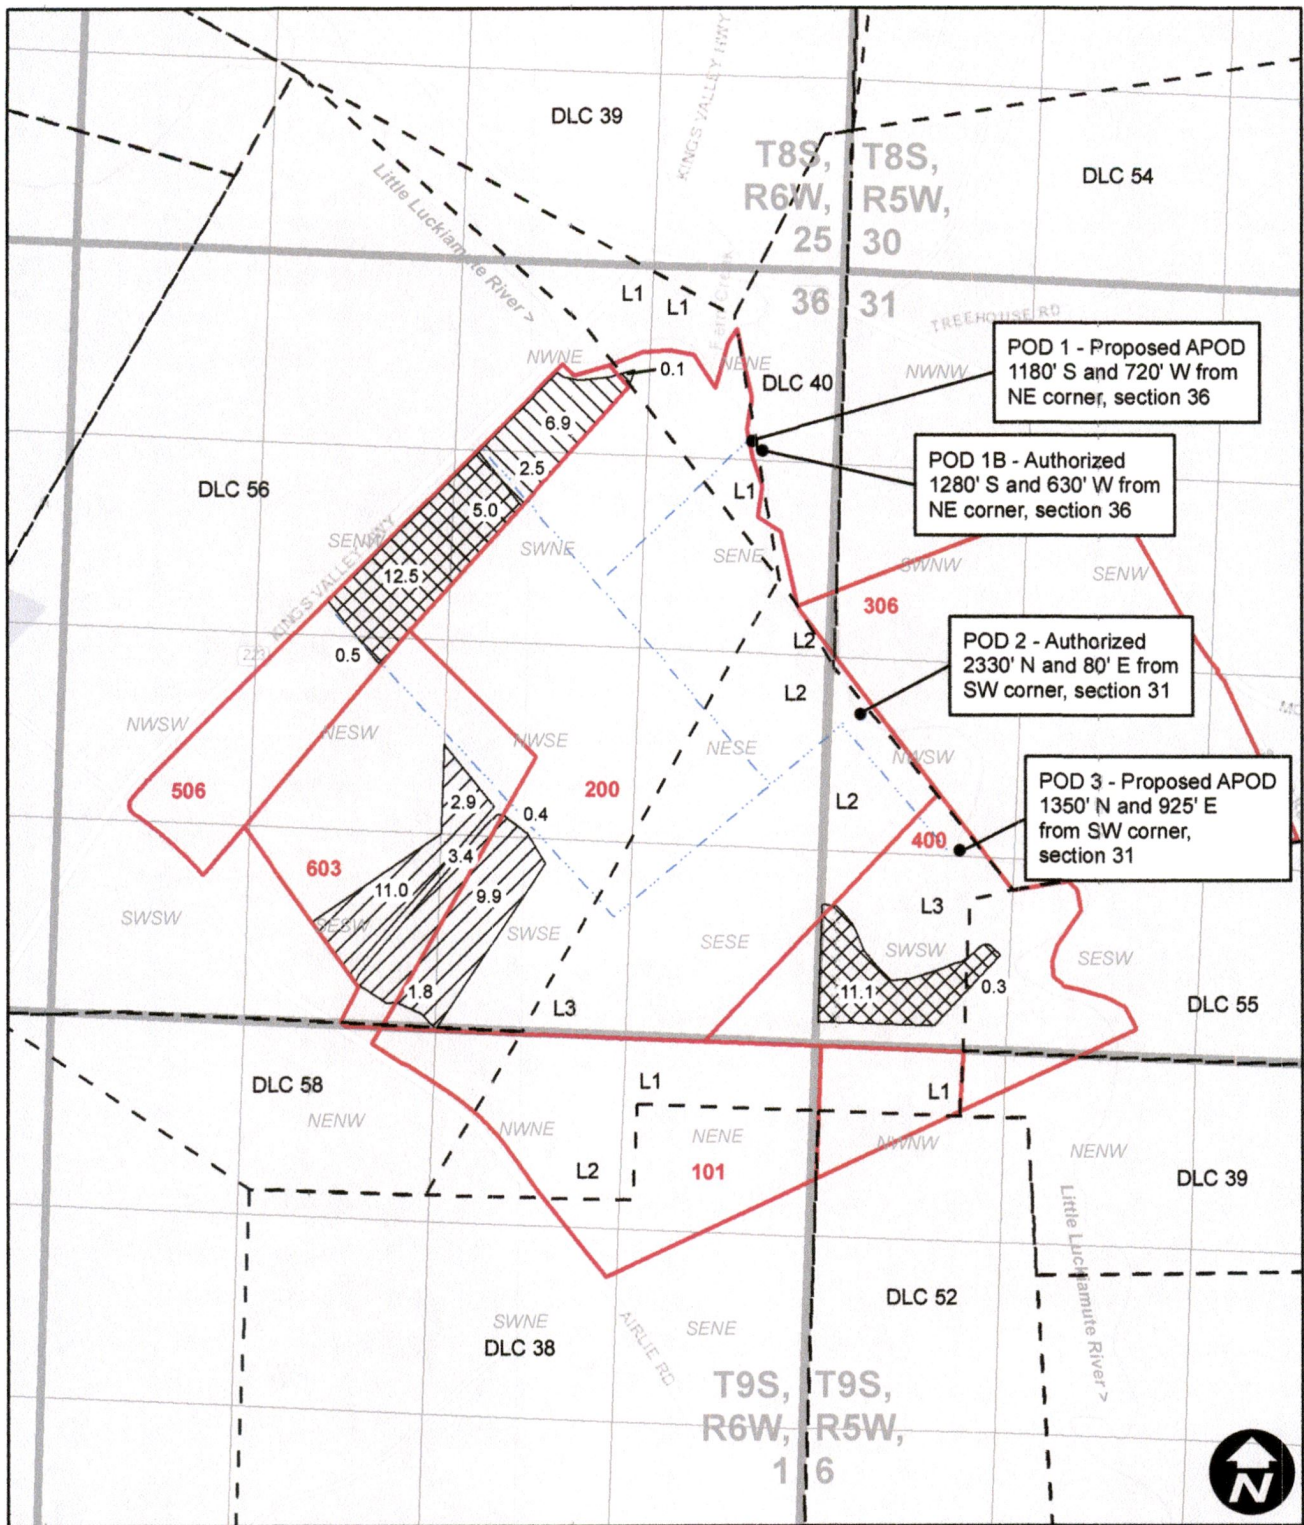

Legend

- 58749 From
- 58749 To
- 58749 No Change
- Mainline
- DLC
- Taxlot

Received by OWRD

MAY 23 2025

Salem, OR

WILL MCGILL SURVEYING LLC
14659 -