
Receipt # 142210

Receipt #

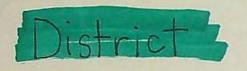

Name Ridgeview Irrigation District Address P.O. Box 67 Homedale, ID 83628 office @ sbocidaho.com Change in POU Date Filed 1/5/2024 Initial notice date 1/16/2024	Name of Stream Ar Trib. of Snake R Use Irrigation	n of water right(s) eservoir, Owyhe liver	County Malheu	r	Date -5-1024	FEES PAID Amount # 1360.00	Rece 147
DPD issued date	App#App#App#App#	Per #Per #Per #	Cert # Cert #	PR DatePR Date			Rece
Irrigation District Agent South Board of Control office @ sbocida ho. com CWRE CC's list BOR - Oversized map - Location							



Water Resources Department

North Mall Office Building 725 Summer St NE, Suite A Salem, OR 97301 Phone 503 986-0900 Fax 503 986-0904 www.oregon.gov/owrd

May 28, 2024

Ridgeview Irrigation District PO Box 67 Homedale, ID 83628

REFERENCE: District Transfer T-14378

Enclosed is a copy of the final order approving your District Transfer.

The time allowed to complete the transfer is specified in the final order. You are required to submit a claim of beneficial use to this Department within one year of the date you complete the change(s) or within one year of the completion date authorized final order whichever comes first. If necessary, you may request more time by filing for transfer extension. All extensions are subject to approval.

To file a claim please include:

- 1. A CLAIM OF BENEFICIAL USE form
- 2. A CLAIM OF BENEFICIAL USE SITE REPORT
- A Claim of Beneficial Use Map (this map does not need to be prepared by a Certified Water Rights Examiner (CWRE))

All forms needed to file a claim for a district transfer are available at https://www.oregon.gov/OWRD/programs/WaterRights/Transfers/DistTransfer/Pages/Forms.aspx

If you have any questions related to the approval of this transfer, you may contact your caseworker Ann Reece by telephone at (503) 979-3214 or by e-mail at Ann.L.Reece@water.oregon.gov.

Sincerely,

Elyse D. Richman

Water Right Services Support

Elype Richman

Transfers and Conservation Section

cc: Jered L. Hoshaw, Watermaster Dist. # 9 (via email)

South Board of Control, Agent

U.S. Bureau of Reclamation, Interested Party

Enclosure

BEFORE THE WATER RESOURCES DEPARTMENT OF THE STATE OF OREGON

In the Matter of Transfer Application)	FINAL ORDER APPROVING
T-14378, Malheur County)	A DISTRICT PERMANENT TRANSFER FOR A
)	CHANGE IN PLACE OF USE

Authority

Oregon Revised Statutes (ORS) 540.570 to 540.580 establish the process in which a district may submit a request to transfer a water right within district boundaries. Oregon Administrative Rule (OAR) Chapter 690, Division 385 implements the statutes and provides the Department's procedures and criteria for evaluating district transfer applications.

Applicant

RIDGEVIEW IRRIGATION DISTRICT PO BOX 67 HOMEDALE, ID 83628

Findings of Fact

- On January 5, 2024, RIDGEVIEW IRRIGATION DISTRICT (RID) filed a district transfer application to permanently change the place of use under Certificate 81012. The Department assigned the application number T-14378.
- Notice of the District Permanent Transfer Application was published on February 13, 2024, pursuant to ORS 540.580 and OAR 690-385-4400. No comments were filed in response to the notice.
- The U.S. Bureau of Reclamation was notified of the transfer application on February 13, 2024; no comments were received within 90 days of the notification.
- 4. On March 12, 2024, RID submitted superseding correcting maps.
- 5. The portion of the right to be transferred is as follows:

Certificate: 81012 in the name of U.S. BUREAU OF RECLAMATION (perfected under

Permit S-8179)

Use: IRRIGATION of 28.10 acres

This final order in a contested case and is subject to judicial review by the Court of Appeals under ORS 183.482. Any petition for judicial review must be filed within the 60-day time period specified by ORS 183.482(1). Pursuant to ORS 536.075(2) and OAR 137-003-0675, you may petition for judicial review or petition the Director for reconsideration of this order. A petition for reconsideration may be granted or denied by the Director, and if no action is taken within 60 days following the date the petition was filed, the petition shall be deemed denied.

Within 20 days after this final order is issued (i.e., mailing date), the district or any protestant may file with the commission exceptions to the final order. The commission shall issue an order granting or denying the exceptions within 30 days after receiving the exceptions. ORS 540.580(10).

Priority Dates: FEBRUARY 14, 1916 & AUGUST 19, 1924 (Live Flow), and FEBRUARY 15, 1916, and AUGUST 20, 1924 (Stored Water)

Limit/Duty: The amount of water from direct flow of the Owyhee River used for irrigation shall be limited to 1/60th of one cubic foot per second per acre, or its equivalent for each acre irrigated and shall be further limited to 3.0 acre-feet per acre for each acre irrigated during the irrigation season of each year. The amount of water from direct flow of the Owyhee River together with water store in Owyhee Reservoir and with the amount secured under any other water right existing for the same lands, shall be limited to a diversion of not to exceed 6.7 acre-feet for each acre irrigated during the irrigation season of each year.

Source: OWYHEE RIVER and OWYHEE RESERVOIR (constructed under Permit R-599), tributary to the SNAKE RIVER

Authorized Point of Diversion:

Twp	Rng	Mer	Sec	Q-Q	LOT	Measured Distances
22 5	45 E	WM	21	NW SW	1	TUNNEL #1: 264 FEET SOUTH AND 495 FEET EAST FROM THE W¼ CORNER OF SECTION 21

Authorized Place of Use:

IRRIGATION								
Twp	Rng	Mer	Sec	Q-Q	Acres	Tax Lot	Water User	Notice
22 S	14 E	WM	14	SW NE	7.00	200	HAYHURST	2023-03
22 S	14 E	WM	14	NENW	9.00	1800	HAYHURST	2023-03
22 S	14 E	WM	14	SE NW	3.50	1800	HAYHURST	2023-03
22 S	14 E	WM	14	NE SW	1.40	400	HOLMAN	2023-01
22 S	14 E	WM	26	NENW	1.10	3300	THOMAS	2023-02
22 S	14 E	WM	26	NW NW	1.40	3300	THOMAS	2023-02
22 S	14 E	WM	26	SW NW	1.70	3300	THOMAS	2023-02
22 S	14 E	WM	26	SE NW	3.00	3300	THOMAS	2023-02
				TOTAL	28.10			

6. Transfer Application T-14378 proposes to change the place of use to:

Proposed Place of Use:

IRRIGATION								
Twp	Rng	Mer	Sec	Q-Q	Acres	Tax Lot	Water User	Notice
22 S	46 E	WM	11	SW SE	4.60	1800	HAYHURST	2023-03
22 S	46 E	WM	14	SW NE	1.00	200	HAYHURST	2023-03
225	46 E	WM	14	NE SW	5.00	300	HAYHURST	2023-03
225	46 E	WM	14	NW SE	7.40	200	HAYHURST	2023-03
22 S	46 E	WM	14	SW SE	1.50	700	HAYHURST	2023-03
22 S	46 E	WM	26	NW NE	0.20	3300	THOMAS	2023-02
22 S	46 E	WM	26	SW NE	2.30	3300	THOMAS	2023-02
22 S	46 E	WM	26	NENW	0.90	3300	THOMAS	2023-02
22 S	46 E	WM	26	NW NW	2.00	3300	THOMAS	2023-02
225	46 E	WM	26	SE NW	1.80	3300	THOMAS	2023-02

IRRIGATION -									
Twp	Rng	Mer	Sec	Q-Q	Acres	Tax Lot	Water User	Notice	
22 S	46 E	WM	36	SW NE	0.90	100	HOLMAN	2023-01	
22 S	46 E	WM	36	SE NE	0.50	100	HOLMAN	2023-01	
				TOTAL	28.10				

- 7. The Department finds that the district permanent transfer application was submitted according to ORS 540.580 and OAR 690-385-4000, contains the information required under OARs 690-385-4200 and 690-385-2000, and includes maps meeting the requirements of OARs 690-385-4300 and 690-385-2200.
- 8. The Department finds that the proposed district permanent transfer meets all the criteria set forth in ORS 540.580 and OAR 690-385-4000.
- 9. The water right is subject to transfer as defined in OAR 690-385-0100(17).
- 10. The proposed change in place of use will not result in enlargement of the right as defined in OAR 690-385-0100(4).
- 11. The proposed change in place of use will not result in injury to other water rights as defined in OAR 690-385-0100(6).
- 12. Any other applicable requirements for district permanent water right transfers are met as required in OAR 690-385-4500.

Conclusions of Law

The proposed change in place of use as proposed in Transfer Application T-14378 comply with and satisfy the requirements of ORS 540.580 and OAR 690-385-4500.

Now, therefore, it is ORDERED:

- The proposed change in place of use to the water right evidenced by Certificate 81012 is approved.
- The place of use from which the water right is transferred off by Transfer T-14378 shall no longer be irrigated and is cancelled from Certificate 81012.
- The right to the use of the water at the place of use NOT modified by this order is restricted to beneficial and is subject to all other conditions and limitations contained in Certificate 81012.
- 4. The water user shall maintain and operate the existing measurement device and shall make such improvements as may be required by the Department.
- Full beneficial use of the water shall be made, consistent with the terms of this order, on or before October 1, 2025. A Claim of Beneficial Use shall be submitted by RID to the Department within one year after the deadline for completion of the changes and full beneficial use of the water.

6. Water right Certificate 81012 is modified. After satisfactory proof of completion has been determined by the Department, a superseding water right certificate will be issued when the Department determines it is necessary for record keeping.

MAY 2 8 2024 Dated in Salem, Oregon on

Lisa J. Jaramillo Transfer and Conservation Section Manager, for Douglas E. Woodsock, Acting Director

Oregon Water Resources Department

Mailing Date: MAY 2 9 2024

Watermaster Review Form: Water Right Transfer



Oregon Water Resources Department 725 Summer St NE, Suite A Salem, Oregon 97301-1266 (503) 986-0900 www.oregon.gov/OWRD

Transfer Application: T-14378

Review Due Date:

Applicant Name: Ridgeview Irrigation District	
Proposed Changes: POU POD POA USE OTHER	
Reviewer(s): Jered Hoshaw Date of Review: 02/26/20	24
 Do you have <u>evidence</u> that the right has not been used in the last 5 years and forfeiture would not likely be rebuttable? Yes ✓ No If "Yes", attach e aerial photo showing pavement or building on the land for >5 yrs.) 	
2. Is there a history of regulation on the source that serves this (or these) right(s) transferred right(s) and downstream water rights? ☐ Yes ✓ No Gener frequency of any regulation or explain why regulation has not occurred:	that has involved the ally characterize the
3. Have headgate notices been issued for the source that serves the transferred Yes No ✓ Records not available.	right(s)?
4. In your estimation, after the proposed change, would distribution of water for regulation of other water rights that would not have occurred if use under the was/were maximized? Yes V No If "Yes", explain:	
5. In your estimation, if the proposed change is approved, are there upstream was be affected? Yes No If "Yes", describe how the rights would be affected:	

Transfer Application

Watermaster Review Form

Watermaster Review Form

Transfer Application

	porary transfer of this nature been previously filed and approved on the same lands as thereof) as those lands involved in this transfer?
Yes	No If "Yes", answer the following:
	i. Were there any problems with more acres being irrigated (or wetted) than were authorized under the temporary transfer? Yes No If "Yes", explain:
	ii. Did the designated areas that were to remain dry (or not wetted) under the temporary transfer actually remain dry? Yes No If "No", explain:
	iii. Did the applicant comply with and meet all of the conditions of the temporary transfer? Yes No If "No", explain:
	iv. Do you have any other observations regarding the temporary transfer? Yes No If "Yes", describe:
	v. Did the applicant demonstrate to the Department through monitoring and site inspections by the Watermaster that neither injury nor enlargement occurred as a result of the temporary transfer? Yes No If "No", explain:
c. To the	best of your knowledge, if this transfer is approved, does it appear that:
	i. "Injury" will occur to other water rights that share the same source? Yes No If "Yes", explain:
	ii. "Enlargement" of the water right being transferred will occur? Yes No If "Yes", explain:

Salem, OR 97301-1266

Oregon Water Resources Department

Measurement Condition Information for the Applicant

(To be sent with the Draft Preliminary Determination or Final Order)

Transfer #: T-
In order to avoid enlargement of the right or injury to other rights, a be required to be installed <u>prior to diversion of water</u> , as a condition of this transfer: at each point of diversion/appropriation (new and existing) OR at each new point of diversion/appropriation.
For additional information, or to obtain approval of a different type of measurement device, the applicant should contact the area Watermaster:
Watermaster name:
District:
Address:
City/State/Zip:
Phone:
Email:
Note: If a device other than the one specified in the Preliminary Determination or Final Order is approved by the Watermaster, fill out and mail the form below to the Salem office. ***********************************
Approval of an Alternate Measurement Device T- (to be filled out after consultation with the applicant, or after a site visit) On behalf of the Director, I authorize use of the following suitable alternate measurement device:
Watermaster signature District Date
If this form is used for approval of an alternative measurement device, it must be mailed to:
Oregon Water Resources Department
725 Summer Street NE, Suite A

TACS Page 5 of 5 Last revised May 2019

WATER RIGHT TRANSFER COVER SHEET

Transfer: T-1	4378						Tran	sfer Speci	alist:		
Transfer Type	: District Perm	nanent Transf	er	Reimburse	ement Authority	? 🔲					
PO Box 67	/ Irrigation Dis / e, ID 83628	trict	PO Bo					andowne	g		
Current Lan	downer if other	than Applicant	CWRE	:		Irri	igation D	istrict:			
Affected Lo	ocal Gov'ts:		Affect	ed Tribal Gov'	t:	BC	OR Notifi	ed (date):			
Water Rights	Affected										
File Marked	App. File #	or Decree Nam	e	Permit	Certificate	e		Needed	RR/CR Nos.		
							Yes Yes Yes	No No No			
Key Dates &	Initial Actions (S	upport Staff)									
Rec'd: January 5, 2024				roposed Action(s): PLACE OF USE							
Fees Pd: 1360.00			Acknowl	Acknowledgement Letter Sent				Basin: 11 Owyhee			
Initial Public Notice: 1/16/2024			County s	County sent cc: of Ack Letter				ALHEUR			
WM District: 9 Jered L. Hoshaw			WM Rev	iew request se	ent:	WI	M Review	date rece	eived:		
ODFW Distr	rict:		ODFW R	ODFW Review sent:				ew date re	eceived:		
Groundwat	er		GW Revi	GW Review sent:			V Review	date rece	ived:		
Caseworker /	Actions: Newspa	per & PD Notice	2:								
Newspaper	notice needed: [ne of Newspape						
Newspaper	notice sent to co	oordinator:		Nev	vspaper notice o	uote r	equeste	d (NRS1):			
TANKS A SE	news \$ sent:			News \$ received:							
Affidavit of	publication recei	ved:		Last	day of publicati	on:					
Peer Review:							200 1 10				
Document	Drafted Date: Initials:		Da	Coordinator ate: itials:	Changes Made Date: Initials:		CW Sent		Signature Date		
PD	Date: Initials:	Date: Initials:		ate: itials:	Date: Initials: Data Review Date:		Date:		Date:		
FO	Date:	and the same of		itials:	Date:	-	Date: No. of desig:	ocs for	Date:		

Transfer Cover Sheet Last Revised 1/26/2023



Water Resources Department

North Mall Office Building 725 Summer St NE, Suite A Salem, OR 97301 Phone 503 986-0900 Fax 503 986-0904 www.oregon.gov/owrd

January 10, 2024

Ridgeview Irrigation District PO Box 67 Homedale, ID 83628

Reference: District Permanent Transfer T-14378

On January 5, 2024, we received your district transfer application requesting PLACE OF USE changes. The application was accompanied by \$1360.00. Your receipt number 142210 is enclosed.


By copy of this letter, we are asking the Watermaster for their report regarding the potential for injury to existing water rights which may be caused by the change.

This application will be published on the Department's weekly notice dated January 16, 2024, viewable at http://apps.wrd.state.or.us/apps/misc/wrd notice view/?notice id=21. A copy of the application can be assessed through this public notice link. Pursuant to Oregon administrative rules, the Department is requesting public comments on the recently filed district transfer application listed above. Comments may be submitted by any interested persons within 30 days of the weekly notice publication date. Comments must be received by the Department on or before February 15, 2024. For details on how to file comments please refer to the Department's weekly notice. Details for filing protests, if applicable, are also noted on the weekly notice.

If you have any questions, please call the Transfer Section, (503) 986-0935.

cc: Watermaster # 9, Jered L. Hoshaw (via email)
Bureau of Reclamation

Enclosure

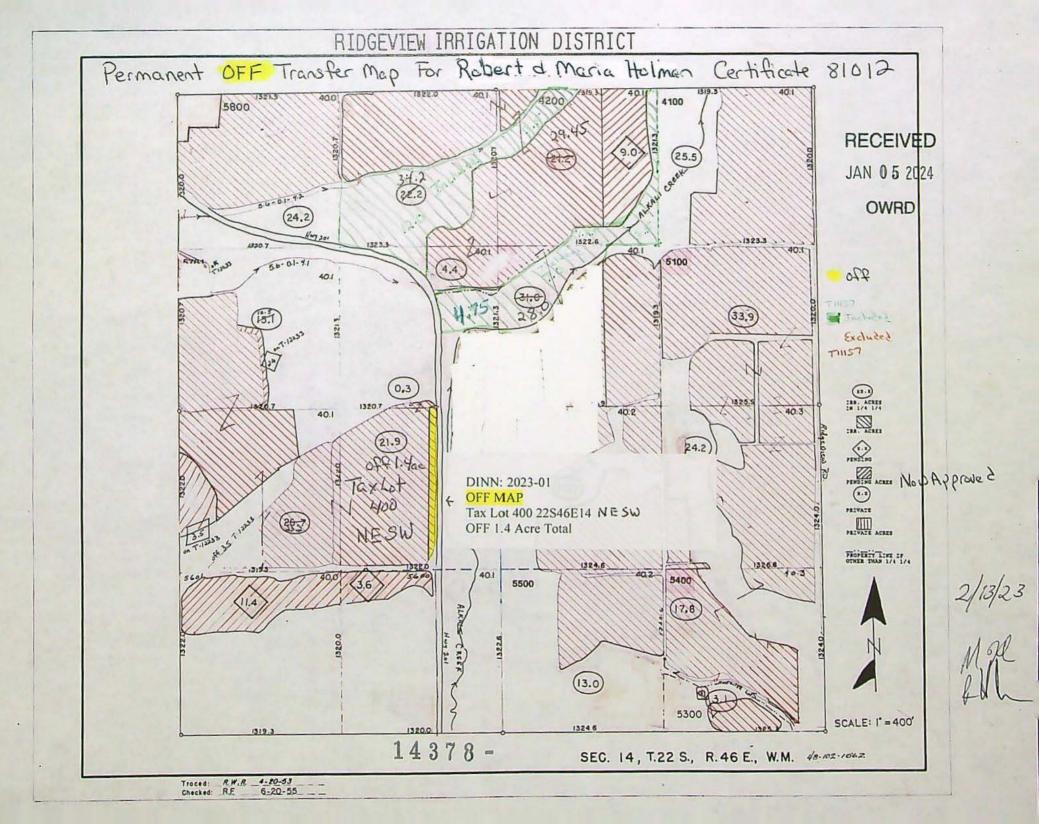

STATE OF OREGON WATER RESOURCES DEPARTMENT

RECEIPT #142210

725 Summer St. N.E. Ste. A SALEM, OR 97301-4172 (503) 986-0900 / (503) 986-0904 (fax)

INVOICE #

	X 1212		X	TOTAL REC'D	15/360
1083	TREASURY	4170 WRD	MISC CASH AC	CCT	
0407	COPIES				S
	OTHER: (IDENTIFY)			S
0243 I/S Le	ease 0244	Muni Water Mgmt	. Plan 024	5 Cons. Water _	
			OPERATING A		
	MISCELLANEOUS	3	46110		
0407	COPY & TAPE FE		10110		S
0410	RESEARCH FEES				S
0408	MISC REVENUE:	(IDENTIFY)			\$
TC162	DEPOSIT LIAB. (IDENTIFY)			S
0240	EXTENSION OF T	IME			S
	WATER RIGHTS:		EXAM FEE		RECORD F
0201	SURFACE WATER	3	0202	S	
0203	GROUND WATER		S	0204	S
0205	TRANSFER		\$13600	0	
	WELL CONSTRU	CTION	EXAM FEE		LICENSE F
0218	WELL DRILL CON	STRUCTOR	\$	0219	S
	LANDOWNER'S F	PERMIT		0220	\$
	OTHER	(IDENTIFY)			
			. COLUCT OTAL	TEE	
0536	TREASURY	0437 WEL	L CONST. STAF	The second second	
0211	WELL CONST ST	ART FEE	S	CAR	77000
0210	MONITORING WE	LLS	\$	CAR	D#
	OTHER	(IDENTIFY)			
0607	TREASURY	0467 HYD	RO ACTIVITY	LIC NUMBER	
0233	POWER LICENSE				S
0231	HYDRO LICENSE				\$
0201	HYDRO APPLICA				\$
			IED (DDV		
	TREASURY	OIF	IER / RDX		
FUND .		TITLE			
	E	_ VENDOR #			
DESCRIPT					S

PRECEIPT: 142210

DATED: STUDY BY:

Distribution - White Copy - Customer, Yellow Copy - Fiscal, Blue Copy - File, Buff Copy - Fiscal



Oregon Water Resources Department 725 Summer Street NE, Suite A Salem Oregon 97301-1266 (503) 986-0900 www.wrd.state.or.us

Application for District Permanent Water Right

Transfer

Please type or print legibly in dark ink. If your application is incomplete or inaccurate, we will return it to you. If any requested information does not apply to your application, insert "N/A" to indicate "Not Applicable." As you complete this form, please refer to notes and guidance included on the application. A summary of review criteria and procedures that are generally applicable to the application is available at www.wrd.state.or.us/OWRD/PUBS/forms.shtml#app criteria review.

Change in Place of Use Only

1A. APPLICANT INFORMATION

IRRIGATION DISTRICT Ridgeview Irrigation District			ADDITIONAL CONTACT NO.		
			COUNTY Malheur		
STATE ID	ZIP 83628	E-MAIL office@sbocidaho.	com		
	ID	ID 83628			

1B. AGENT INFORMATION

AGENT/BUSINESS NAME South Board of Contr			PHONE NO. 208-337-3760	ADDITIONAL CONTACT NO.		
ADDRESS P. O. Box 67	OI .		FAX NO. 208-337-5107			
CITY Homedale	STATE ID	ZIP 83628	E-MAIL office@sbocidaho	.com		
				CORRESPONDENCE FROM THE ENTS WILL ALSO BE MAILED.		

2. PROPOSED CHANGE(S) TO WATER RIGHT(S)

 List <u>all</u> water rights to be affected by this transfer. Indicate the certificate, permit, decree or other identifying number(s) in the table below: (Attach additional pages as necessary.)

	Certificate	Permit / Previous Transfer	Decree
1.	81012	-8171	
2.			DECENTED.
3.		-	RECEIVED
4.		-	JAN 0 5 2024
5.			OWRD
6.			OWIL

3. ATTACHMENTS

Check each of the following attachments included with this application. The application will be returned if all required attachments are not included.

Supplemental Form A -

Description of Proposed Change(s) to a Water Right

A <u>separate</u> Supplemental Form A is enclosed for <u>each</u> water right to be affected by this transfer.

Map

Permanent Transfer

A map meeting the requirements of OAR 690-385-3300 must be included but need not be prepared by a Certified Water Right Examiner (CWRE).

Fees:

Amount enclosed: \$ 1360.00
 See the Department's Fee Schedule at www.wrd.state.or.us or call (503) 986-0900.

Land Use Compatibility Statement

☐ The Land Use Information Form is <u>not</u> required if water is to be diverted, conveyed and/or used only on federal lands or if <u>ALL</u> of the following apply: a) a change in place of use only, b) a change that does not involve the placement or modification of structures, c) the use of water is for irrigation only and d) the use is located within an irrigation district or an exclusive farm use zone.

4. SIGNATURES

The district certifies the following:

- The water rights proposed for transfer are water rights subject to transfer and are not subject to forfeiture for nonuse under ORS 540.610;
- (2) Each user affected by the proposed transfer has provided written authorization for the transfer and such authorization is on file with the district;
- (3) For lands which are no longer irrigated or susceptible of irrigation that are included in this transfer under the authority of ORS 540.572 and OAR 690-385-5000, notices as required under ORS.572 and OAR 690-385-5100 have been given to the user and any security interest holder of record of intent to transfer the right and the user was provided an opportunity to resolve the matter in the manner described by ORS 540.572 and OAR 690-385-5400 and 690-385-5600.
- (4) On behalf of the district, I affirm to the best of my knowledge the information contained in this application is true and accurate.

District Manager signature

Carl Seiders

(2/29/23)

OR

Authorized District Representative signature

name (print)

date

RECEIVED

JAN 0 5 2024

OWRD

Before submitting your application to the Department, be sure you have:

- Answered each question completely.
- Included all the required attachments.
- Included a check payable to the Oregon Water Resources Department for the appropriate amount.



District Permanent Water Right Transfer Application Supplemental Form A

DESCRIPTION OF PROPOSED CHANGE(S) TO A WATER RIGHT

List only one water right per page. A separate Supplemental Form A must be completed for each certificate, permit, decree, or other right involved in the proposed transfer.

Attach additional copies of Supplemental Form A as needed to describe other certificates, permits, decrees or other rights involved in this transfer.

1. CURRENT WATER RIGHT INFORMATION

Water Right Subject to Transfer (check and complete one of the following):

\boxtimes	Certificated Right	81012		
	Certificated Right	Certificate Number		
	Adjudicated, Non-certificated Right	Name of Decree	Page Number	
	Permit for which Proof has been Approved	- Permit Number	Date Claim of Beneficial Use Sub-	mitted
	Transferred Right for which Proof has been Filed	- Previous Transfer Number	Date Claim of Beneficial Use Sub-	mitted
	Permit for Supplemental Irrigation	- Permit Number		
	Name on Permit, Certificate, of Priority Date(s): 2/15/1916 & 8 If there are multiple Priority I provided in Supplemental Form date is associated with each of places of use. Source(s) of Water to be Affective Priority I provided in Supplemental Form date is associated with each of places of use.	8/20/1924 Dates identified on the wat n A of this application must the authorized points of di	st identify which priority version or appropriation and	d
	Tributary to: Snake River Are there other water rights,			
	this land?			1
	☐ Yes ☐ No If "Yes", what are the Permit, I	Registration or Certificate	Numbers?	RECEIVED JAN 0 5 2024

Certificate Number or other identifying number: 81012

The following information must be provided only for those points of diversion or appropriation that are involved in the transfer.

If a point of diversion or appropriation is not numbered on the decree or water right certificate or permit, assign it a unique number in the following table (e.g. POD #1 or POA(well) #1). Use the number to refer to the point of diversion or appropriation serving the place of use described in Tables I and II. Note: Permanent district transfers do not allow for a change in point of diversion or appropriation to serve the proposed place of use.

Government lot and donation land claim numbers must be included in the table below only if the information is reflected on the existing water right.

Location of Existing Authorized Point(s) of Diversion (POD) or Appropriation (POA):

(i.e., the allowed point(s) of diversion or appropriation listed on the water right for the "FROM" or "OFF" lands)

			AUTHOR	IZED POIN	T(S) of D	IVERSIC	ON (POD) or APPROPRIATION (POA)
POD# or POA#	TWP	RNG	SEC	QQ	DLC	GOV'T LOT	MEASURED DISTANCES
1	22 S	46 E	10	NW SW			(Tunnel No. 1) Lot 1 NWSW, Sec. 21, T22S R45E, WM; 495 Ft. E and 264 Ft. S
1	22 S	46 E	10	NE SW			from common corner to Sec. 20 and 21
							RECEIVED
							JAN 0 5 2024
							OWRD

Certificate Number or other identifying number: 81012

Provided the district filed notice of a change in place of use pursuant to OAR 690-385-4100, reference the District Internal Notice Number (DINN) used to describe the change(s) to be made permanent by this transfer.

Government lot (GOV"T LOT) and donation land claim numbers (DLC) must be included in the tables below only if the information is reflected on the existing water right.

								7,077	ZED PLACE	OF USE		
POD#					LEGAL DESCRIP							
or POA#	PRIORITY DATE	USE	TWP	RNG	SEC	QQ	DLC	GOV'T LOT	TAXLOT	ACRES	USER NAME	DINN
	Attached &										COEXTAINE	DIM
											RECEIVED	
											JAN 0 5 2024	
- 1											OWRD	
									TOTAL:			

Authorized or Off Lands

Certificate 81012

POD	Priority	Use	TWP	RNG	Sec	QQ	Gov't L	Tax Lot	Acres	User Name	DINN
1	2/14/2016 8/19/2024	IR	225	46E	14	NESW		400	1.4	Robert & Maria Holman	2023-01
1		IR	225	46E	26	NWNW		3300	1.4	James Thomas	2023-02
1	11	IR IR	22S 22S	46E	26 26	SWNW		3300 3300	1.7 3.0	James Thomas James Thomas	2023-02
1	311	IR	225	46E	26	NENW		3300	1.1	James Thomas	2023-02
1	ш	IR	225	46E	14	SENW		1800	3.5	James Hayhurst	2023-03
1	n n	IR IR	22S 22S	46E	14	SWNE NENW		200 1800	7.0 9.0	James Hayhurst James Hayhurst	2023-03
						Tot	tal Acres	OFF	28.1		

JAN 0 5 2024 OWRD Certificate Number or other identifying number: 81012

					TA	BLE II	. – PRO	POSED	PLACE OF	USE		STEEL STATE
POD /					LE	GAL D	ESCRIP					
POA #	PRIORITY DATE	USE	TWP	RNG	SEC	QQ	DLC	GOV'T LOT	TAX LOT	ACRES	USER NAME	DINN
See	Attached	Excel	Shoe	+								
											RECEIVED	
											JAN 0 5 2024	
											OWRD	
									TOTAL:			

Proposed or ON Lands

Certificate 81012

POD	Priority	Use	TWP	RNG	Sec	QQ	Gov't L	Tax Lot	Acres	User Name	DINN
1	2/14/2016	IR	225	46E	36	SWNE		100	0.9	Robert & Maria	2023-01
	8/19/2024									Holman	
1	11	IR	225	46E	36	SENE		100	0.5	R & M Holman	2023-01
1	'n	IR	225	46E	26	NWNW		3300	2.0	James Thomas	2023-02
1	n'	IR	225	46E	26	SENW		3300	1.8	James Thomas	2023-02
1	11	IR	225	46E	26	SWNE		3300	2.3	James Thomas	2023-02
1	п	IR	225	46E	26	NWNE		3300	0.2	James Thomas	2023-02
1	"	IR	225	46E	26	NENW		3300	0.9	James Thomas	2023-02
1	11	IR	225	46E	14	SWSE		700	1.5	James Hayhurst	2023-03
1	"	IR	225	46E	14	NWSE		200	7.4	James Hayhurst	2023-03
1	11	IR	225	46E	14	NESW		300	5.0	James Hayhurst	2023-03
1	"	IR	225	46E	14	SWNE		200	1.0	James Hayhurst	2023-03
1	Ü	IR	225	46E	11	SWSE		1800	4.6	James Hayhurst	2023-03
						То	tal Acres	ON	28.1		

Gem Irrigation District

Ridgeview Irrigation District

P. O. Box 67, Homedale, ID 83628 Phone (208)337-3760 Fax (208)337-5107

December 29, 2023

Oregon Water Resources Department 725 Summer Street NE, Suite A Salem, Oregon 97301-1266

Attention: Water Right Transfer Department

Please find enclosed a payment calculation sheet, a check for \$1360 and Application for District Permanent Water Right Transfer followed by supplemental form A and maps for the following water users:

- Robert & Maria Holman (DINN #2023-01)
- James Thomas (DINN #2023-02)
- James Hayhurst (DINN #2023-03

A copy has also been forwarded to Jered Hoshaw, Watermaster for review. Please contact our office at 208-337-3760 if you have any questions.

Thank You,


Anita Johnston, Office Clerk South Board of Control


RECEIVED


JAN 0 5 2024

14378 -


OWRD

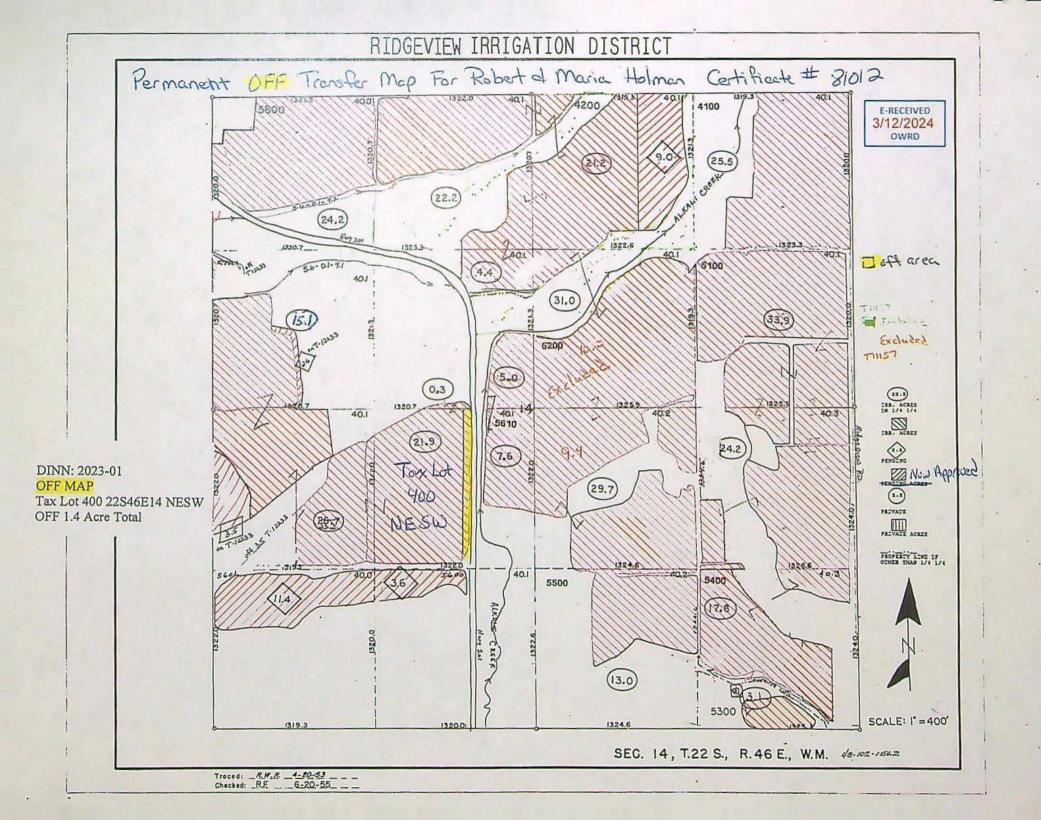


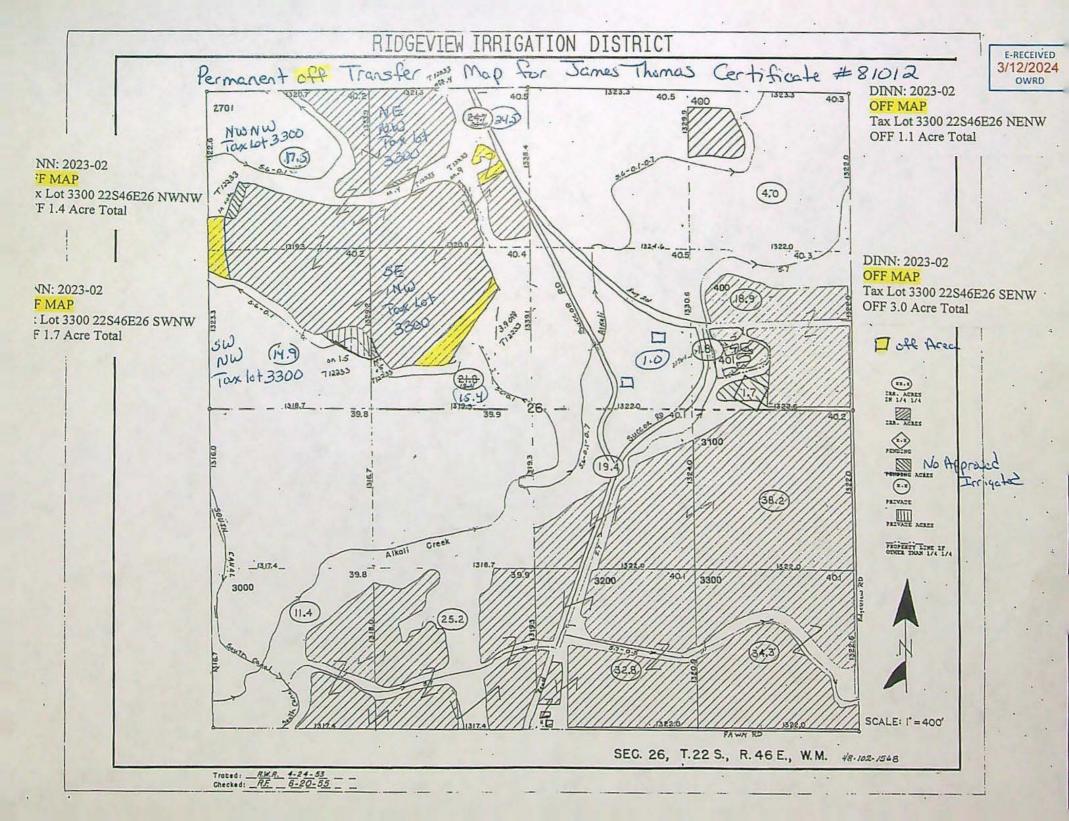


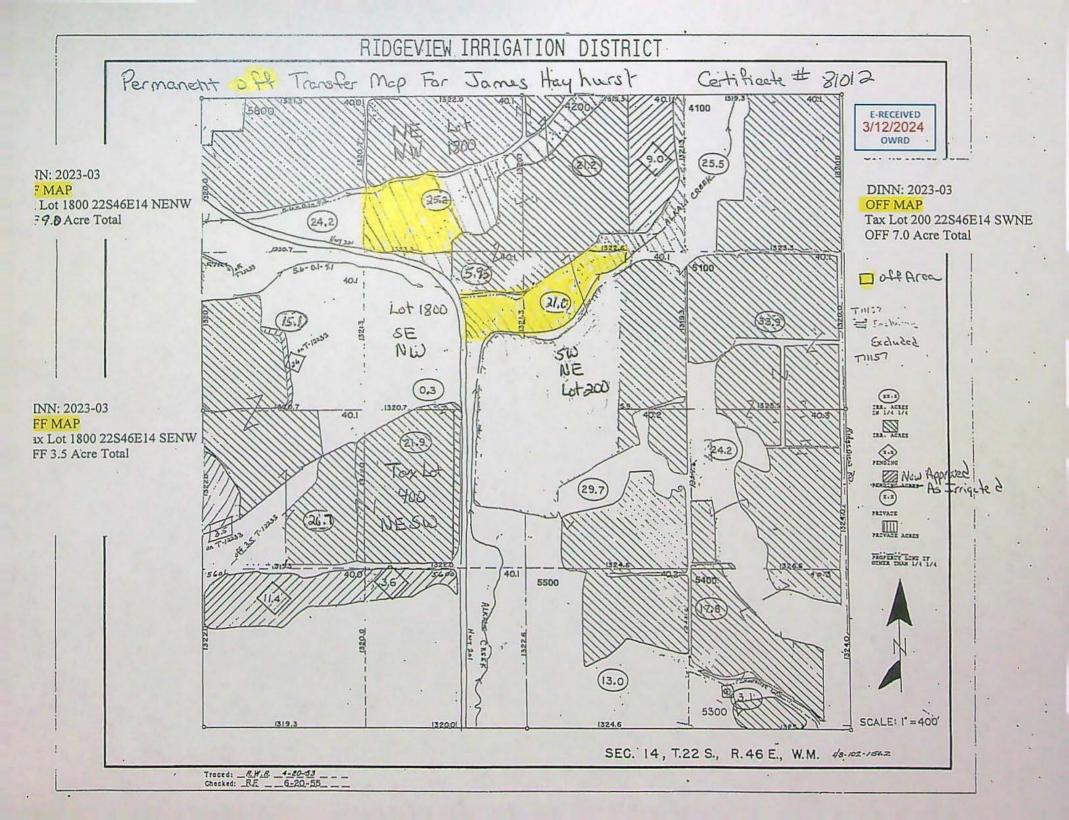



SHECEIVED 3/12/2024 OWRD

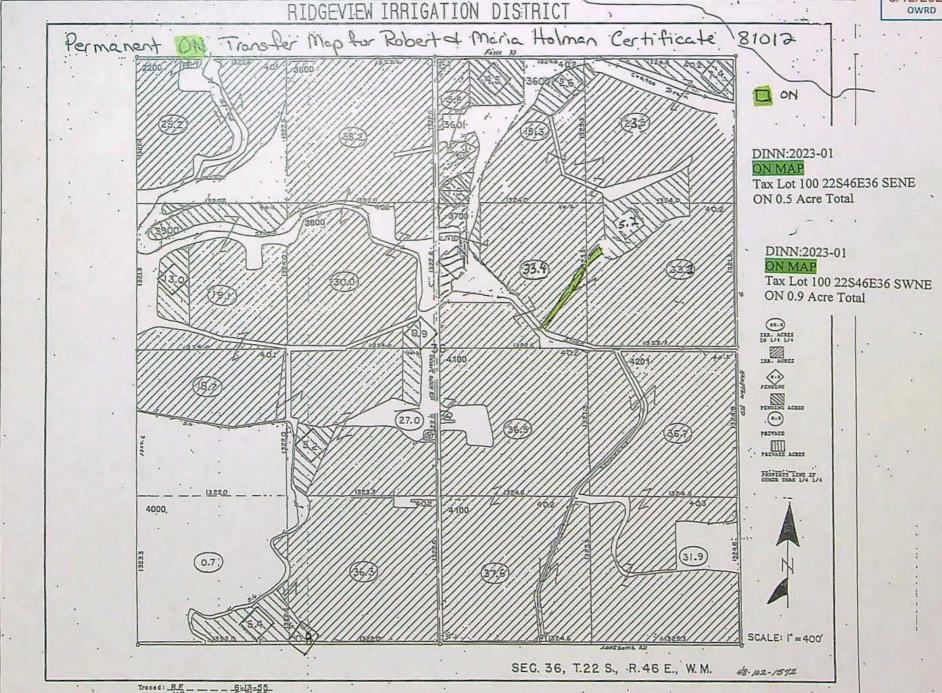


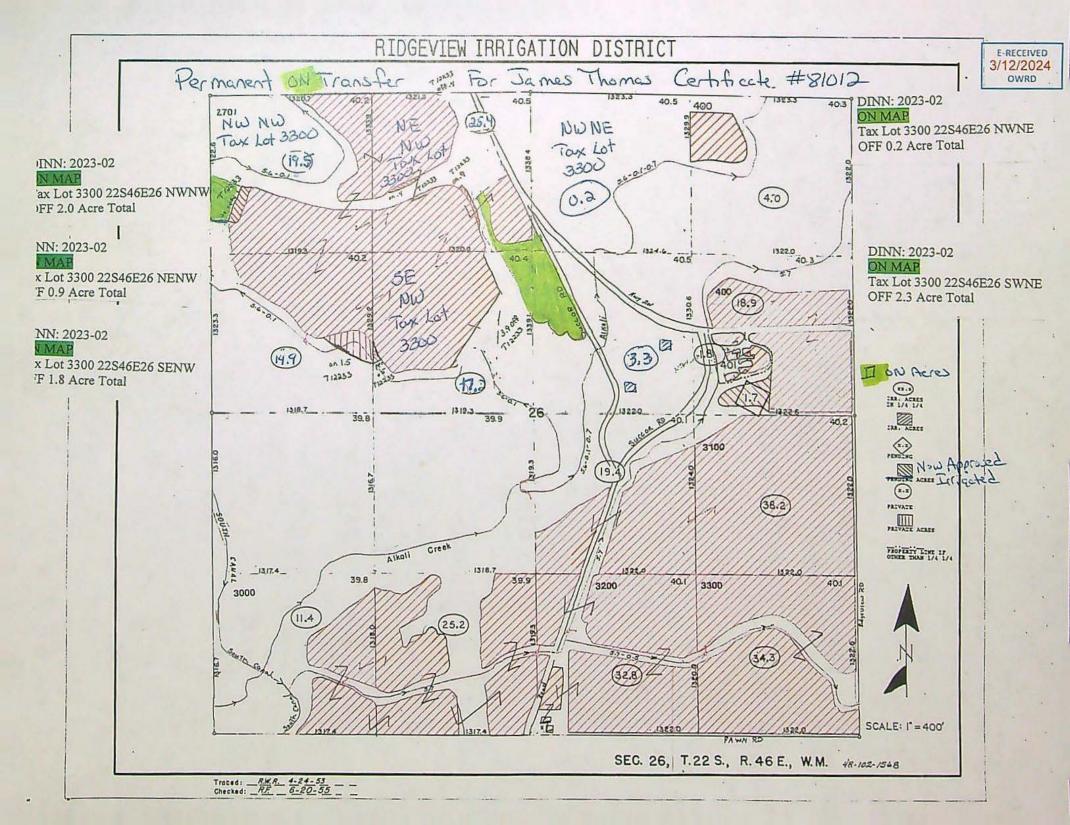


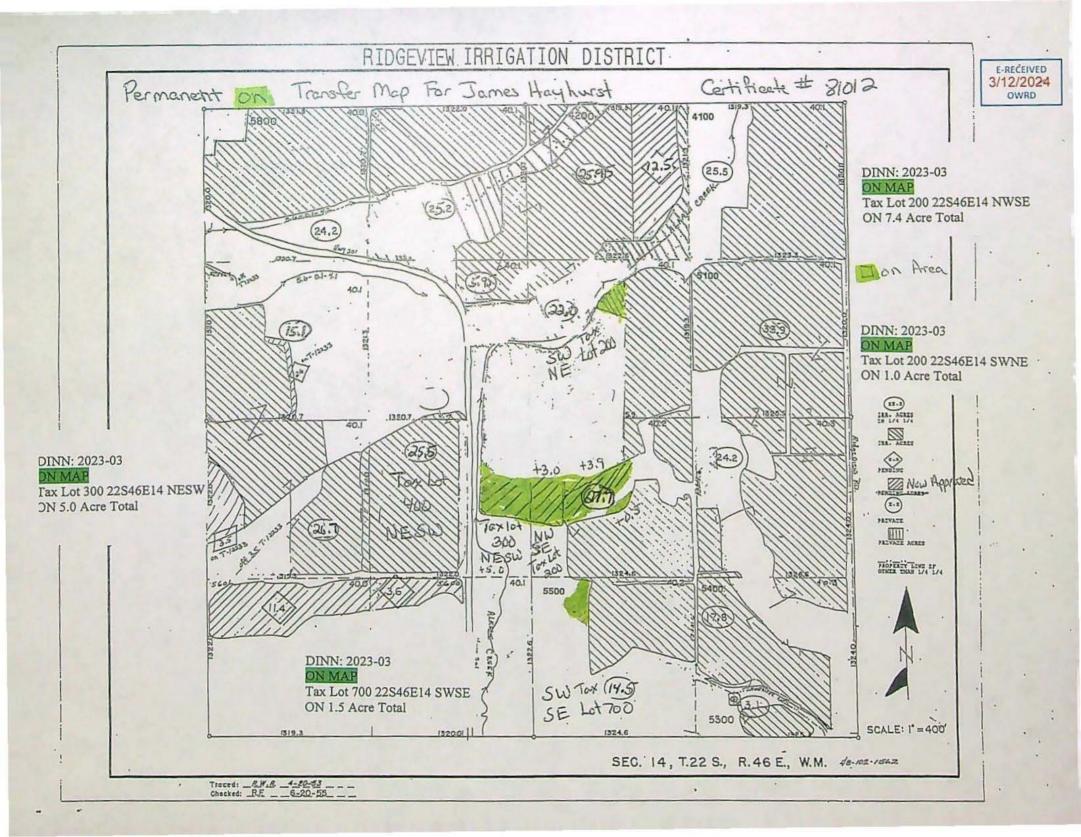


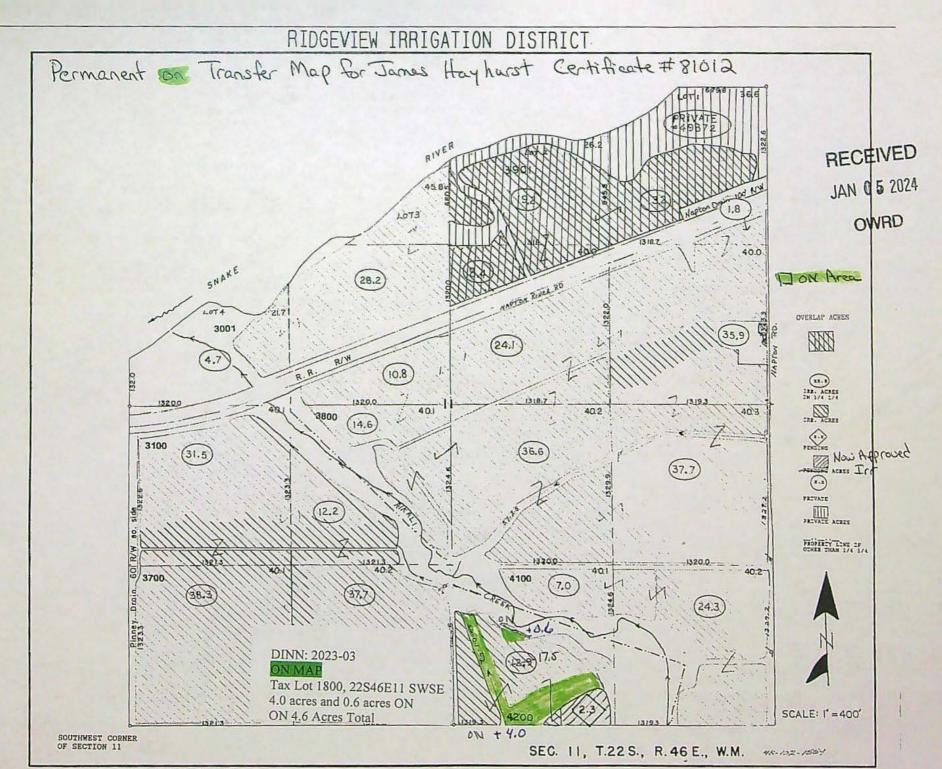


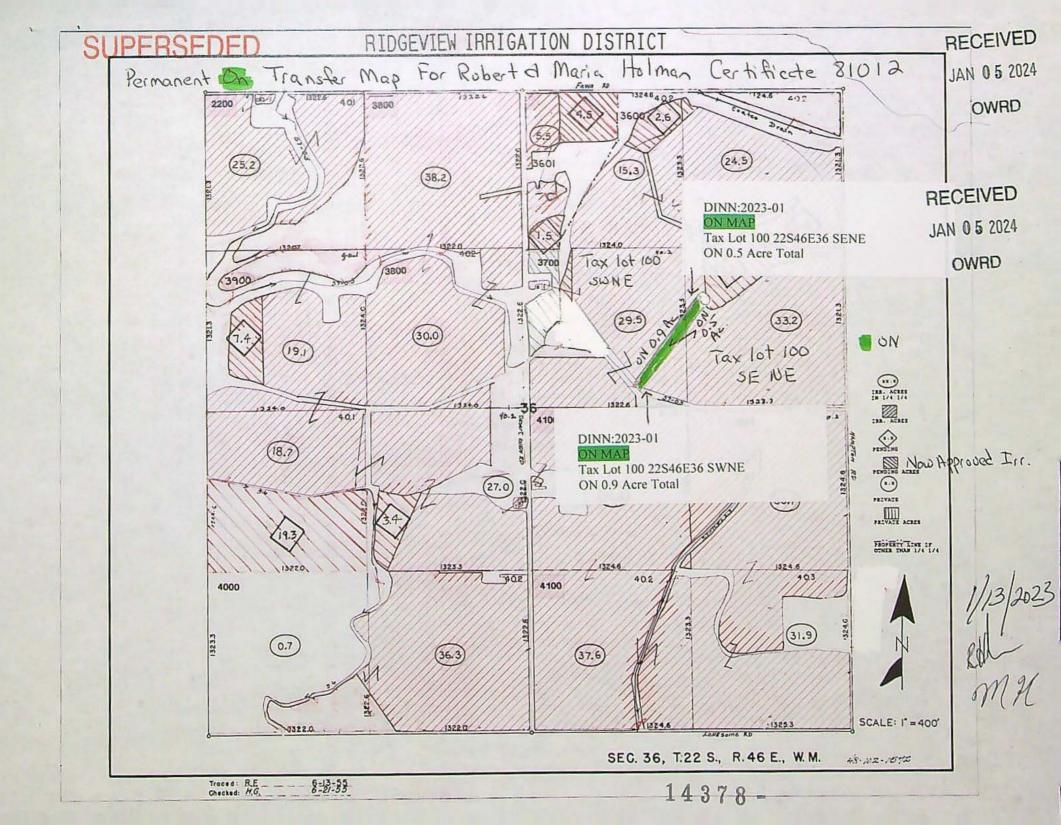

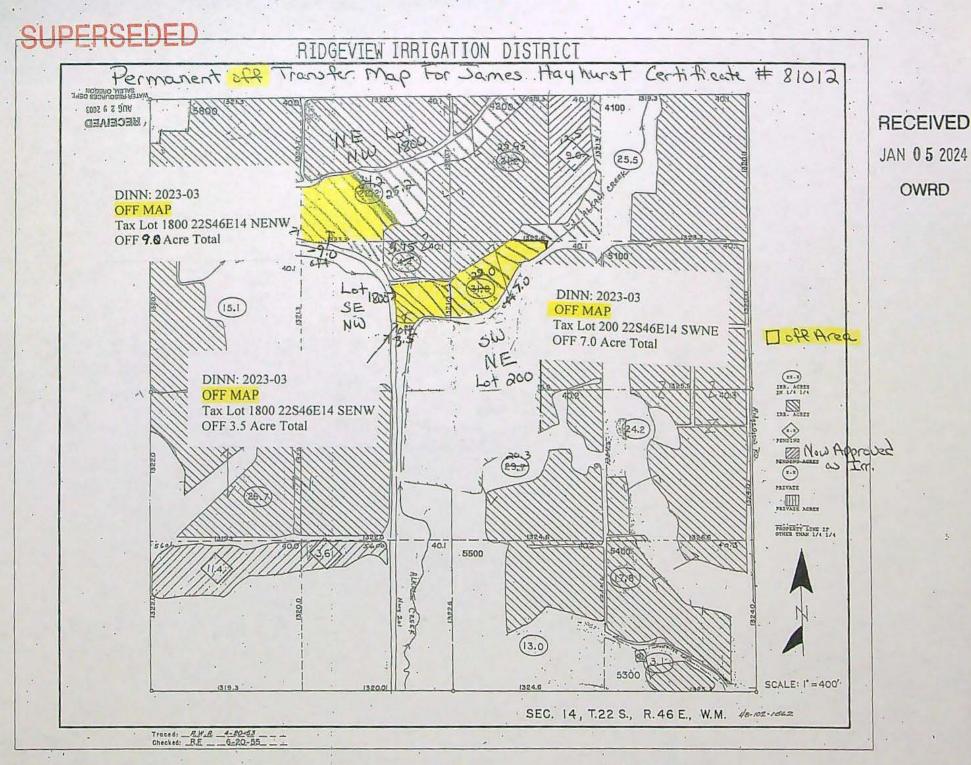

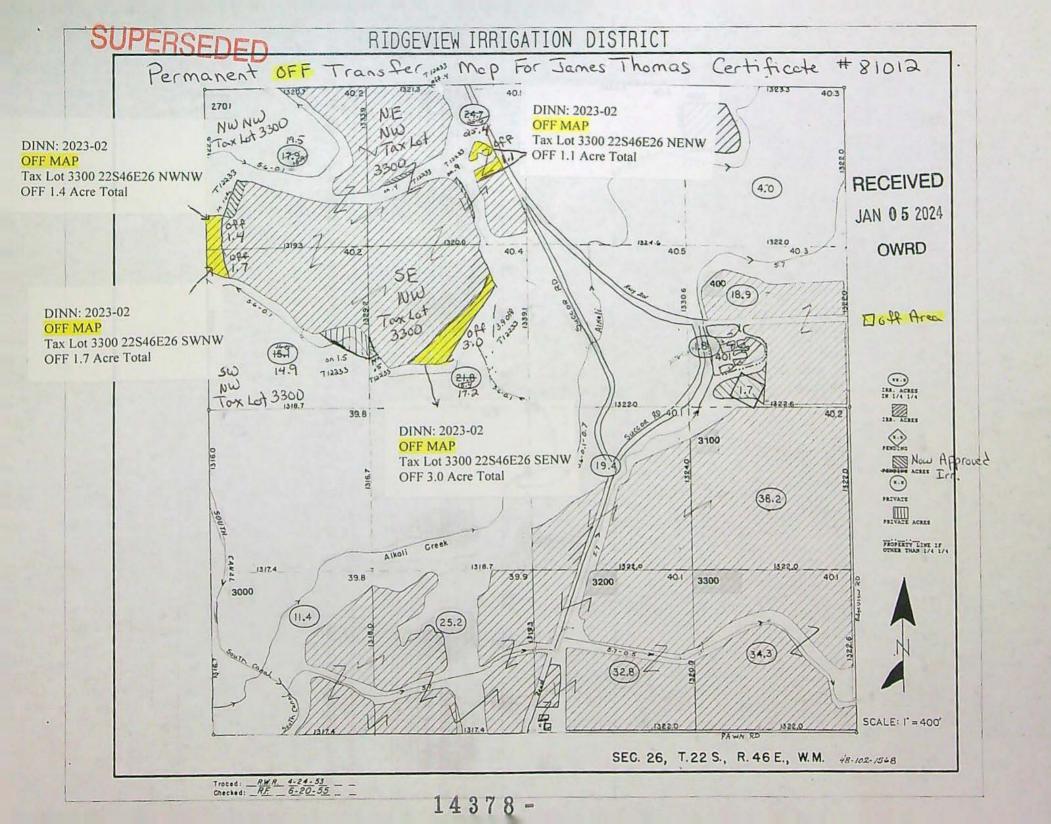

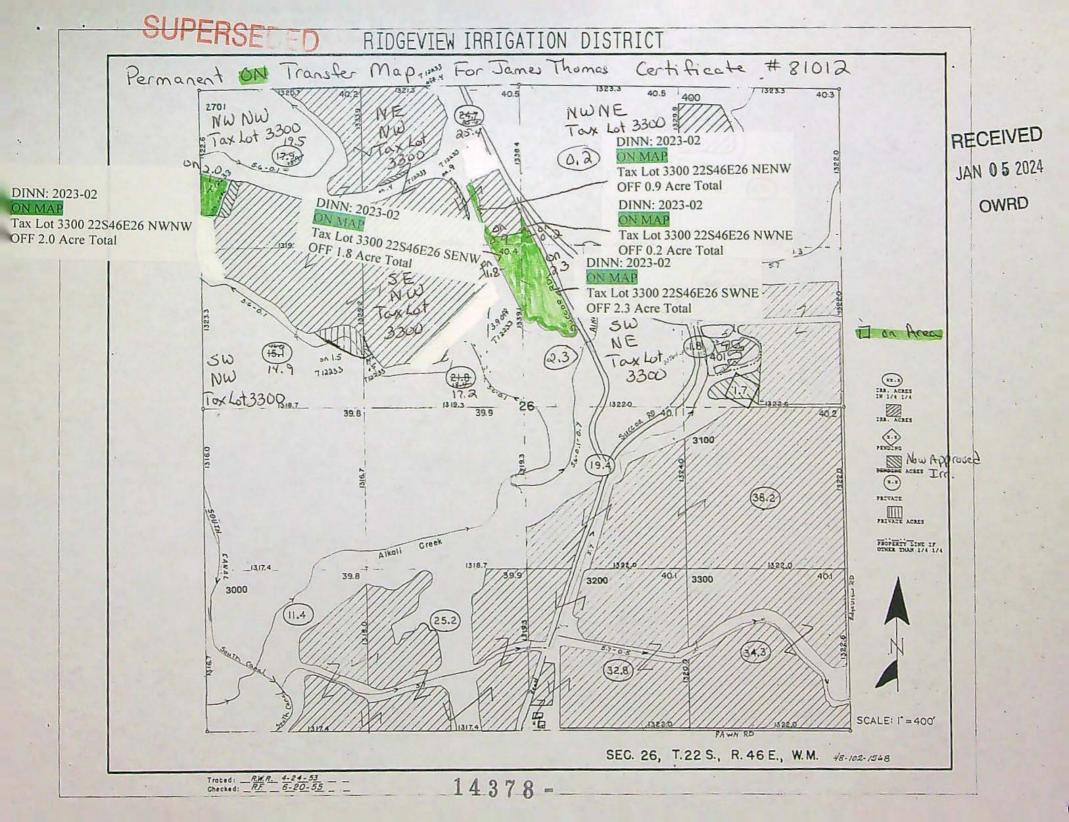

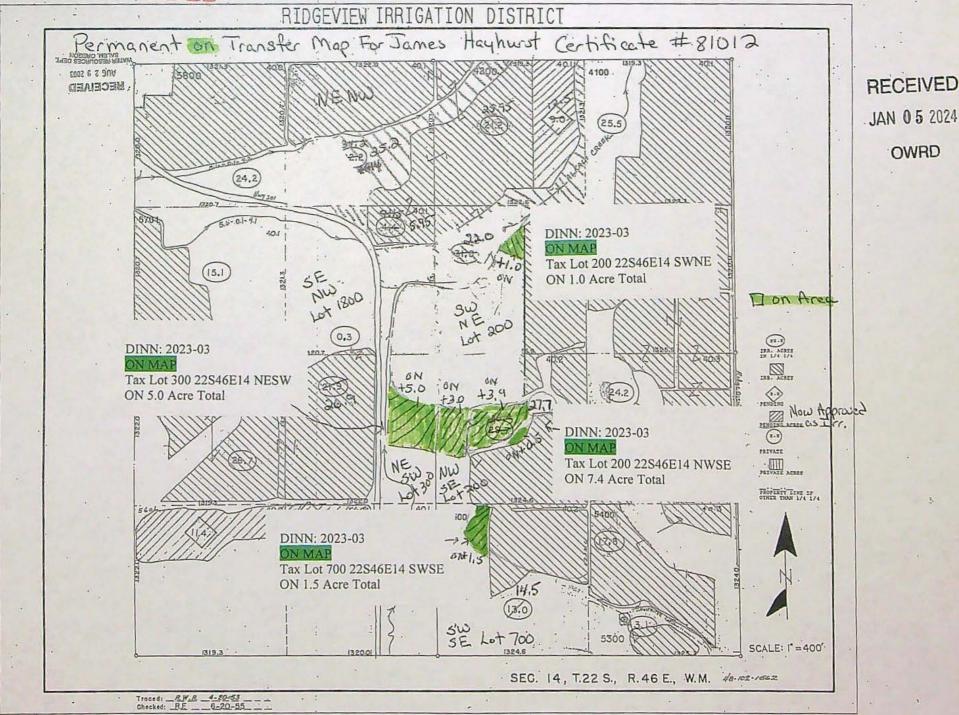

OWRD

Oregon Water Resources Department Transfer Fee Calculation for Permanent District Transfer

Main

@ Return

Help

	. Crimanent District Hansier	(1)	Return		Contact Us
Foday's Date: Wednesday, December 27, 2023			Fee C	alcula	tion

Base Fee (includes one type of change to one water right for up to 1 cfs) \$1,360.00 Enter total number of water rights included in transfer. 1 \$0.00 Check this box if you propose to change the place of use for a NON-irrigation use. Check this box if you propose to change the place of use for an irrigation use Enter the following for irrigation uses included in the transfer: (If a supplemental certificate also covers the same land as an included primary right, only list the primary.) Only list a supplemental right if ONLY the supplemental is moving (to a "like" primary.) Total acres Total cfs in the If certificate does # of acres to Certificate# in the water water right OR not list cfs, enter Transfer cfs be transferred right certificate 1/ cfs per acre 81012 6785 28.1 113 0.467988

Total Transfer CFS(rounded up to the next whole cfs):1.00

Subtotal: \$1,360.00

Transfer Fee: \$1,360.00

Clear Return to Edit

> RECEIVED JAN 0 5 2024