

DESCHUTES COUNTY SEC.01 T18S R12E

E-RECEIVED
AUG 11, 2025
OWRD

OWRD#: T-14057


SCALE - 1" = 400'

-  ON LANDS
-  EXISTING WATER RIGHTS
-  # ac. PARCELS W/ WATER RIGHTS



NE 1/4

"OFF/ON" MAP

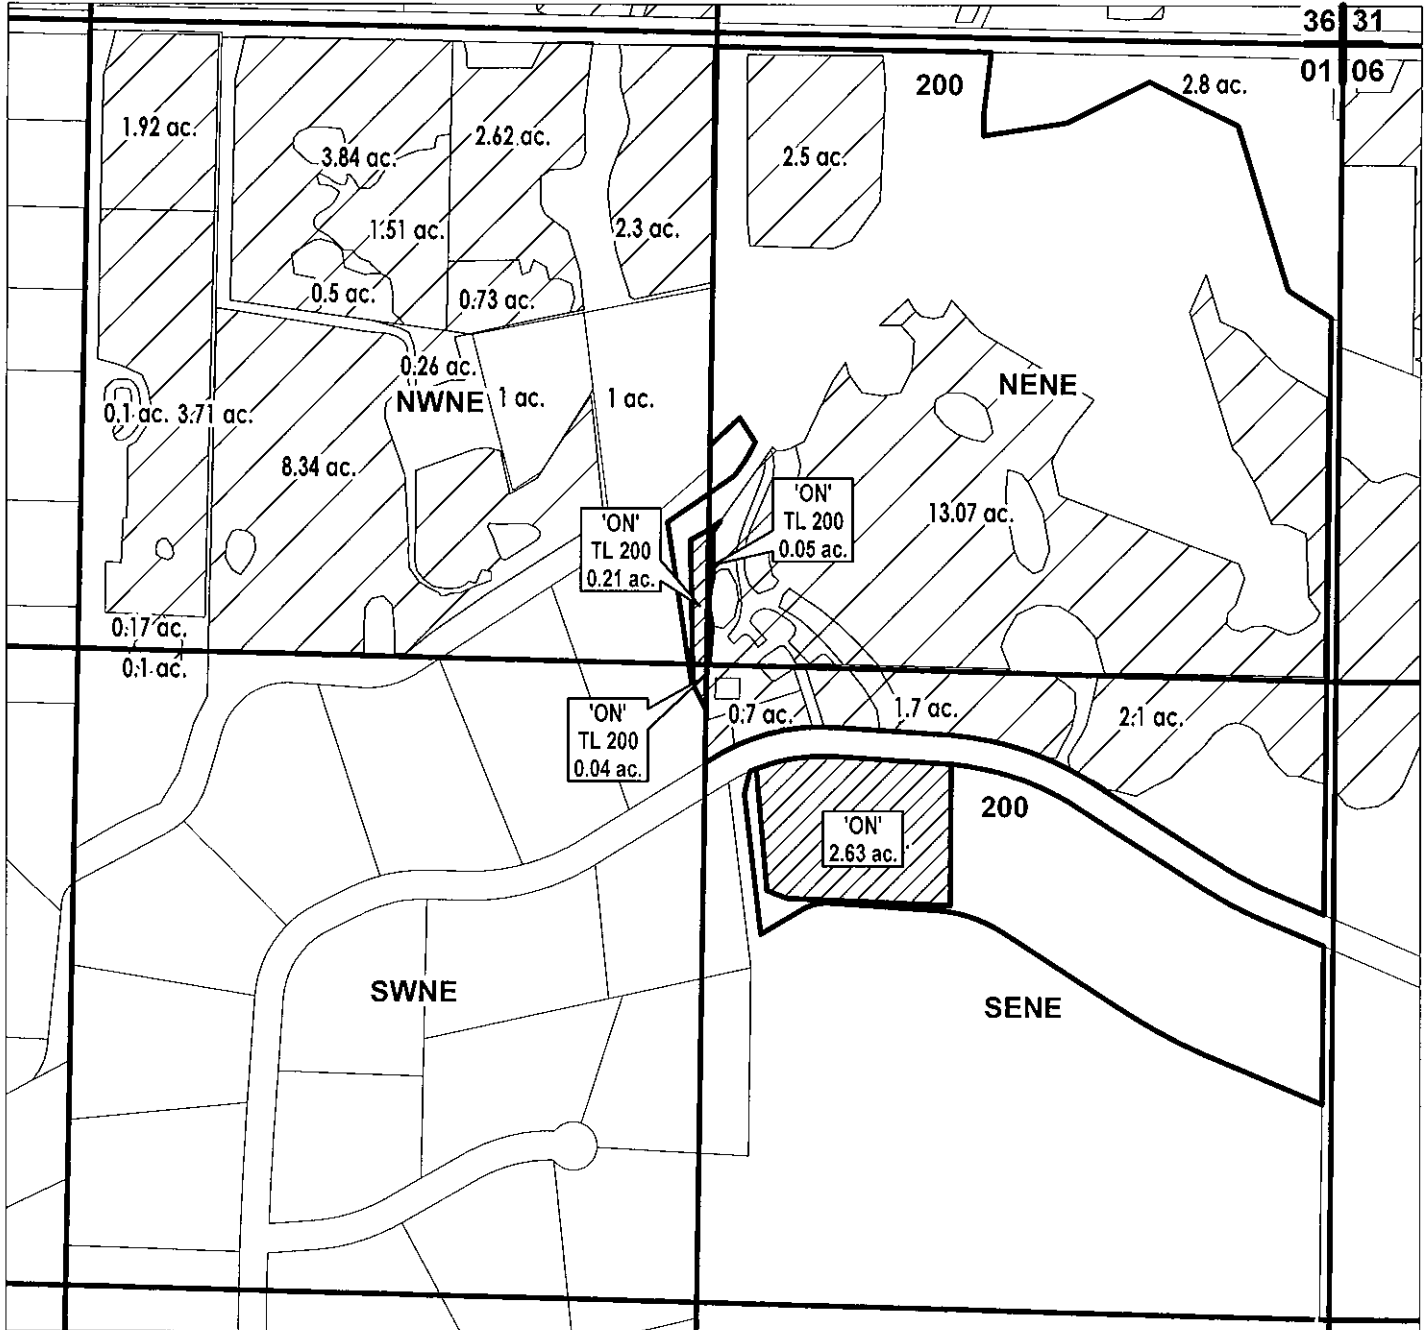

FINAL PROOF MAP

NAME: Grund, Gary/Suzanne

TAXLOT #: 200

2.93 ACRES

DATE: 8/11/2025