

JEFFERSON COUNTY SEC.33 T13S R13E



E-RECEIVED
AUG 11, 2025
OWRD

SCALE - 1" = 400'



SE 1/4 OF THE NW 1/4; SW 1/4 OF THE NE 1/4

OWRD #: T-14284

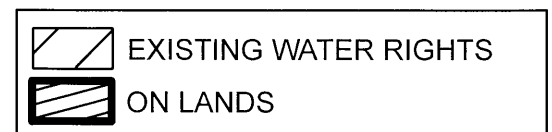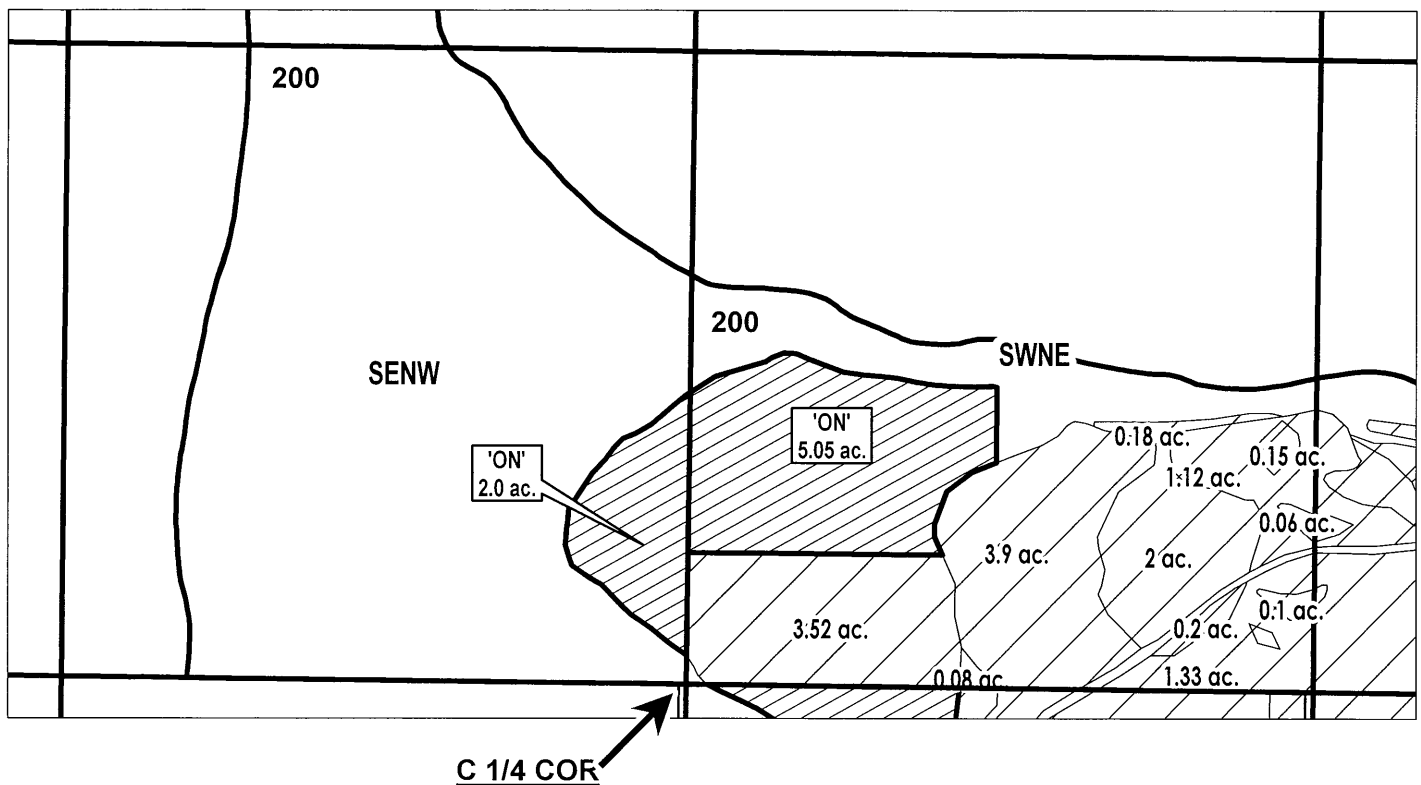

FINAL PROOF MAP

NAME: Coyote Land Holdings LLC

TAXLOT(S) #: 200

7.05 ACRES ON

DATE: 8/6/2025

JEFFERSON COUNTY SEC.33 T13S R13E

E-RECEIVED
AUG 11, 2025
OWRD



SCALE - 1" = 400'



NW 1/4 OF THE SE 1/4

OWRD #: T-14284

C 1/4 COR

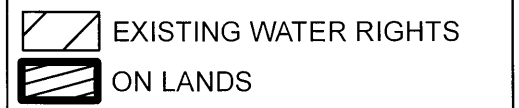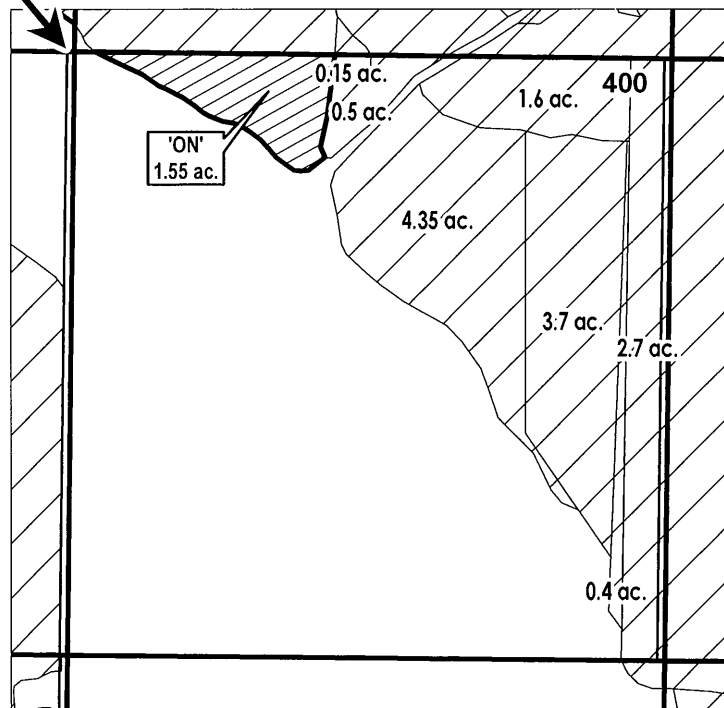

FINAL PROOF MAP

NAME: Coyote Land Holdings LLC

TAXLOT(S) #: 400

1.55 ACRES ON

DATE: 8/6/2025

JEFFERSON COUNTY SEC.34 T13S R13E


E-RECEIVED
AUG 11, 2025
OWRD

SCALE - 1" = 400'



NW 1/4 OF THE SW 1/4; NE 1/4 OF THE SW 1/4

OWRD #: T-14284

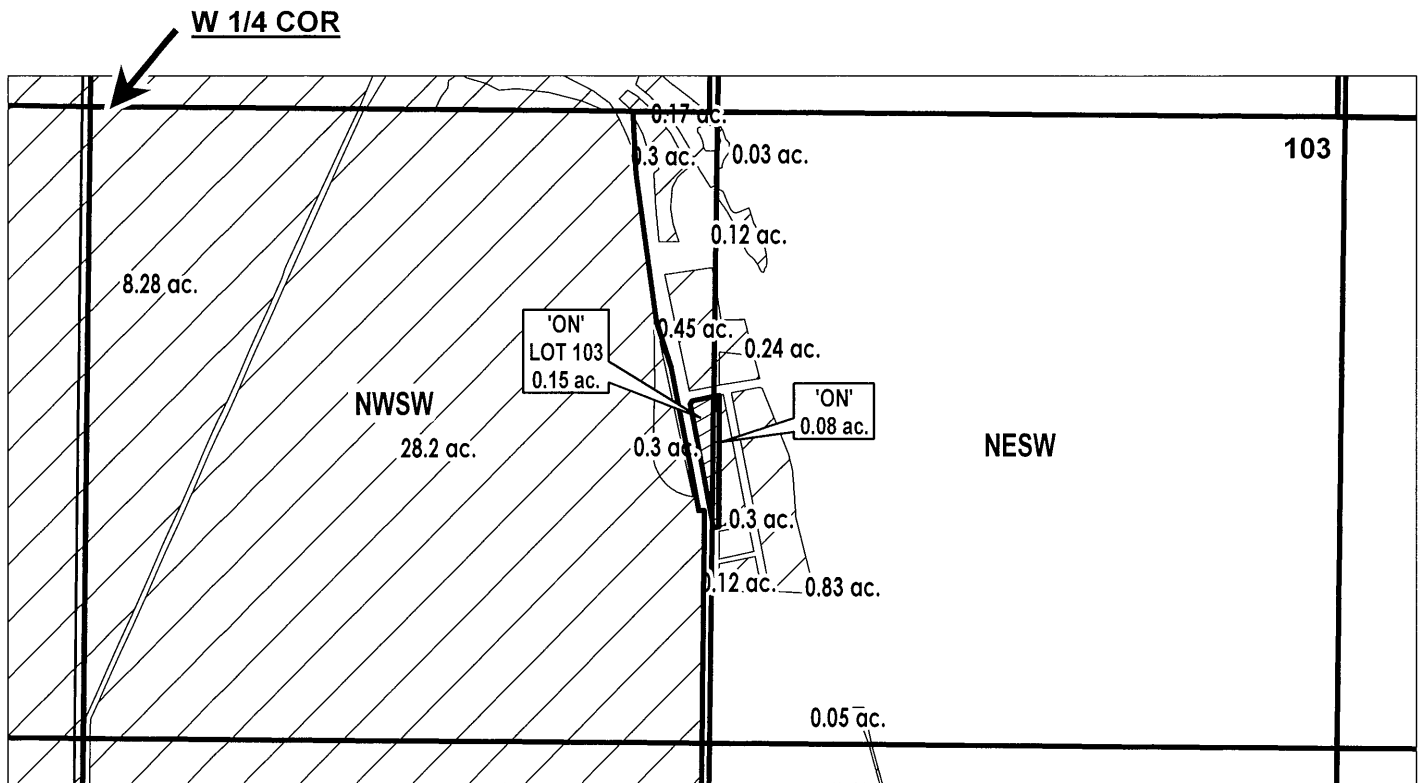

FINAL PROOF MAP

NAME: Coyote Land Holdings LLC

TAXLOT(S) #: 103

0.23 ACRES ON

DATE: 8/6/2025


DESCHUTES COUNTY SEC.22 T14S R13E

E-RECEIVED
AUG 11, 2025
OWRD

SCALE - 1" = 400'

SW 1/4 OF THE SE 1/4

OWRD #: T-14284

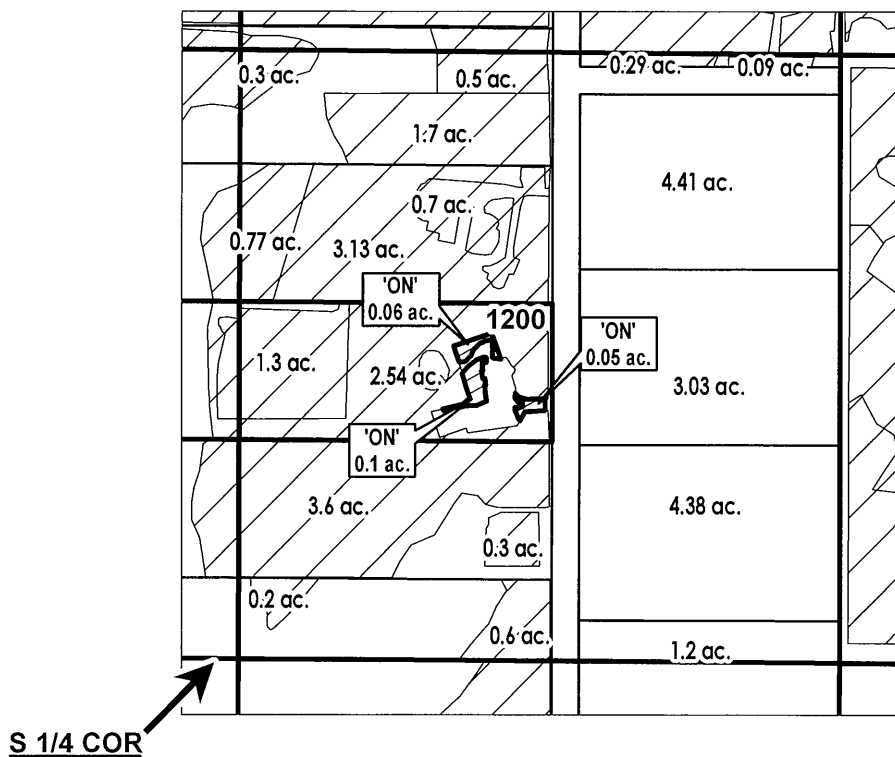

# ac.	PARCELS W/ WATER RIGHTS
	EXISTING WATER RIGHTS
	ON LANDS



FINAL PROOF MAP

NAME: Kluehe, Arman/Sandara

TAXLOT(S) #: 1200

0.21 ACRES ON

DATE: 8/11/2025

DESCHUTES COUNTY SEC.24 T14S R13E



E-RECEIVED
AUG 11, 2025
OWRD

SCALE - 1" = 400'



SW 1/4 OF THE SE 1/4; SE 1/4 OF THE SE 1/4

OWRD #: T-14284

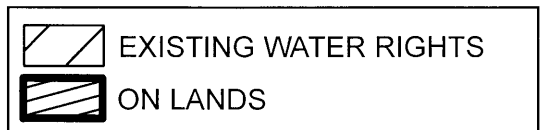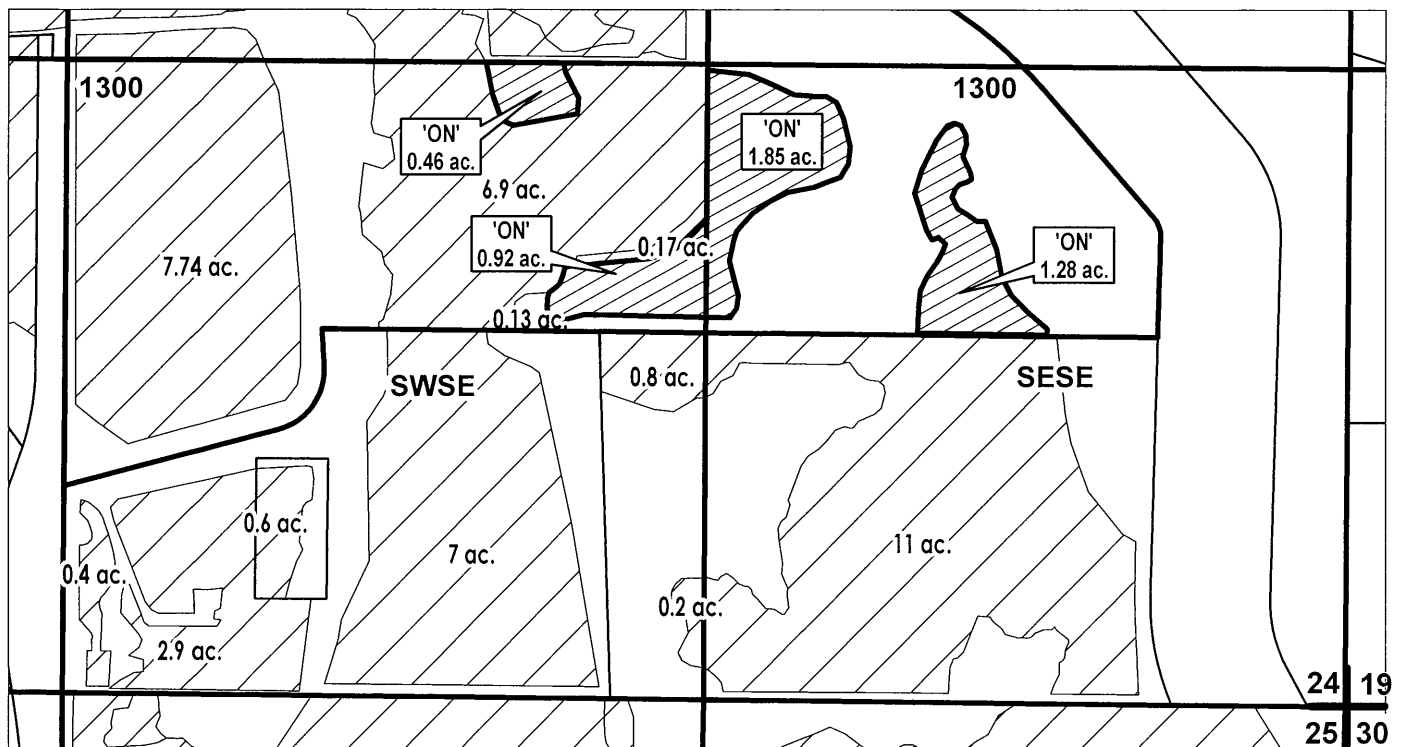

FINAL PROOF MAP

NAME: Lunsford, Randy/ Tonya

TAXLOT(S) #: 1300

4.51 ACRES ON

DATE: 8/11/2025

DESCHUTES COUNTY SEC.12 T15S R12E

E-RECEIVED
AUG 11, 2025
OWRD


SCALE - 1" = 400'



NW 1/4 OF THE SW 1/4; NE 1/4 OF THE SW 1/4

OWRD #: T-14284

W 1/4 COR

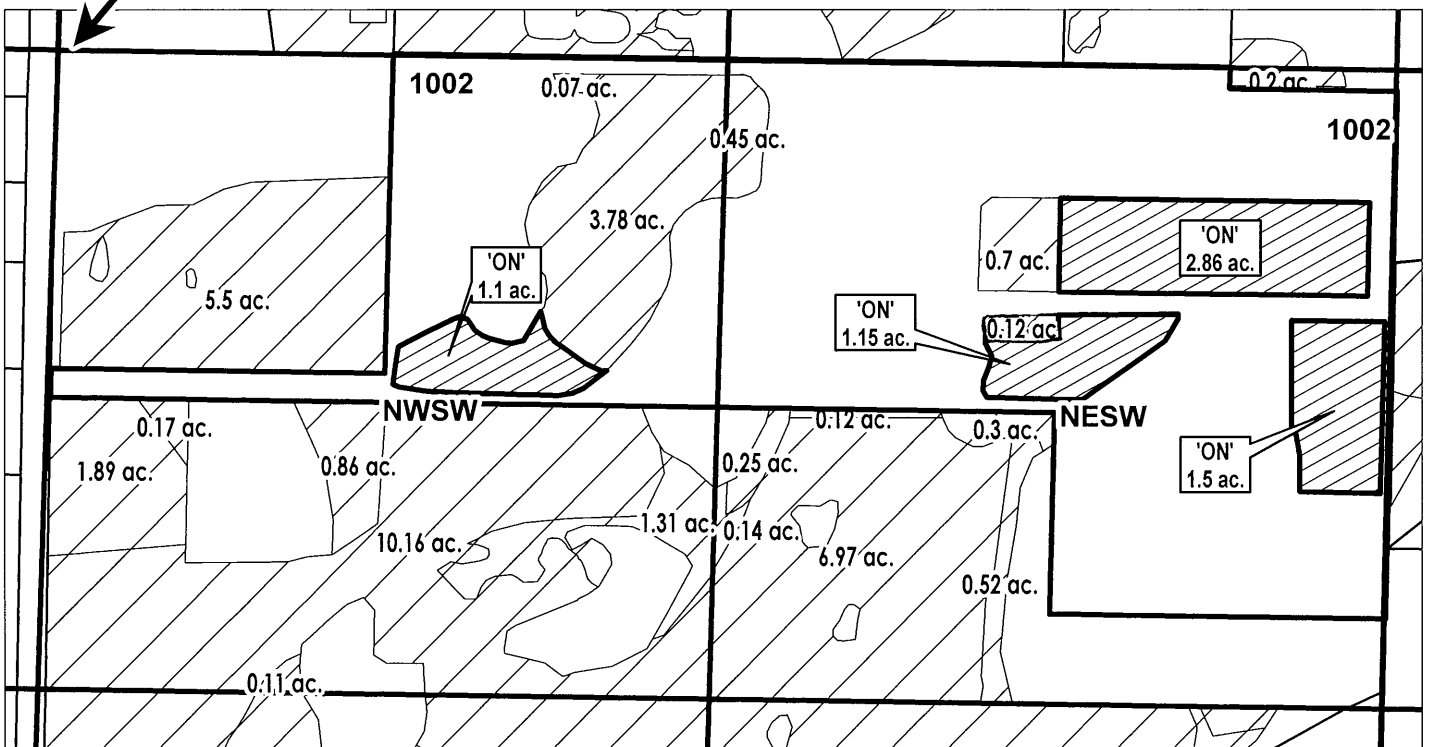

EXISTING WATER RIGHTS
ON LANDS



FINAL PROOF MAP

NAME: Lattavo Family LLC

TAXLOT(S) #: 1002

6.61 ACRES ON

DATE: 8/11/2025



DESCHUTES COUNTY SEC.25 T15S R12E

E-RECEIVED
AUG 11, 2025
OWRD

SCALE - 1" = 400'

N
NE 1/4 OF THE SW 1/4

OWRD #: T-14284

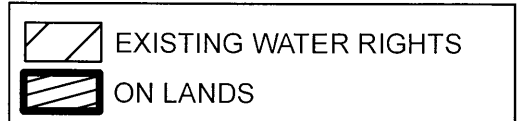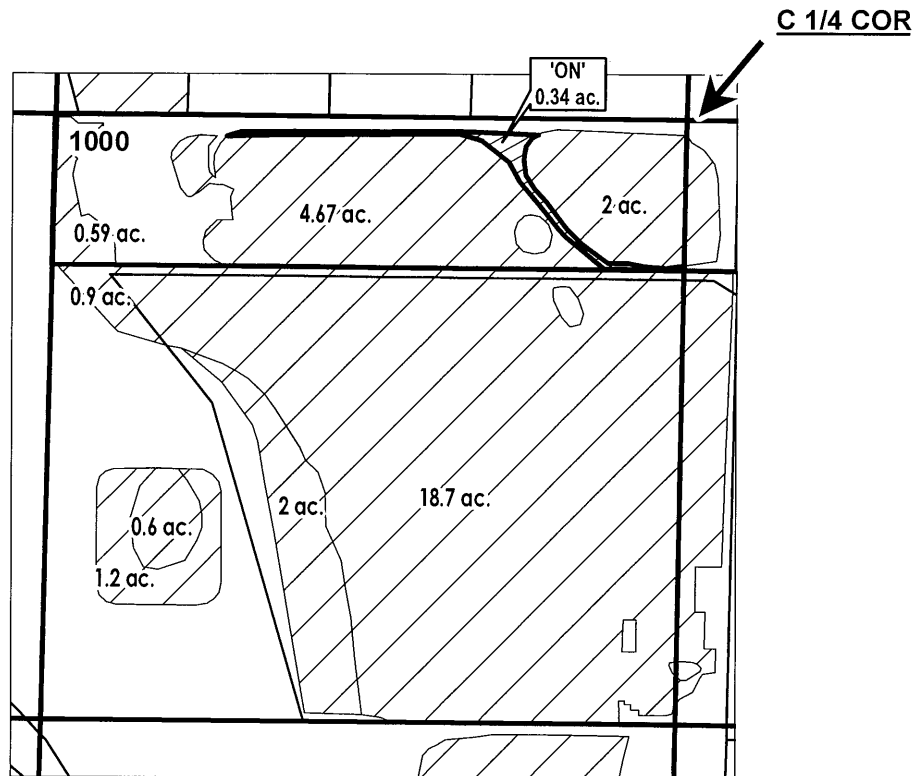

FINAL PROOF MAP

NAME: Brumbley, John T.

TAXLOT(S) #: 1000

0.34 ACRES ON

DATE: 8/11/2025

DESCHUTES COUNTY SEC.23 T17S R12E

E-RECEIVED
AUG 11, 2025
OWRD


SCALE - 1" = 400'



NW 1/4 OF THE SE 1/4

OWRD #: T-14284

C 1/4 COR

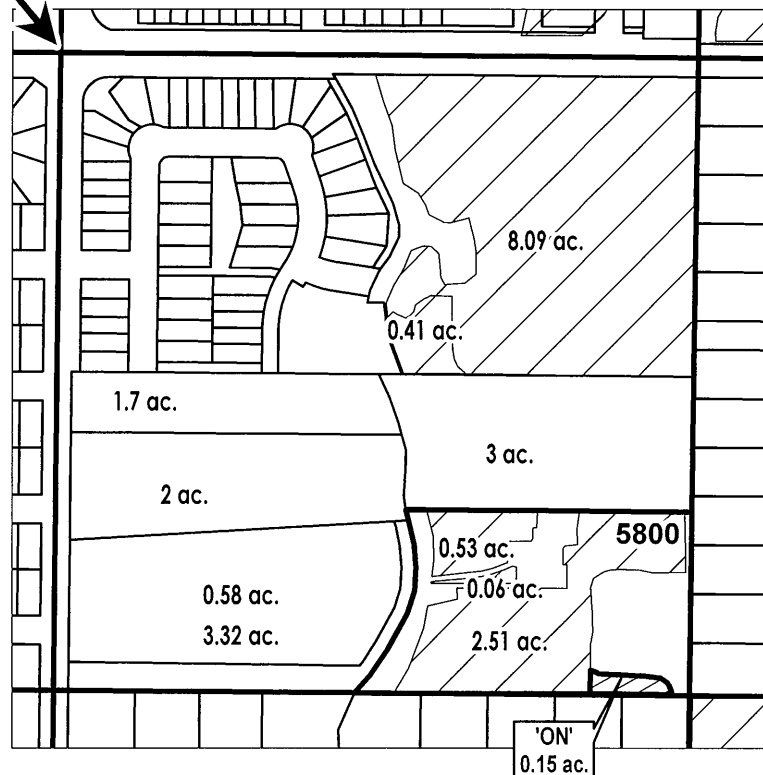

# ac.	PARCELS W/ WATER RIGHTS
	EXISTING WATER RIGHTS
	ON LANDS



FINAL PROOF MAP

NAME: Lepore, Brian/Emily

TAXLOT(S) #: 5800

0.15 ACRES ON

DATE: 8/11/2025


**DESCHUTES COUNTY
SEC.31 T17S R13E**

**E-RECEIVED
AUG 11, 2025
OWRD**

SCALE - 1" = 400'

N
SE 1/4 OF THE NE 1/4

OWRD #: T-14284

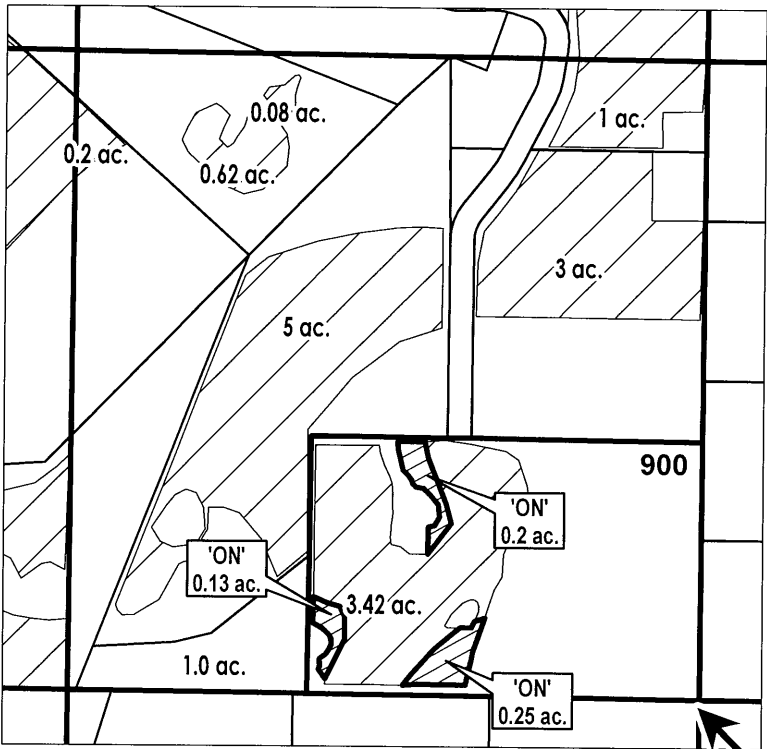

E 1/4 COR

# ac.	PARCELS W/ WATER RIGHTS
	EXISTING WATER RIGHTS
	ON LANDS



FINAL PROOF MAP

NAME: Coad, Robert/Coad Hensley, Valerie

TAXLOT(S) #: 900

0.58 ACRES ON

DATE: 8/11/2025

DESCHUTES COUNTY SEC.11 T17S R14E



E-RECEIVED
AUG 11, 2025
OWRD

SCALE - 1" = 400'



SW 1/4 OF THE SW 1/4

OWRD #: T-14284

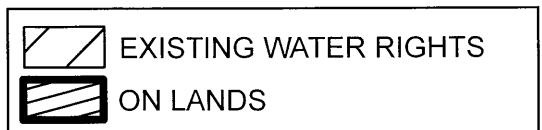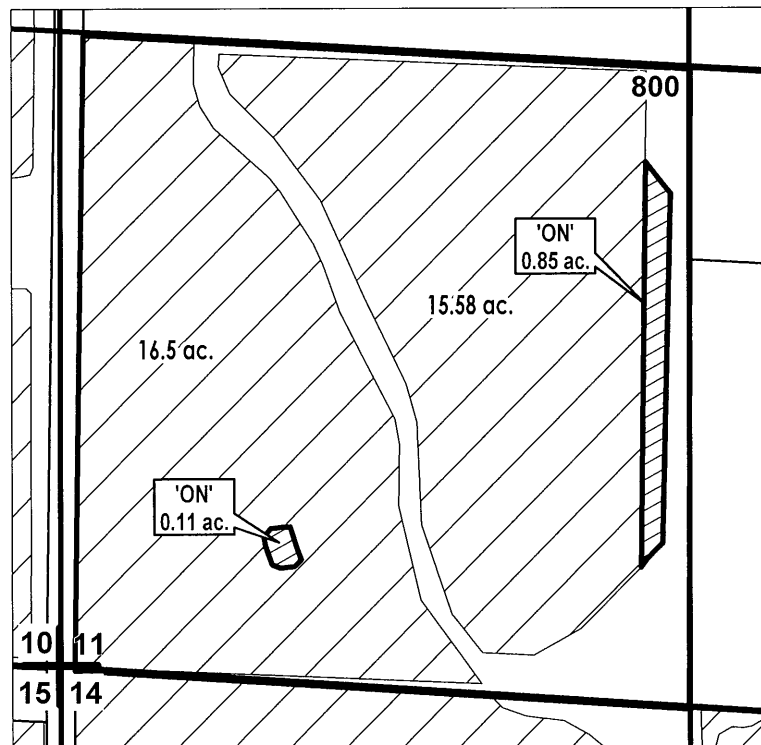

FINAL PROOF MAP

NAME: Miltenberger, Jeanne Trustee

TAXLOT(S) #: 800

0.96 ACRES ON

DATE: 8/6/2025

DESCHUTES COUNTY
SEC.03 T18S R13E


E-RECEIVED
AUG 11, 2025
OWRD

SCALE - 1" = 400'



SW 1/4 OF THE SE 1/4; SE 1/4 OF THE SE 1/4

OWRD #: T-14284

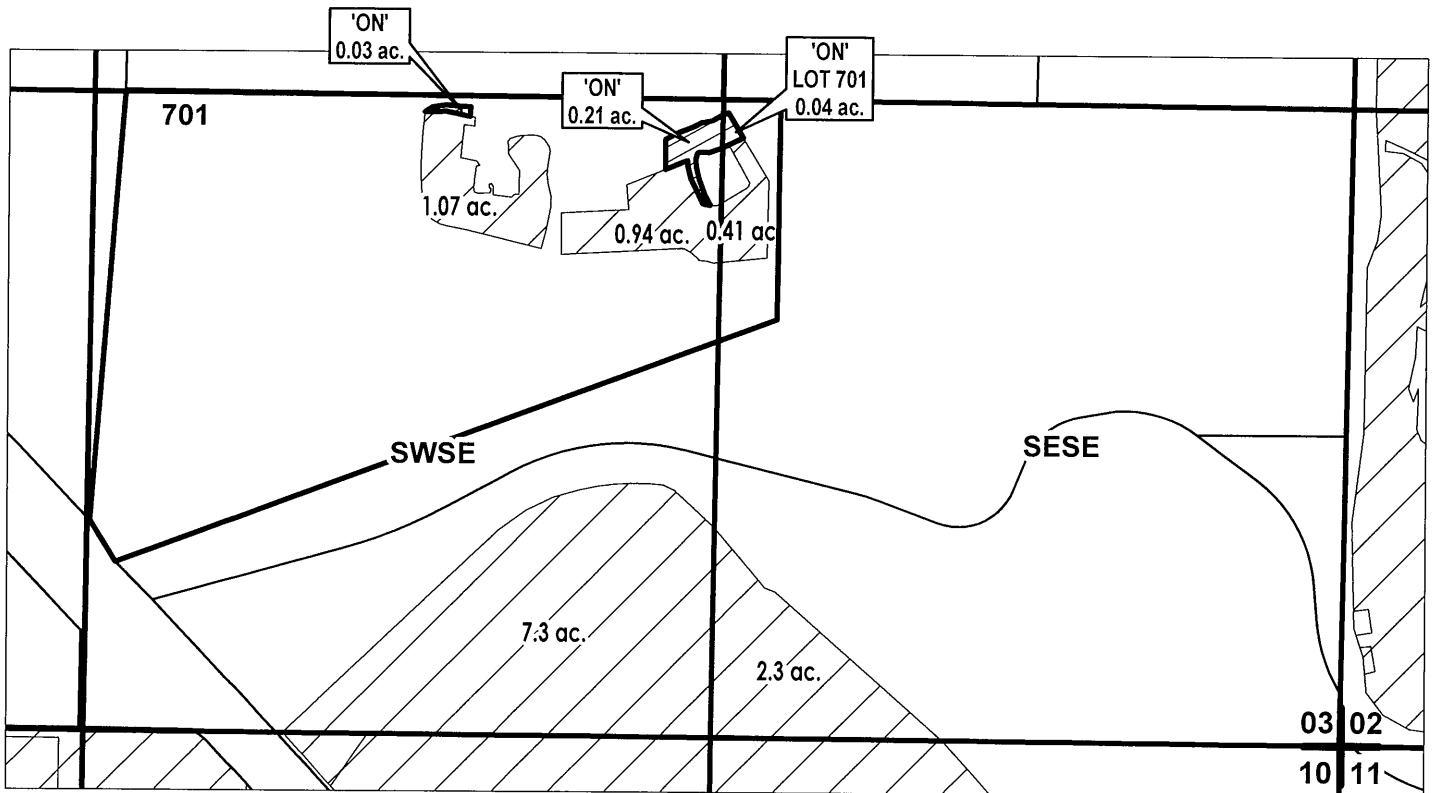

FINAL PROOF MAP

NAME: Holland, Kevin/Danielle

TAXLOT(S) #: 701

0.24 ACRES ON

DATE: 8/11/2025

**DESCHUTES COUNTY
SEC.11 T18S R13E**



**E-RECEIVED
AUG 11, 2025
OWRD**

SCALE - 1" = 400'



NE 1/4 OF THE SW 1/4

OWRD #: T-14284

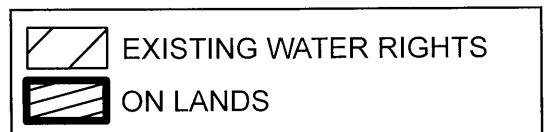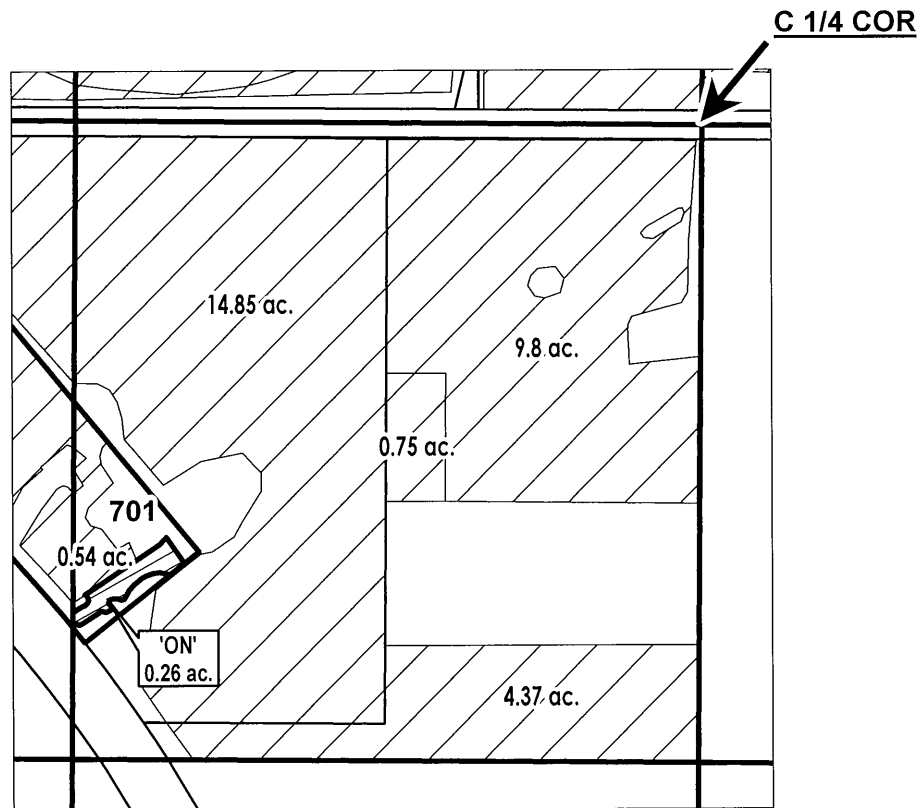

FINAL PROOF MAP

NAME: Peterson, Tim/Castagna, Cheryl

TAXLOT(S) #: 701

0.26 ACRES ON

DATE: 8/11/2025