

**CROOK COUNTY
SEC.03 T16S R14E**


E-RECEIVED
AUG 20, 2025
OWRD

SCALE - 1" = 400'



SW 1/4 OF THE NW 1/4

OWRD#: T-14489

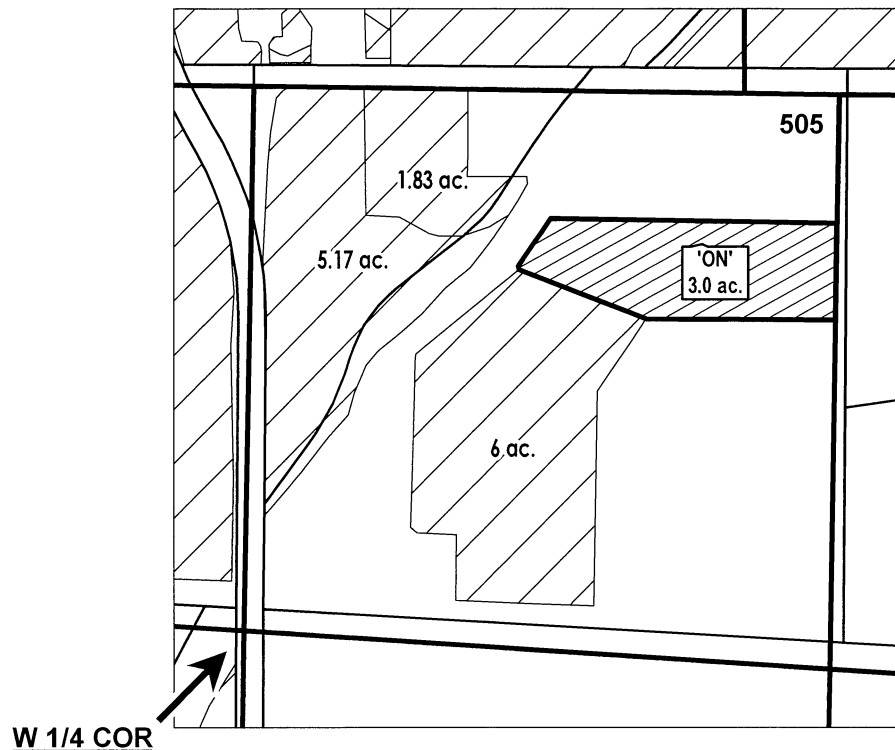

 ON LANDS
 EXISTING WATER RIGHTS



FINAL PROOF MAP

NAME: Hinton, Brian/Katie

TAXLOT #: 505

3.0 ACRES

DATE: 8/20/2025

**CROOK COUNTY
SEC.03 T16S R14E**


SCALE - 1" = 400'



SW 1/4 OF THE NW 1/4

E-RECEIVED
AUG 20, 2025
OWRD

OWRD#: T-14489

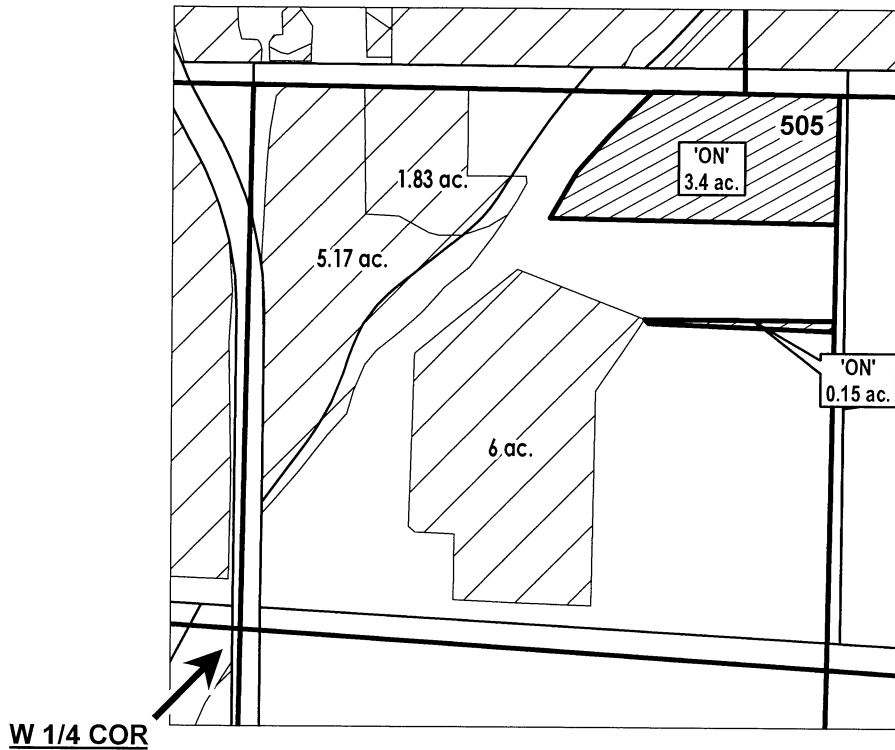

 ON LANDS
 EXISTING WATER RIGHTS



FINAL PROOF MAP

NAME: Hinton, Brian/Katie

TAXLOT #: 505

3.55 ACRES

DATE: 8/20/2025

DESCHUTES COUNTY
SEC.14 T17S R12E


E-RECEIVED
AUG 20, 2025
OWRD

SCALE - 1" = 400'



SE 1/4 OF THE NW 1/4

OWRD#: T-14489

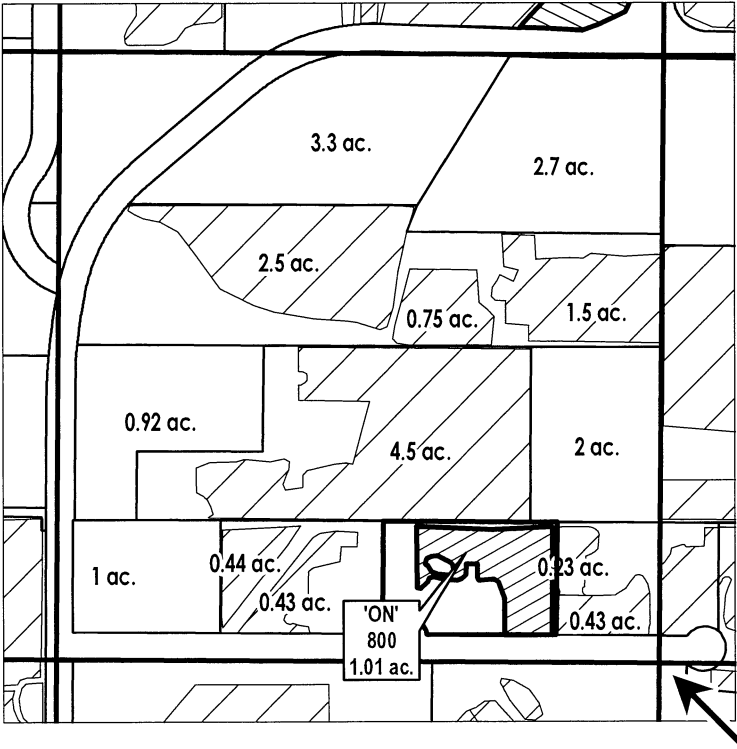

C 1/4 COR

-  ON LANDS
-  EXISTING WATER RIGHTS
-  PARCELS W/ WATER RIGHTS



FINAL PROOF MAP

NAME: Cowan, Cliff

TAXLOT #: 800

1.01 ACRES

DATE: 8/20/2025

**DESCHUTES COUNTY
SEC.22 T17S R13E**

E-RECEIVED
AUG 20, 2025
OWRD


SCALE - 1" = 400'



NW 1/4 OF THE NE 1/4

OWRD#: T-14489

N 1/4 COR

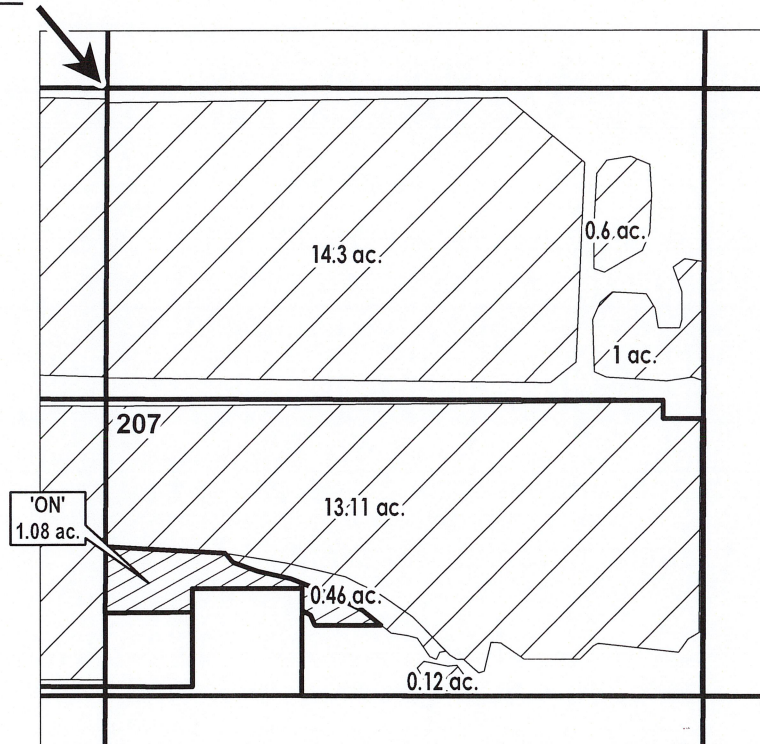

 **ON LANDS**
 **EXISTING WATER RIGHTS**



FINAL PROOF MAP

NAME: Van Kessel. Peter/Marianne

TAXLOT #: 207

1.08 ACRES

DATE: 8/20/2025

DESCHUTES COUNTY SEC.32 T17S R13E


E-RECEIVED
AUG 20, 2025
OWRD

SCALE - 1" = 400'



SE 1/4 OF THE NW 1/4

OWRD#: T-14489

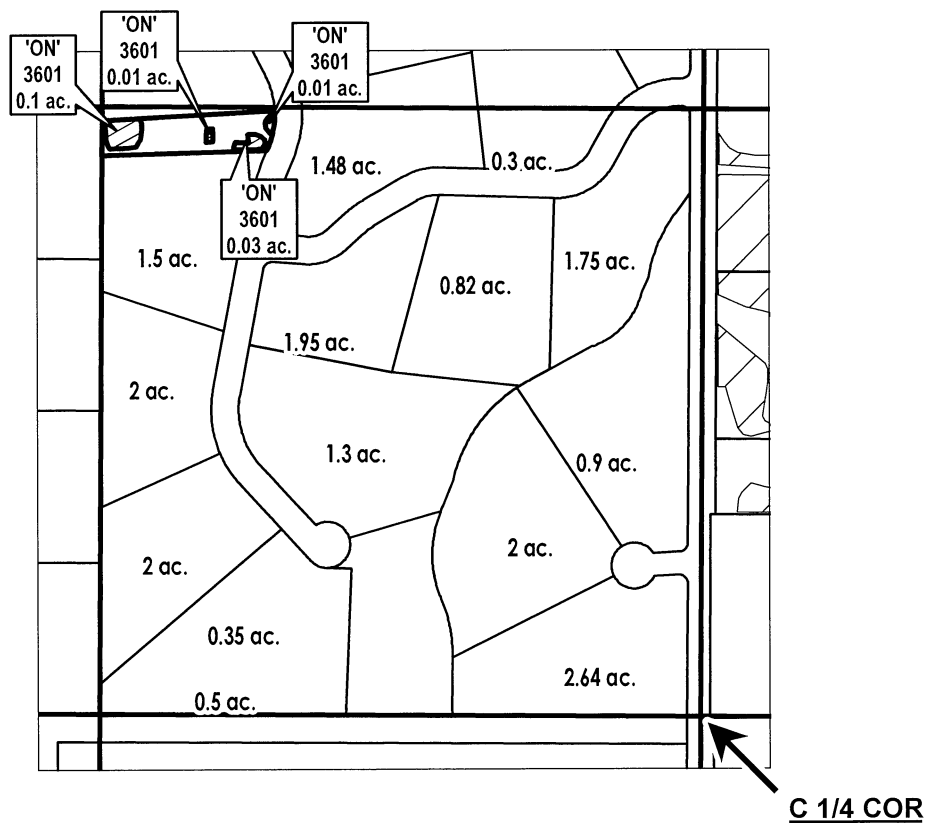

 ON LANDS
 # ac. PARCELS W/ WATER RIGHTS



FINAL PROOF MAP

NAME: Gonzalez, Miguel/Heather

TAXLOT #: 3601

0.15 ACRES

DATE: 8/20/2025

**DESCHUTES COUNTY
SEC.03 T18S R13E**


E-RECEIVED
AUG 20, 2025
OWRD

SCALE - 1" = 400'



NE 1/4 OF THE NE 1/4

OWRD#: T-14489

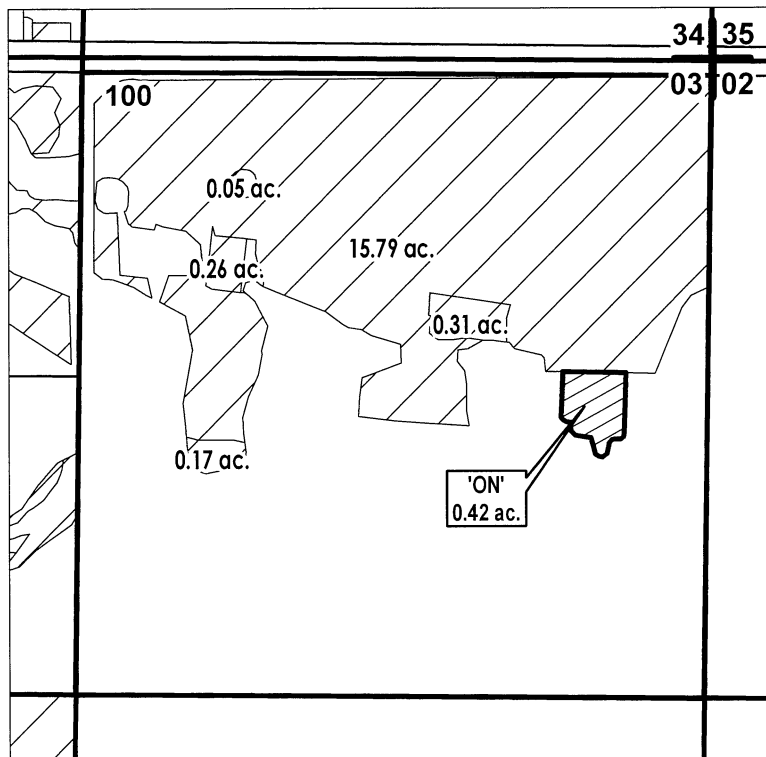

 ON LANDS
 EXISTING WATER RIGHTS



FINAL PROOF MAP

NAME: Appleby Ghost Rock Revocable

Trust TAXLOT #: 100

0.42

ACRES

DATE: 8/20/2025

**DESCHUTES COUNTY
SEC.04 T18S R13E**



E-RECEIVED
AUG 20, 2025
OWRD

SCALE - 1" = 400'



NE 1/4 OF THE NE 1/4

OWRD#: T-14489

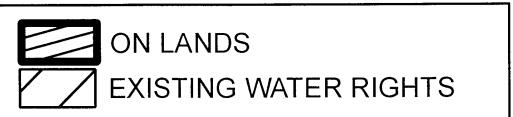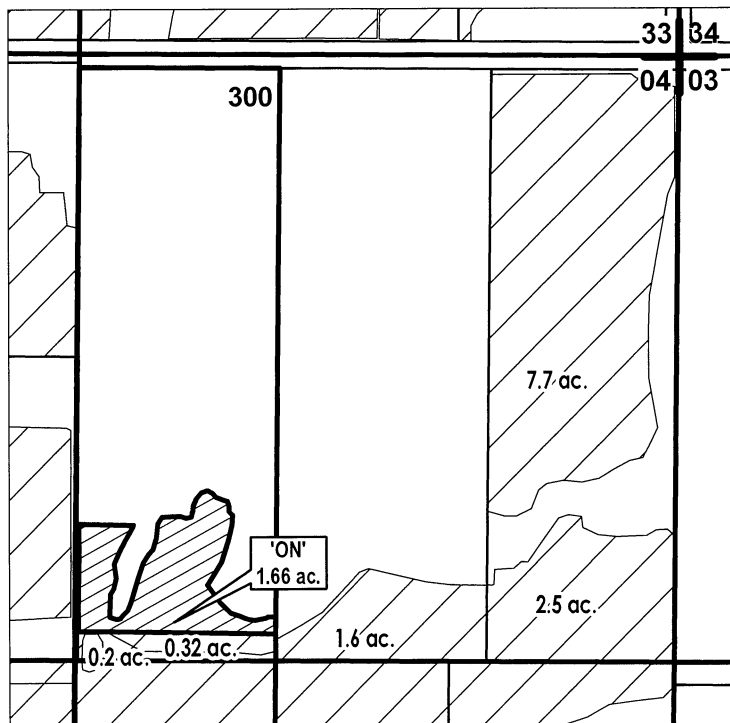

FINAL PROOF MAP

NAME: Obradovich, Nicholas/Milgiorini, Robyn

TAXLOT #: 300

1.66 ACRES

DATE: 8/20/2025