


EAGLE POINT IRRIGATION DISTRICT
CLAIM OF BENEFICIAL USE T - 14572 - MAP 1 of 3
TOWNSHIP 35S, RANGE 1W, W.M.
JACKSON COUNTY, OREGON

District Internal Notice
T-2024-002 Certificate 89373


Assessor Maps
T-35S-1W-2,3,10,11

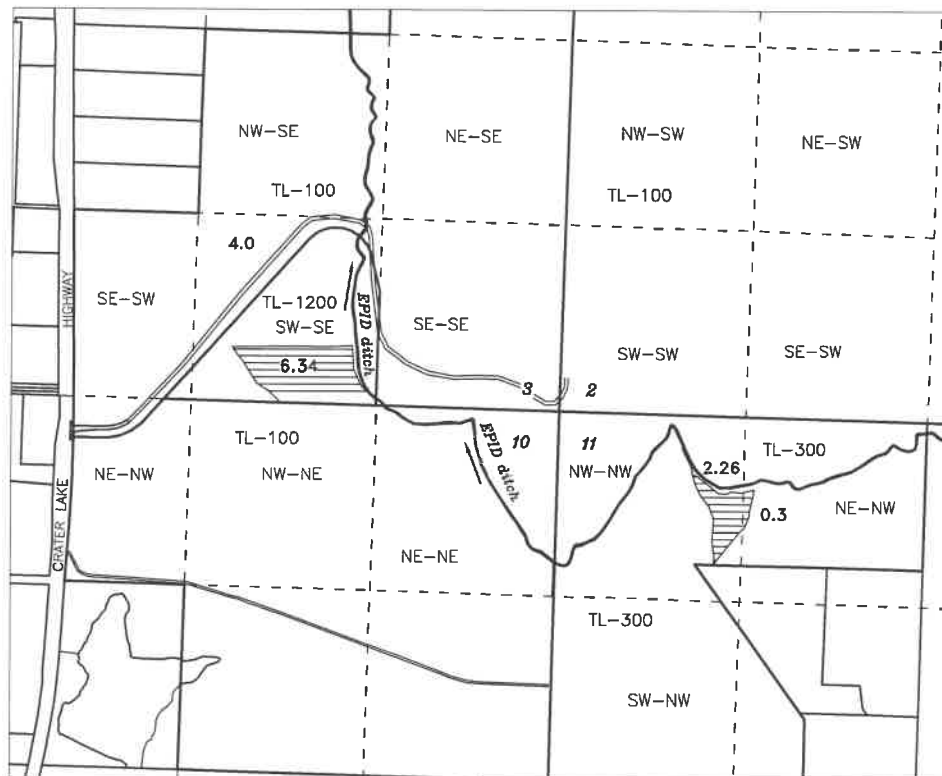

Legend

Points of Diversion per C-89373

TOWNSHIP 35S RANGE 2E., W.M.

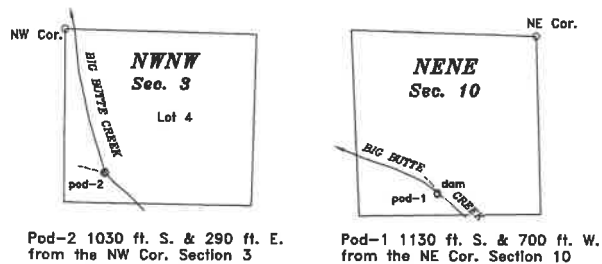

Scale 1 inch = 1320 feet



8.90 Acres
Irrigation

EAGLE POINT IRRIGATION DISTRICT
2329 BROPHY ROAD - P.O. BOX 157
EAGLE POINT, OR 97524
PHONE 541-826-3411 - FAX 541-826-8738

Water User:

Carson Collier
Kailey Villa
16650 Highway 62
Eagle Point, OR 97524



Scale
1" = 1320'


This map is not intended to provide legal dimensions
or locations of property ownership lines

7/2/2025 N.E.D.

EAGLE POINT IRRIGATION DISTRICT
CLAIM OF BENEFICIAL USE TRANSFER T-14572
MAP 2 of 3

District Internal Notice
T-2024-3 Certificate
89373

LEGEND

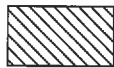

6.46 Acres Irrigation

Water User:

Rodney and Deborah Brudevold
2545 Stevens Road
Eagle Point, OR 97524

EAGLE POINT IRRIGATION DISTRICT
2329 BROPHY ROAD - P.O. BOX 157
EAGLE POINT, OR 97524
PHONE 541-826-3411 - FAX 541-826-8738

This map is not intended to provide legal dimensions
or locations of property ownership lines




Scale
1 inch = 800 feet

7/2/2025 N.E.D.

TOWNSHIP 36 SOUTH,
RANGE 1 WEST W.M.

TOWNSHIP 36 SOUTH,
RANGE 1 EAST, W.M.

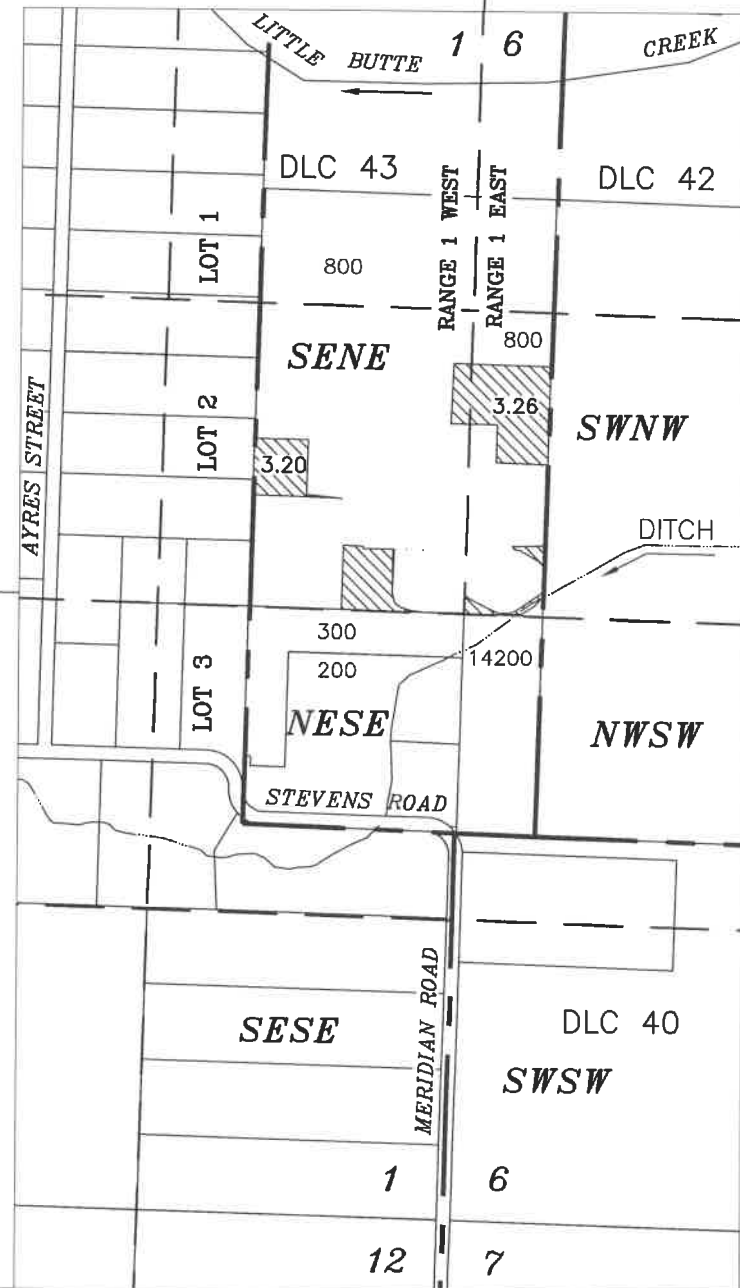

This map is not intended to provide legal dimensions or locations of property ownership lines