

4293

DESCRIPTION OF WATER RIGHT

Name Henry Blair & Bessie Blair  
By \_\_\_\_\_  
Address Andrews Star Route Box 5  
Burns, Oregon 97720

Change in POD & POV  
Date filed Sept 11, 1979  
Date of hearing Nov. 28, 1979  
Place of hearing Burns  
Date of order 12-20-79 Vol. 32, page 591  
Date for application of water 10-1-81  
Proof mailed \_\_\_\_\_  
Proof received \_\_\_\_\_  
Certificate issued **MAR 23 1989** Vol. 51, page 60567

Name of stream Wildhorse Creek  
Trib. of \_\_\_\_\_ County of Harney  
Use irrigation  
Quantity of water \_\_\_\_\_ No. of acres 38<sup>3</sup>  
Name of ditch \_\_\_\_\_  
Date of priority 1902  
In name of Robert E. Blair  
Wildhorse Creek Adjudication, Vol. 15, page 368  
App. No. \_\_\_\_\_ Per. No. \_\_\_\_\_ Cert. No. 20915  
Certificate cancelled \_\_\_\_\_  
Notation made on record by \_\_\_\_\_

FEES PAID

| Date        | Amount           | Receipt No. |
|-------------|------------------|-------------|
| 9-11-79     | 20-              | 14056       |
| 9-24-79     | 27 <sup>25</sup> | 14206       |
| TOTAL . . . |                  |             |
|             | Cert. Fee        |             |

FEES REFUNDED

| Date | Amount | Check No. |
|------|--------|-----------|
|      |        |           |

EX 20-  
POV 12<sup>25</sup>  
POD 15-  
47<sup>25</sup>

REMARKS

See T-3985 (C-20913)  
**Dard for C NOV 20 1981**

W.R.I.S.


Assembled 3-22-85 by SRB

Entered \_\_\_\_\_ by \_\_\_\_\_

Verified \_\_\_\_\_ by \_\_\_\_\_

|                     | INDEX CARDS: |         |
|---------------------|--------------|---------|
|                     | Entered      | Checked |
| ✓ Name              | <u>lg</u>    | _____   |
| ✓ Stream            | <u>lg</u>    | _____   |
| ✓ Pt. of Div.       | _____        | _____   |
| ✓ Calendar          | <u>lg</u>    | _____   |
| CHECKED TO RECORDS: |              |         |
| ✓ Twp. & Rge.       | <u>SRB</u>   | _____   |
| ✓ Decree-vault      | <u>SRA</u>   | _____   |
| ✓ Decree-safe       | <u>SRB</u>   | _____   |
| ✓ Cert. of W/R      | <u>SRA</u>   | _____   |
| Per. Folder         | _____        | _____   |
| Chainindex          | _____        | _____   |
| Cross Ref.          | _____        | _____   |
| ✓ Power Claim       | _____        | _____   |
| ✓ Abstracts         | <u>lg</u>    | _____   |

T. 35S., R. 33E., W. M.

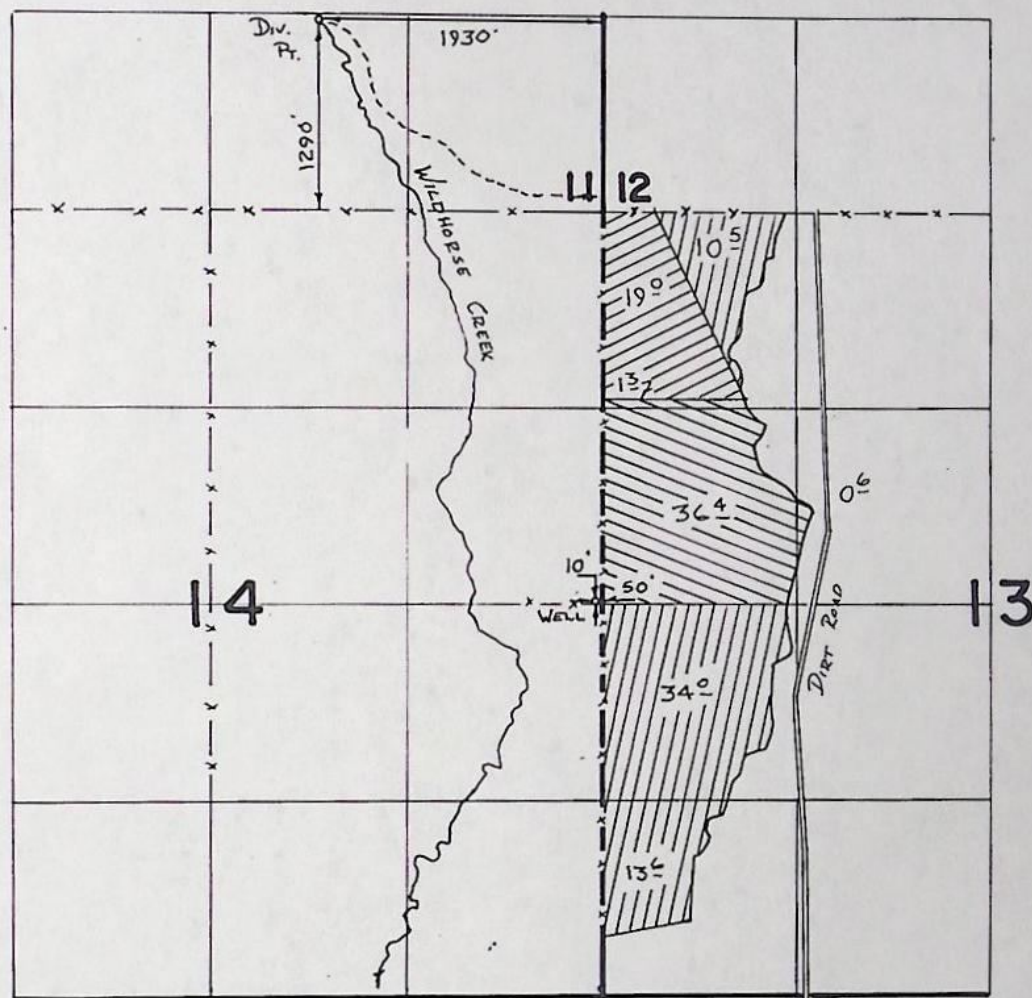

Scale 1" = 1320'



T-3985



T-4293



PER. 43216 ÷ 44048

# FINAL PROOF SURVEY

## UNDER

**TRANSFERS 3985,4293**


Application No. **57573** Permit No. **43216**.....

IN NAME OF

HENRY & BESSIE.....BLAIR..

Surveyed 7-18 1988, by V.L. Church

T. 35S., R. 33E., W.M.

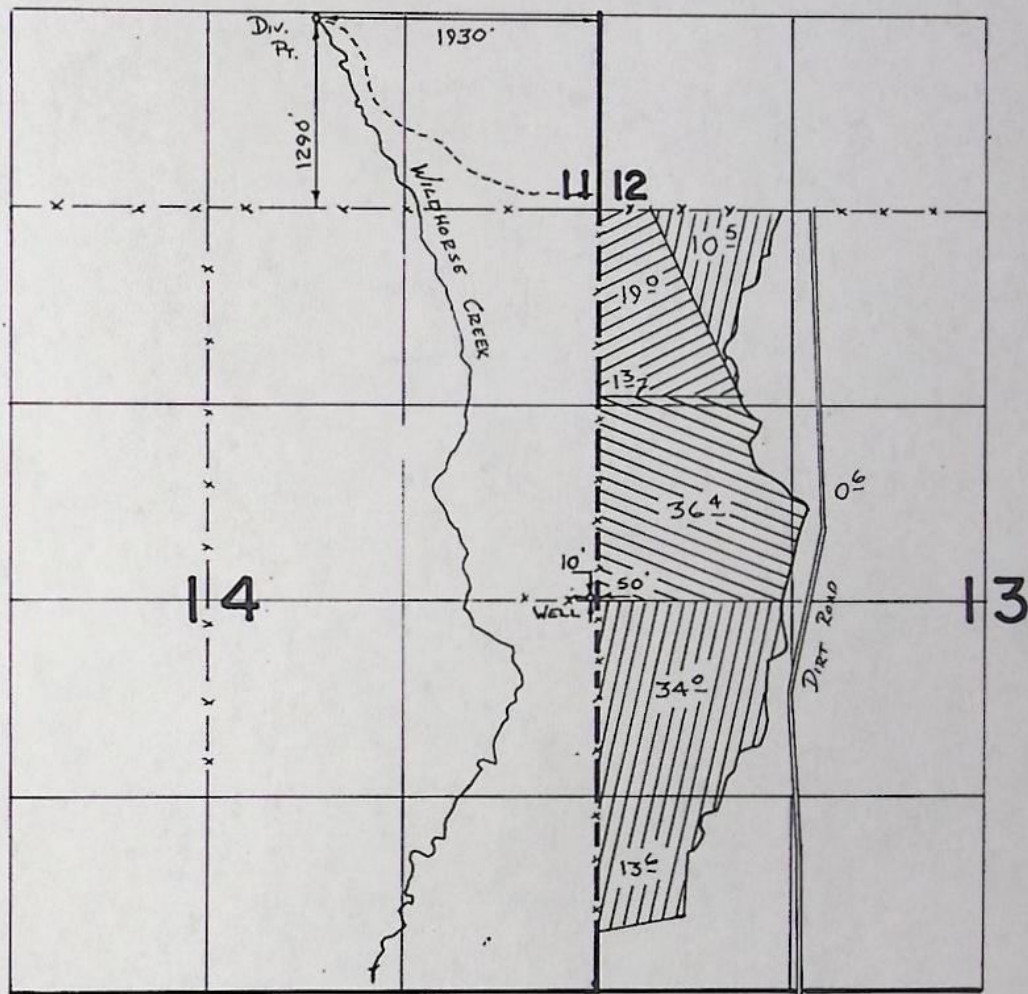

Scale 1"=1320'



T-3985



T-4293



PER. 43216 & 44048

**FINAL PROOF SURVEY**  
UNDER

**TRANSFERS 3985, 4293**

Application No. **57573** Permit No. **43216**

IN NAME OF

**HENRY & BESSIE BLAIR**


Surveyed 7-18-1988, by V.L. Church

T-9293

RECEIVED  
JUL 13 1978  
WATER RESOURCES DEPT.  
SALEM, OREGON

# SECTION PLAT

Section 13-24-26 Township 35 SOUTH Range 33 EAST  
County of HARNEY State of ORE  
NORTH

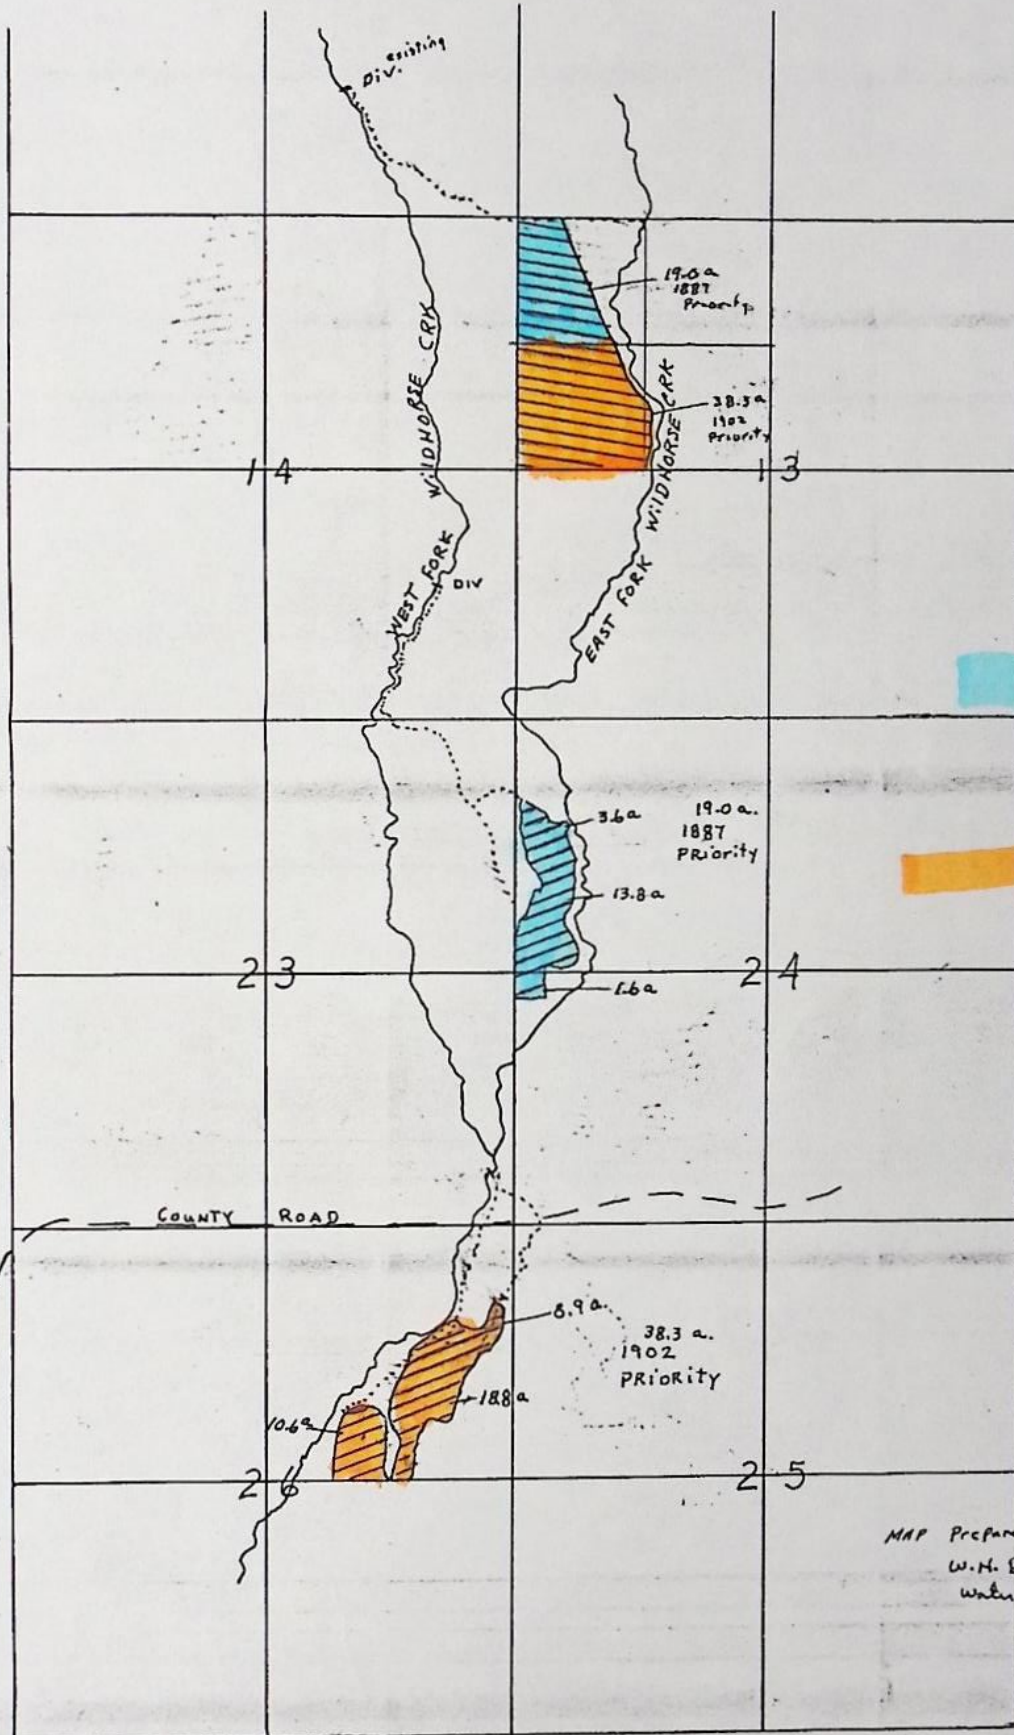

Scale 4" = 1 Mile

Note EAST Fork is usually DRY / USED IN HEAVY RUN OFF.

*Ves*

POD  
POU  
USE  
Add'l POD

Add'l POD

County Harney

1. Name Helen & Bessie Blair

Address Andrews Star Rt, Box 5, Burns, OR 97720

2. Source of Supply Wildhorse Cr., Trib of \_\_\_\_\_

3. Use in/38,3ae

4. Amount of Water 1160<sup>th</sup> cfs/ac/yr : 2 1/2 ac-ft/yr

5. Priority Date 1902

6. Proposed Point of Diversion 1260' N + 1850' W from SE Cor, S11,  
W in SW SE, S11, T35S, R33E, Wm (Surplus Ditch).

7. Completion Date 10-1-81

8. Place of Use:

[illegible]

~~22948~~  
~~4493~~ JLC

## SECTION PLAT

Section 13Township 35 SRange 33 E

RECEIVED

County of HARNEYState of OREGON

SEP 11 1979

WATER RESOURCES DEPT.  
SALEM, OREGON

NORTH

RECEIVED

JUN 27 1978

WATER RESOURCES DEPT.  
SALEM, OREGONTRANSFER  
TO

11

12

DIV  
WEST CHANNEL  
WILDHORSE CRKEAST CHANNEL  
WILDHORSE CRK  
ROAD190 Ac  
1887  
Pri.38 1/2  
1902  
Pri.

14

13

S

Remarks scale  $\frac{1}{4}$ " = 1 mile <sup>1320</sup> 660). TRANSFER 190 Ac 1887 Priority From SEC. 24 AND  
 38 1/2 Ac 1902 Priority From SEC. 26 T35S R33E TO SEC. 13 T35S R33E  
 using existing Div Point. Change Permit G-8657 To Supplemental  
 in SW 1/4, NW 1/4 Sec 13 T35S R33E For 30 Ac.

See File 57573 for report

7-18-88

V.L. Chund R.I.



## Water Resources Department

3850 PORTLAND ROAD NE, SALEM, OREGON 97310

PHONE

378 - 3739

March 31, 1989

Henry and Bessie Blair  
Andrews Star Route, Box 5  
Burns, Oregon 97720

REFERENCE FILES: T-3985, T-4293, G-8657, 57573, 58478

Dear Mr. & Mrs. Blair

Enclosed are certificates confirming changes approved by transfers numbered 3985 and 4293. Please review the notice regarding certificates which is also enclosed.

Our findings regarding permits 43216 and G-8116 are enclosed in the form of proposed certificates. It is important that you read the notice pertaining to these.


Our Field Inspector reports no land west of Wildhorse Creek irrigated as proposed under your application 58478, permit 44048. All land East of Wildhorse Creek found irrigated was included in the proposed certificate under permit 43216.

Since the water right as allowed by permit 44048 was not perfected, the permit serves no purpose and should be cancelled. Enclosed is a form to be signed and returned to the department which will authorize us to cancel the permit. This process will avoid the necessity for formal cancellation proceedings.

Our Inspector also reports finding 115.4 acres irrigated under permit G-8116 which exceeds the 105.0 acres requested by 10.4 acres. This is the unhatched area in the SW 1/4 SW 1/4, Section 13. If you intend to continue the irrigation of the 10.4 acres, a new permit should be obtained. An application and our instruction booklet is enclosed.

If you have questions, please give me a call.

Sincerely;

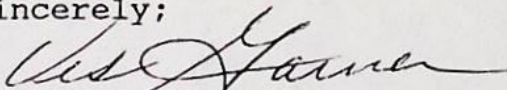  
Vestal R. Garner, Manager  
Certificate Section

ENCLOSURES

CC: Bill Beal, Watermaster

RECEIVED

JAN 18 1982

WATER RESOURCES DEPT.  
SALEM, OREGON

NOTICE OF COMPLETION OF CHANGE IN

place of use & point of diversion from Wildhorse Cr.

PURSUANT TO TRANSFER APPLICATION NO. 4993

I, Henry E. Blair, hereby certify that completion  
of works and use of water to the extent intended within the provisions  
of the order of the Water Resources Director approving said water  
right transfer application was accomplished by Oct 1, 1981.

Jan 12, 1982  
Date

Henry E. Blair  
Signature

(Mail to the Water Resources Department, Salem, Oregon 97310.)

OK  
D. J.

WILDIHORSE CR TRIB ALFORD L.

WR T-0982-C1

\*\*\* OREGON WATER RESOURCES DEPARTMENT \*\*\*  
 \*\*\* WATER RIGHTS DIVISION \*\*\*  
 \*\*\* WATER RIGHT DATA INPUT FORM \*\*\*

 PAGE 1  
 RUN ON: 3/20/81 AT: 9:08

 WATER RIGHT NO. T00004293 PERMIT NO. 015368 CERTIF. NO.  
 ORIG. NO. C00020915 PREV. NO. C00020915 SUPER. NO.

 NAME: HENRY & BESSIE BLAIR  
 ADDRESS: ANDREWS STAR RT BOX 5  
 CITY/STATE/ZIP/COUNTY: BURNS, OR 97720
STREAM-ID 12 0060 0010 0020

RIV. MI.

WM. DIST. 10 W.R. TYPE S C STATUS V

CANCEL YEAR---&gt;

CONSTR. COMPLT---> 10 01 1981

YR. LAST USED-----&gt; \_\_\_\_\_

NEXT ACTION DUE---&gt; \_\_\_\_\_

PRIORITY-----> 12 31 1902PUT TO USE-----> 10 01 1981

LAST TRANS. DATE---&gt; \_\_\_\_\_

LAST TRANS. TYPE---&gt; \_\_\_\_\_

APPLICATION---> 09 11 1979

SURVEYED-----&gt;

EXAM. FEE-----> 20.00

RECORDING FEE-----&gt;

27.25PERMIT ISSUE---> 12 20 1979

CONCURRENCE-----&gt;

CYCLE STATUS-----&gt; \_\_\_\_\_

REPORTED FLAG-----&gt; \_\_\_\_\_

CONSTR. STRT---> 12 20 1979

CERTIFIED-----&gt;

CORRES. INIT.-----&gt; \_\_\_\_\_

CORRES. DATE-----&gt; \_\_\_\_\_

 POINT-OF-DIVERSION DATA;  
 TWP/SP RGE SECT QTR/QTR STREAM-ID

RIV. MI.

RATE

STATUS S OR P

3505 330E 11 D C 12 0060 0010 00200.638VP
 \*\* REMARKS; - - - - -  
 \*\* DATED--->

 \*\* POD: SURPLUS DITCH, 1260' N &  
 \*\* 1850' W FM SE COR S 11. CHANGES  
 \*\* POU & POD ALL OF C-20915.

PLACE-OF-USE DATA:

TWP/SP RGE SECT QTR/QTR CNTY USE % CNSMTV ACRES STATUS S OR P

3505 330E 13 B C 13 1R 100 38.30VP
 \*\*-----  
 \*\*-----  
 \*\*-----  
 \*\*-----

W.R.I.S.

Assembled 3-22-85 by SAK

Entered \_\_\_\_\_ by \_\_\_\_\_

Verified \_\_\_\_\_ by \_\_\_\_\_

BEFORE THE WATER RESOURCES DIRECTOR OF OREGON

HARNEY COUNTY

IN THE MATTER OF THE APPLICATION )  
OF HENRY & BESSIE BLAIR FOR AP- )  
PROVAL OF CHANGES IN PLACE OF USE )  
AND POINT OF DIVERSION OF WATER )  
- - - - -

ORDER APPROVING  
TRANSFER NO. 4293

On September 11, 1979, an application was filed in the office of the Water Resources Director by Henry and Bessie Blair for approval of changes in place of use and point of diversion of water from Wildhorse Creek, pursuant to the provisions of ORS 540.510 to 540.530.

The certificate recorded at page 20915, Volume 15, State Record of Water Right Certificates, in the name of Robert E. Blair, describes a right for the use of not to exceed 1/60th cubic foot per second per acre per year, not to exceed 2½ acre feet per year, from Wildhorse Creek for irrigation of a certain 8.9 acres in NE¼ NE¼, 10.6 acres in SW¼ NE¼ and 18.8 acres in SE¼ NE¼, Section 26, Township 35 South, Range 33 East, W.M., with a date of priority of 1902. Water for this right is diverted, through an unnamed ditch, from a point located 580 feet North and 280 feet West from the Northeast Corner of Section 26, being within the SE¼ SE¼ of Section 23, Township 35 South, Range 33 East, W.M.

The applicants herein, owners of the lands above described, propose to change the place of use and point of diversion therefrom and, without loss of priority, to irrigate in lieu thereof a certain 38.3 acres in SW¼ NW¼ of Section 13, Township 35 South, Range 33 East, W.M., with a date of priority of 1902, from a point of diversion located 1260 feet North and 1850 feet West from the Southeast Corner of Section 11, being within the SW¼ SE¼, Section 11, Township 35 South, Range 33 East, W.M. (Surplus Ditch).

Notice of the application, pursuant to ORS 540.520(2), was published in the Times-Herald, a newspaper printed and having general circulation in Harney County, Oregon, for a period of three weeks in the issues of October 4, 11 and 18, 1979.

Mr. William H. Beal, Watermaster, has filed a statement to the effect that the proposed changes in place of use and point of diversion may be made without injury to existing rights.

No objections having been filed and it appearing that the proposed changes

in place of use and point of diversion may be made without injury to existing rights, the application should be approved. '

NOW, THEREFORE, it hereby is ORDERED that the requested changes in place of use and point of diversion, as described herein, without loss of priority, are approved.

It is FURTHER ORDERED that the quantity of water diverted at the new point of diversion shall not exceed the quantity of water available at the old point of diversion under the subject right.

It is FURTHER ORDERED that the following provisions shall be effective when in the judgment of the watermaster it becomes necessary to install headgates and measuring devices:


That the diversion works shall include an in line flow meter, a weir, or other suitable device for measuring the water to which the applicant is entitled;

That the type and plans of the measuring device be approved by the watermaster before the beginning of construction work and that the weir or measuring device be installed under the general supervision of said watermaster.

It is FURTHER ORDERED that the construction work shall be completed and the change in point of diversion of water made and that said water so transferred shall be applied to beneficial use on or before October 1, 1981.

It is FURTHER ORDERED that the certificate recorded at page 20915, Volume 15, State Record of Water Right Certificates, is canceled; and upon proof satisfactory to the Water Resources Director of completion of works and beneficial use of water to the extent intended under the provisions of this order, a confirming certificate of water right shall be issued to the applicants herein.

Dated at Salem, Oregon this 20th day of December, 1979.

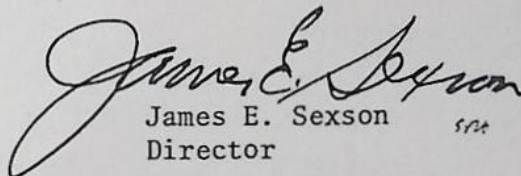  
James E. Sexson  
Director

T-4293

RECEIVED

SEP 11 1979

WATER RESOURCES DEPT  
SALEM, OREGON

# Application for Transfer of Water Right

To the WATER RESOURCES DIRECTOR OF OREGON:

I, Henry Blair and Bessie Blair

(Name of applicant)

of Andrews

(Mailing address)

(City)

State of Oregon, 97720

(Zip Code)

(Phone number)

do hereby make application for change

in point of diversion and place of use

(In point of diversion; place of use; use heretofore made of the water)

1. Is the water right recorded in your name? Robert E Blair

(If not, give name)

2. Was your water right determined by Decree of Court? Yes If so, give title of proceedings

(Yes or No)

Wildhorse Creek

number of certificate 20915

3. Was your water right acquired by Water Right Permit? Yes If so, give number

(Yes or No)

of permit 1902 Number of certificate 20915

NOTE: If the entire right of record is not directly involved in the requested change, only that part of the right that is directly involved should be considered in answering the balance of the questions on this form.

4. The source of water is Wildhorse Creek

5. What is the date of priority of your water right? 1902

6. The authorized point of diversion is located 500 ft. N and 280 ft. W from the NE

(N. or S.)

(E. or W.)

corner of Sec. 26 being within the SE 1/4 SE 1/4 of Section 23 Tp. 35S R. 33E W. M.,

(No. N. or S.)

(No. E. or W.)

in the county of Harney The name of the ditch used is Unnamed Ditch

NOTE: Answer question if the application is for change in point of diversion.

on West Channel of Wildhorse Creek

7. The proposed point of diversion is located 1260 ft. N and 1850 ft. W from the SE

(N. or S.)

(E. or W.)

corner of Sec. 11 being within the SW 1/4 SE 1/4 of Section 11 Tp. 35S R. 33E W. M.,

(No. N. or S.)

(No. E. or W.)

in the county of Harney The name of the ditch to be used is Surplus

ex 2000  
POD 1500  
POU 1225  
4725

65-POU for 100/10

8. The use to which the water is applied is irrigation  
(Irrigation, Mining, Power, Manufacturing, etc.)

Location of area irrigated, or place of use if other than irrigation:

| Township<br>North or South | Range<br>E. or W. of<br>Willamette Meridian | Section | List $\frac{1}{4}$ - $\frac{1}{4}$ of Section | Number Acres To Be Irrigated |
|----------------------------|---------------------------------------------|---------|-----------------------------------------------|------------------------------|
| 35S                        | 33E                                         | 26      | NE $\frac{1}{4}$ NE $\frac{1}{4}$             | 8.9                          |
|                            |                                             |         | SW $\frac{1}{4}$ NE $\frac{1}{4}$             | 10.6                         |
|                            |                                             |         | SE $\frac{1}{4}$ NE $\frac{1}{4}$             | 18.8                         |
|                            |                                             |         |                                               | <u>38.3</u>                  |
|                            |                                             |         |                                               |                              |
|                            |                                             |         |                                               |                              |

(If more space required, attach separate sheet)

9. Are you the legal owner of the above described lands? Yes  
(If not owner, explain your interest)

10. To your knowledge, has any portion of the water right above described undergone a period of five or more consecutive years of nonuse? No  
(Yes or No)

NOTE: Answer questions 11, 12 and 13 if application is for change in use or place of use.

11. Are the lands from which you propose to transfer your water right free of all encumbrances, including taxes, mortgages, liens, etc.? No  
(Answer Yes or No)

12. If not, give below a description of existing encumbrances:

| NATURE OF ENCUMBRANCE | HELD BY | AMOUNT |
|-----------------------|---------|--------|
|                       |         |        |
|                       |         |        |

13. The use to which the water is to be applied is irrigation  
(Irrigation, power, mining, manufacturing, domestic supplies, etc.)

Location of area to be irrigated, or place of use if other than irrigation:

| Township<br>North or South | Range<br>E. or W. of<br>Willamette Meridian | Section | List $\frac{1}{4}$ - $\frac{1}{4}$ of Section | Number Acres To Be Irrigated |
|----------------------------|---------------------------------------------|---------|-----------------------------------------------|------------------------------|
| 35S                        | 33E                                         | 13      | SW $\frac{1}{4}$ NW $\frac{1}{4}$             | 38.3                         |
|                            |                                             |         |                                               |                              |
(If more space required, attach separate sheet)

14. Reasons for the proposed changes are to put water to a more  
beneficial use with less waste

15. Construction work will be completed on or before July 1979

16. The water will be completely applied to the proposed use on or before Oct 1979

Remarks

**NOTE:** THIS APPLICATION MUST BE ACCOMPANIED BY A MAP OR MAPS SHOWING THE BEFORE AND AFTER LOCATIONS OF THE POINT OF DIVERSION AND/OR PLACE OF USE, AS THE CASE MAY BE.

#### AFFIDAVIT OF APPLICANT

I, Henry Blair & Bessie Blair, the applicant herein, being first duly sworn, depose and say that I have read the above and foregoing application for transfer of water right; that I know the contents thereof and that the statements therein made are true and correct to the best of my knowledge and belief.

In Witness Whereof, I have hereunto set my hand this 15<sup>th</sup> day of July, 1978

x Henry Blair  
x Bessie Blair  
(Name of applicant)

Subscribed and sworn to before me this 15<sup>th</sup> day of July, 1978

[Notarial Seal]

William M. Allen

NOTARY PUBLIC FOR OREGON

My commission expires 09-19-78





## STATE OF OREGON

## INTEROFFICE MEMO

TO: TRANSFERS, WATER RIGHTS DIVISION

DATE: July 10, 1978.

FROM: William H. Beal

SUBJECT: WATER RIGHT TRANSFER APPLICATION NO. 3985  
IN THE NAME OF Henry and Bessie Blair

RECEIVED

JUL 13 1978

WATER RESOURCES DEPT.  
SALEM, OREGON

In my opinion the proposed change in POD and POU  
may be made without injury would result in injury\* to existing water rights.

Headgate notices have have not been issued for diversions from the source which serves this right.

If for change in point of diversion, is there any intervening point of diversion between the authorized and the proposed points of diversion? NO  
(yes or no)

In my opinion the order approving the subject transfer application should include the following in regard to the appropriator installing suitable measuring devices in the diversion works:

- (1) PRIOR to the diverting of water at the new point of diversion...
- X (2) When in the judgement of the watermaster it becomes necessary...

\* The approval of this transfer application would result in injury to other water rights because

I can see no injury from this change. The East fork of Wild horse Cr. is dry except an occasional high fast run off.

The Transfer would give more efficient use of the water.

+ William H. Beal  
WATERMASTERS SIGNATURE OR INITIALS



## *Water Resources Department*

### MILL CREEK OFFICE PARK

555 13th STREET N.E., SALEM, OREGON 97310

PHONE 378-3066

June 30, 1978

Henry and Bessie Blair  
Andrews Route  
Burns, Oregon 97720

RE: File No. T-3985

Dear Mr. & Mrs. Blair:

Your water right transfer application for approval of a change in place of use and changes in points of diversion of water from Wildhorse Creek, together with the two maps, were received on June 27, 1978. Of the fees submitted, \$23.90 was credited to your transfer application. Our receipt No. 3985 is enclosed.

The changes proposed for the water right described in the certificate issued to Robert E. Blair, recorded at Page 20915, State Record of Water Right Certificates, includes a proposed change in point of diversion from Wildhorse Creek below the confluence of the East and West channels of Wildhorse Creek to a point upstream on the West channel. Since there are various diversions of water under other rights on both channels, it appears that such a change would result in a situation where there would be no reasonable way to distribute water to said right at the proposed location. Therefore, it is doubtful that the proposed changes for the right described in the certificate recorded at Page 20915 could be approved.

If you choose not to go ahead with the change for the right described in the certificate recorded at Page 20915, reference to this right may be deleted from your transfer application and supporting map. We can proceed with your application for the changes requested for the other right described in the certificate recorded at Page 20913.

The application requires additional recording fees in the amount of \$21.10 for the change involving the certificate recorded at Page 20913. It is also necessary to submit a deposit of \$50.00 to cover the cost of publication. Will you please tell us which newspaper you prefer that we use. Any difference between the fees submitted and the actual cost will be settled with you upon completion of the transfer proceeding.

By copy of this letter, we are asking the watermaster for his usual report regarding the proposed changes.

Henry and Bessie Blair  
T-3985  
Page Two

I am returning your transfer application and map for completion.  
Please refer any correspondence to File No. T-3985.

Sincerely,

Wayne J. Overcash  
Water Rights Engineer

WJO:slk  
Enclosure  
cc: William H. Beal, Watermaster



RECEIVED

JUN 27 1979

WATER RESOURCES DEPT  
SALEM, OREGON

WILDHORSE RANCH  
Andrews, Oregon

June 26, 1979

Mr. Wayne J. Overcash  
Water Resources Department  
555 - 13th Street N. E.  
Salem, Oregon 97310


Re: Henry Blair Application for Water Transfer  
T-3985

Dear Mr. Overcash:

This will confirm that Wildhorse Ranch, Inc., has no objections in connection with the above transfer. Also, the East Fork that is in the area of the subject property is not considered by us to be a major waterway.

If anything further in this connection is needed, kindly advise.

Yours very truly,

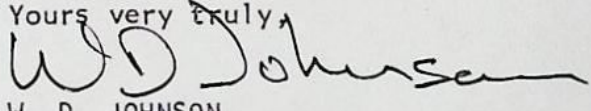  
W. D. JOHNSON

WDJ/bd

cc: Mr. Henry Blair  
Andrews Star Route  
Burns, Oregon 97720

T-4293

|   |                   |             |            |                                                        |                                        |   |
|---|-------------------|-------------|------------|--------------------------------------------------------|----------------------------------------|---|
| 20911<br>Robert E. Blair<br>successor to<br>Louise Blair, deceased<br>Andrews, Oregon<br>Claim No. 1<br>Contest No. 4<br>Findings 18 and 21 | 1894              | 21.8        | Irrigation | Unnamed                                                | Wildhorse<br>Creek                     | 7.8 acres in the SW $\frac{1}{4}$ NE $\frac{1}{4}$ ,<br>8.0 acres in the NE $\frac{1}{4}$ NW $\frac{1}{4}$ ,<br>6.0 acres in the SE $\frac{1}{4}$ NW $\frac{1}{4}$ ,<br>Section 2,<br>T. 35 S., R. 33 E., W.M.                                                                      |
| 20912<br>Harry E. Blair and<br>Bessie Blair<br>Andrews, Oregon<br>Claim No. 2<br>Contest No. 4<br>Findings 19 & 22                          | 1883              | 137.8       | Irrigation | Turner                                                 | Wildhorse<br>Creek,<br>West<br>Channel | 30.0 acres in the NE $\frac{1}{4}$ NE $\frac{1}{4}$ ,<br>34.5 acres in the NW $\frac{1}{4}$ NE $\frac{1}{4}$ ,<br>33.5 acres in the SW $\frac{1}{4}$ NE $\frac{1}{4}$ ,<br>40.0 acres in the SE $\frac{1}{4}$ NE $\frac{1}{4}$ ,<br>Section 14,<br>T. 35 S., R. 33 E., W.M.         |
| 20913<br>Claim No. 3<br>Contest No. 4<br>Findings 19 & 22                                                                                   | 1887              | 19.0        | Irrigation | Larson                                                 | Wildhorse<br>Creek,<br>West<br>Channel | 3.6 acres in the NW $\frac{1}{4}$ NW $\frac{1}{4}$ ,<br>13.8 acres in the SW $\frac{1}{4}$ NW $\frac{1}{4}$ ,<br>1.6 acres in the NW $\frac{1}{4}$ SW $\frac{1}{4}$ ,<br>Section 24,<br>T. 35 S., R. 33 E., W.M.                                                                    |
| 20914<br>Claim No. 4<br>Contest No. 4<br>Findings 19 & 22                                                                                   | July 21,<br>1913  | 10.0<br>8.5 | Irrigation | Modified- See Decree<br>Paragraph I, pg 448<br>Vol. 15 | Unnamed<br>Springs                     | 1.5 acres in the NW $\frac{1}{4}$ SW $\frac{1}{4}$ ,<br>2.0 acres in the SW $\frac{1}{4}$ SW $\frac{1}{4}$ ,<br>Section 1,<br>4.0 acres in the NE $\frac{1}{4}$ SE $\frac{1}{4}$ ,<br>1.0 acre in the SE $\frac{1}{4}$ SE $\frac{1}{4}$ ,<br>Section 2,<br>T. 35 S., R. 33 E., W.M. |
| Modifying Water Right Certificate recorded<br>Volume 2, page 1370, State Record of Water Right Certificates.                                |                   |             |            |                                                        |                                        |   |
| 20915<br>Robert E. Blair<br>Andrews, Oregon<br>Claim No. 5<br>Contest No. 4<br>Findings 18 and 23                                           | 1902              | 38.3        | Irrigation | Unnamed                                                | Wildhorse<br>Creek                     | 8.9 acres in the NE $\frac{1}{4}$ NE $\frac{1}{4}$ ,<br>10.6 acres in the SW $\frac{1}{4}$ NE $\frac{1}{4}$ ,<br>18.8 acres in the SE $\frac{1}{4}$ NE $\frac{1}{4}$ ,<br>Section 26,<br>T. 35 S., R. 33 E., W.M.                                                                   |
| 20916<br>Robert E. Blair and<br>Harry Blair<br>Andrews, Oregon<br>Claim No. 6<br>Contest No. 4<br>Findings 18 & 24                          | April 9,<br>1915  | 20.0        | Irrigation | Unnamed                                                | Willow<br>Creek &<br>Willow<br>Springs | 20.0 acres in the E $\frac{1}{2}$ SE $\frac{1}{4}$ SE $\frac{1}{4}$ ,<br>Section 10,<br>T. 35 S., R. 33 E., W.M.   |
| Confirming Water Right Certificate recorded<br>Volume 3, page 1826, State Record of Water Right Certificates.                               |                   |             |            |                                                        |                                        |   |
| 20917<br>Claim No. 7<br>Contest No. 4<br>Findings 18 and 24                                                                                 | April 30,<br>1920 | 7.7         | Irrigation | Unnamed                                                | Willow<br>Creek                        | 2.5 acres in the W $\frac{1}{2}$ SE $\frac{1}{4}$ SE $\frac{1}{4}$ ,<br>Section 10,<br>5.2 acres in the NE $\frac{1}{4}$ NE $\frac{1}{4}$ NE $\frac{1}{4}$ ,<br>Section 15<br>T. 35 S., R. 33 E., W.M.                                                                              |
| Confirming and modifying Water Right Certificate recorded<br>Volume 4, page 3453, State Record of Water Right Certificates.                 |                   |             |            |                                                        |                                        |   |
| 20918<br>Willem M. Bruckwilder<br>Andrews, Oregon<br>Claim No. 8<br>Contest No. 2<br>Findings 16 & 25                                       | 1905              |             | Irrigation | Unnamed                                                | Andrews<br>Creek                       | 5 fruit trees located in the<br>N $\frac{1}{2}$ NW $\frac{1}{4}$ NW $\frac{1}{4}$ NE $\frac{1}{4}$ ,<br>Section 27<br>T. 35 S., R. 33 E., W.M.   |
| This right is inferior to the right of<br>Andrew J. and Marjorie A. Skull under Claim No. 21.                                               |                   |             |            |                                                        |                                        |   |

WILDHORSE CREEK - Harney Co. Page 38