

4272 Vigil

Name Janet W. Vigil

By _____

Address 4794 Sams Valley Rd.
Gold Hill, OR 97525Change in POVDate filed August 7, 1979

Date of hearing _____

Place of hearing _____

Date of order 10-26-79 Vol. 32, page 461Date for application of water 10-1-81Proof mailed NOV 30 1999 FEB 17 2000

Proof received _____

Certificate issued JAN 21 1980 Vol. 42, page 48876MAY 10 2000 76532Surveyed 10/17/84to survey 6/00OK certNew owner Scott Holliman ← Per Co.
PO Box 4194
Medford, OR 97501
Assessor

4272

DESCRIPTION OF WATER RIGHT

Name of stream unnamed stream & reservoirTrib. of _____ County of JacksonUse irrigationQuantity of water _____ No. of acres 1.8

Name of ditch _____

Date of priority Sept. 13, 1957In name of Ralph A. James

Adjudication, Vol. _____, page _____

App. No. 31869 Per. No. 25121 Cert. No. 29714

Certificate cancelled _____

Notation made on record by _____

FEES PAID

Date	Amount	Receipt No.
<u>8-7-79</u>	<u>30.00</u>	<u>13305</u>
TOTAL . . .		
	Cert. Fee	

FEES REFUNDED

Date	Amount	Check No.

REMARKS

W.R.I.S.

Assembled 3-19-85 by SEA

Entered _____ by _____

Verified _____ by _____


TO BE ENTERED WHERE CHECKED	INDEX CARDS:	
	Entered	Checked
☒ Name	<u>Dej</u>	<u> </u>
☒ Stream	<u>Dej</u>	<u> </u>
☒ Pt. of Div.	<u>Dej</u>	<u> </u>
☒ Calendar	<u>Dej</u>	<u> </u>
☒ Twp. & Rge.	<u>SRB</u>	<u> </u>
☒ Decree-vault	<u> </u>	<u> </u>
☒ Decree-sale	<u> </u>	<u> </u>
☒ Cert. of W/R	<u>SEA</u>	<u> </u>
☒ Per. Folder	<u>Dej</u>	<u> </u>
☒ Chainindex	<u> </u>	<u> </u>
☒ Cross Ref.	<u> </u>	<u> </u>
☒ Power Claim	<u>Dej</u>	<u> </u>
☒ Abstracts	<u> </u>	<u> </u>

464

T. 35S., R. 2 W., W.M.

Sec. 30

SE 1/4 SE 1/4

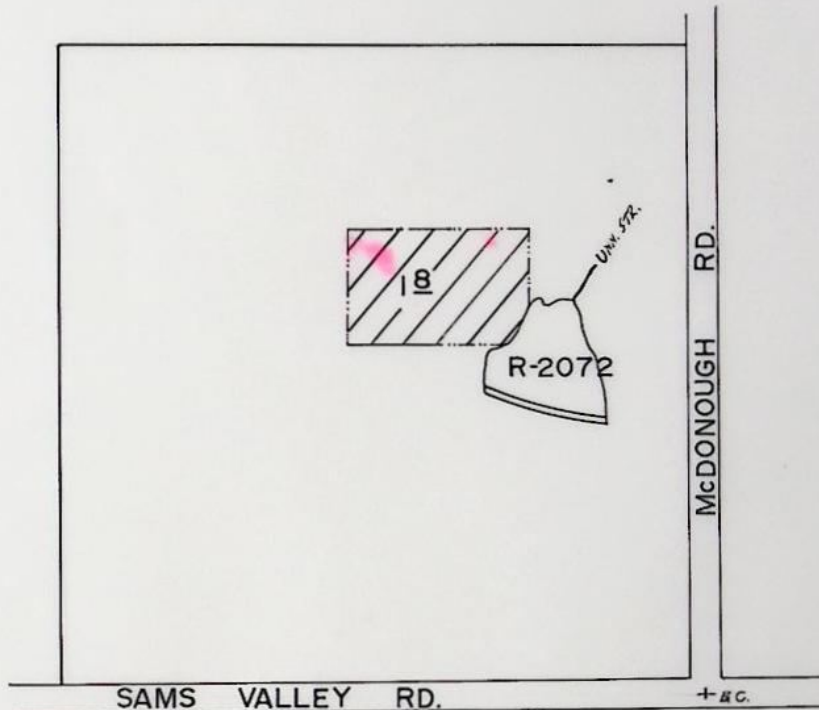

Scale 1"=400'

FINAL PROOF SURVEY
UNDER

Transfer No. 4272

Application No. Permit No.
IN NAME OF

JANET W. VIGIL

Surveyed Oct. 17, 1984, by J.R. WOODROOF

REPORT ON INSPECTION UNDER TRANSFER
OF WATER RIGHT FOR CHANGE IN: POD

POD
POD
USE
Add '1 POD

Transfer NO. 4272

County

Old Certificate NO. 29714

1. Name Janet W. Vigil (855 - 7523)
Address 4794 Sams Valley Rd, Gold Hill, OR 97525
2. Source of Supply un'd stream & reservoir, Trib of Table Rock Cr.
3. Use irrigation of 1.8 ac
4. Amount of Water 0.048 cfs Priority Date 9/13/1957
5. Proposed Point of Diversion

6. Completion Date 10-1-81

7. Place of Use:

[illegible]

RECEIVED

MAY 20 1985

WATER RESOURCES DEPT
SALEM, OREGON


NO CONFLICTS

SE $\frac{1}{4}$ of SE $\frac{1}{4}$ of SECTION 30, T.35S, R.2W, W.M T-42-72

RECEIVED

AUG 1 - 1979

WATER RESOURCES DEPT.
SALEM, OREGON

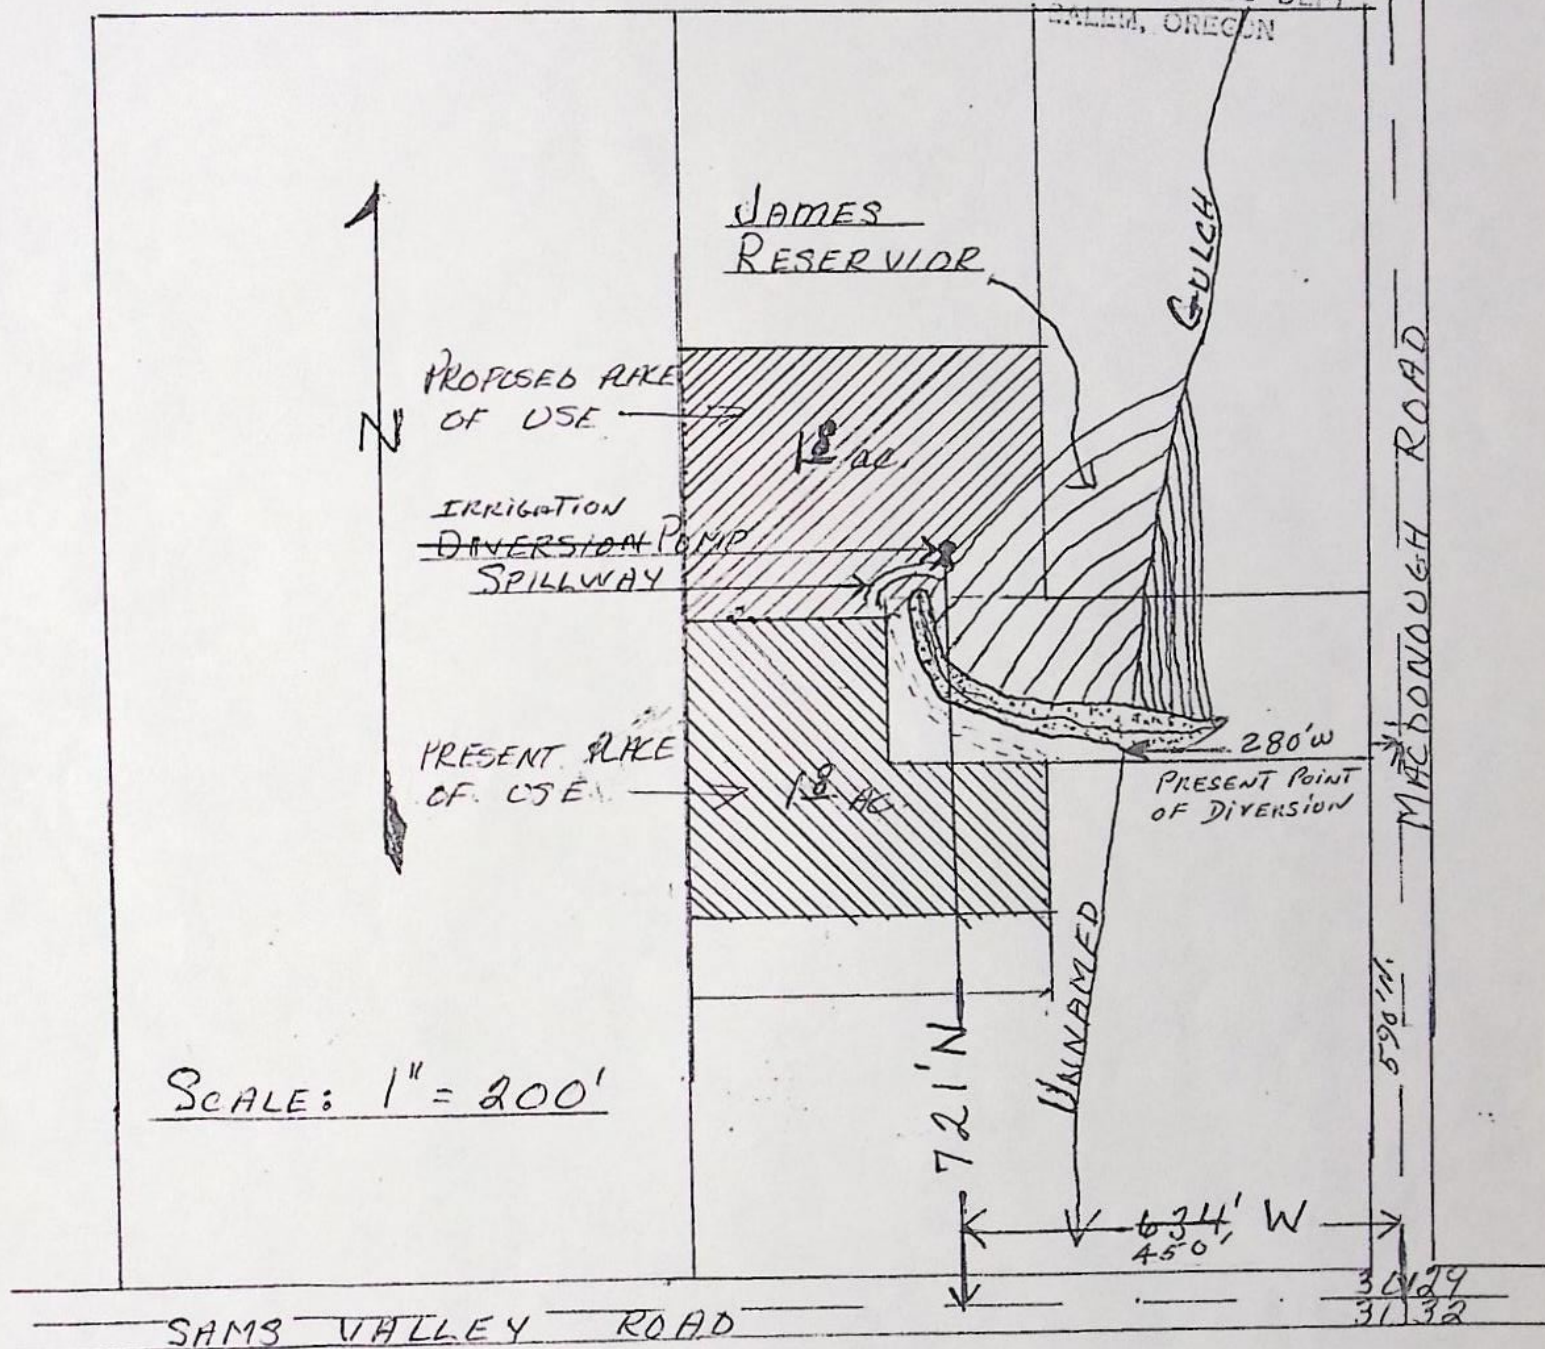


MAP TO COMPLETE APPLICATION OF JANET W. VIGIL
FOR CHANGE OF PLACE IN USE ON PER. # 25121

RECEIVED

MAY 20 1985

WATER RESOURCES DEPT.
SALEM, OREGON

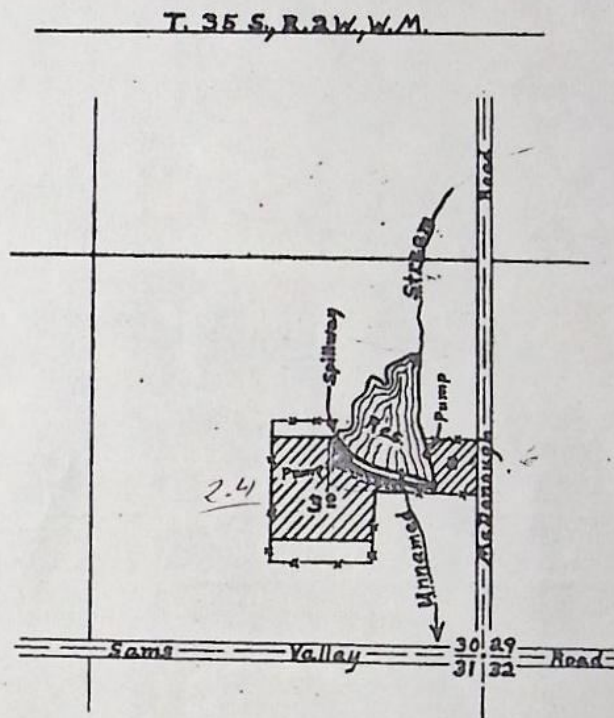

(Scale: 8" = 1 mile)

RECEIVED

MAY 20 1985

FINAL PROOF SURVEY WATER RESOURCES DEPT
UNDER OREGON

R-31868 R-2072
Application No. 31869 Permit No. 25121
IN NAME OF

Ralph A. James


Surveyed March 20, 1962 by B.G. Hendrix

29713
CERT. 29714
also see Cert. 48876

Ralph James R-31868
Application No. 31869
Permit No. 25121 & R2072
Priority 9-13-57

SE 1/4 of SE 1/4 of Section 30, T. 35 S., R. 2 W., W.M.

Find in Table Rock Creek
Misc.,
Vol. 7

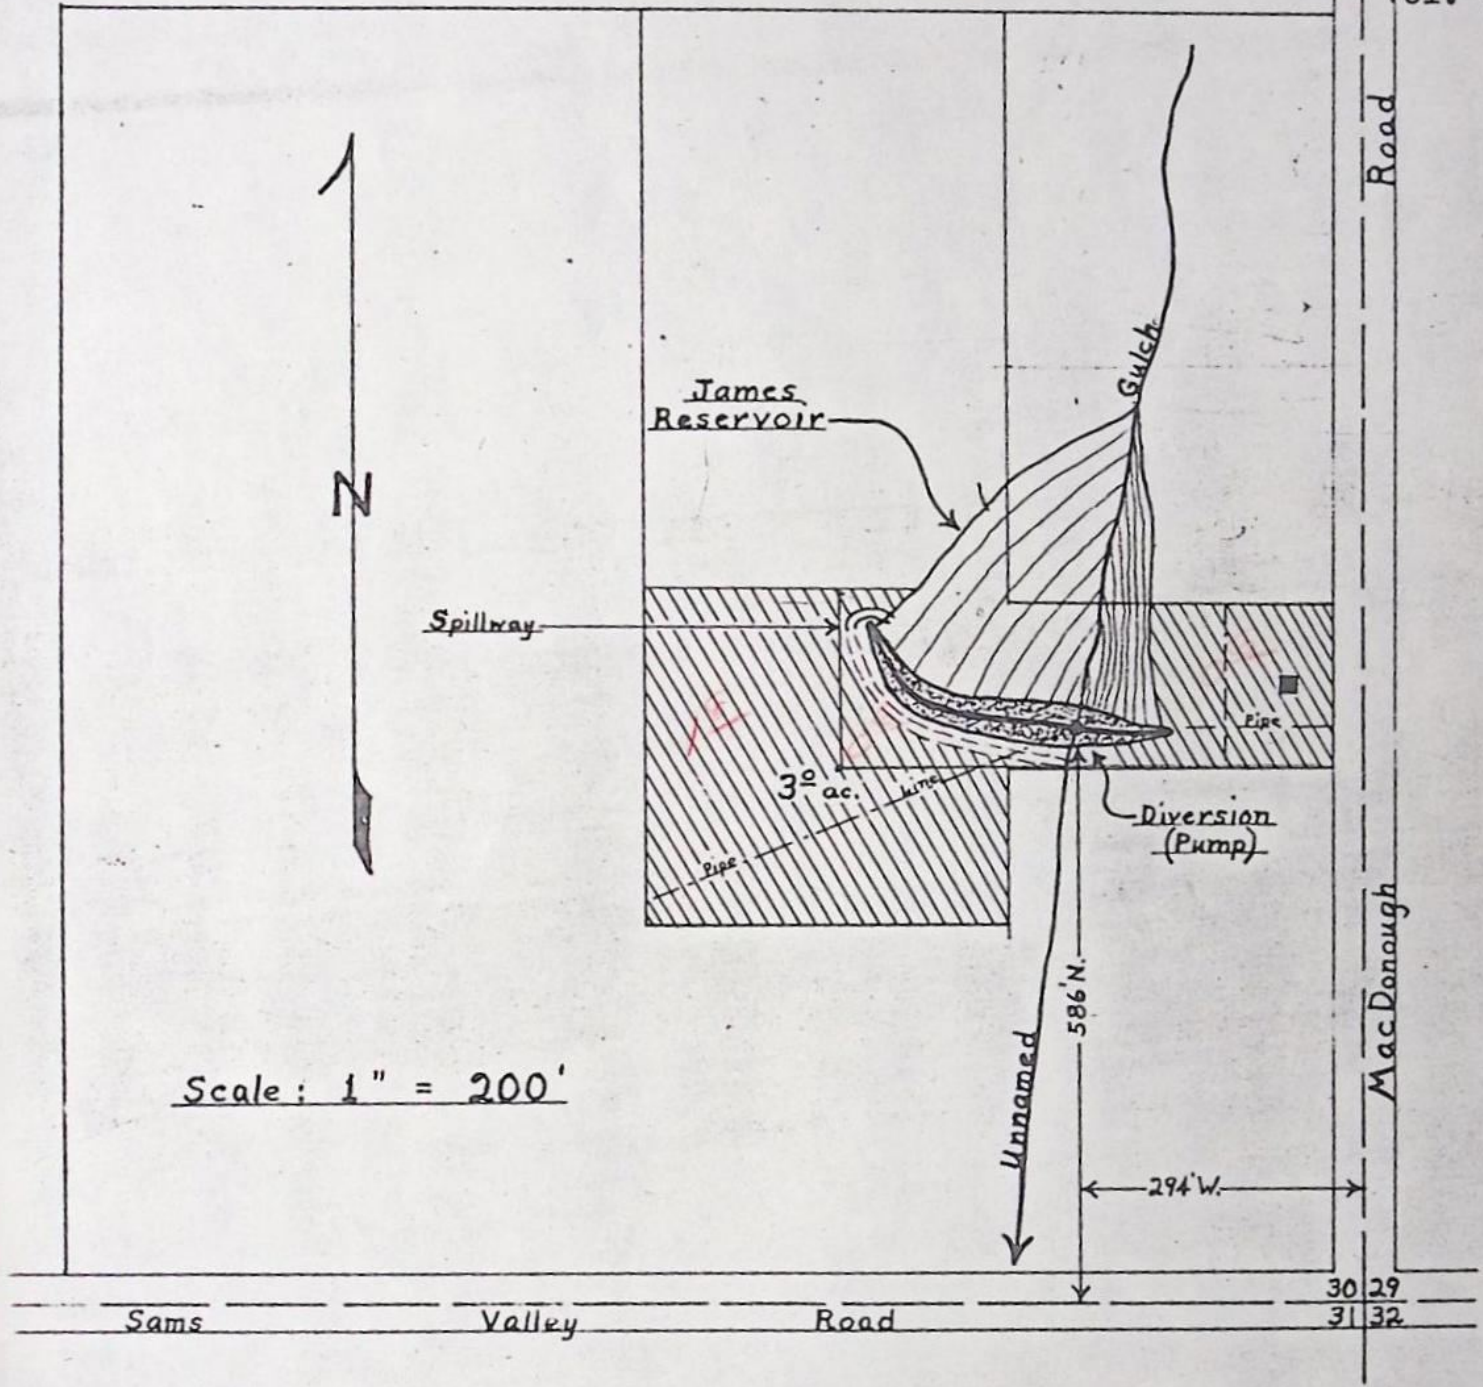

Ralph James

This Office --- 9-11-57 --- David C. Hendrix, Watermaster.

RECEIVED

MAY 20 1985

WATER RESOURCES DEPT
SALEM, OREGON

INFO: TALKED TO MRS. (VIGIL) FORREST

DIVERSION: A 1/2 hp ELECTRIC MOTOR INTO A GOULD CENTRIFUGAL 1 1/2" x 1 1/4" WHICH REDUCES TO 1" AFTER 15'. THE 1" BLACK PLASTIC LINE IS TIED TO 2 - 1" LINES. ONE LINE SUPPLIES A GARDEN WHILE THE OTHER SUPPLIES HOSE BIBS AROUND THE HOUSE. GARDEN HOSE WITH SPRINKLERS ARE USED FOR IRRIGATION

PUMP: CENTURY 1/2 hp ELECTRIC MOTOR WITH GOULD CENTRIFUGAL PUMP 1 1/2" x 1 1/4"

PIPE: 60' - 1 1/2" P.V.C. (PUMP INLET)
15' - 1 1/4" P.V.C. (PUMP OUTLET)
500' - 1" BLACK PLASTIC PIPE
50' - 1" GALVANIZED PIPE
50' - 3/4" SOAKER HOSE

SPRINKLERS: 2 - RB 5/32" x 10" } MAXIMUM USE. (3)
2 - GARDEN SPRINKLERS }

@ 40 PSI

$$\frac{(6.6)(0.5)}{101.6 + 7} = 0.034$$

101.6 + 7

USE:

LAWN & GARDEN

$$\frac{(4.4)(3)}{450} = 0.029$$

450

LIFT:

-3 to +2 DISCHARGE

+5 TO +2 SUCTION

TIE: PHOTO 41029-279-272L

TIED TO S.E. CORNER OF SECTION 30

RECEIVED

MAY 20 1985

WATER RESOURCES DEPT
SALEM, OREGON

10-17-84

John R. Woodbury

W.R.E.

RECEIVED
MAY 2 0 1985
WATER RESOURCES DEPT
PORTLAND, OREGON

RECEIVED

JUN 13 1980

WATER RESOURCES DEPT
SALEM, OREGON

NOTICE OF COMPLETION OF CHANGE IN

place of use of water from an unnamed stream

PURSUANT TO TRANSFER APPLICATION NO. 4272

I, JANET W. VIGIL, hereby certify that completion
of works and use of water to the extent intended within the provisions
of the order of the Water Resources Director approving said water
right transfer application was accomplished by June, 1980

6-12-80


Date

Janet W. Vigil

Signature

(Mail to the Water Resources Department, Salem, Oregon 97310.)

OK
J. W. Vigil

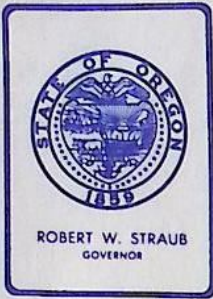

Water Resources Department

MILL CREEK OFFICE PARK

555 13th STREET N.E., SALEM, OREGON 97310

PHONE 378-3066

October 31, 1979

Janet W. Vigil
4794 Sams Valley Road
Gold Hill, Oregon 97525

RE: File No. T-4272

Dear Ms. Vigil:

Enclosed is a certified copy of the order of the Water Resources Director approving water right transfer application No. 4272 for a change in place of use of water from an unnamed stream and reservoir.

The time in which to accomplish completion of the works and beneficial use of the water to the extent intended, as authorized by the order, expires October 1, 1981. A form for reporting such completion of works and use of water is enclosed for your convenience.

You should give particular attention to the time limit for carrying out the change authorized by the enclosed order. The water right for any portion of an authorized change in use therefore made or change in place of use NOT carried out within the time allowed, or within an extension thereof, will be lost. An extension of the time limit can be allowed only upon a showing that diligent effort has been made to complete the actual change within the time allowed.

Sincerely,

Samuel R. Allison
Supervisor
Transfer Section

SRA:lcj
cc: David C. Mendrix, Watermaster


COPY

SE $\frac{1}{4}$ of SE $\frac{1}{4}$ of SECTION 30, T.35S, R.2W, W.M. T-4272

RECEIVED

AUG 7 - 1979

WATER RESOURCES DEPT
SALEM, OREGON

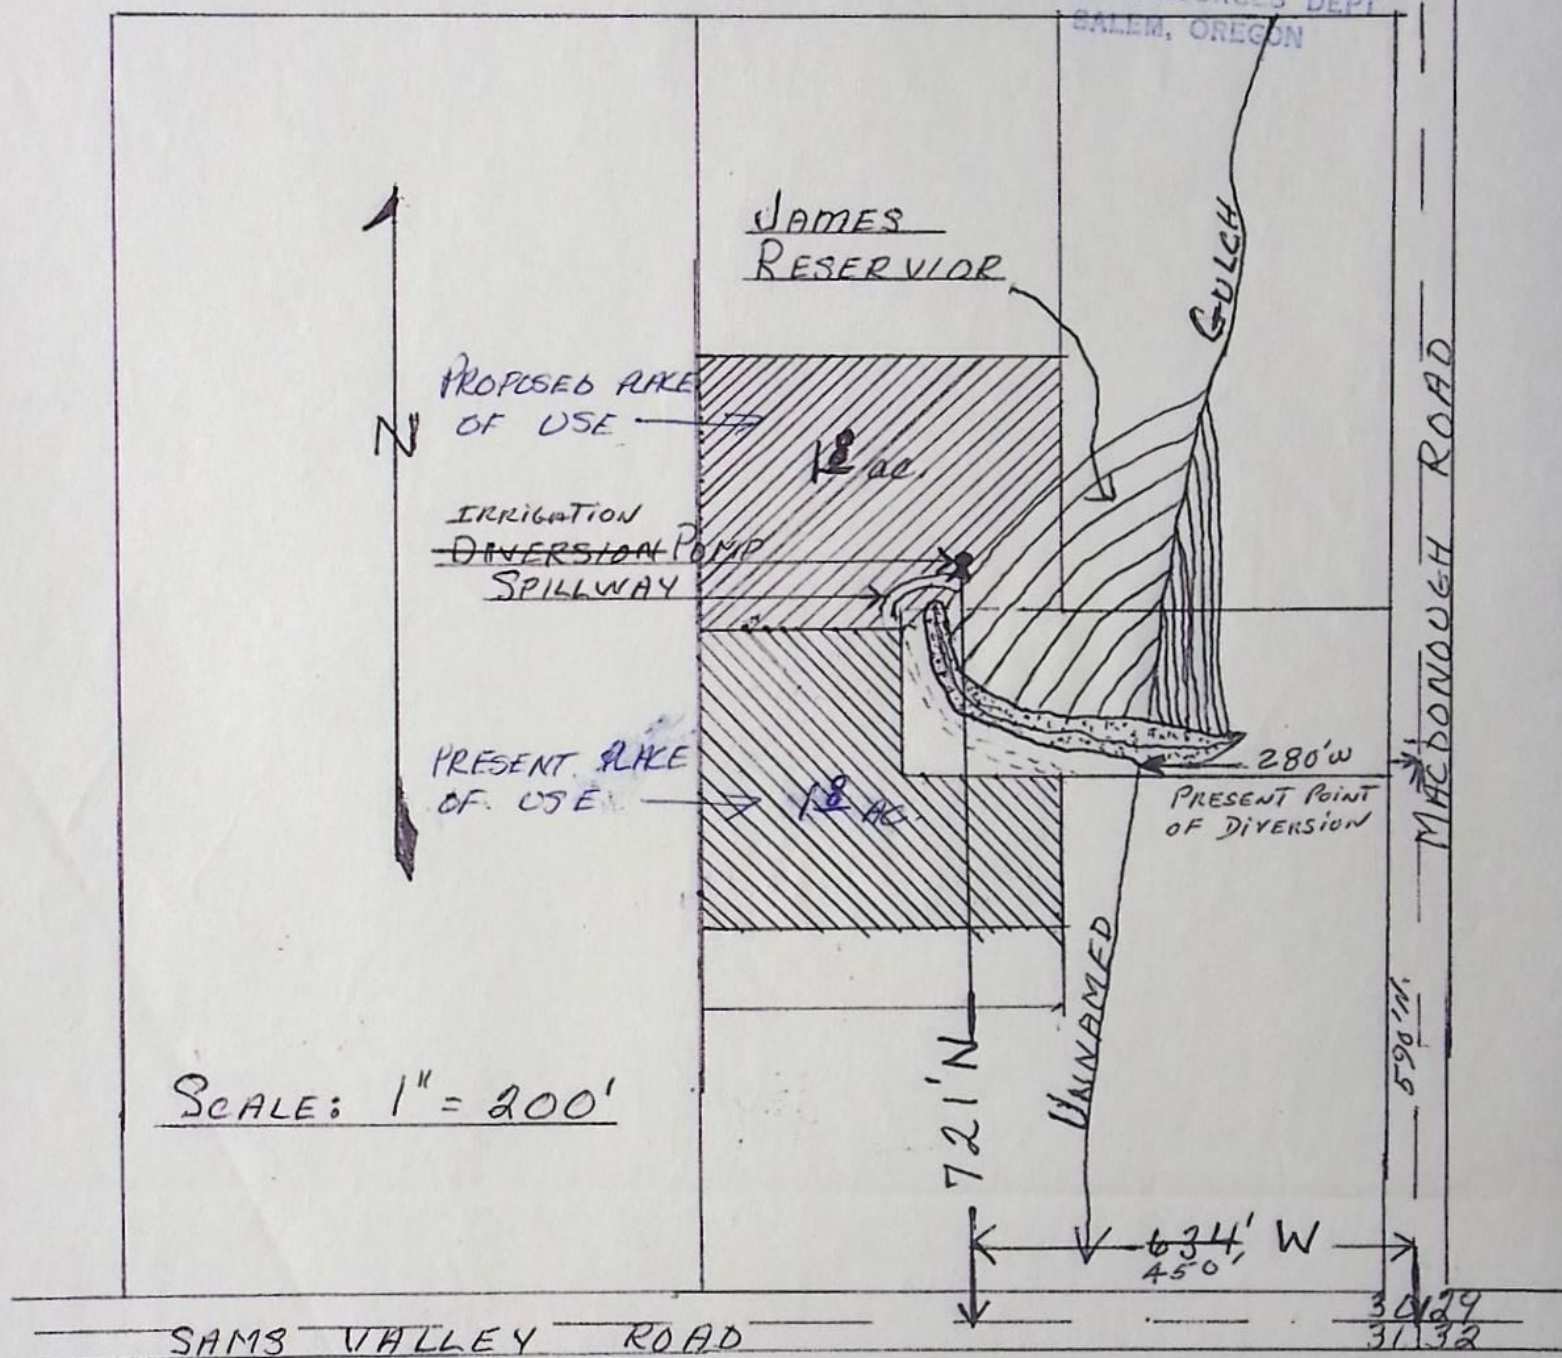

MAP TO COMPLETE APPLICATION OF JANET W. VIGIL
FOR CHANGE OF PLACE IN USE ON PER. # 25121

RECEIVED

AUG 7 - 1979

WATER RESOURCES DEPT
SALEM, OREGON

T-4272

Application for Transfer of Water Right

To the WATER RESOURCES DIRECTOR OF OREGON:

I, Janet W. Vigil
(Name of applicant)
of 4794 Sams Valley Road, Gold Hill,
(Mailing address) (City)
State of OREGON, 97525, 855-7523, do hereby make application for change
(Zip Code) (Phone number)
in place of use.
(In point of diversion; place of use; use heretofore made of the water)

1. Is the water right recorded in your name? No. Ralph A. James.
(If not, give name)

2. Was your water right determined by Decree of Court? No. If so, give title of proceedings
(Yes or No)
number of certificate

3. Was your water right acquired by Water Right Permit? Yes. If so, give number
(Yes or No)
of permit 25121 Number of certificate 29714.

A#31869

NOTE: If the entire right of record is not directly involved in the requested change, only that part of the right that is directly involved should be considered in answering the balance of the questions on this form.

4. The source of water is Unnamed Stream and Reservoir.

5. What is the date of priority of your water right? September 13, 1957.

6. The authorized point of diversion is located 590 ft. N. and 280 ft. W. from the SE
(N. or S.) (E. or W.)
corner of Sec. 30 being within the SE 1/4 SE 1/4 of Section 30 Tp. 35 S. R. 2 W. W. M.,
(No. N. or S.) (No. E. or W.)
in the county of Jackson. The name of the ditch used is pump.

NOTE: Answer question if the application is for change in point of diversion.

7. The proposed point of diversion is located _____ ft. _____ and _____ ft. _____ from the _____
(N. or S.) (E. or W.)
corner of _____ being within the _____ 1/4 _____ 1/4 of Section _____ Tp. _____ R. _____ W. M.,
(No. N. or S.) (No. E. or W.)
in the county of _____ The name of the ditch to be used is _____

8. The use to which the water is applied is irrigation.
(Irrigation, Mining, Power, Manufacturing, etc.)

Location of area irrigated, or place of use if other than irrigation:

Township North or South	Range E. or W. of Willamette Meridian	Section	List $\frac{1}{4}$ - $\frac{1}{4}$ of Section	Number Acres To Be Irrigated
35 S.	2 W.	30	SE $\frac{1}{4}$ SE $\frac{1}{4}$	1.8 acres

(If more space required, attach separate sheet)

9. Are you the legal owner of the above described lands? Yes.
(If not owner, explain your interest)

10. To your knowledge, has any portion of the water right above described undergone a period of five or more consecutive years of nonuse? No.
(Yes or No)

NOTE: Answer questions 11, 12 and 13 if application is for change in use or place of use.

11. Are the lands from which you propose to transfer your water right free of all encumbrances, including taxes, mortgages, liens, etc.? Yes.
(Answer Yes or No)

12. If not, give below a description of existing encumbrances:

NATURE OF ENCUMBRANCE	HELD BY	AMOUNT

13. The use to which the water is to be applied is irrigation.
(Irrigation, power, mining, manufacturing, domestic supplies, etc.)

Location of area to be irrigated, or place of use if other than irrigation:

Township North or South	Range E. or W. of Willamette Meridian	Section	List $\frac{1}{4}$ - $\frac{1}{4}$ of Section	Number Acres To Be Irrigated
35 S.	2 W.	30	SE $\frac{1}{4}$ SE $\frac{1}{4}$	1.8 acres

(If more space required, attach separate sheet)

14. Reasons for the proposed changes areto better facilitate the use of water.

15. Construction work will be completed on or beforeOctober 1, 1980.

16. The water will be completely applied to the proposed use on or beforeOctober 1, 1981.

Remarks

NOTE: THIS APPLICATION MUST BE ACCOMPANIED BY A MAP OR MAPS SHOWING THE BEFORE AND AFTER LOCATIONS OF THE POINT OF DIVERSION AND/OR PLACE OF USE, AS THE CASE MAY BE.

AFFIDAVIT OF APPLICANT

I, Janet W. Vigil, the applicant herein, being first duly sworn, depose and say that I have read the above and foregoing application for transfer of water right; that I know the contents thereof and that the statements therein made are true and correct to the best of my knowledge and belief.

In Witness Whereof, I have hereunto set my hand this 23 day of July, 1979.

Janet W. Vigil
(Name of applicant)

Subscribed and sworn to before me this 23 day of July, 1979.

[Notarial Seal]

John F. Cummins
NOTARY PUBLIC FOR OREGON

My commission expires 21 January 1980



ACCOUNT NUMBER

RECORD OF DESCRIPTIONS OF
OFFICE OF COUNTY ASSESSOR, JACKSON CO

JACKSON CO

b-3

IBER

352W30D 00502 00603

SECTION 30D

TOWNSHIP 35 S

RANGE 2W

W.M.

MAP NO. 352W30D

L PHOTO

502

TAX LOT NUMBER

LOT

BLOCK

NO.

NO.

ADDITION

CITY

INDENT EACH NEW
COURSE TO THIS LINE

LEGAL DESCRIPTION

DEED RECORD

ACRES

YEAR

VOLUME

PAGE

REMAINING

P.A.K.M.

James, R A % Raymond & Mary Lou Rich (C)

Com at the SE cor of Sec 30 in T 35S, R 2W of the
WM, JCO;

thence N, alg the E li of sd Sec 305';

thence W 363.5' to the true pob;

thence cont W 365.725' to a pt S of the SE cor of
tract desc in Vol 125 P 518 of the DR of JCO;thence N, to & alg the E li of sd tract & its ext,
651.5';thence E 365.725' to the NW cor of tract desc in Vol
596 Deeds P 156;

thence S 241' to the SW cor thereof;

thence W 166.5';

thence S 169.5';

thence E 166.5' to the NW cor of tract desc in Inst
68-01350 of the O.R. of JCO;thence S 241' to the true pob. Less prop desc in
O.R. 66-03153 JCO & Vol 447 P 335 JCO.

1951 Part of
354 404
1969 Being part of
C#-5095
JV 70-02452

T-4272

Rich, Raymond & Mary Lou
(inst in 352W30D-400)

Part of
O.R. 75-04013
JV 75-02444

Hansen, Douglas J & Sara K
(inst in 352W30D-400)

Part of
O.R. 75-13178
JV 76-00991

Goulette, Gary Michael & Mary Lynne
(inst in 352W30D-400)(1-15842-5)

Part of
O.R. 78-12475
JV 78-08568

Vigil, Janet W

Part of
O.R. 79-13276
J.V. 79-08697


RECEIVED

AUG - 1979

WATER RESOURCES DEPT
SALEM, OREGON

T-7272

SE 1/4 of SE 1/4 of Section 30, T. 35 S., R. 2 W., W.M.

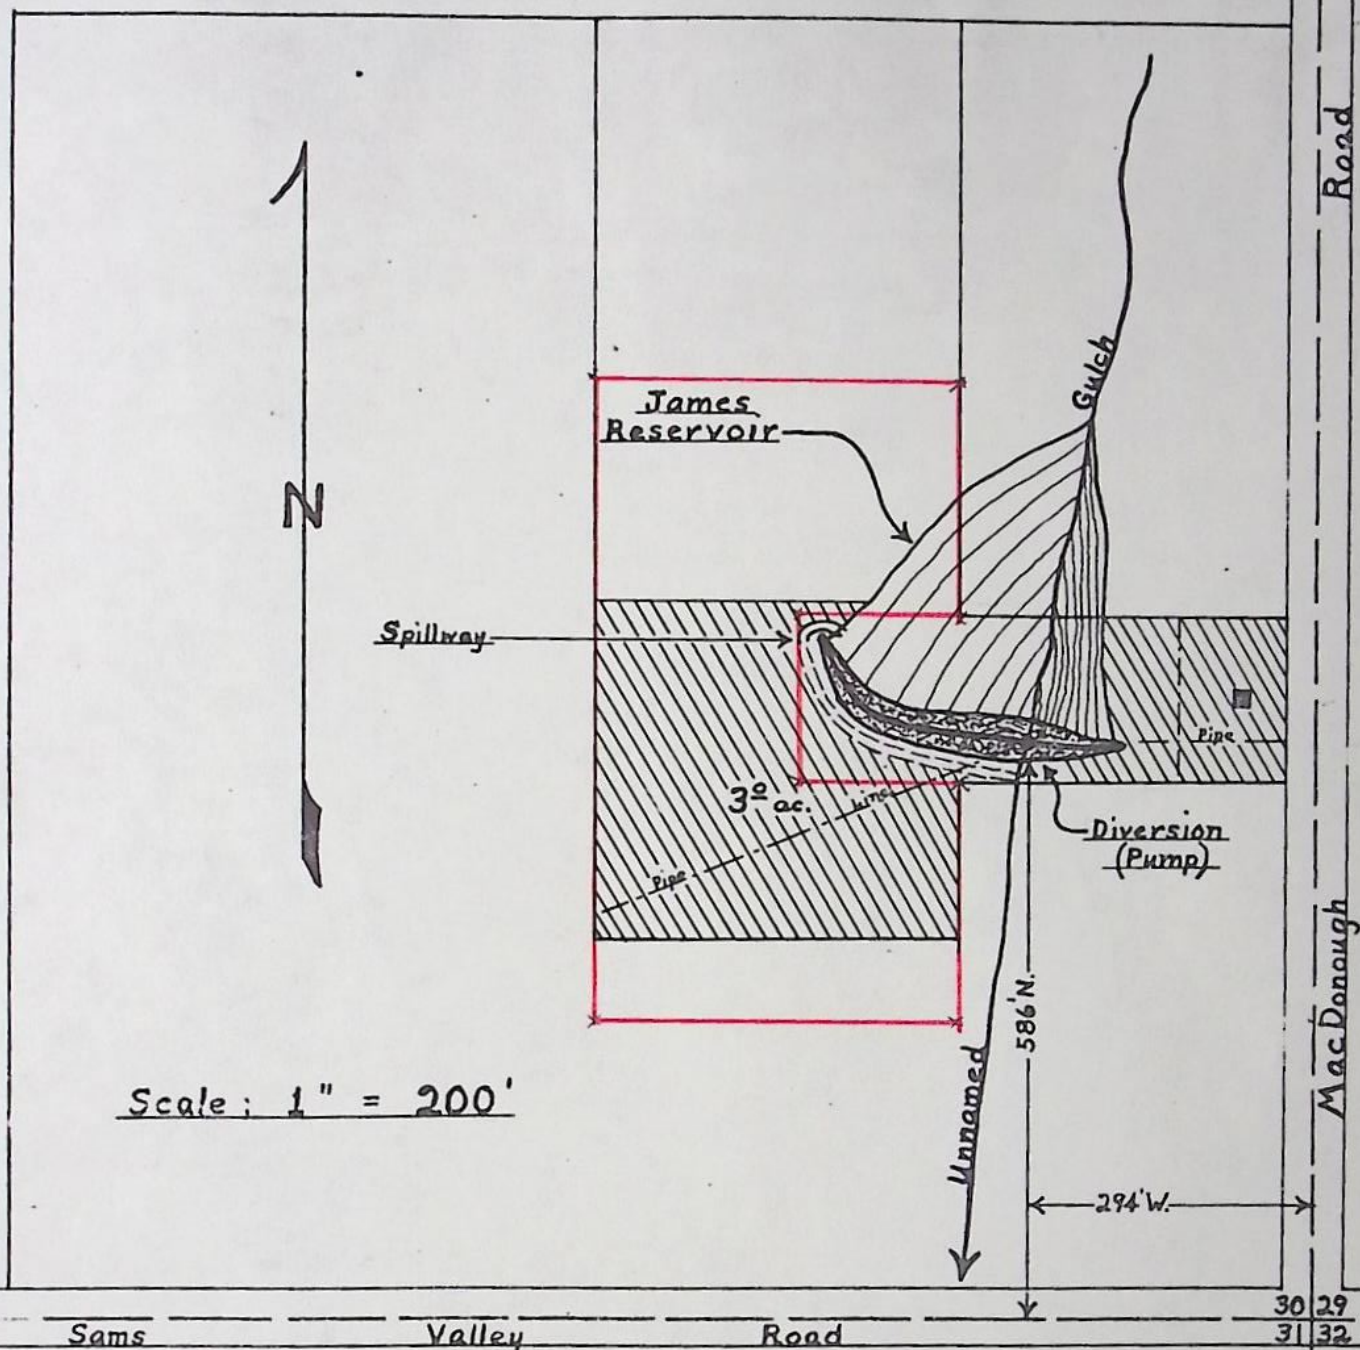

Application No. R-31868 f 31868 31869

Ralph James Permit No. R-2072 f 25121

This Office --- 9-11-57 --- David C. Hendrix, Watermaster.

RECEIVED
SEPT 11 1957
STATE ENGINEER
PORTLAND, OREGON



Water Resources Department

MILL CREEK OFFICE PARK

555 13th STREET N.E., SALEM, OREGON 97310

PHONE 378-3066

August 10, 1979

Janet W. Vigil
4794 Sams Valley Road
Gold Hill, Oregon 97525

RE: File No. T-4272

Dear Ms. Vigil:

Your water right transfer application for approval of a change in place of use of water from an unnamed stream and reservoir, together with supporting data and payment of fees in the amount of \$30, was received on August 7, 1979. Our receipt No. 13305 is enclosed.

When examination of the application and supporting data has been completed, you will be advised of any matters requiring your further attention prior to consideration of the application for approval.

Please refer any correspondence to file No. T-4272.

Sincerely,

Samuel R. Allison
Supervisor
Transfer Section

SRA:lcj
cc: David C. Hendrix, Watermaster