



CLAIM OF BENEFICIAL USE Site Report

E-RECEIVED
SEP 15, 2025
OWRD

Good
Transfer Number: T - 14365 District Internal Notice #: 2023-41

User Name: Dry Fly Trust - Marco + Mallory Ugas

Place of Use: 20470 Swalley Rd

USE	POD #	TWP	RNG	SEC	QQ	DLC	GOV'T LOT	TAX LOT	ACRES
IRR	3415	16	12	21	NW/NW			00203	.95

District Conveyance System:

Description of Delivery System: Main Canal and into hg 4-1470

Headgate: 01-1470

Canal: Main

Beneficial Use:

Description of Beneficial Use: Landscape, pastures and hay

Method Used to Apply Water: Pumped from a pond and into a mainline and laterals

Method Used to Calculate Beneficial Use: on site visit

User Interviewed: () Yes (X) No

Beneficial Use Made as Authorized: (X) Yes () No

Description of Beneficial Use if Less than Authorized:

Inspected By:

Karl Parker

Date:



11/25/2024

Instructions: Attach and label the corresponding final proof map.

Swalley Irrigation District

2023 District Transfer T-14365 Claim of Beneficial Use Map

Certificates: 74145
for Mallory Ugas

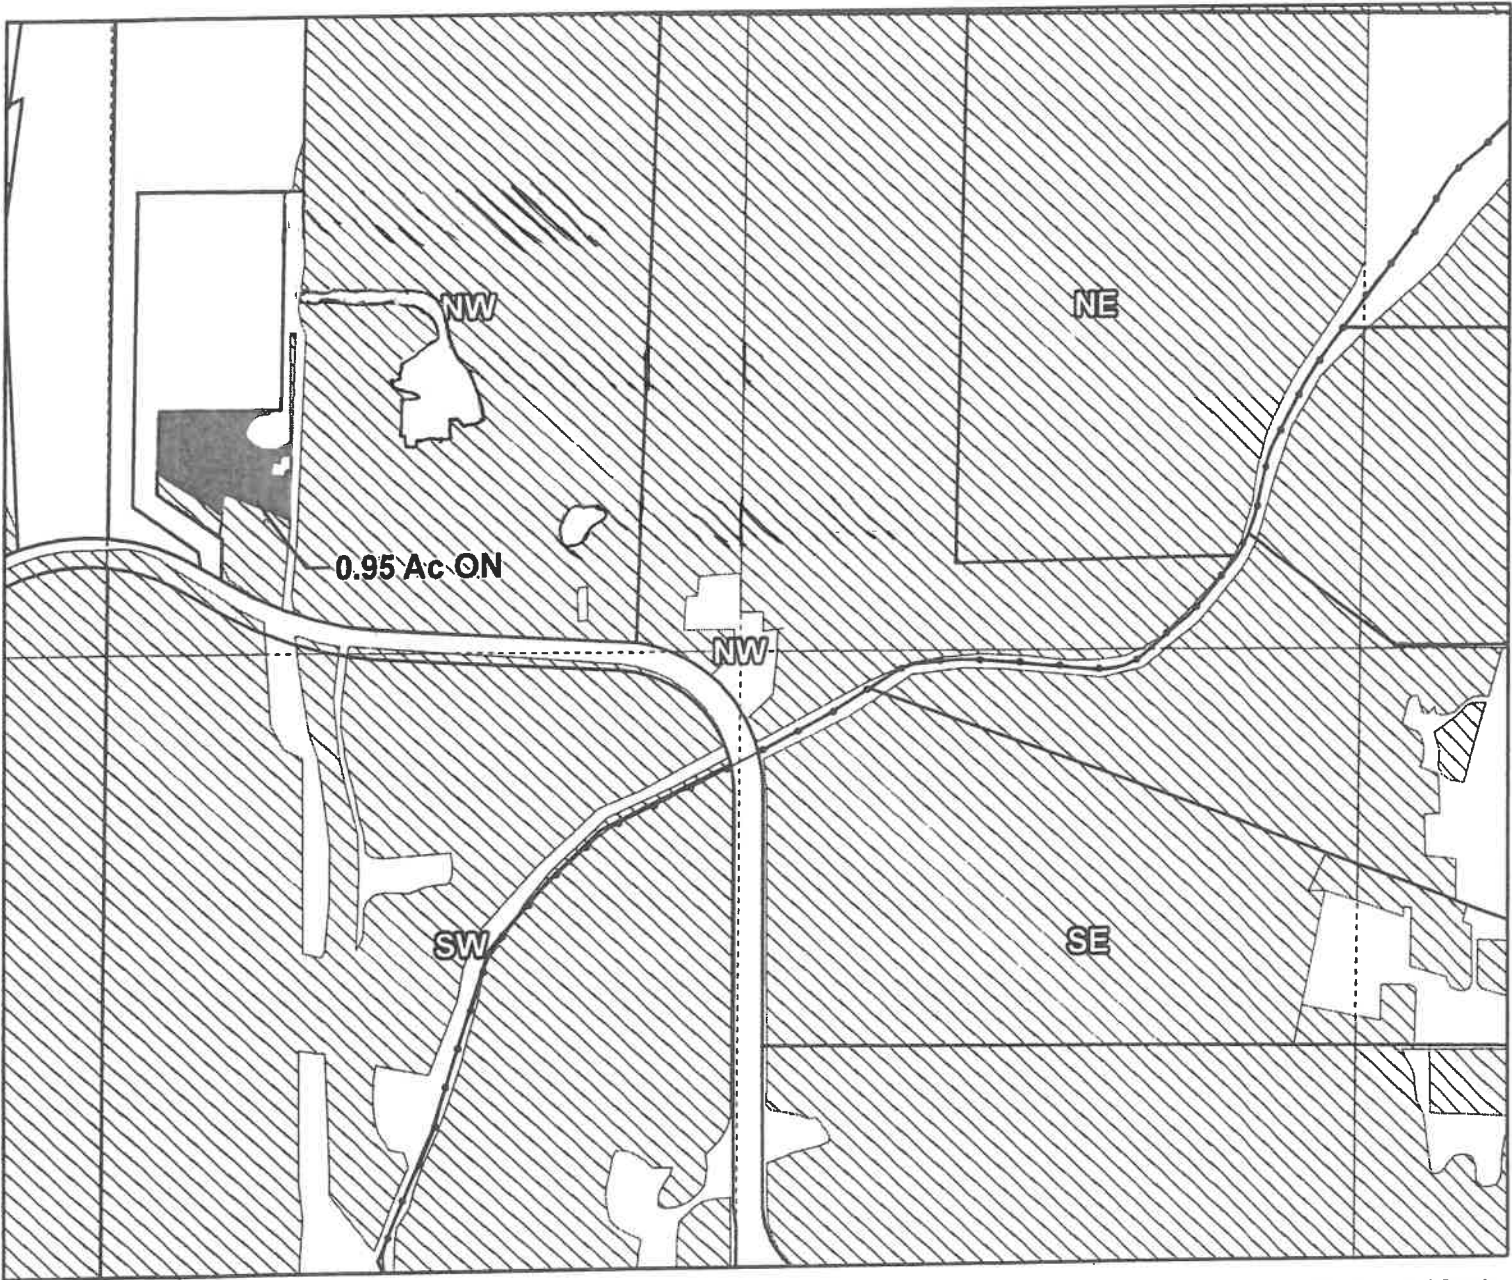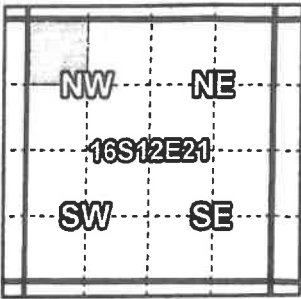

Taxlot 1612210000203, 16-12-21-NW/NW-00203: 0.95 Acres On, 23.95 Acres Total
Taxlot 1612210000203, 16-12-21-NW/NW-00203: 0.95 Acres Off, 23.00 Acres Remaining

- Pipelines and Canals
- Transfer - ON
- Transfer - OFF
- Primary Water Right
- Taxlots



1 inch = 400 feet