


RIDGEVIEW IRRIGATION DISTRICT

Final Proof Map For Robert d Maria Holman Certificate 81012

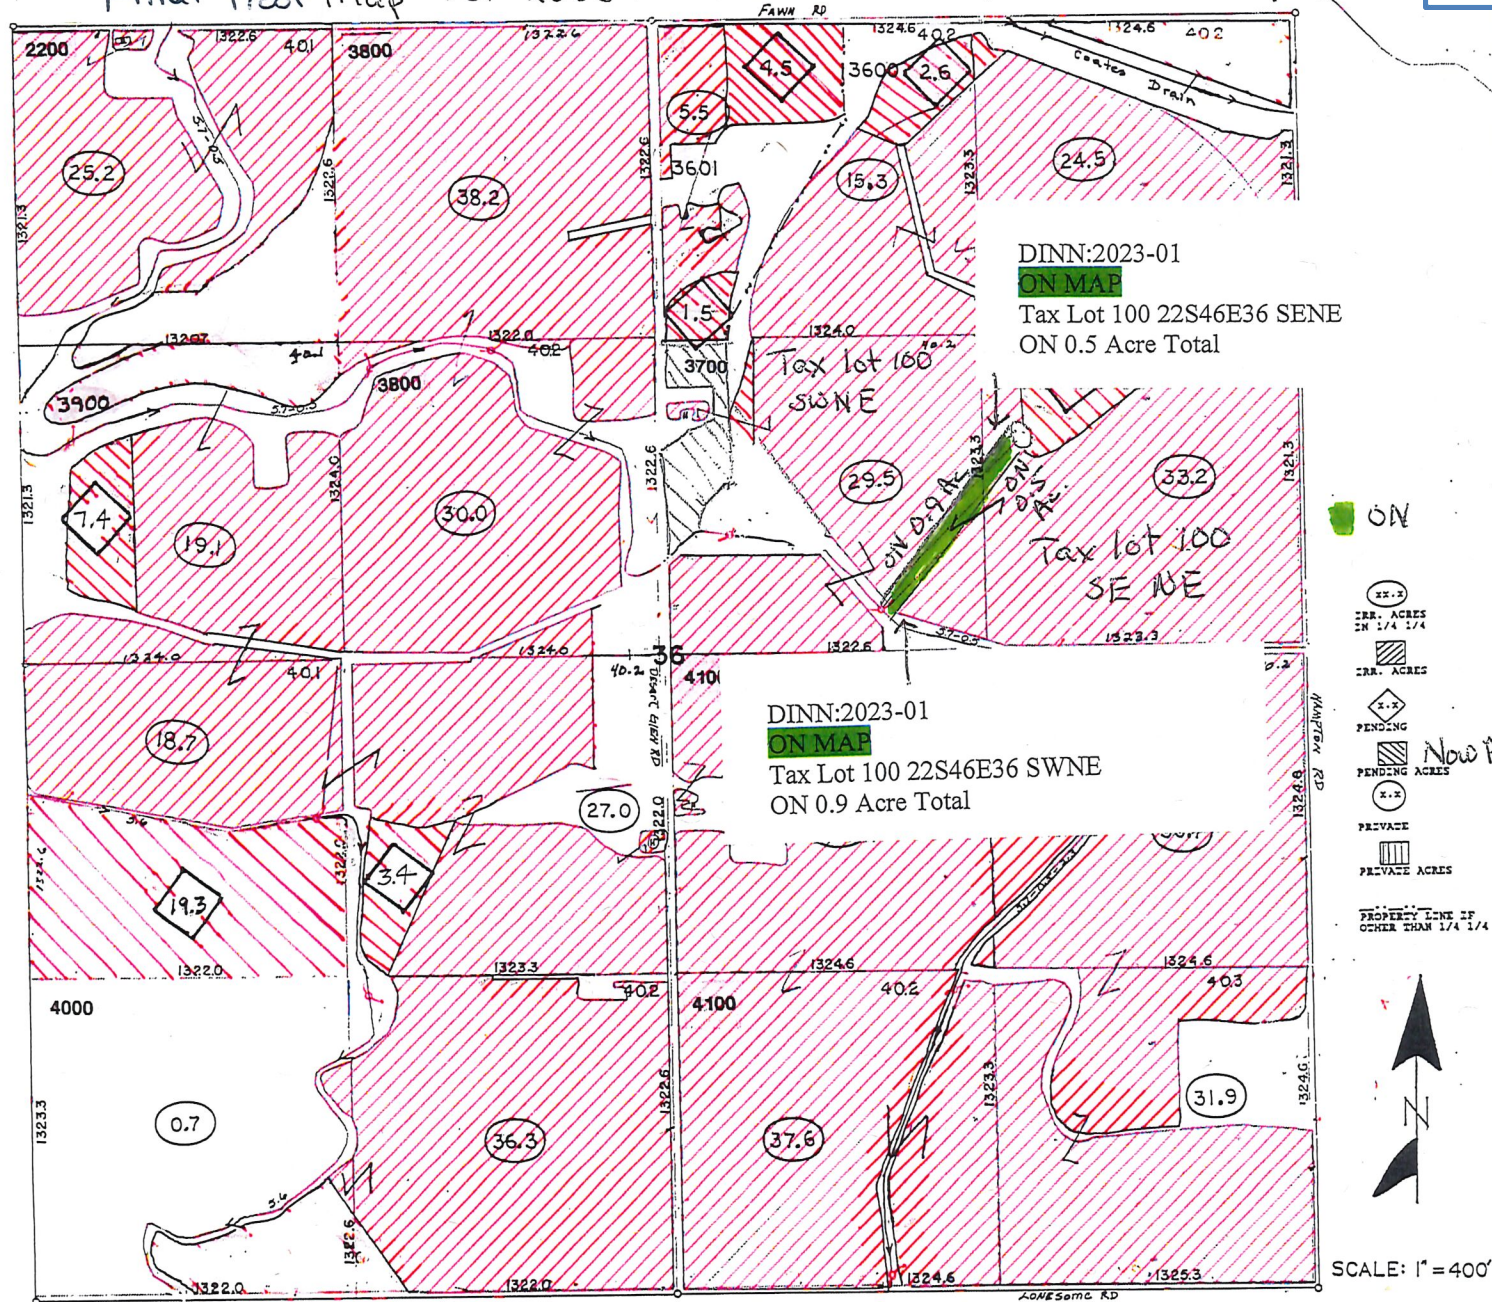


SEC. 36, T:22 S., R.46 E., W.M.

48-102-1572

Traced: R.E. 6-13-55
Checked: H.G. 6-21-55

1/13/2023
edh
mH

Final Proof Map ^{T 12833} For James Thomas Certificate # 81012
02-4

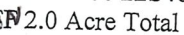

- PROPERTY OF
OTHER THAN

Now Approved
ACRES Inc.



SCALE: 1" = 400'


SEC. 26, T.22 S., R. 46 E., W.M. 48-102-1548

Traced: R.W.R. 4-24-53
Checked: R.F. 6-20-55

RIDGEVIEW IRRIGATION DISTRICT

Final Proof

Map For James Hayhurst Certificate #81012

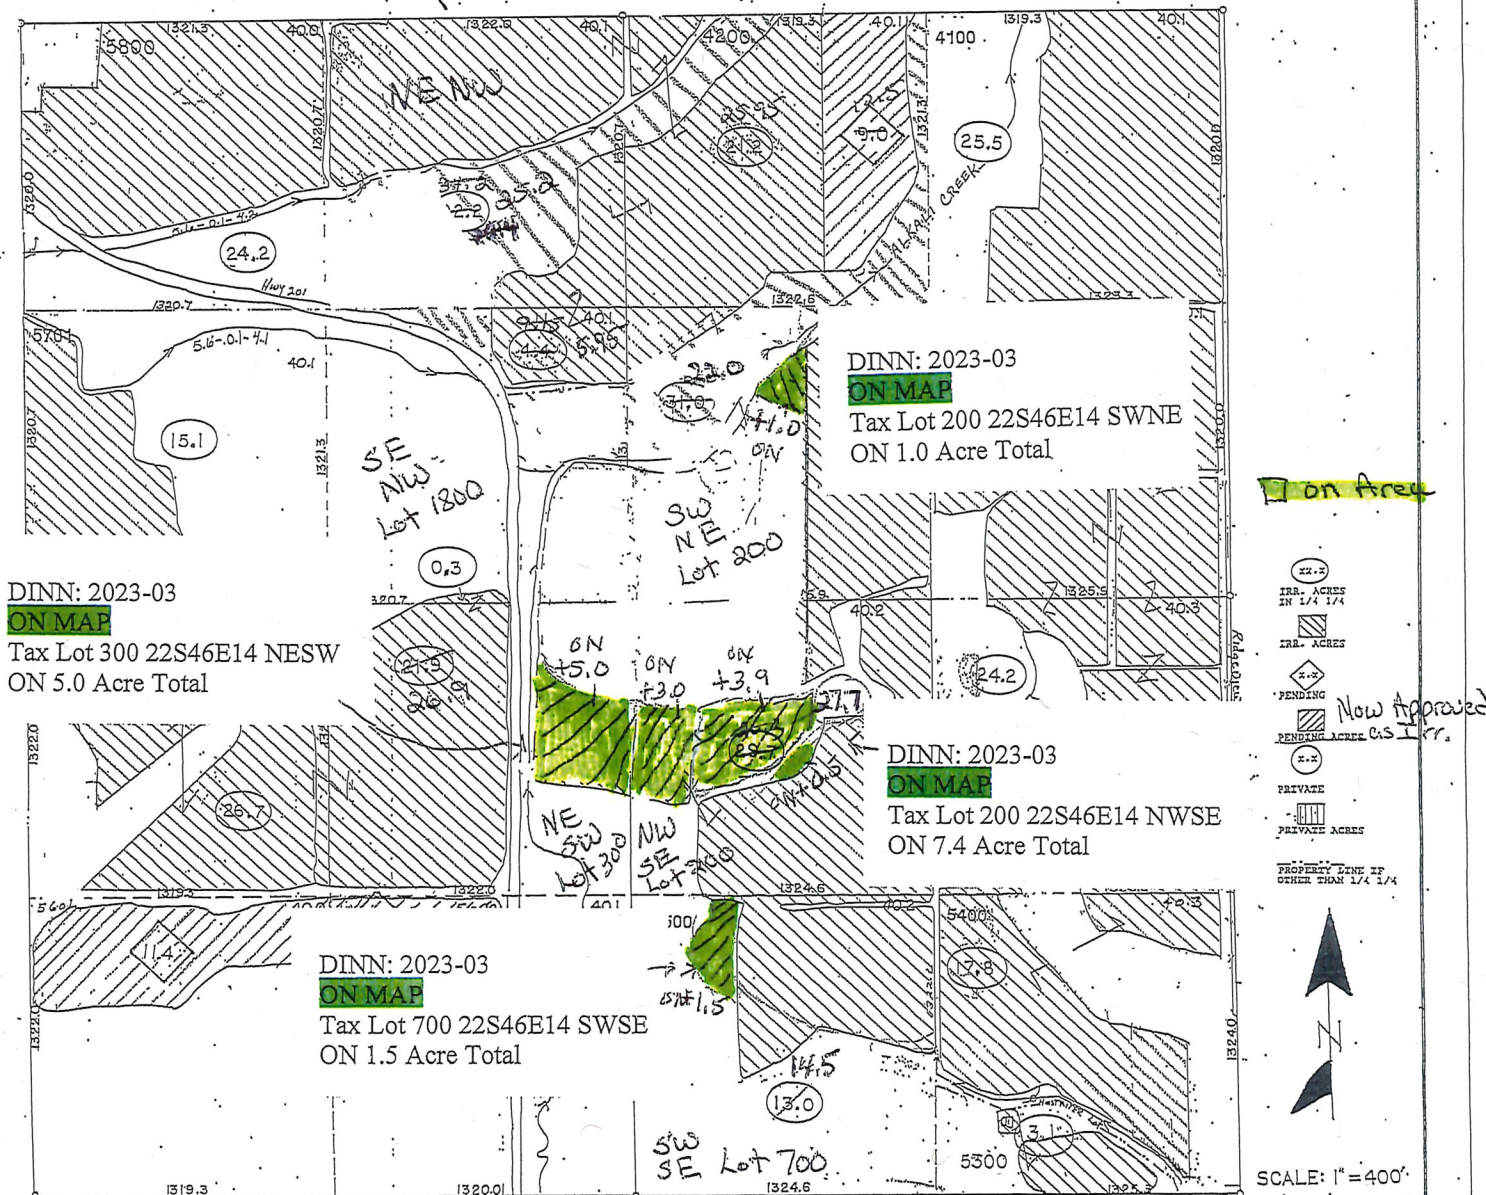


SEC. 14, T.22 S., R.46 E., W.M. 48-102-1562

Traced: R.W.R. 4-20-53
Checked: R.E. 6-20-55

RIDGEVIEW IRRIGATION DISTRICT.

Final Proof

Map for James Hayhurst Certificate # 81012

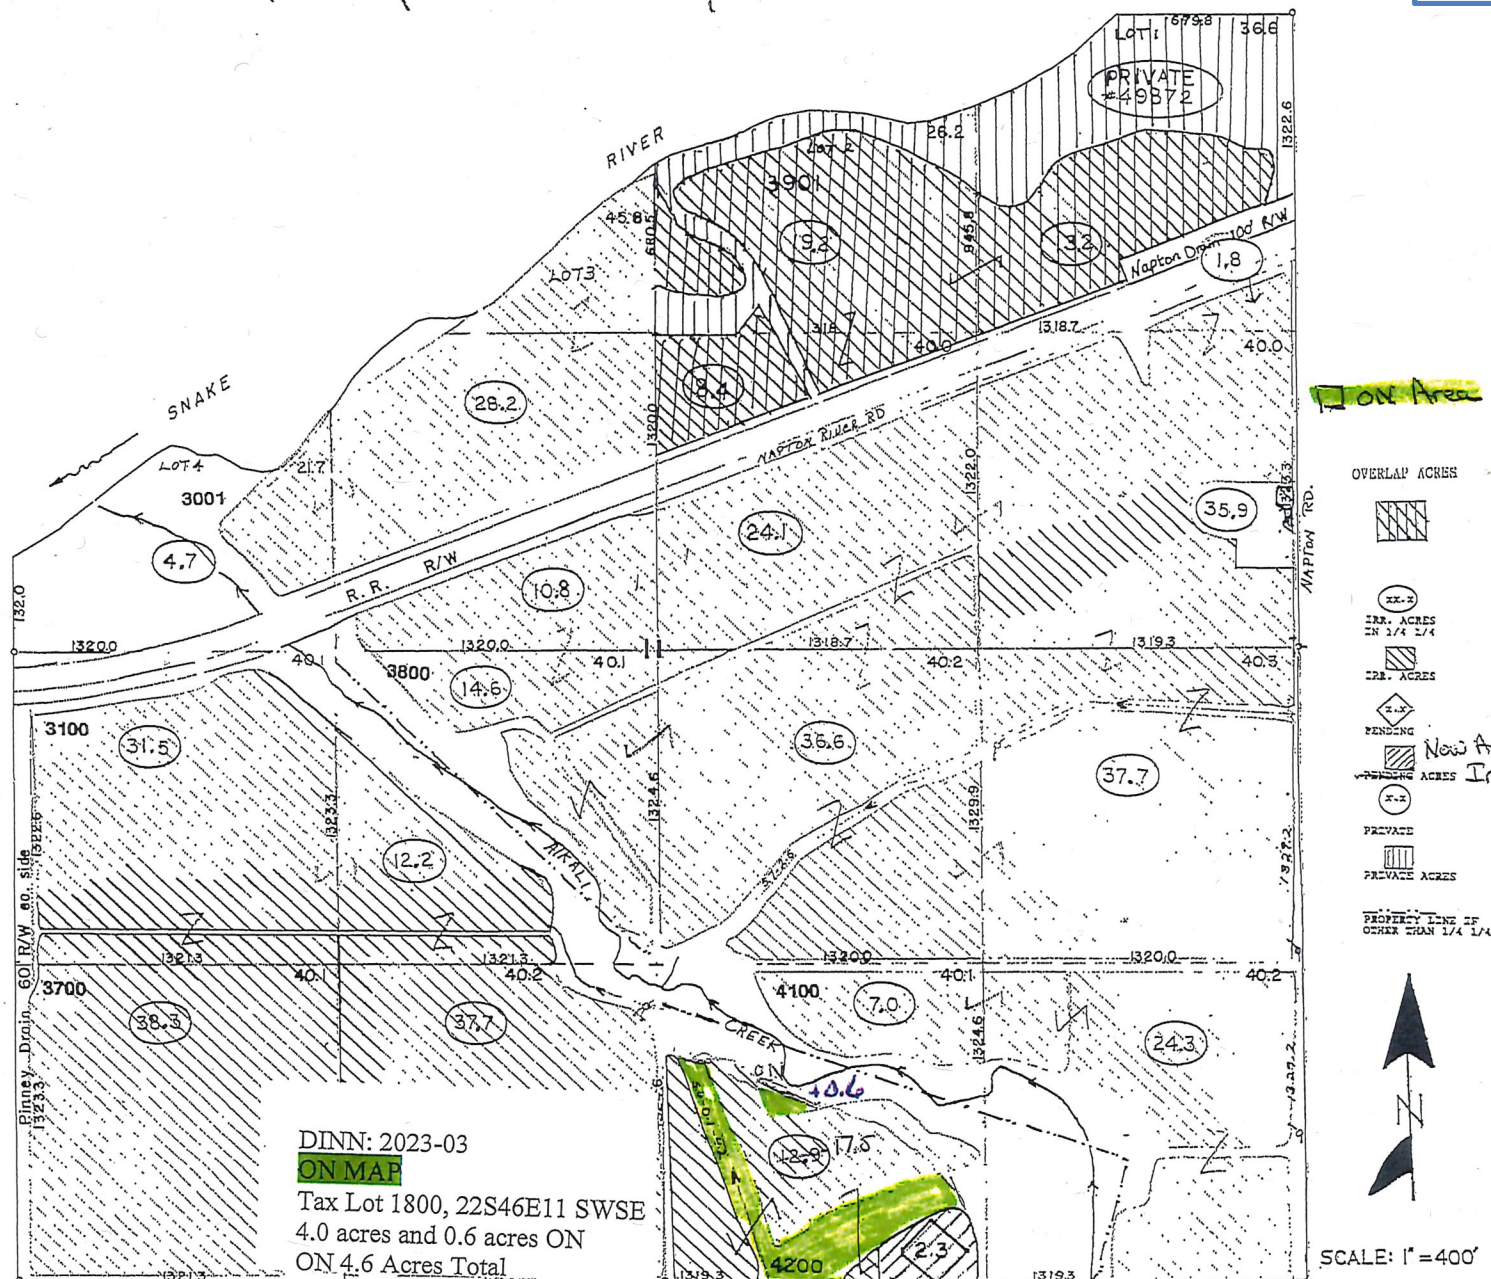

SOUTHWEST CORNER
OF SECTION 11

SEC. 11, T.22 S., R.46 E., W.M.


Traced: R.W.R. 4-16-53
Checked: R.F. 6-20-55