

**CROOK COUNTY
SEC.14 T15S R14E**


**E-RECEIVED
SEP 22, 2025
OWRD**

SCALE - 1" = 400'



SE 1/4 OF THE NE 1/4

OWRD#: T-14583

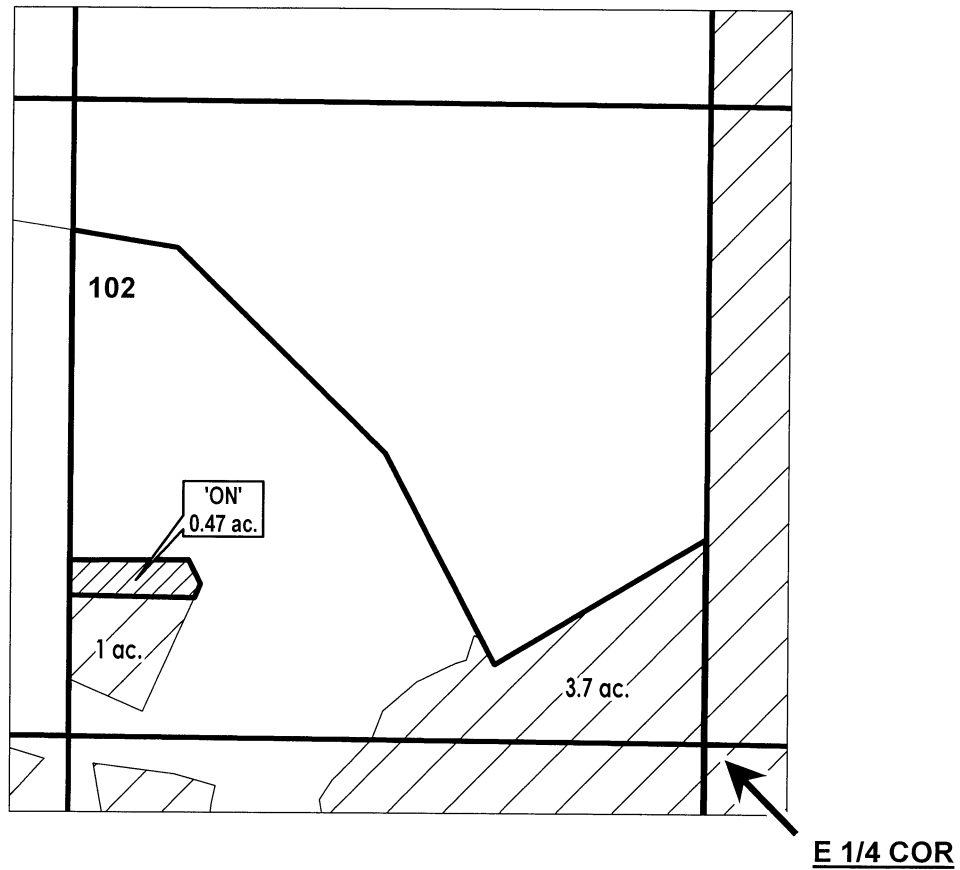

 ON LANDS
 EXISTING WATER RIGHTS



FINAL PROOF MAP

NAME: Walker Living Trust

TAXLOT #: 102

0.47 ACRES

DATE: 9/15/2025

DESCHUTES COUNTY SEC.12 T18S R13E



E-RECEIVED
SEP 22, 2025
OWRD

SCALE - 1" = 400'



SW 1/4 OF THE SE 1/4

OWRD#: T-14583

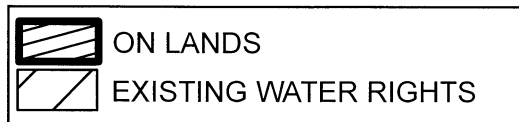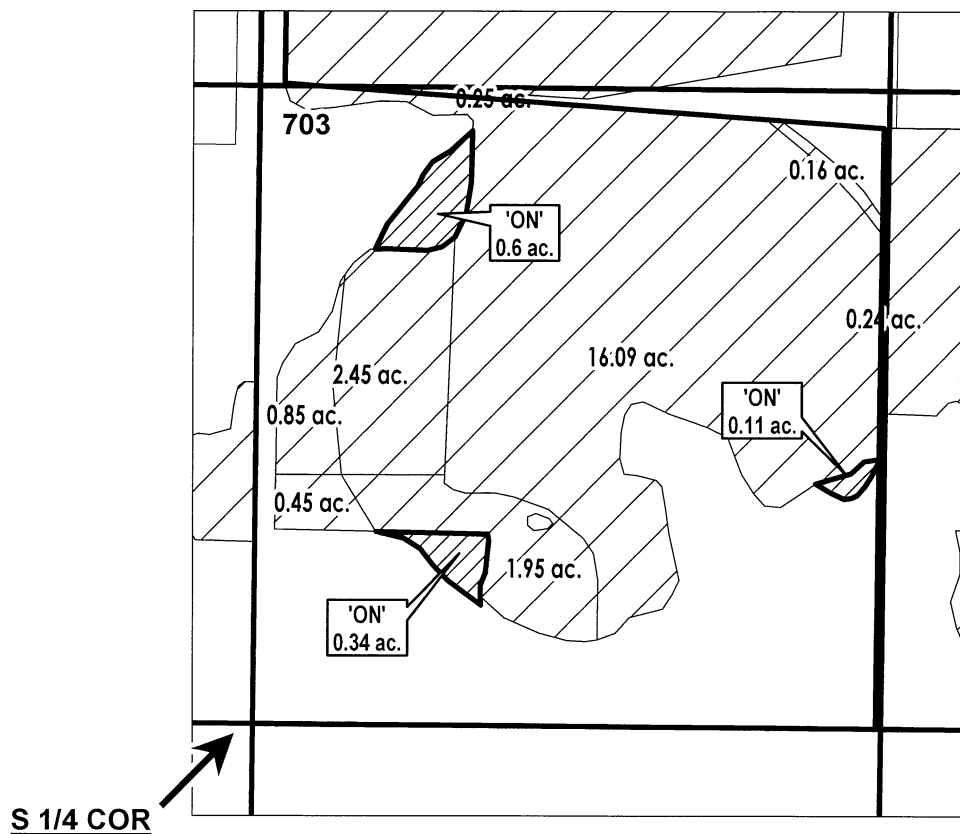

FINAL PROOF MAP

NAME: King Family Trust

TAXLOT #: 703

1.05 ACRES

DATE: 9/15/2025

DESCHUTES COUNTY SEC.12 T16S R12E



E-RECEIVED
SEP 22, 2025
OWRD

SCALE - 1" = 400'



SW 1/4 OF THE SW 1/4

OWRD#: T-14583

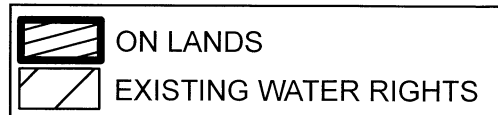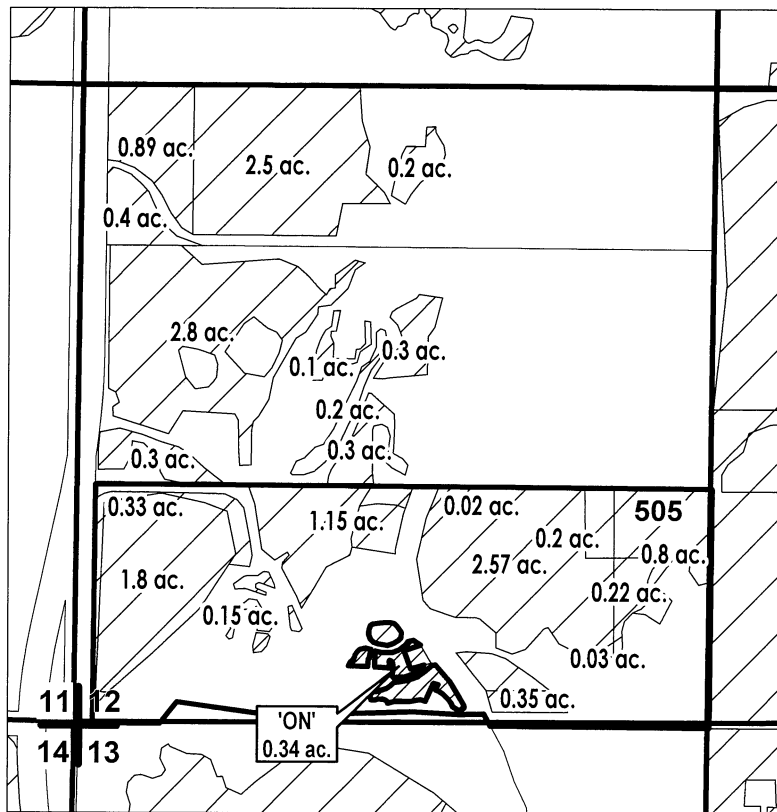

FINAL PROOF MAP

NAME: Hayden, Richard/ Lori

TAXLOT #: 505

0.34 ACRES

DATE: 9/15/2025

**CROOK COUNTY
SEC.15 T15S R14E**


E-RECEIVED
SEP 22, 2025
OWRD

SCALE - 1" = 400'



SW 1/4 OF THE SE 1/4

OWRD#: T-14583

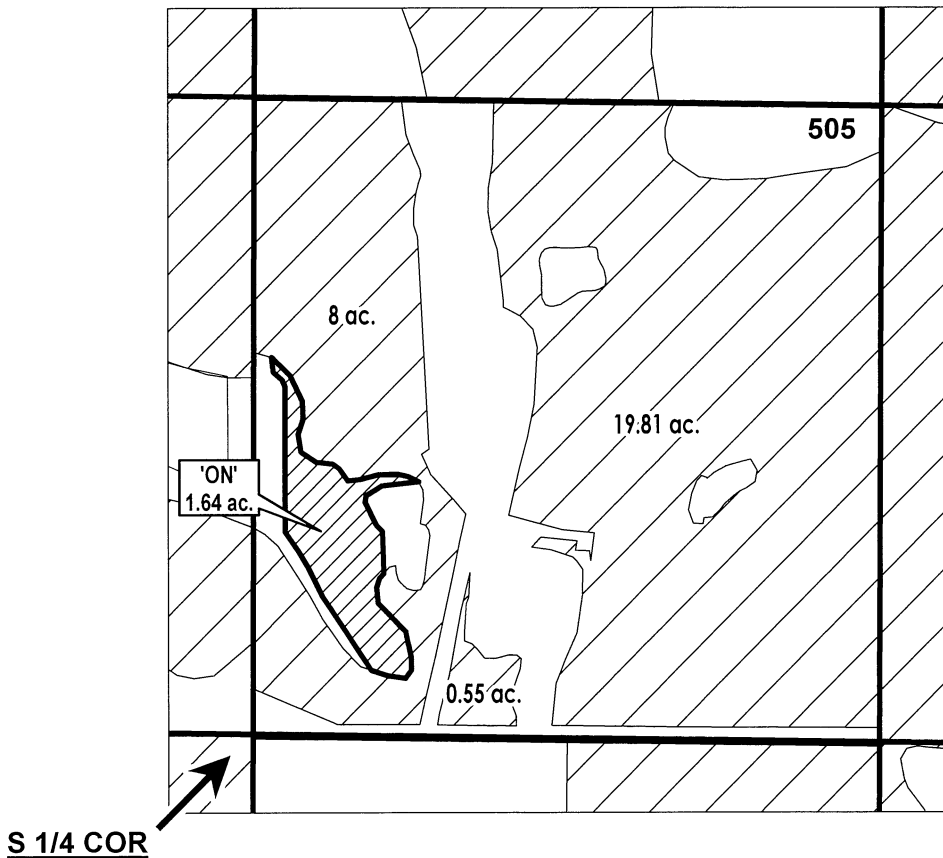

 ON LANDS
 EXISTING WATER RIGHTS



FINAL PROOF MAP

NAME: Scott Posey/ Valerie Russell

TAXLOT #: 701

1.64 ACRES

DATE: 9/15/2025

DESCHUTES COUNTY SEC.05 T14S R13E



E-RECEIVED
SEP 22, 2025
OWRD

SCALE - 1" = 400'



SW 1/4 OF THE NW 1/4

OWRD#: T-14583

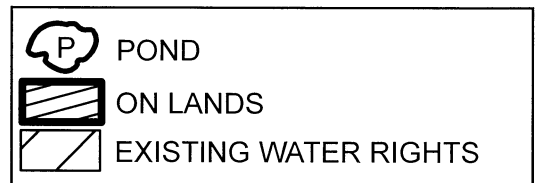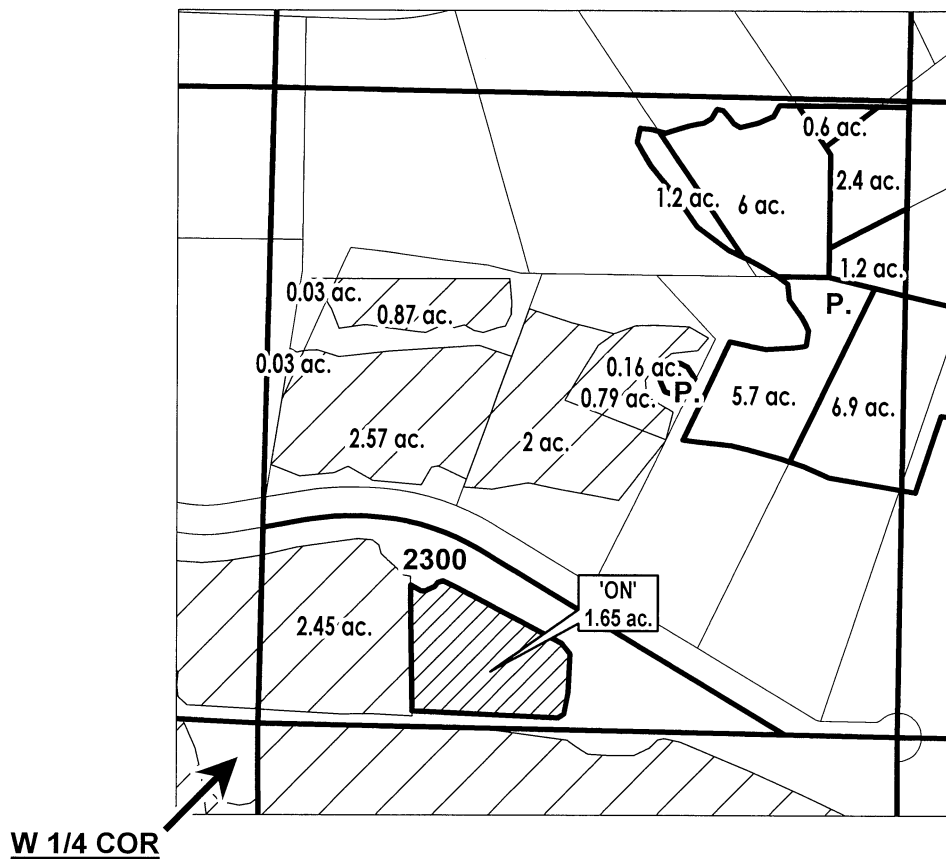

FINAL PROOF MAP

NAME: Michael Peters/ Stephanie Aldrich

TAXLOT #: 2300

1.65 ACRES

DATE: 9/15/2025

DESCHUTES COUNTY SEC.11 T16S R12E



E-RECEIVED
SEP 22, 2025
OWRD

SCALE - 1" = 400'



NE 1/4 OF THE NE 1/4

OWRD#: T-14583

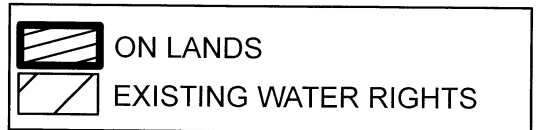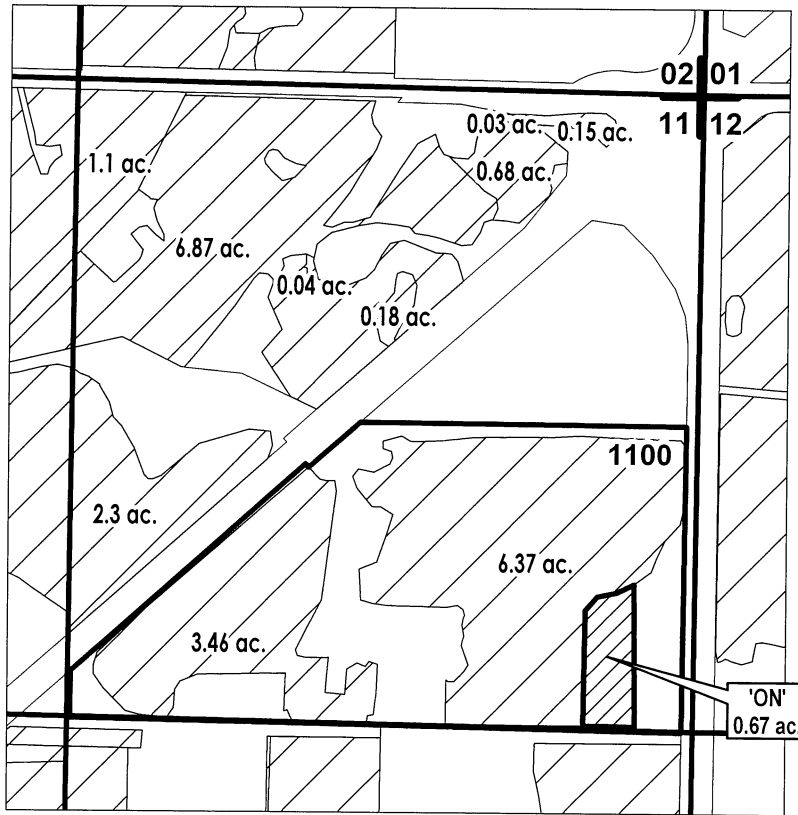

FINAL PROOF MAP

NAME: Delance, Joseph/ Rachel

TAXLOT #: 1100

0.67 ACRES

DATE: 9/15/2025

**DESCHUTES COUNTY
SEC.04 T18S R13E**


E-RECEIVED
SEP 22, 2025
OWRD

SCALE - 1" = 400'



NE 1/4 OF THE NE 1/4

OWRD#: T-14583

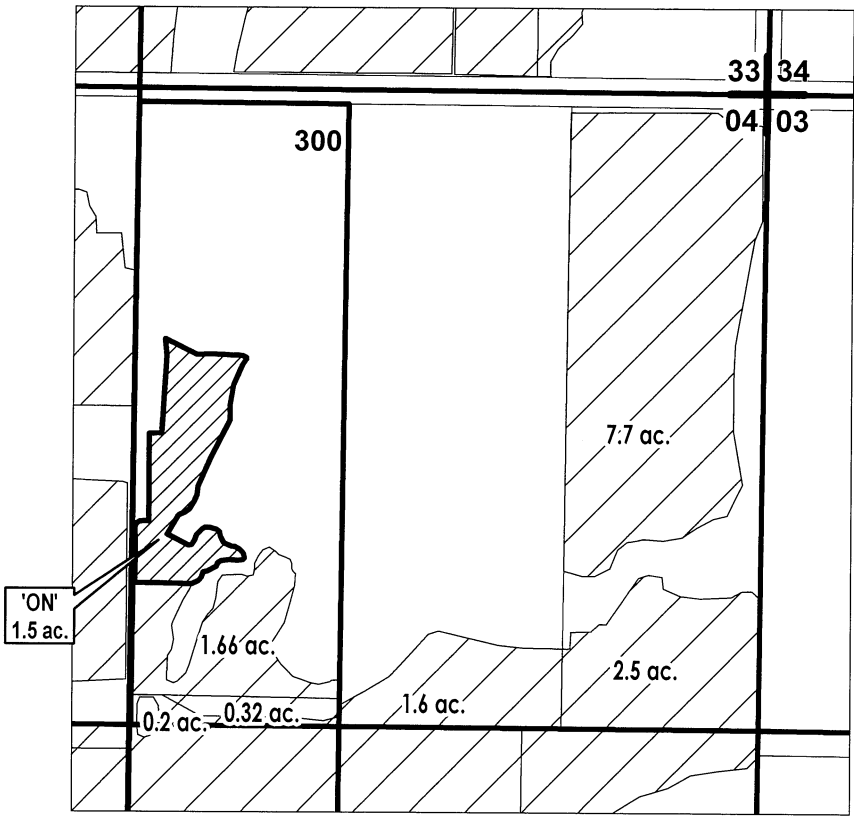

FINAL PROOF MAP

NAME: Obradovich, Nicholas/ Migliorini, Robyn

TAXLOT #: 300

1.5 ACRES

DATE: 9/15/2025

DESCHUTES COUNTY SEC.31 T14S R13E


E-RECEIVED
SEP 22, 2025
OWRD

SCALE - 1" = 400'



SW 1/4 OF THE NE 1/4

OWRD#: T-14583

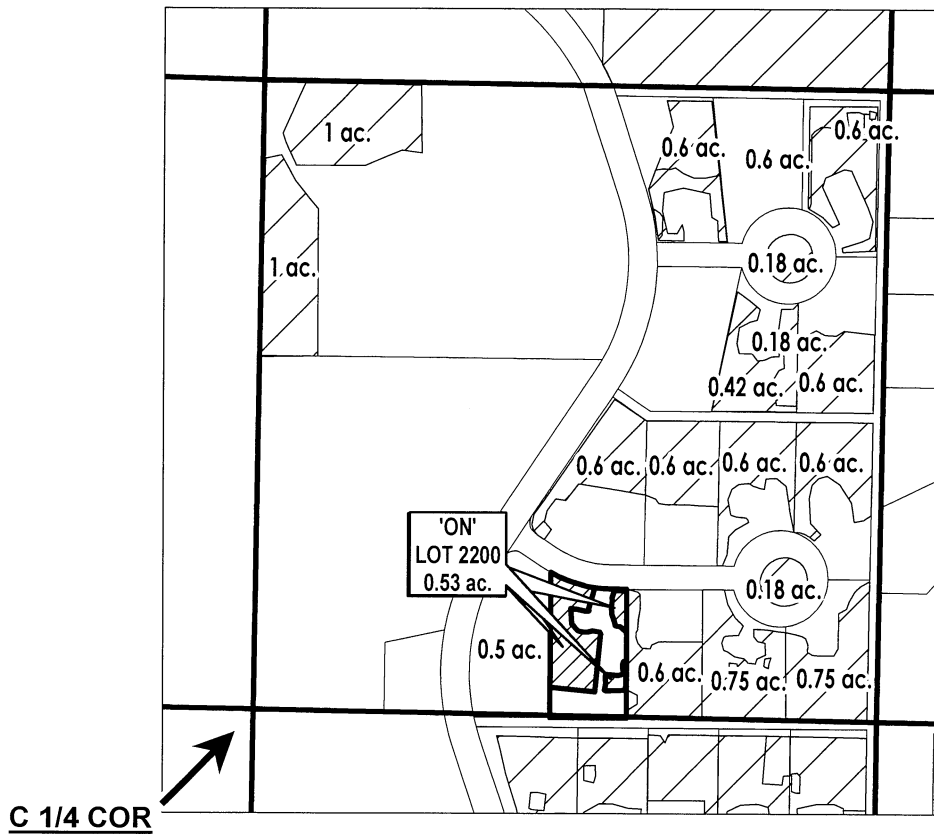

# ac.	PARCELS W/ WATER RIGHTS
	ON LANDS
	EXISTING WATER RIGHTS



FINAL PROOF MAP

NAME: Piland, Marden

TAXLOT #: 2200

0.53 ACRES

DATE: 9/15/2025

DESCHUTES COUNTY SEC.25 T15S R12E


E-RECEIVED
SEP 22, 2025
OWRD

SCALE - 1" = 400'



SW 1/4 OF THE SE 1/4

OWRD#: T-14583

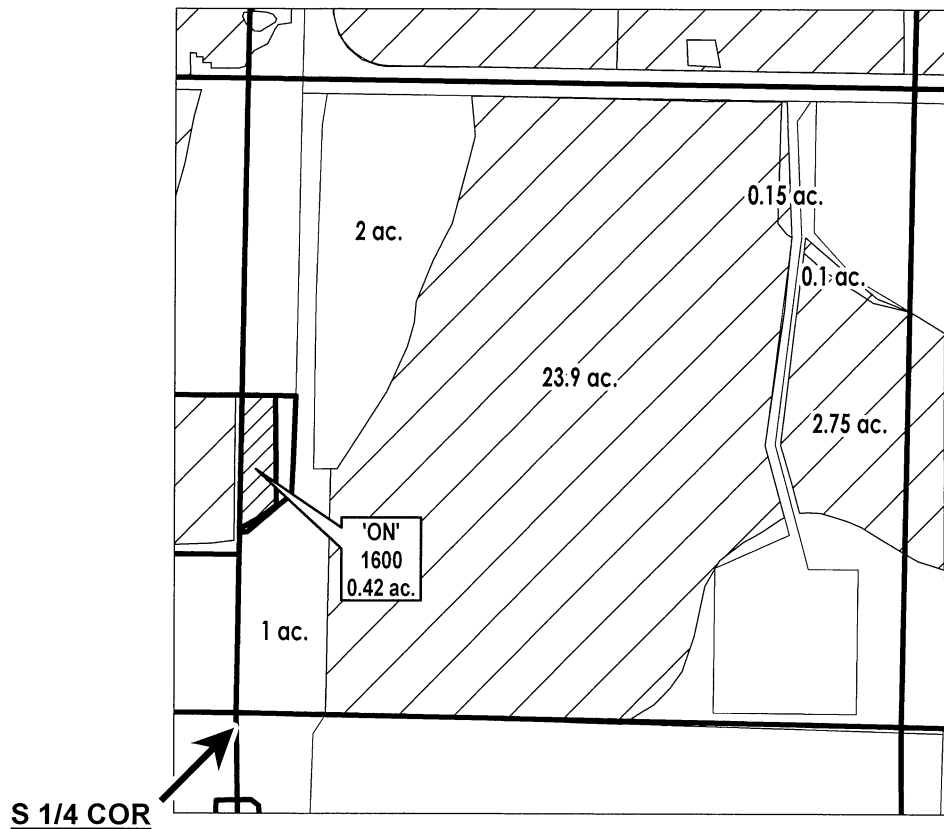

# ac.	PARCELS W/ WATER RIGHTS
	ON LANDS
	EXISTING WATER RIGHTS



FINAL PROOF MAP

NAME: Morton, Mark

TAXLOT #: 1600

0.42 ACRES

DATE: 9/15/2025

DESCHUTES COUNTY SEC.02 T18S R13E


E-RECEIVED
SEP 22, 2025
OWRD


SCALE - 1" = 400'



NE 1/4 OF THE SW 1/4

OWRD#: T-14583

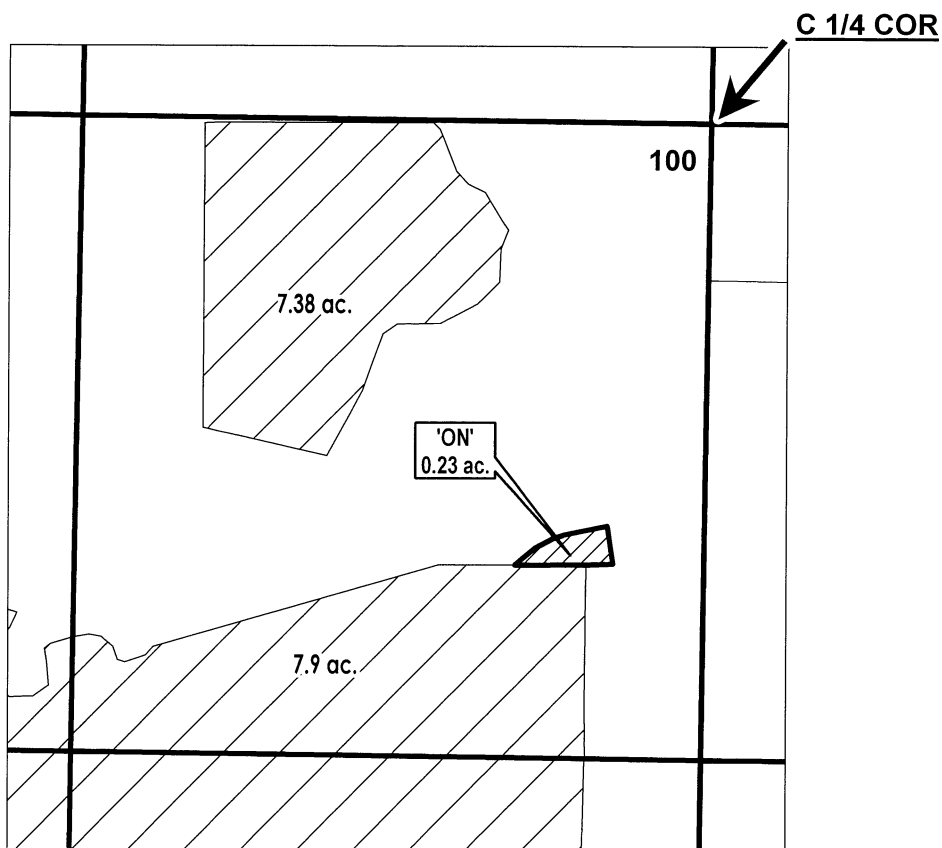

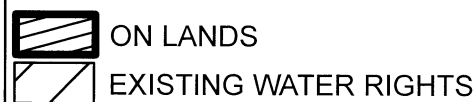 ON LANDS
EXISTING WATER RIGHTS



FINAL PROOF MAP

NAME: Dynes, Luke

TAXLOT #: 100

0.23 ACRES

DATE: 9/15/2025

DESCHUTES COUNTY SEC.03 T17S R14E



E-RECEIVED
SEP 22, 2025
OWRD

SCALE - 1" = 400'



SE 1/4 OF THE SE 1/4

OWRD#: T-14583

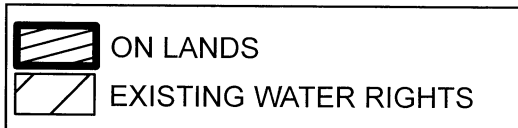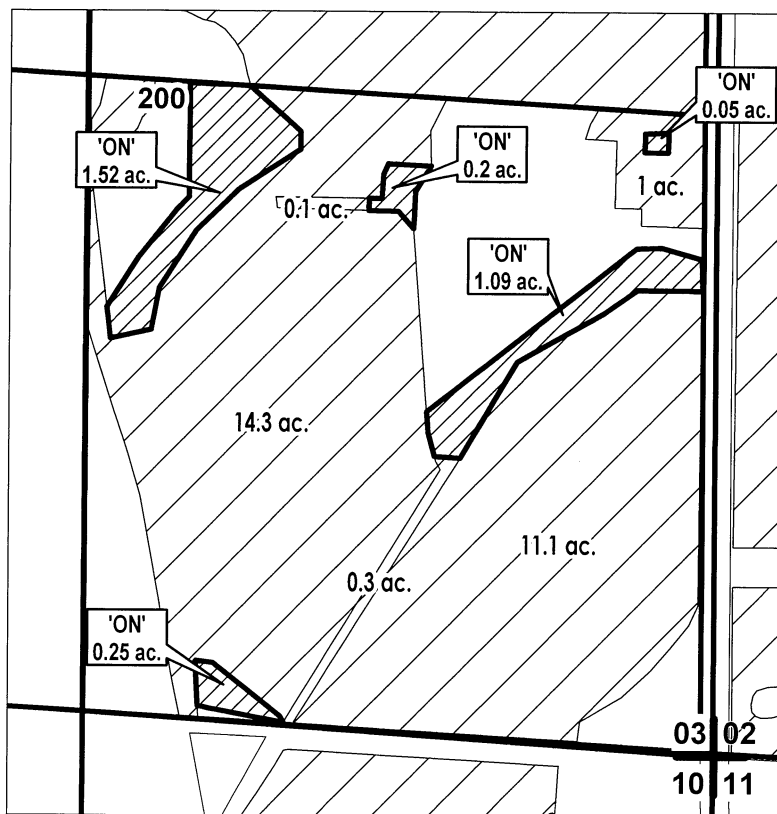

FINAL PROOF MAP

NAME: McMichael, David

TAXLOT #: 200

3.11 ACRES

DATE: 9/15/2025

CROOK COUNTY SEC.03 T16S R14E


E-RECEIVED
SEP 22, 2025
OWRD

SCALE - 1" = 400'



SW 1/4 OF THE NW 1/4

OWRD#: T-14583

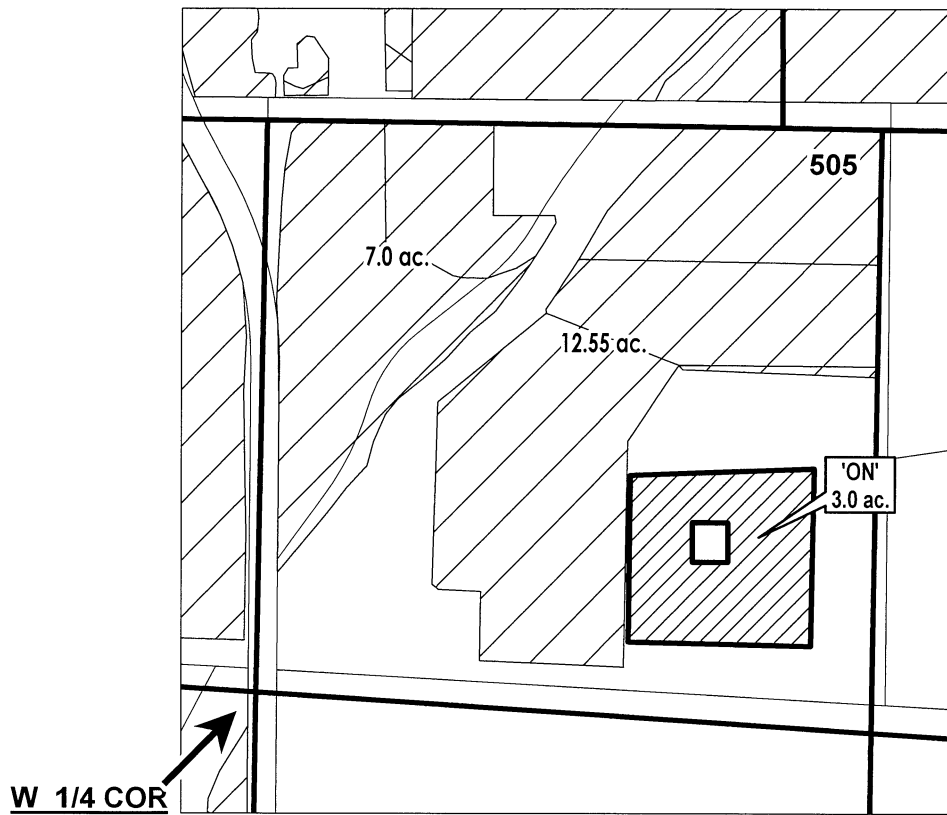

 ON LANDS
 EXISTING WATER RIGHTS



FINAL PROOF MAP

NAME: Hinton, Brian/ Kati

TAXLOT #: 505

3.0 ACRES

DATE: 9/15/2025