

Name Ross E., Joyce M. + Norman L. Carry

4396

~~By~~ Central Oregon I.D.

Address P.O. Box 548

Redmond, OR

DESCRIPTION OF WATER RIGHT

Name of stream Deschutes River

Trib. of \_\_\_\_\_ County of Crook

Use irrigation

Quantity of water \_\_\_\_\_ No. of acres 40<sup>±</sup>

Name of ditch Central Oregon Canal

Date of priority Oct. 31, 1900 + Dec. 2, 1907

In name of Lynn Fischer

Deschutes River Adjudication, Vol. \_\_\_\_\_, page 36

App. No. \_\_\_\_\_ Per. No. \_\_\_\_\_ Cert. No. 29052

Certificate cancelled \_\_\_\_\_

Notation made on record by \_\_\_\_\_

FEES PAID

Date	Amount	Receipt No.
<u>2-19-80</u>	<u>32.50</u>	<u>16137</u>
TOTAL . . .		
	Cert. Fee	

FEES REFUNDED

Date	Amount	Check No.

Change in POU

Date filed Feb 19, 1980

Date of hearing \_\_\_\_\_

Place of hearing \_\_\_\_\_

Date of order 3-12-80 Vol. 33, page 55

Date for application of water 10-1-81

Proof mailed 7-27-87

Proof received 10-18-88 Aug 19, 87

Certificate issued \_\_\_\_\_ Vol. \_\_\_\_\_, page \_\_\_\_\_

*Landrus, Knocke, Hanna  
not necessary*

*to survey 4/80*

REMARKS

Surveyed 5/9/84 (Knocke, et al)


— finis —

T-6188 & POC SO. OR. V. 43, p. 163


W.R.I.S.	
Assembled <u>2-8-85</u> by <u>SL</u>	
Entered _____ by _____	
Verified _____ by _____	

NO BE ENTERED WHEN CHECKED	INDEX CARDS:	
	Checked	Checked
<input checked="" type="checkbox"/>	Name	<u>SL</u>
<input checked="" type="checkbox"/>	Stream	<u>SL</u>
<input checked="" type="checkbox"/>	Pt. of Div.	<u>SL</u>
<input checked="" type="checkbox"/>	Calendar	<u>SL</u>
<input checked="" type="checkbox"/>	Twp. & Rgn.	<u>SL</u>
<input checked="" type="checkbox"/>	Dist. & Unit	<u>SL</u>
<input checked="" type="checkbox"/>	Des. name	<u>SL</u>
<input checked="" type="checkbox"/>	Cor. of W/R	<u>SL</u>
<input type="checkbox"/>	Int. folder	_____
<input type="checkbox"/>	C. Index	_____
<input type="checkbox"/>	Cross Ref.	_____
<input type="checkbox"/>	Power Claim	_____
<input checked="" type="checkbox"/>	Abstracts	<u>SL</u>


T.15S., R.14E., W.M.

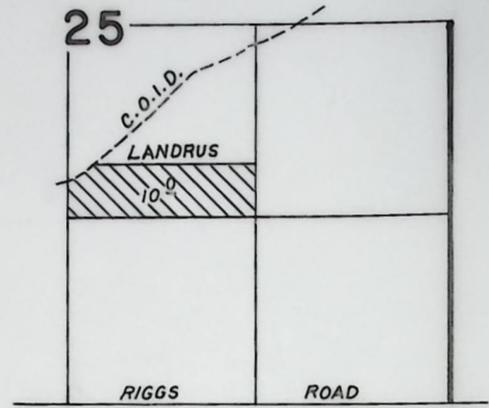

T.14S., R.14E., W.M.

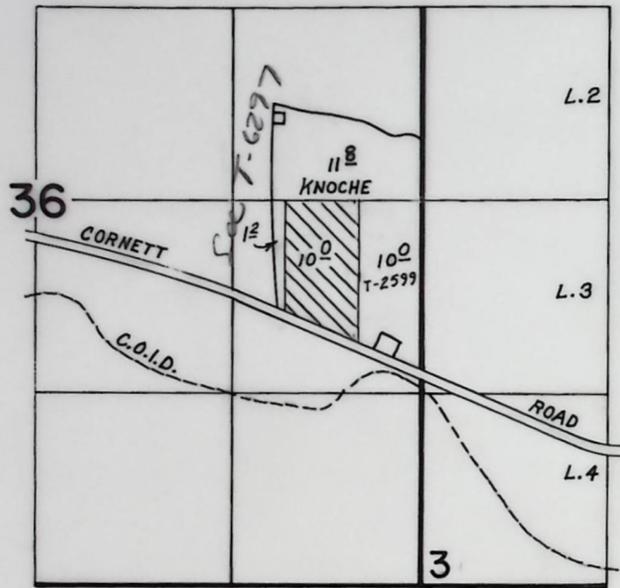

T.14S., R.15E., W.M.

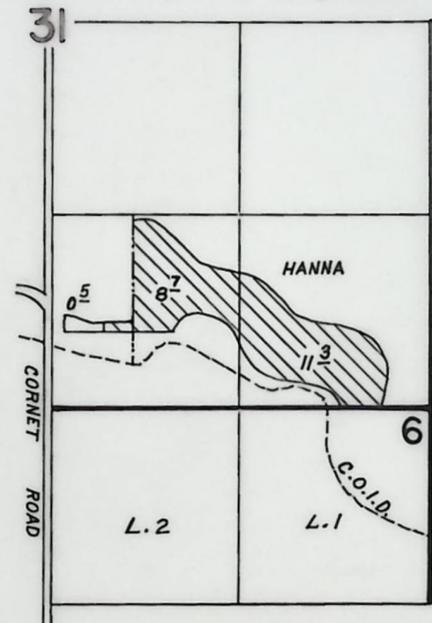

**FINAL PROOF SURVEY**  
UNDER

TRANSFER NO. 4396

Application No. .... Permit No. ....

IN NAME OF

KNOCHE; HANNA; LANDRUS; /C.O.I.D.

Surveyed MAY 9 1984, by LESLIE OLSON

BEFORE THE WATER RESOURCES DIRECTOR OF OREGON  
DESCHUTES COUNTY

IN THE MATTER OF THE APPLICATION OF )  
ROSS E., JOYCE M. & NORMAN L. CURRY )  
(CENTRAL OREGON IRRIGATION DISTRICT) )  
FOR APPROVAL OF A CHANGE IN PLACE OF )  
USE OF WATER )  
-----

ORDER APPROVING  
TRANSFER NO. 4396

On February 19, 1980, an application was filed in the office of the Water Resources Director by Ross E., Joyce M. & Norman L. Curry for approval of a change in place of use of water from Deschutes River, pursuant to the provisions of ORS 540.510 to 540.530.

By Decree of the Circuit Court for Deschutes County, Oregon, entered September 30, 1958, in the Matter of the Determination of the Relative Rights to the Use of the Waters of Deschutes River and its Tributaries, a water right was allowed in the name of Central Oregon Irrigation District for the use of the waters of Deschutes River for irrigation of, among other lands, a certain 9.0 acres in NE $\frac{1}{4}$  NW $\frac{1}{4}$ , 0.2 acre in SW $\frac{1}{4}$  NW $\frac{1}{4}$  and 30.8 acres in SE $\frac{1}{4}$  NW $\frac{1}{4}$  of Section 11, Township 15 South, Range 14 East, W.M., being tabulated in the name of Lynn Fischer at Volume 16, Page 36, with dates of priority of October 31, 1900 and December 2, 1907, as evidenced by certificate recorded at page 29052, Volume 21, State Record of Water Right Certificates. These lands also have a supplemental right under permit No. 23256 to the use of water stored in Crane Prairie Reservoir with a date of priority of February 28, 1913. These lands are irrigated by means of the Central Oregon Canal.

The applicants herein, owners of the lands above described, propose to transfer the water right therefrom, without loss of priority, to a certain 10.0 acres in NE $\frac{1}{4}$  SE $\frac{1}{4}$  of Section 36, Township 14 South, Range 14 East; 7.5 acres in SW $\frac{1}{4}$  SE $\frac{1}{4}$ , 12.5 acres in SE $\frac{1}{4}$  SE $\frac{1}{4}$  of Section 31, Township 14 South, Range 15 East; and 10.0 acres in NW $\frac{1}{4}$  SE $\frac{1}{4}$  of Section 25, Township 15 South, Range 14 East, W.M.

The lands involved herein are within the boundaries of the Central Oregon Irrigation District and the Board of Directors of said District approved the proposed change in place of use of water at a regular meeting held February 12, 1980.

Mr. Robert F. Main, Jr., Watermaster, has filed a statement to the effect that the proposed change in place of use may be made without injury to existing rights.


No objections having been filed and it appearing that the proposed change in place of use of water may be made without injury to existing rights, the application should be approved.

NOW, THEREFORE, it hereby is ORDERED that the requested change in place of use, as described herein, without loss of priority, is approved.

It is FURTHER ORDERED that said water so transferred shall be applied to beneficial use on or before October 1, 1981.

It is FURTHER ORDERED that upon receipt of proof satisfactory to the Water Resources Director of complete application of water to beneficial use on the lands to which the water is transferred hereby, a certificate of water right shall be issued to Central Oregon Irrigation District confirming this and prior changes without the District.

Dated at Salem, Oregon, this 12th day of March, 1980.

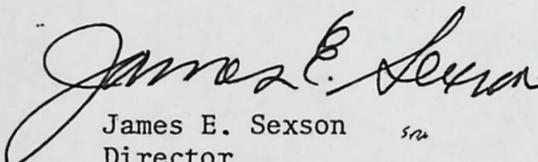  
James E. Sexson  
Director

RECEIVED


MAR 6 1980

WATER RESOURCES DEPT  
SALEM, OREGON

T-4396

SCALE:  
4" = 1 MILE APPROX.

In crop in 1948  
but not irrigated

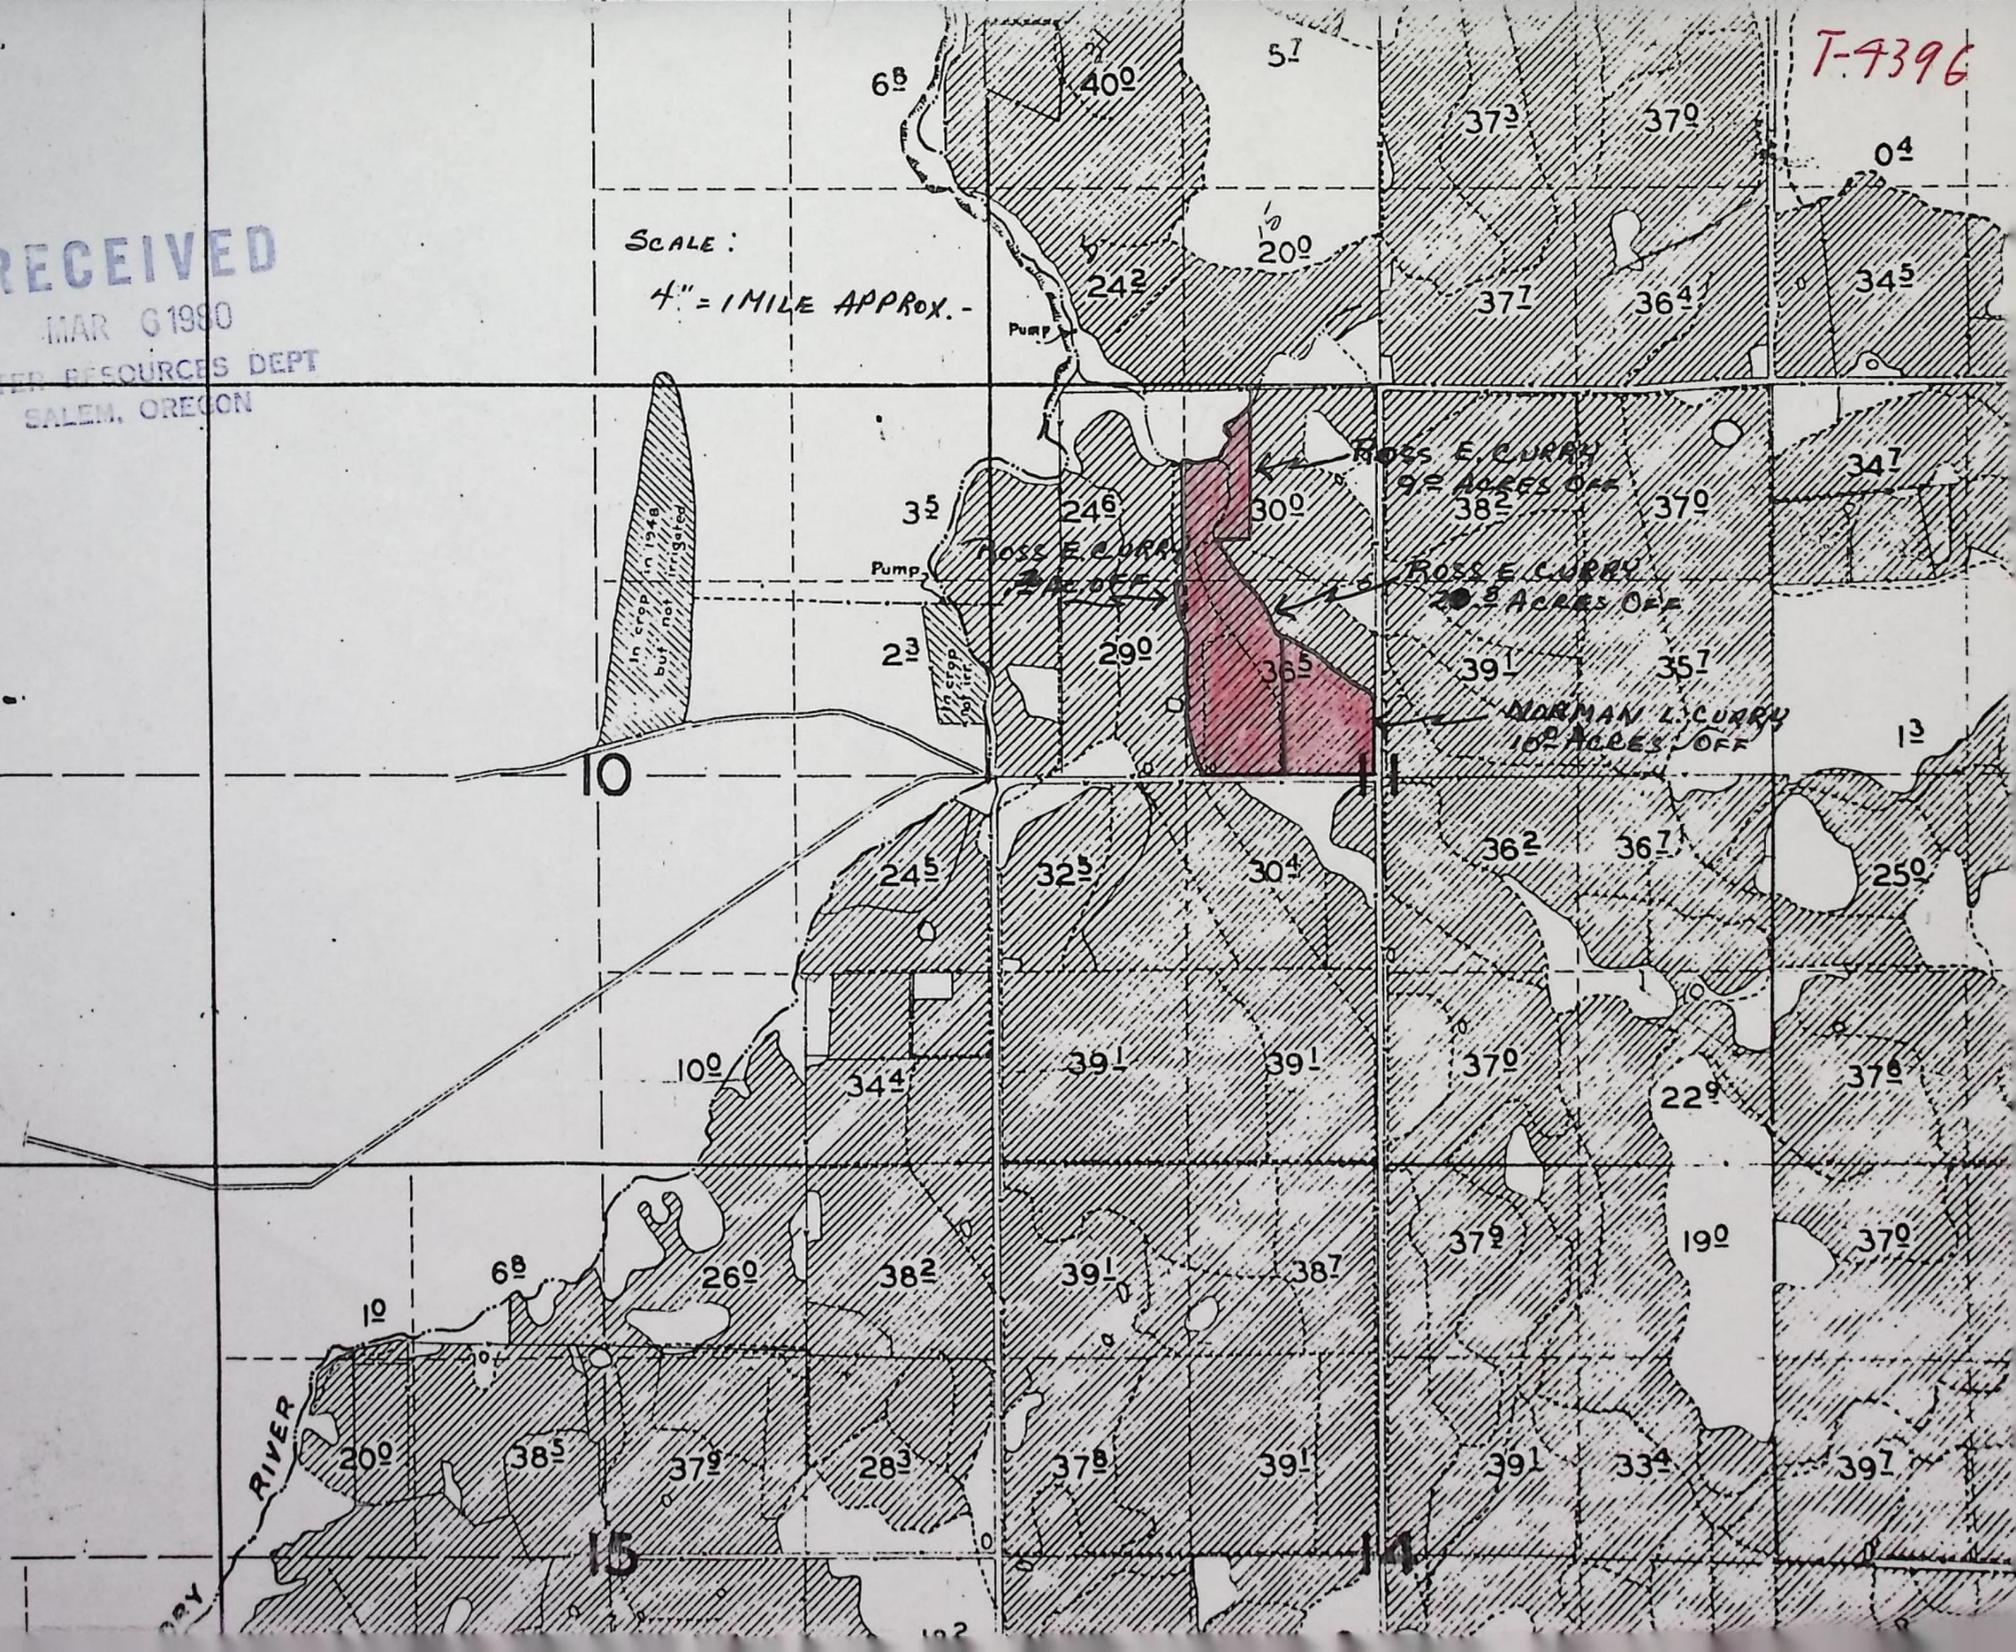

REPORT ON INSPECTION UNDER TRANSFER  
OF WATER RIGHT FOR CHANGE IN:

POD  
POU  
USE  
Add'l POD

130-221R  
5-9-84  
L610

Transfer NO. 4396 County Crook

Old Certificate NO. 29052 Knoche, Hanna, Landrus

1. Name Ross E, Joyce A., + Norman L. Curry, c/o COID  
Address \_\_\_\_\_

2. Source of Supply Deschutes R., Trib of \_\_\_\_\_

3. Use irrigation of 40<sup>0</sup> AC. ✓

4. Amount of Water \_\_\_\_\_ Priority Date 10/31/1900, 12/2/1907

5. Proposed Point of Diversion \_\_\_\_\_

6. Completion Date 10-1-81

7. Place of Use:

Township	Range	Section	Forty Acre Tract	Use for Which Transfer Made
14S ✓	14E ✓	36 ✓	NESE ✓	10 <sup>0</sup> ac Knoche ✓
14S ✓	15E ✓	31 ✓	SWSE ✓	8 <sup>7</sup> / <sub>10</sub> AC } Hanna ✓ <small>with cont 11/19</small>
"	"	31 ✓	SESE ✓	11 <sup>3</sup> / <sub>10</sub> AC } ✓
15S ✓	14E ✓	25 ✓	NWSE ✓	10 <sup>0</sup> ac Landrus ✓
14S	14E	36	SE NE	11 <sup>8</sup> OVERACREAGE } KNOCHE
<del>14S</del>	<del>14E</del>	<del>36</del>	<del>NE SE</del>	<del>10<sup>4</sup> Tr-2599 OVERACREAGE</del> }
14S	15E	31	SW SE	0 <sup>5</sup> OVERACREAGE HANNA

NESE 14.14.36  
 20 29052  
 10 4396 ✓  
 SENE \_\_\_\_\_  
 NCR

14.15.31  
 SWSE 7  
 40 ✓ CT-29052  
 7<sup>5</sup> T-4396 ✓

SESE  
 12<sup>5</sup> T-4396 ✓


15.14.25  
 15<sup>0</sup> CT-29052  
 15<sup>0</sup> T-4396 ✓  
 10<sup>0</sup> T-4396 ✓  
 NCR

T-4396

NW 1/4 SE 1/4 SEC. 25  
T. 15 S., R. 14 E. W. M.

1" = 200'

Dale & Annette Landries  
Rt. 1 Box 353

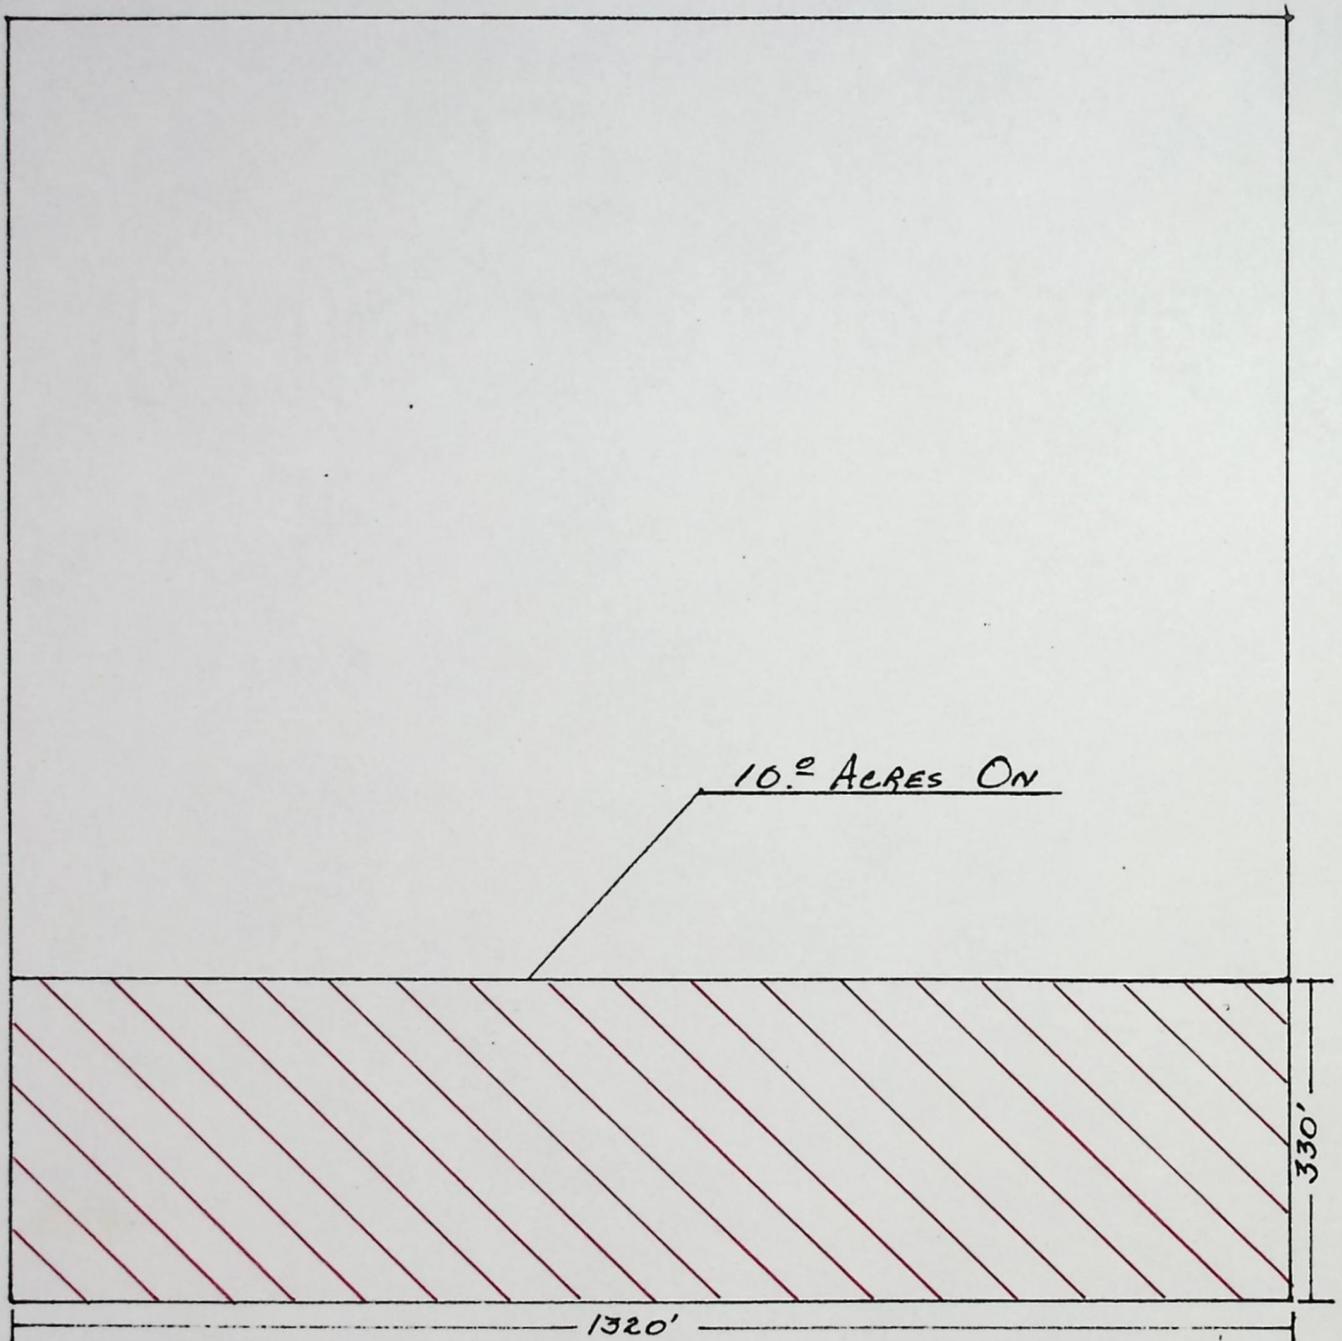

RECEIVED  
FEB 19 1980  
WATER RESOURCES DEPT.  
SALEM, OREGON

landless portion

Info: Dale landless

Crop: Grass & Alfalfa hay

Hds: 60 RB's on wheel + round lines

Pump: 40 hp Century

see 3389 - report  
4716  
4710

Irrigation for lands  
south of canal

Tie: 155-14E

4-25-84

Sadie Olsen  
WRE

T-4396

NE 1/4 SE 1/4 SECTION 36  
T. 14 S., R. 14 E W.M.

Abt 1 P.M.


1" = 200'

TAW?

H. W. & E. Knoche

Rt. 1 Box 165

447-5362

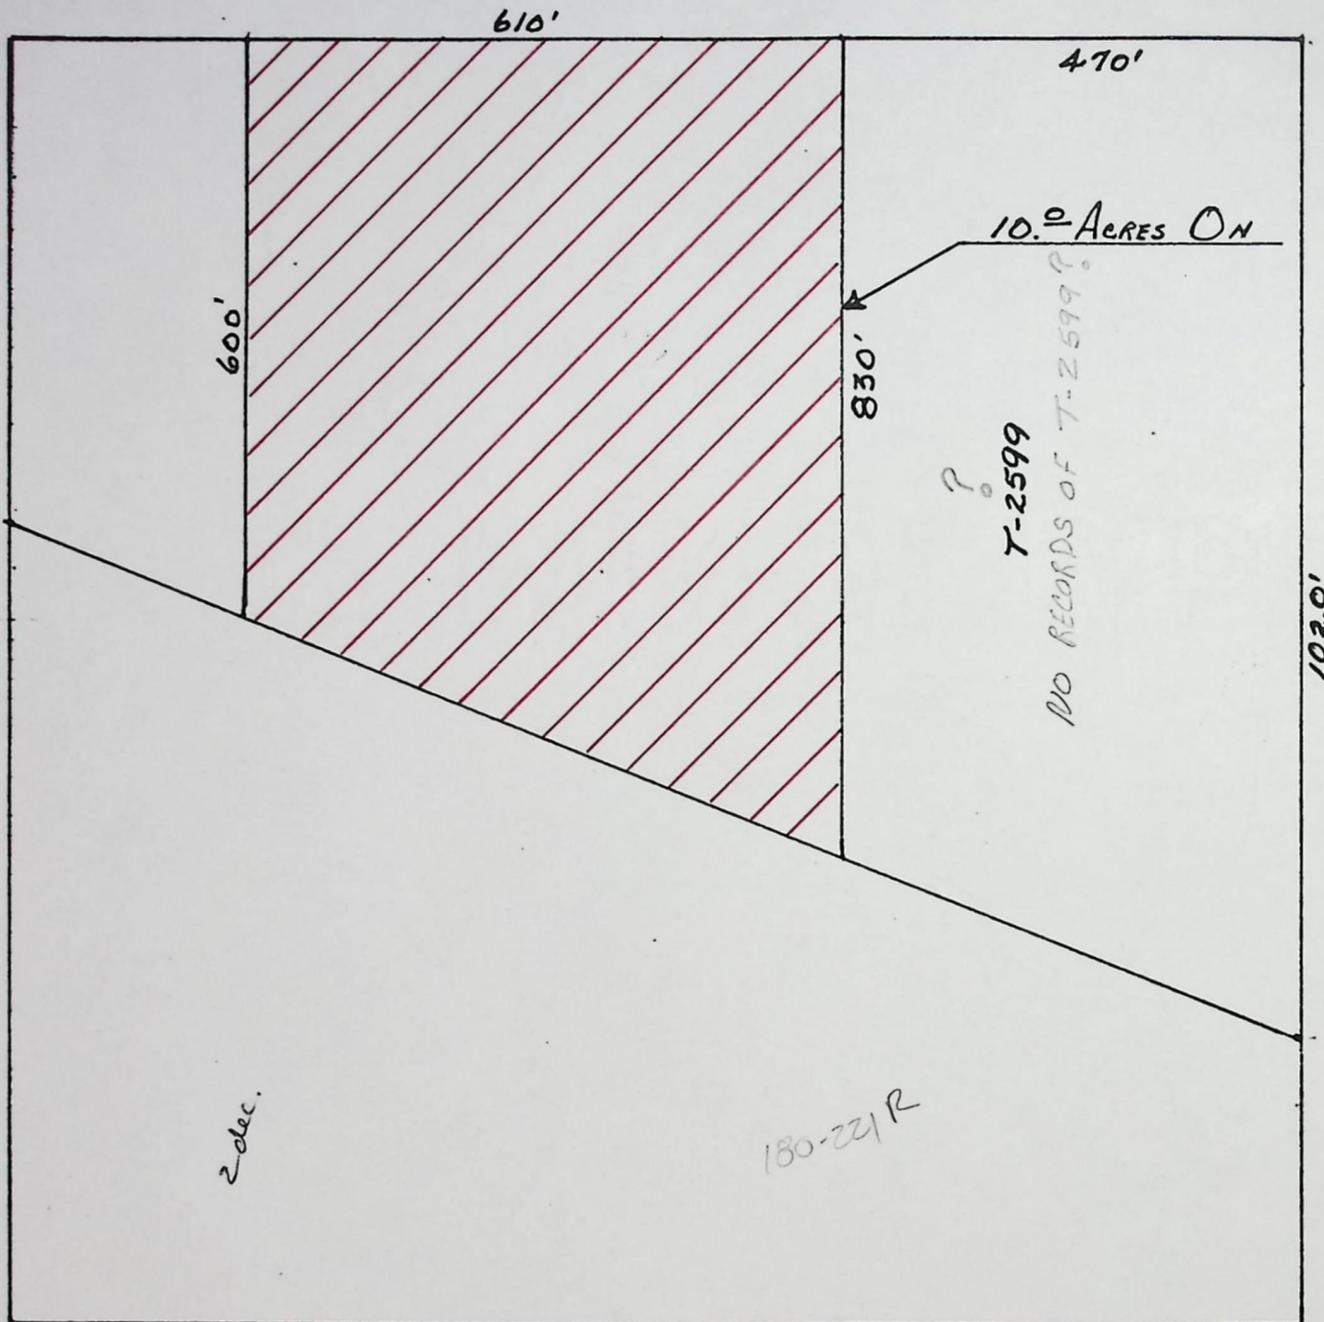

79.64 121 79.21

	L1	
36	L2	31
	L3	
	L4	

80.00 116 79.60

RECEIVED

FEB 19 1980

WATER RESOURCES DEPT.  
SALEM, OREGON

Info: Personal Obs.

Hdo: 11 RB's, buried ML

Pump: elec. 10HP

Remarks: Missed Mr. Knoche at his house, but did talk to him by phone a couple of times. There is a large irrigated field in front of property which is irrigated from pond. Neighbor <sup>Neighbor</sup> (lives on property) says they don't irrigate from well. There is also pasture irrigated up in the trees. Appears that headgate is across the road - pipe runs under rd into pond. (Pumped)

Tel: 180-221 R

5-9-84


Senio Olson

WRE

T-4396

SECTION 31, T.14S., R.15E. W.1

SCALE 1" = 900'

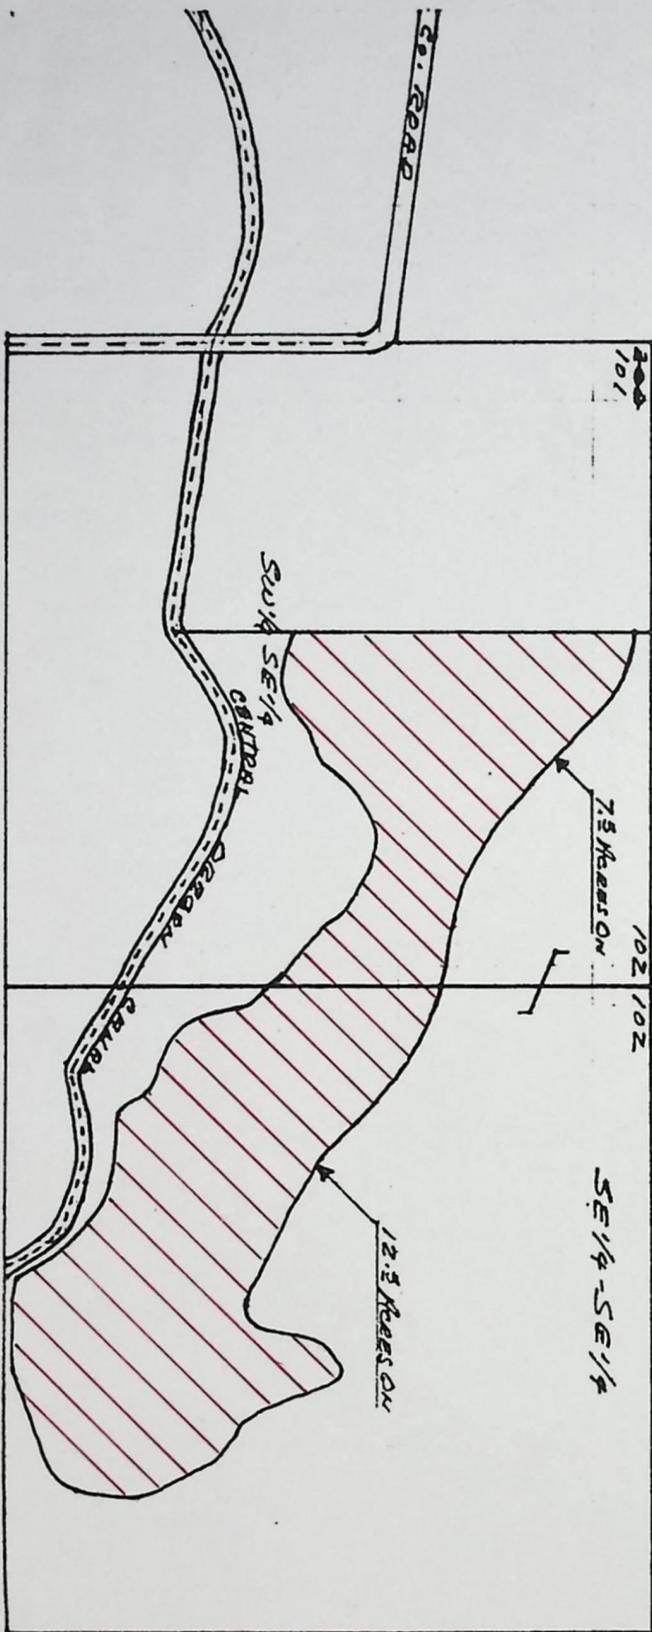

Glenn & Amy Hanna  
P.O. Box 167

36		79.21	
1	2	3	4
1	8	6	7
115	4	5	4
7	6	7	2
155	6	7	2
79.60	2	1	1
79.21	3	1	8
79.21	7	2	2

wed. - A.M.

180-221R

RECEIVED  
 FEB 19 1980  
 WATER RESOURCES DEPT  
 SALEM, OREGON

Info: Amy Hanna

Hds: 4 guns - 2 at a time, <sup>1 1/2" nozzle</sup> buried mainline (5"?)

Pump: 2 - 10 hp - pump ~ 200 gpm, 100 per head

Crop: grass hay

Remarks: irrigation extends beyond fence line

all the way around & is used for pasture - planted to  
wheat when cattle are run on field  
created wheat

File: 180-221R

4-25-84

Jessie Olson

WRE

\*\*\* OREGON WATER RESOURCES DEPARTMENT \*\*\*  
\*\*\* WATER RIGHTS DIVISION \*\*\*  
\*\*\* WATER RIGHT DATA INPUT FORM \*\*\*

WATER RIGHT NO. T0000 43961 PERMIT NO. 016 036 CERTIF. NO. 029052  
ORIG. NO. C000290521 PREV. NO. C000290521 SUPER. NO.

NAME: R.E. J.M. & N.L. CURRY

ADDRESS: COID PO BOX548

CITY/STATE/ZIP/COUNTY; REDMOND, OR 97756

07  
09

STREAM-ID 05 1980 RIV.MI. 0.0 WM.DIST. 11 W.R.TYPE SC STATUS V

CANCEL YEAR----> CONSTR.COMPLT--> 05 04 1981 YR.LAST USED-----> NEXT ACTION DUE-->  
PRIORITY-----> 10 31 1900 PUT TO USE-----> 05 04 1981 LAST TRANS.DATE--> LAST TRANS.TYPE-->  
APPLICATION--> 02 19 1980 SURVEYED-----> 05 09 1984 EXAM.FEE-----> 20.00 RECORDING FEE-----> 12.50  
PERMIT ISSUE--> 03 12 1980 CONCURRENCE-----> CYCLE STATUS-----> REPORTED FLAG----->  
CONSTR.STRT.--> 03 12 1980 CERTIFIED-----> CORRES.INIT.-----> CORRES.DATE----->

POINT-OF-DIVERSION DATA:  
TWNSP RNGE SECT QTR/QTR STREAM-ID

TWNSP	RNGE	SECT	QTR/QTR	STREAM-ID	RIV.MI.	RATE	STATUS	S	OR	P
170S	120E	29	A D	05 1980	164.9		V			P
180S	120E	13	A C	05 1980	171.0		V			P
					0.0					

\*\* REMARKS; - - - - -  
\*\* DATED-->  
\*\* PRIORITY ALSO 12-2-1907 CHANGES POLI  
\*\* PART OF C-29052 PILOT BUTTE CENTRAL  
\*\* OREGON CANAL TAB IN NAME OF LYNN  
\*\* FISCHER  
\*\*  
\*\*  
\*\*

PLACE-OF-USE DATA:  
TWNSP RNGE SECT QTR/QTR CNTY USE % CNSMTV ACRES STATUS S OR P

TWNSP	RNGE	SECT	QTR/QTR	CNTY	USE %	CNSMTV	ACRES	STATUS	S	OR	P
140S	140E	36	D A	07	IR	100.00	10.00	V			P
140S	150E	31	D C				7.50				
140S	150E	31	D D				12.50				
150S	140E	25	D B				10.00				


W.R.I.S.  
Approved 2-8-85  
Entered \_\_\_\_\_ by \_\_\_\_\_  
Verified \_\_\_\_\_ by \_\_\_\_\_

RECEIVED



OCT 18 1988

WATER RESOURCES DEPT.  
SALEM, OREGON


T. 15S., R. 14E., W.M.

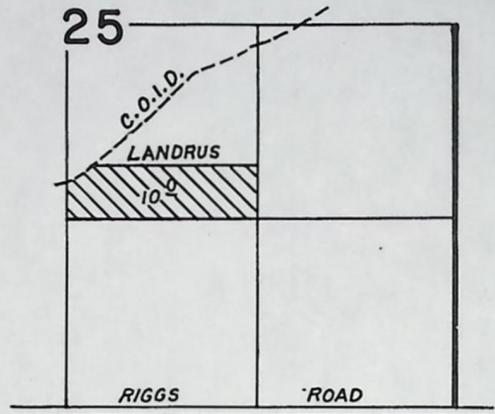

T. 14S., R. 14E., W.M.

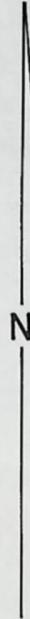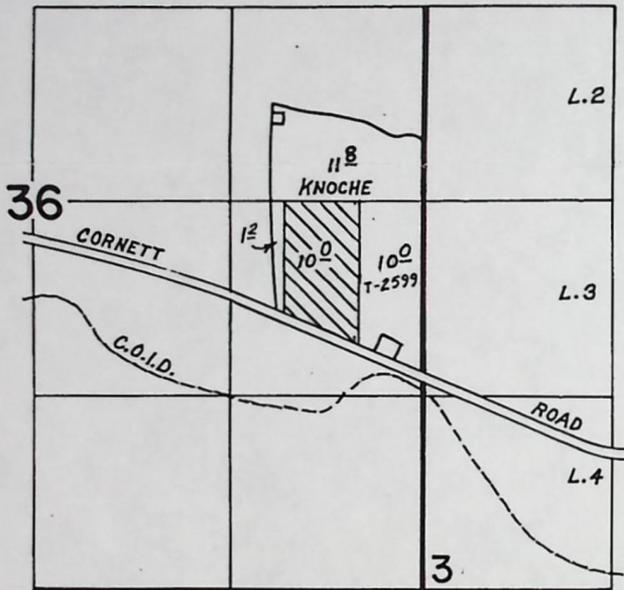

T. 14S., R. 15E., W.M.

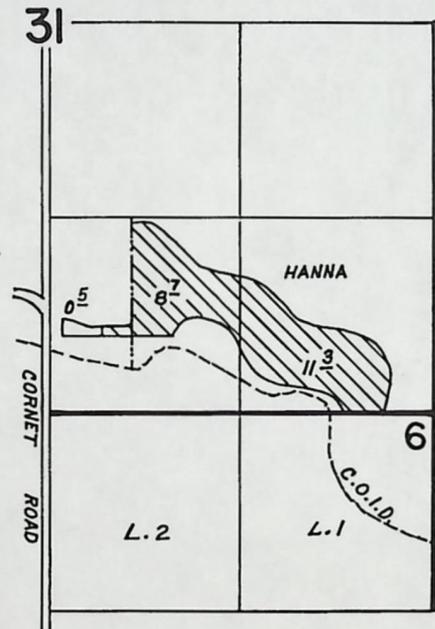

**FINAL PROOF SURVEY**  
UNDER

TRANSFER NO. 4396  
Application No. .... Permit No. ....  
IN NAME OF

KNOCHE; HANNA; LANDRUS; /C.O.I.D.

Surveyed MAY 9 1984, by LESLIE OLSON

RECEIVED  
OCT 10 1988  
WATER RESOURCES DEPT.  
SALE, OREGON

STATE OF OREGON

COUNTY OF CROOK

PROOF OF APPROPRIATION OF WATER

Name: DALE LANDRUS

Address: Route 1, Box 353, Powell Butte, Oregon 97753

c/o Central Oregon Irrigation District, Bob Anderson, Asst. Manager

P.O. Box 548, Redmond, Oregon 97756

Source of Supply: Deschutes River and Crane Prairie Reservoir

Tributary of: Columbia River

Transfers: 3389, 4396

Priority Dates: October 31, 1900, December 2, 1907 and February 28, 1913

Use: Irrigation of 20.0 acres

Location and Point of Diversion: Central Oregon Canal

The description of land given below and as shown on the attached map corresponds to that found to be irrigated:

10.0 acres NW 1/4 SE 1/4 (T-4396)  
3.7 acres NW 1/4 SE 1/4 (T-3389)  
6.3 acres NE 1/4 SE 1/4 (T-3389)  
Section 25  
Township 15 South, Range 14 East, WM

I have read the above and foregoing proof of appropriation of water defining the extent of use of water under the change in place of use approved by the order of the Water Resources Director entered September 28, 1976 and March 12, 1980; I know the contents thereof, and that the facts therein stated are true.

IN WITNESS WHEREOF, I have hereunto set my hand this 17<sup>th</sup> day of Oct., ~~1987~~  
1988

Dale Landrus  
Legal owner of the above described lands

STATE OF OREGON

COUNTY OF CROOK

PROOF OF APPROPRIATION OF WATER

RECEIVED

AUG 14 1987

WATER RESOURCES DEPT.  
SALEM, OREGON

Name: GLENN HANNA

Address: Route 1, Box 167, Powell Butte, Oregon 97753

c/o Central Oregon Irrigation District, Bob Anderson, Asst. Manager

P.O. Box 548, Redmond, Oregon 97756

Source of Supply: Deschutes River and Crane Prairie Reservoir

Tributary of: Columbia River

Transfer: 4396

Priority Dates: October 31, 1900, December 2, 1907 and February 28, 1913

Use: Irrigation of 20.0 acres


Location and Point of Diversion: Central Oregon Canal

The description of land given below and as shown on the attached map corresponds to that found to be irrigated:

8.7 acres SW 1/4 SE 1/4  
11.3 acres SE 1/4 SE 1/4  
Section 31  
Township 14 South, Range 15 East, WM

I have read the above and foregoing proof of appropriation of water defining the extent of use of water under the change in place of use approved by the order of the Water Resources Director entered March 12, 1980; I know the contents thereof, and that the facts therein stated are true.

IN WITNESS WHEREOF, I have hereunto set my hand this 4<sup>th</sup> day of AUGUST, 1987.

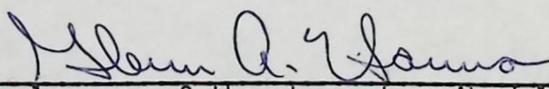  
Legal owner of the above described lands

STATE OF OREGON

COUNTY OF Deschutes Crook

Proof of Appropriation of Water

*over coverage*

Name: H.W. Knoche  
Rt 1, Box 165 % Bob Anderson, Ass't. Manager  
Central Oregon Irrigation District

Address: P.O. Box 548  
Redmond, Or 97756

Source of Supply: Deschutes River & Crane Prairie Reservoir

Permit No.: \_\_\_\_\_ Transfer No.: 4396

Tributary of: Columbia River

Amount of Water: \_\_\_\_\_

Priority Date: Oct 31, 1900 December 2, 1907 Feb 28, 1913

Use: irrigation of 10.0 acres

Location and Point of Diversion: Central Oregon Canal  
North Canal

The description of land given below and as shown on the attached map corresponds to that found to be irrigated:

10.0 acres. NE 1/4 SE 1/4  
Section 36  
T 14 S, R 14 E, W 11

I have read the above and foregoing proof of appropriation of water defining the extent of use of water under the change of in place of use approved by the order of the WRD entered March 12, 1980; I know the contents thereof, and that the facts therein stated are true.

IN WITNESS WHEREOF, I have hereunto set my hand this \_\_\_\_\_ day of \_\_\_\_\_ 198\_.

\_\_\_\_\_  
Legal owner of the above described lands

Knoche

## STD PROOF LETTER


+

Our field examiner found a total of 23.0 acres claimed irrigated in connection with transfer 4396, which exceeds the limit of 10.0 acres under the transfer order. If you wish to establish a legal water right for the additional 13.0 acres, ~~a permit~~ or a water right transfer must be obtained. Please contact Central Oregon Irrigation District for assistance in making the appropriate application.

The 13.0 acres overacreage is displayed on the map as an un-hatched area. If this area is not located where you prefer, please notify us. It may be possible to locate the area elsewhere on your land.

Proof not necessary - finish-

T.14S., R.14E., W.M.

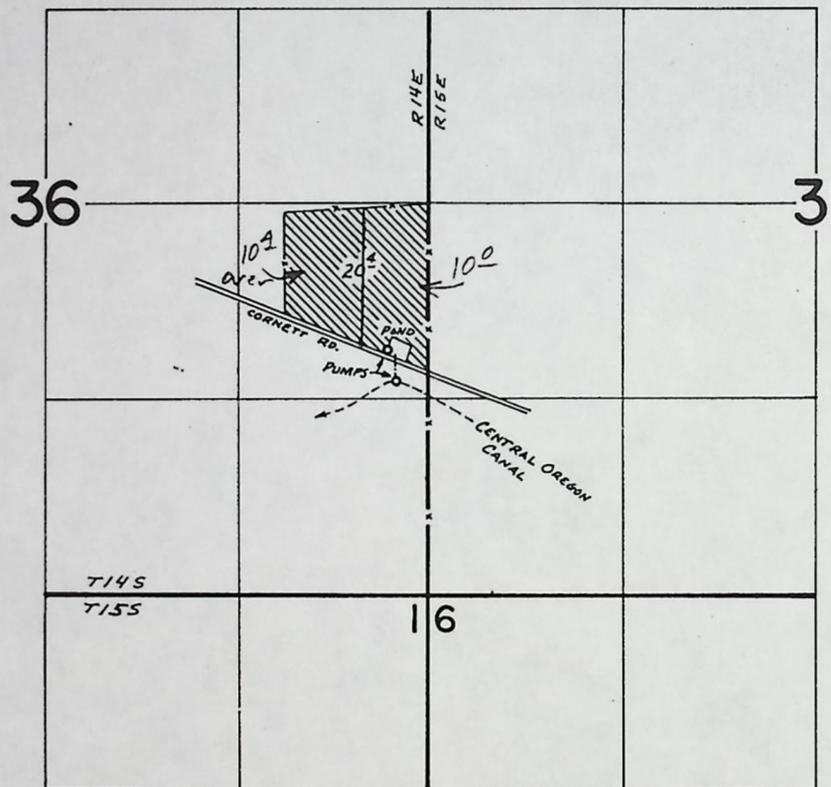

**FINAL PROOF SURVEY**  
UNDER

Transfer No. 2599  
Application No. \_\_\_\_\_ Permit No. \_\_\_\_\_  
IN NAME OF

\_\_\_\_\_ HENRY W. KNOCHE \_\_\_\_\_

Surveyed May 12 1975, by D. Norby \_\_\_\_\_

RECEIVED

MAY 04 1981

WATER RESOURCES DEPT  
SALEM, OREGON

NOTICE OF COMPLETION OF CHANGE IN

PLACE OF USE OF WATER FROM DESCHUTES RIVER

PURSUANT TO TRNASFER APPLICATION NO. 4396

I, Dale Landrus, hereby certify that completion of works and use of water to the extent intended within the provisions of the order of the Water Resources Director approving said water right transfer application was accomplished by JAN. 1, 1981.

April 30, 1981  
Date

Dale Landrus  
Signature

(Mail to the Water Resources Department, Salem, Oregon 97310.)

Letter only!  
OK  
Dij

RECEIVED

MAY 13 1980

WATER RESOURCES DEPT  
SALEM, OREGON

NOTICE OF COMPLETION OF CHANGE IN

Pou of water from Deschutes River

PURSUANT TO TRNASFER APPLICATION NO. 4396

I, Henry Knoche, hereby certify that completion of works and use of water to the extent intended within the provisions of the order of the Water Resources Director approving said water right transfer application was accomplished by 4-15, 1980

May 13 1980  
Date

Henry Knoche  
Signature

(Mail to the Water Resources Department, Salem, Oregon 97310.)

ok  
Gy

RECEIVED  
APR 9 1980  
WATER RESOURCES DEPT  
SALEM, OREGON

NOTICE OF COMPLETION OF CHANGE IN

PLACE OF USE OF WATER FROM DESCHUTES RIVER

PURSUANT TO TRNASFER APPLICATION NO. 4396

I, GLENN A. HANNA, hereby certify that completion of works and use of water to the extent intended within the provisions of the order of the Water Resources Director approving said water right transfer application was accomplished by March 28, 1980

April 4, 1980  
Date

Glenn A. Hanna  
Signature

(Mail to the Water Resources Department, Salem, Oregon 97310.)

de  
Gij

T-4396

RECEIVED  
FEB 19 1980  
WATER RESOURCES DEPT  
SALEM, OREGON

# Application for Transfer of Water Right

To the WATER RESOURCES DIRECTOR OF OREGON:

I, Ross E. Curry and Joyce M. Curry and Norma L. Curry  
(Name of applicant)

of Route 1 Box 180, Powell Butte  
(Mailing address) (City)

State of Oregon, 97753, 447-3701, do hereby make application for change  
(Zip Code) (Phone number)

in place of use  
(In point of diversion; place of use; use heretofore made of the water)

1. Is the water right recorded in your name? No. Lynn Fischer, Page 36  
(If not, give name)

2. Was your water right determined by Decree of Court? Yes If so, give title of proceedings  
(Yes or No)

Adjudication of the Deschutes River number of certificate 29052

3. Was your water right acquired by Water Right Permit? No If so, give number  
(Yes or No)

of permit ..... Number of certificate .....

NOTE: If the entire right of record is not directly involved in the requested change, only that part of the right that is directly involved should be considered in answering the balance of the questions on this form.

4. The source of water is Deschutes River, Central Oregon Canal

5. What is the date of priority of your water right? Oct. 31, 1900 and Dec. 2, 1907

6. The authorized point of diversion is located ..... ft. ..... and ..... ft. ..... from the .....  
(N. or S.) (E. or W.)

corner of ..... being within the ..... 1/4 ..... 1/4 of Section ..... Tp. .... R. .... W. M.,  
(No. N. or S.) (No. E. or W.)

in the county of Crook The name of the ditch used is .....

NOTE: Answer question if the application is for change in point of diversion.

7. The proposed point of diversion is located ..... ft. ..... and ..... ft. ..... from the .....  
(N. or S.) (E. or W.)

corner of ..... being within the ..... 1/4 ..... 1/4 of Section ..... Tp. .... R. .... W. M.,  
(No. N. or S.) (No. E. or W.)

in the county of ..... The name of the ditch to be used is .....

8. The use to which the water is applied is irrigation  
(Irrigation, Mining, Power, Manufacturing, etc.)

Location of area irrigated, or place of use if other than irrigation:

Township North or South	Range E. or W. of Willamette Meridian	Section	List ¼-¼ of Section	Number Acres To Be Irrigated
15	14	11	NE¼ NW¼	9.0 ✓
15	14	11	SW¼ NW¼	.2 ✓
15	14	11	SE¼ NW¼	30.8 ✓

(If more space required, attach separate sheet)

9. Are you the legal owner of the above described lands? Yes  
(If not owner, explain your interest)

10. To your knowledge, has any portion of the water right above described undergone a period of five or more consecutive years of nonuse? No  
(Yes or No)

NOTE: Answer questions 11, 12 and 13 if application is for change in use or place of use.

11. Are the lands from which you propose to transfer your water right free of all encumbrances, including taxes, mortgages, liens, etc.? Yes  
(Answer Yes or No)

12. If not, give below a description of existing encumbrances:

NATURE OF ENCUMBRANCE	HELD BY	AMOUNT
None		

13. The use to which the water is to be applied is irrigation  
(Irrigation, power, mining, manufacturing, domestic supplies, etc.)

Location of area to be irrigated, or place of use if other than irrigation:

Township North or South	Range E. or W. of Willamette Meridian	Section	List ¼-¼ of Section	Number Acres To Be Irrigated
14	14	36	NE¼ SE¼	10 ✓
14	15	31	P S½ SE¼	20 ✓ 7.5 in SW SE 12.5 in SE SE
15	14	25	NW¼ SE¼	10 ✓

(If more space required, attach separate sheet)

14. Reasons for the proposed changes are More beneficial use of the water.

15. Construction work will be completed on or before \_\_\_\_\_

16. The water will be completely applied to the proposed use on or before Oct. 31, 1981

Remarks 10 acres water right being transferred to Henry Knocke and 20 acres  
water right being transferred to Glen Hanna. 10 acres to Dale Landrus.

Approved by the Board of Directors of Central Oregon Irrigation District at a  
regular meeting held February 12, 1980

**NOTE:** THIS APPLICATION MUST BE ACCOMPANIED BY A MAP OR MAPS SHOWING THE BEFORE AND AFTER LOCATIONS OF THE POINT OF DIVERSION AND/OR PLACE OF USE, AS THE CASE MAY BE.

**AFFIDAVIT OF APPLICANT**

We X Ross E. Curry and Joyce M. Curry and Norman L. Curry, the applicant herein, being first duly sworn, depose and say that I have read the above and foregoing application for transfer of water right; that I know the contents thereof and that the statements therein made are true and correct to the best of my knowledge and belief.

In Witness Whereof, I have hereunto set my hand this 23<sup>RD</sup> day of JANUARY, 1980.

X Ross E. Curry

X Joyce M. Curry  
(Name of applicant)

X Norman L. Curry

Subscribed and sworn to before me this 23<sup>RD</sup> day of JANUARY, 1980

[Notarial Seal]

Robert P. Anderson  
NOTARY PUBLIC FOR OREGON

My commission expires Nov. 19, 1983

Name and Postoffice Address of Appropriator	Date of Relative Priority	Amount Cubic Feet Per Second	Number Acres	Use	Name of Ditch	Stream	Description of Land or Place of Use
Central Oregon Irrigation District - Continued:							
Leland Scott			63.0				28.0 acres in Lot 3 (NE $\frac{1}{4}$ NW $\frac{1}{4}$ ), 35.0 acres in Lot 4 (NW $\frac{1}{4}$ NW $\frac{1}{4}$ ), Section 2, T. 15 S., R. 14 E., W.M.
Fred Worth			140.0				35.0 acres in the NE $\frac{1}{4}$ SE $\frac{1}{4}$ , 35.0 acres in the NW $\frac{1}{4}$ SE $\frac{1}{4}$ , 35.0 acres in the SW $\frac{1}{4}$ SE $\frac{1}{4}$ , 35.0 acres in the SE $\frac{1}{4}$ SE $\frac{1}{4}$ , Section 2, T. 15 S., R. 14 E., W.M.
E. L. Snable			138.0				24.0 acres in the NE $\frac{1}{4}$ SE $\frac{1}{4}$ , 4.0 acres in the SW $\frac{1}{4}$ SE $\frac{1}{4}$ , 34.0 acres in the SE $\frac{1}{4}$ SE $\frac{1}{4}$ , Section 10, 38.0 acres in the NE $\frac{1}{4}$ NE $\frac{1}{4}$ , 10.0 acres in the NW $\frac{1}{4}$ NE $\frac{1}{4}$ , 28.0 acres in the SE $\frac{1}{4}$ NE $\frac{1}{4}$ , Section 15, T. 15 S., R. 14 E., W.M.
O. Elliott			145.0				35.0 acres in the NE $\frac{1}{4}$ NE $\frac{1}{4}$ , 38.0 acres in the NW $\frac{1}{4}$ NE $\frac{1}{4}$ , 39.0 acres in the SW $\frac{1}{4}$ NE $\frac{1}{4}$ , 33.0 acres in the SE $\frac{1}{4}$ NE $\frac{1}{4}$ , Section 11, T. 15 S., R. 14 E., W.M.
Lynn Fischer			79.0				25.0 acres in the NE $\frac{1}{4}$ NW $\frac{1}{4}$ , 18.0 acres in the SW $\frac{1}{4}$ NW $\frac{1}{4}$ , 36.0 acres in the SE $\frac{1}{4}$ NW $\frac{1}{4}$ , Section 11, T. 15 S., R. 14 E., W.M.
E. B. Williams			406.0				30.0 acres in the NE $\frac{1}{4}$ SW $\frac{1}{4}$ , 32.0 acres in the NW $\frac{1}{4}$ SW $\frac{1}{4}$ , 39.0 acres in the SW $\frac{1}{4}$ SW $\frac{1}{4}$ , 39.0 acres in the SE $\frac{1}{4}$ SW $\frac{1}{4}$ , 37.0 acres in the NE $\frac{1}{4}$ SE $\frac{1}{4}$ , 36.0 acres in the NW $\frac{1}{4}$ SE $\frac{1}{4}$ , 37.0 acres in the SW $\frac{1}{4}$ SE $\frac{1}{4}$ , (c) 23.0 acres in the SE $\frac{1}{4}$ SE $\frac{1}{4}$ , Section 11, (c) 22.0 acres in the NW $\frac{1}{4}$ SW $\frac{1}{4}$ , Section 12, (c) 8.0 acres in the NE $\frac{1}{4}$ NE $\frac{1}{4}$ , 38.0 acres in the NW $\frac{1}{4}$ NE $\frac{1}{4}$ , (c) 30.0 acres in the SW $\frac{1}{4}$ NE $\frac{1}{4}$ , (c) 6.0 acres in the SE $\frac{1}{4}$ NE $\frac{1}{4}$ , (c) 15.0 acres in the NE $\frac{1}{4}$ SE $\frac{1}{4}$ , (c) 14.0 acres in the NW $\frac{1}{4}$ SE $\frac{1}{4}$ , Section 14, T. 15 S., R. 14 E., W.M.
Henry Cooper			51.0				21.0 acres in the SW $\frac{1}{4}$ NE $\frac{1}{4}$ , 30.0 acres in the SE $\frac{1}{4}$ NE $\frac{1}{4}$ , Section 12, T. 15 S., R. 14 E., W.M.
Harold Worth			68.0				33.0 acres in the NE $\frac{1}{4}$ NW $\frac{1}{4}$ , 35.0 acres in the NW $\frac{1}{4}$ NW $\frac{1}{4}$ , Section 12, T. 15 S., R. 14 E., W.M.
Nettie Smith			25.0				15.0 acres in the SE $\frac{1}{4}$ NW $\frac{1}{4}$ , 10.0 acres in the NE $\frac{1}{4}$ SW $\frac{1}{4}$ , Section 12, T. 15 S., R. 14 E., W.M. Creek County

T-4396

1-1-74

WARRANTY DEED



KNOW ALL MEN BY THESE PRESENTS, That LYNN M. FISCHER and BESSIE FISCHER, husband and wife

hereinafter called the grantor, for the consideration hereinafter stated, to grantor paid by NORMAN L. CURRY and DORIS M. CURRY, husband and wife

the grantee, does hereby grant, bargain, sell and convey unto the said grantee and grantee's heirs, successors and assigns, that certain real property, with the tenements, hereditaments and appurtenances thereunto belonging or appertaining, situated in the County of CROOK and State of Oregon, described as follows, to-wit:

A parcel of land in the Northwest quarter of section 11 in Township 15 South of Range 14 East of the Willamette Meridian, more particularly described as follows: Beginning at a point 881 feet West of the Northeast corner of the Northwest quarter of said section 11, thence South 1019 feet, thence West 189 feet to the East line of the Central Oregon Irrigation District Waste Ditch, as now located and constructed, thence along the East line of said Waste Ditch in a Southeasterly direction to a point 2065 feet, more or less, South of the Northeast corner of the Northwest quarter of said Section 11, thence South to the Southeast corner of the Northwest 1/4 of said Section 11, thence West along the South line of the Northwest quarter of said Section 11 to the West line of the Central Oregon Irrigation District Canal, as now located and constructed, thence North along the West line of said Canal a distance of 2149 feet, more or less, to a point where said Canal bears in a Westerly direction, thence North 200 feet, more or less, to a point on the Southerly line of a tract of land deeded to

(IF SPACE INSUFFICIENT, CONTINUE DESCRIPTION ON REVERSE SIDE) (SEE REVERSE SIDE)

To Have and to Hold the same unto the said grantee and grantee's heirs, successors and assigns forever.

And said grantor hereby covenants to and with said grantee and grantee's heirs, successors and assigns, that grantor is lawfully seized in fee simple of the above granted premises, free from all encumbrances Except those of record.

and that grantor will warrant and forever defend the said premises and every part and parcel thereof against the lawful claims and demands of all persons whomsoever, except those claiming under the above described encumbrances.

The true and actual consideration paid for this transfer, stated in terms of dollars, is \$ 36,000.00

the whole part of the

In construing this deed and where the context so requires, the singular includes the plural and all grammatical changes shall be implied to make the provisions hereof apply equally to corporations and to individuals.

In Witness Whereof, the grantor has executed this instrument this 30 day of October, 1974; if a corporate grantor, it has caused its name to be signed and seal affixed by its officers, duly authorized thereto by order of its board of directors.

Lynn M. Fischer
LYNN M. FISCHER

Bessie Fischer
BESSIE FISCHER

(If executed by a corporation, affix corporate seal)

STATE OF OREGON, County of CROOK, ss. October 30, 1974

STATE OF OREGON, County of ... ss. 19...

Personally appeared the above named Lynn M. Fischer and Bessie Fischer, husband and wife

Personally appeared ... and who, being duly sworn, each for himself and not one for the other, did say that the former is the president and that the latter is the secretary of

and acknowledged the foregoing instrument to be ... voluntary act and deed.

a corporation, and that the seal affixed to the foregoing instrument is the corporate seal of said corporation and that said instrument was signed and sealed in behalf of said corporation by authority of its board of directors; and each of them acknowledged said instrument to be its voluntary act and deed.

Notary Public for Oregon My commission expires March 6 1977

Before me: Notary Public for Oregon My commission expires:

Lynn M. Fischer and Bessie Fischer Powell Butte, Oregon 97753

28942 STATE OF OREGON, County of Crook, ss.

GRANTOR'S NAME AND ADDRESS Norman and Doris Curry 2276 Christy lane Los Vegas, Nevada 89110

I certify that the within instrument was received for record on the 8 day of November, 1974, at 11:55 o'clock A.M., and recorded in book MF on page 28942 or as file/reel number

GRANTEE'S NAME AND ADDRESS After recording return to: Norman Curry 2276 Christy Lane Los Vegas, Nevada 89110

Record of Deeds of said county. Witness my hand and seal of County affixed.

NAME, ADDRESS, ZIP Until a change is requested all tax statements shall be sent to the following address: Norman Curry 2276 Christy Lane Los Vegas, Nevada 89110

By Grace G. Bannon Recording Officer Carmel Hibbard Deputy

\*\*\*\*\*  
Eben Ray and wife by deed recorded in Book 66 of Deeds at page 252,  
Records of Crook County, Oregon, thence East along the Southerly line  
of said tract 60 feet, more or less, to the Southeast corner thereof,  
said point being on the East line of the NW $\frac{1}{4}$ NW $\frac{1}{4}$  of said Section 11,  
thence North to the Northeast corner of the NW $\frac{1}{4}$ NW $\frac{1}{4}$  of said Section 11,  
thence East to the point of beginning.  
\*\*\*\*\*

RECEIVED

FEB 19 1980


T-4396

NW 1/4 SECTION 11 WATER RESOURCES DEPT

SALEM, OREGON

T. 15 S R. 14 E W M

SCALE = 1" = 400'

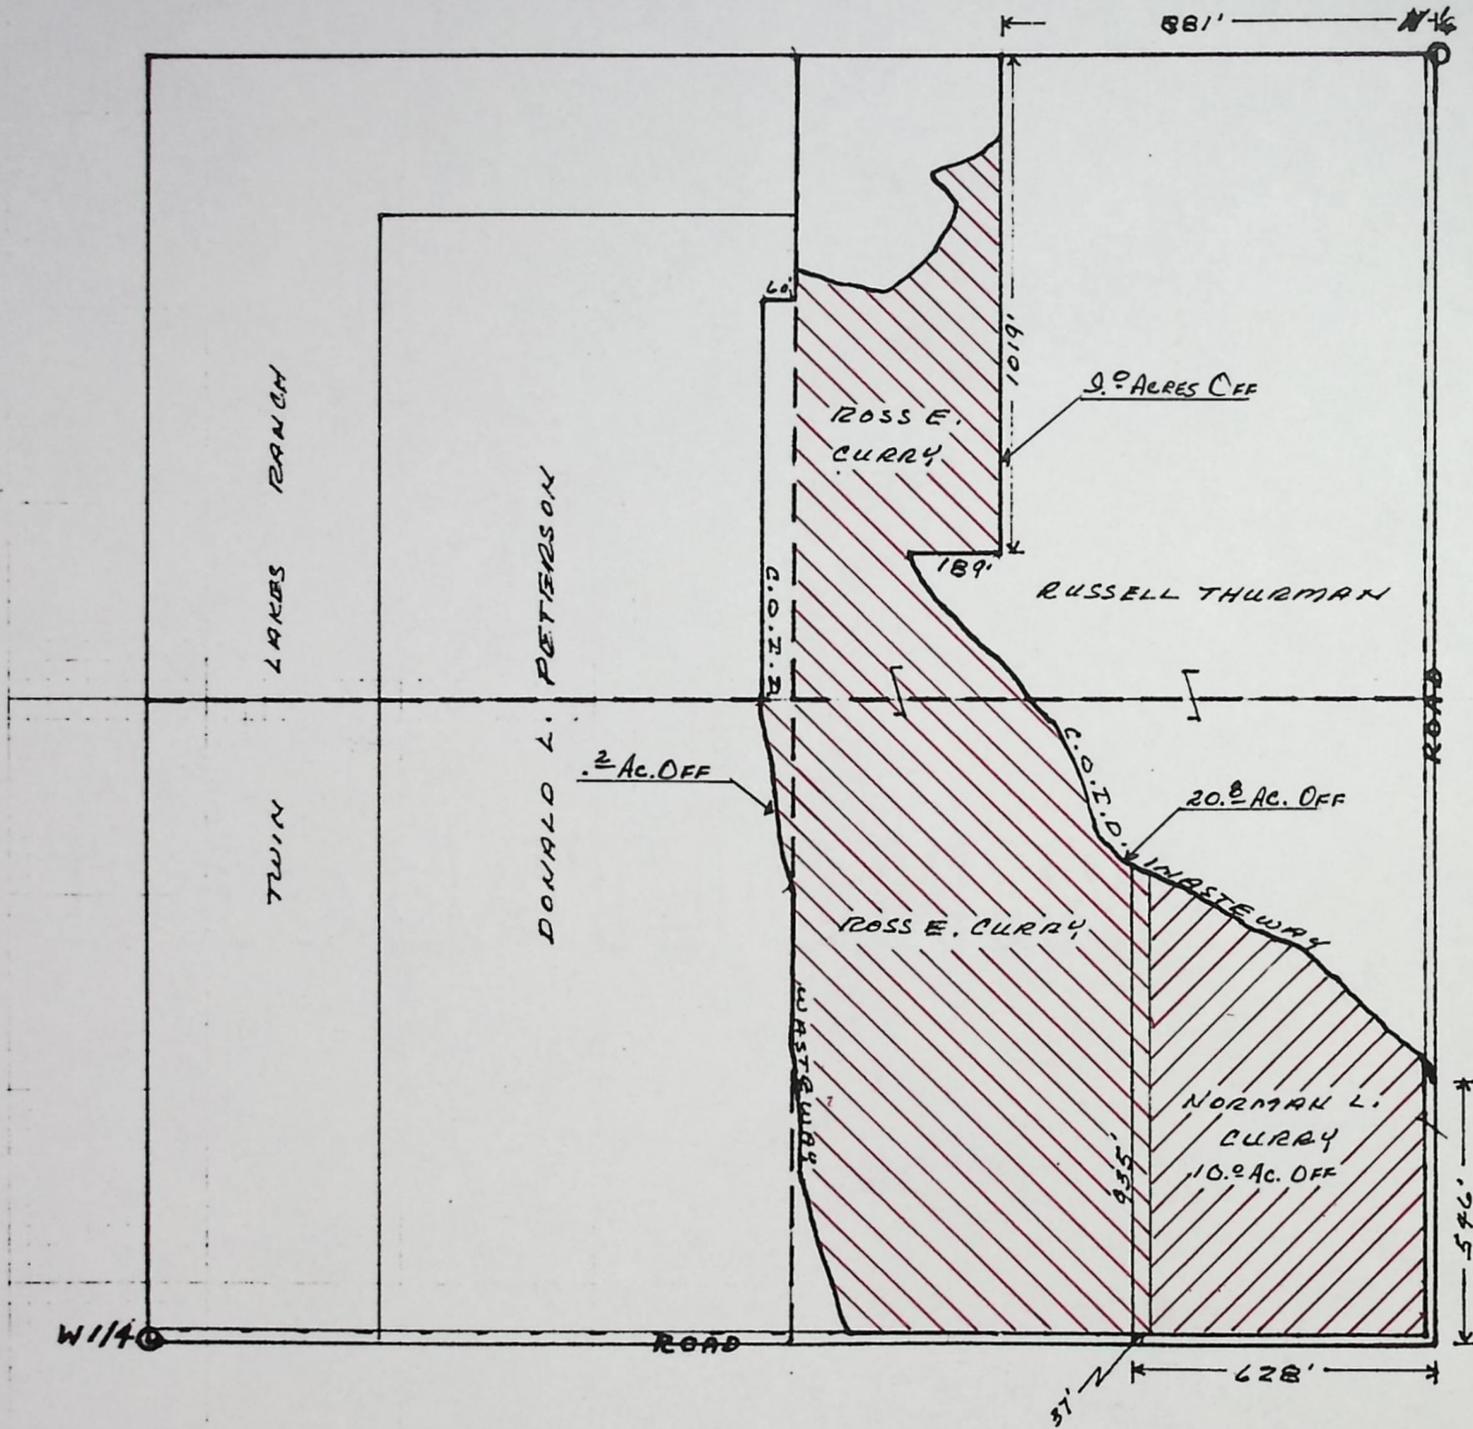

T-4396  
RECEIVED

FEB 19 1980  
WATER RESOURCES DEPT.  
SALEM, OREGON

STATUTORY WARRANTY DEED

NORMAN L. CURRY and DORIS M. CURRY, husband and wife, Grantors, convey and warrant to ROSS E. CURRY and JOYCE M. CURRY, husband and wife, Grantees, the following described real property, free of encumbrances except as specifically set forth herein:

A parcel of land in the Northwest Quarter of Section Eleven (11) in Township Fifteen (15) South of Range Fourteen (14), East of the Willamette Meridian, more particularly described as follows: Beginning at a point 881 feet West of the Northeast corner of the Northwest Quarter of said Section 11; thence South 1019 feet; thence West 189 feet to the East line of the Central Oregon Irrigation District waste ditch, as now located and constructed; thence along the East line of said waste ditch in a Southeasterly direction to a point 2065 feet, more or less, South of the Northeast corner of the Northwest Quarter of said Section 11; thence South to the Southeast corner of the Northwest Quarter of said Section 11; thence West along the South line of the Northwest Quarter of said Section 11 to the West line of the Central Oregon Irrigation District Canal, as now located and constructed; thence North along the West line of said Canal a distance of 2149 feet, more or less, to a point where said Canal bears in a Westerly direction; thence North 200 feet, more or less, to a point on the Southerly line of a tract of land deeded to Eben Ray and wife by deed recorded in Book 66 of Deeds at page 252, Records of Crook County, Oregon; thence East along the Southerly line of said Tract 60 feet, more or less, to the Southeast corner thereof, said point being on the East line of the Northwest Quarter of the Northwest Quarter of said Section 11; thence North to the Northeast corner of the Northwest Quarter of the Northwest Quarter of said Section 11; thence East to the point of beginning



TO: TRANSFERS, WATER RIGHTS DIVISION

DATE: Feb 27, 1980.

FROM: \*\* Bob Main, Watermaster

SUBJECT: WATER RIGHT TRANSFER APPLICATION NO. 4396

IN THE NAME OF Ross, Joyce + Norman Curry

In my opinion the proposed change in POU of water from Deschutes River  
MAY BE MADE WITHOUT INJURY WOULD RESULT IN INJURY\* to an existing water right.

Headgate notices HAVE HAVE NOT been issued for diversion from the sources which serves this right.

If for change in point of diversion, is there any intervening point of diversion between the authorized and the proposed points of diversion? \_\_\_\_\_  
(yes or no)

In my opinion, the order approving the subject transfer application should include the following in regard to the appropriator installing suitable measuring devices in the diversion works:

- \_\_\_\_ (1) PRIOR to the diverting of water at the new point of diversion . . .
- X (2) When in the judgment of the watermaster it becomes necessary . . .

\* The approval of this transfer application would result in injury to other water rights because \_\_\_\_\_  
\_\_\_\_\_  
\_\_\_\_\_

\*\* *Quane Clark*  
Watermaster's signature or initials

EXCEPTING the following described property:  
Beginning at a point 881 feet West of the  
Northeast Quarter corner of the Northwest  
Quarter of said Section 11; thence South  
1,019 feet; thence West 189 feet to the  
East line of the Central Oregon Irrigation  
District waste ditch, as now located; thence  
along the East line of said waste ditch in  
a Southeasterly direction to a point 1,287  
feet to the true point of beginning of the  
land excepted hereunder; thence continuing  
along the East line of said waste ditch in  
a Southeasterly direction 778 feet; thence  
South 546 feet, more or less, to the South-  
east corner of the Northwest Quarter of said  
Section 11; thence West along the South line  
of the Northwest Quarter of said Section 11  
628 feet; thence North 955 feet to the true  
point of beginning.

Subject to and excepting:

1. Easements, restrictions and rights-of-way of record.

The true and actual consideration for this conveyance  
is TWENTY-FIVE THOUSAND FIVE HUNDRED SIXTY DOLLARS (\$25,560.00).

Until a change is requested, all tax statements are  
to be sent to the following address:

Ross E. and Joyce M. Curry

Powell Butte, Oregon 97755

DATED this 20<sup>th</sup> day of March, 1979.

Norman L. Curry  
NORMAN L. CURRY

Doris M. Curry  
DORIS M. CURRY


STATE OF OREGON )  
County of Deschutes ) ss.

March 20, 1979.

Personally appeared before me the above-named  
NORMAN L. CURRY and DORIS M. CURRY, husband and wife, and  
acknowledged the foregoing instrument to be their voluntary  
act and deed.

Christine A. Fisher  
Notary Public for Oregon  
My commission expires: 2-26-81

T-4396

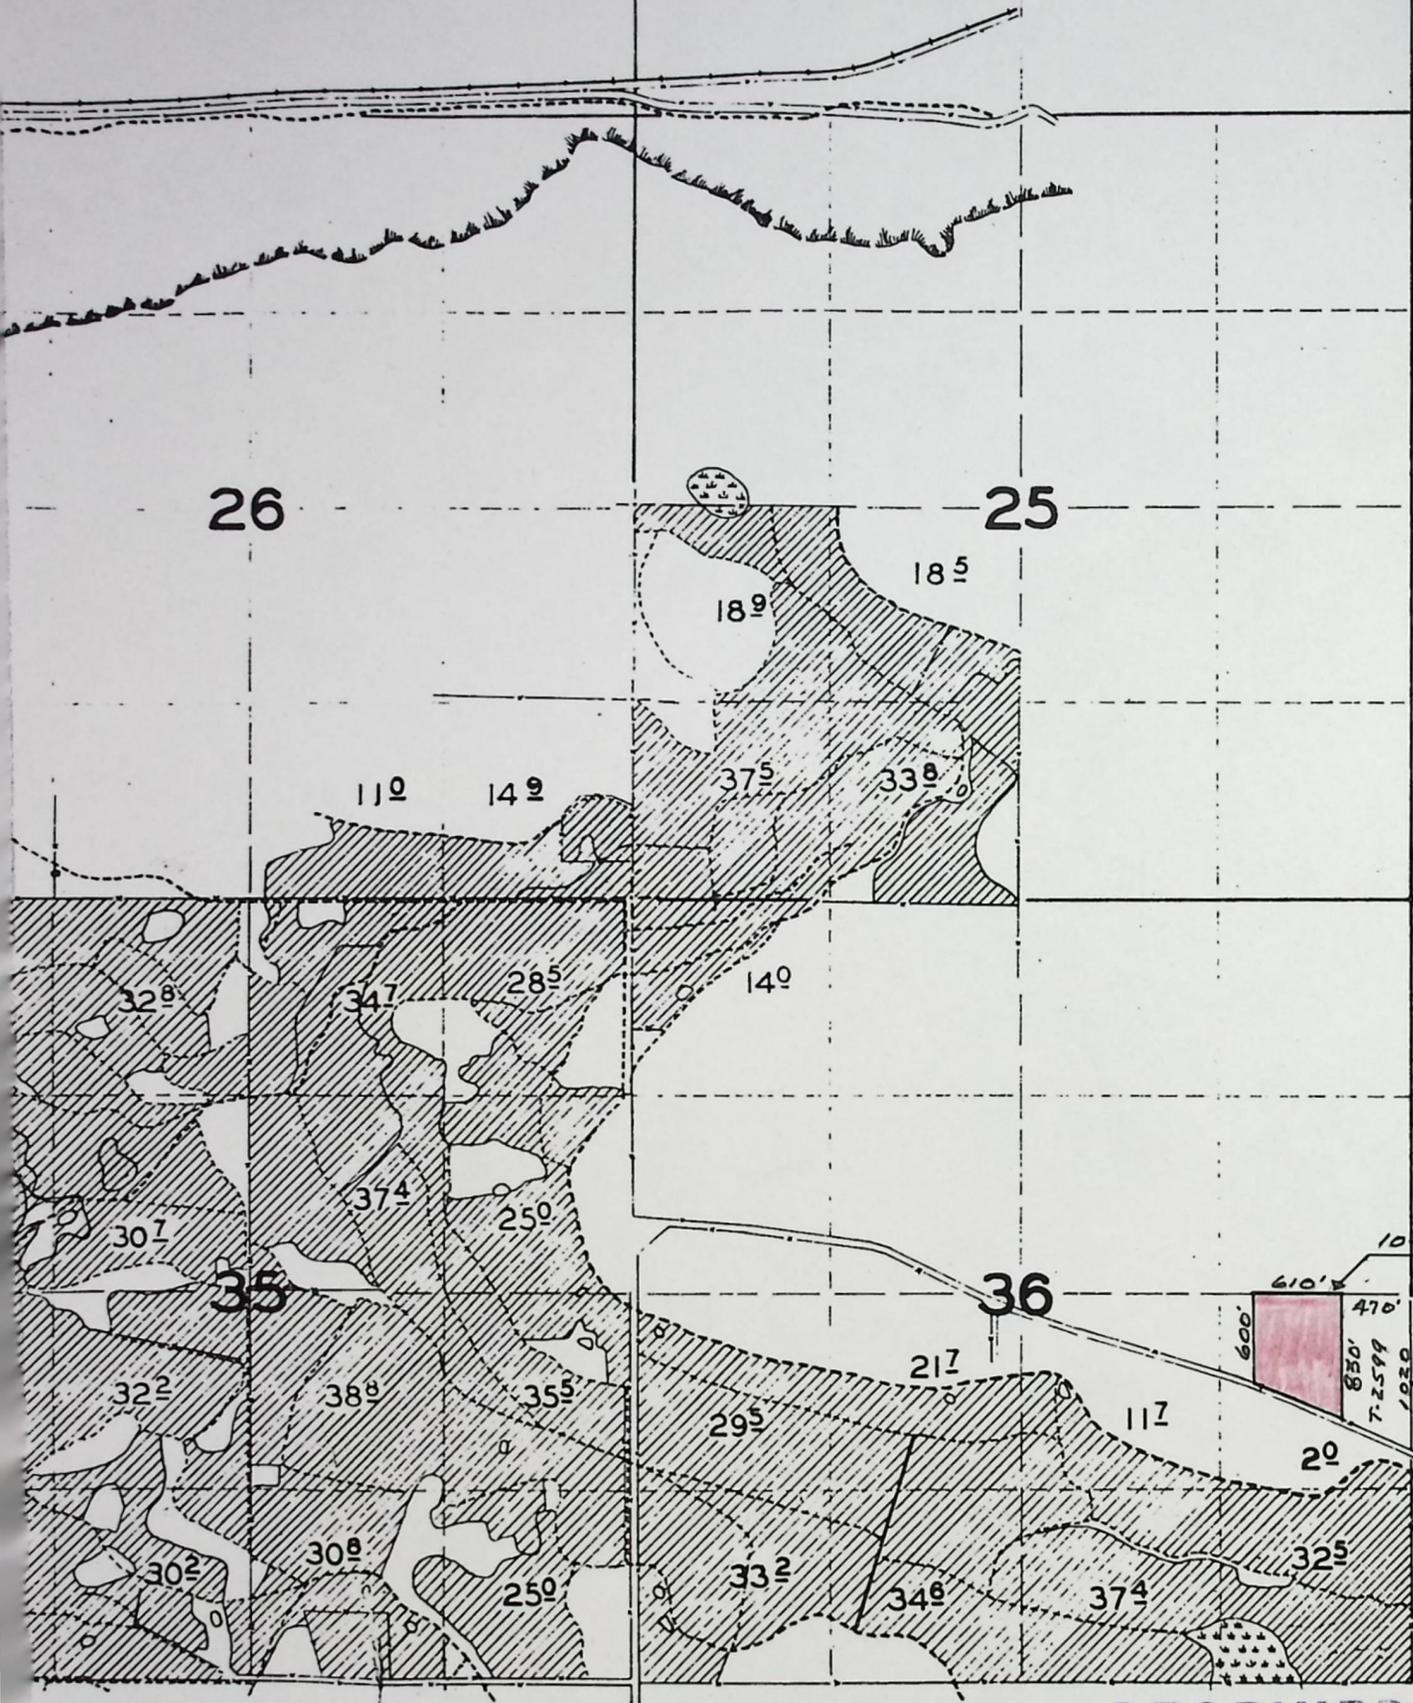

RECEIVED

FEB 19 1980

WATER RESOURCES DEPT.  
SALEM, OREGON

JULY 2, 6, 12-15, 1948

JULY 25, SEPT 13, 1950

4-1-9

3



T-4396

# TOWNSHIP

RECEIVED  
FEB 19 1980  
WATER RESOURCES DEPT.  
SALEM, OREGON

