

Owyhee Irrigation District


SEC. 34 T16S R47E

Scale - 1" = 400'

DINN: 23-71800

Transfer Number: T-14375

NW 1/4 of the NW 1/4

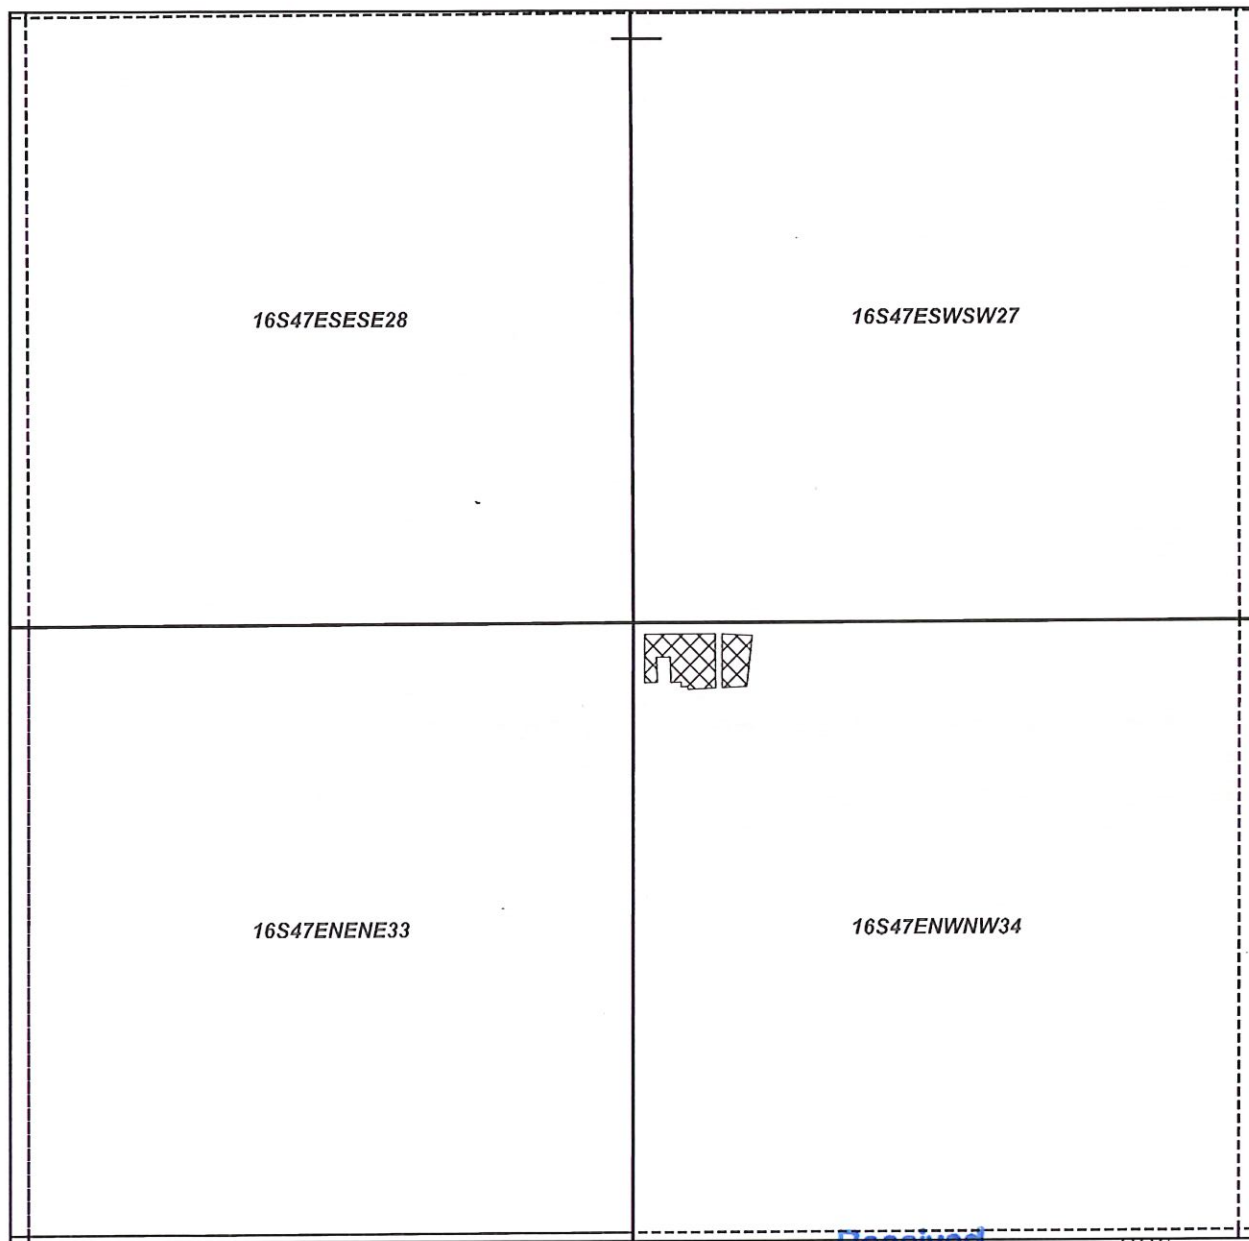

Received

OCT 14 2025

OWRD

☒ On
☐ Off

Current Cert. 75691

"ON" Map

Claim of Beneficial Use Map

NAME: Nancy Allen

TAXLOT - 700, 16S47E34 NW/NW: 0.51 Acres ON, 15.8 Acres Remaining (Cert 75691 IR)



Date: 8/28/2025

Owyhee Irrigation District


SEC. 32 T18S R46E

Scale - 1" = 400'

DINN: 23-44900

Transfer Number: T-14375

SE 1/4 of the SE 1/4

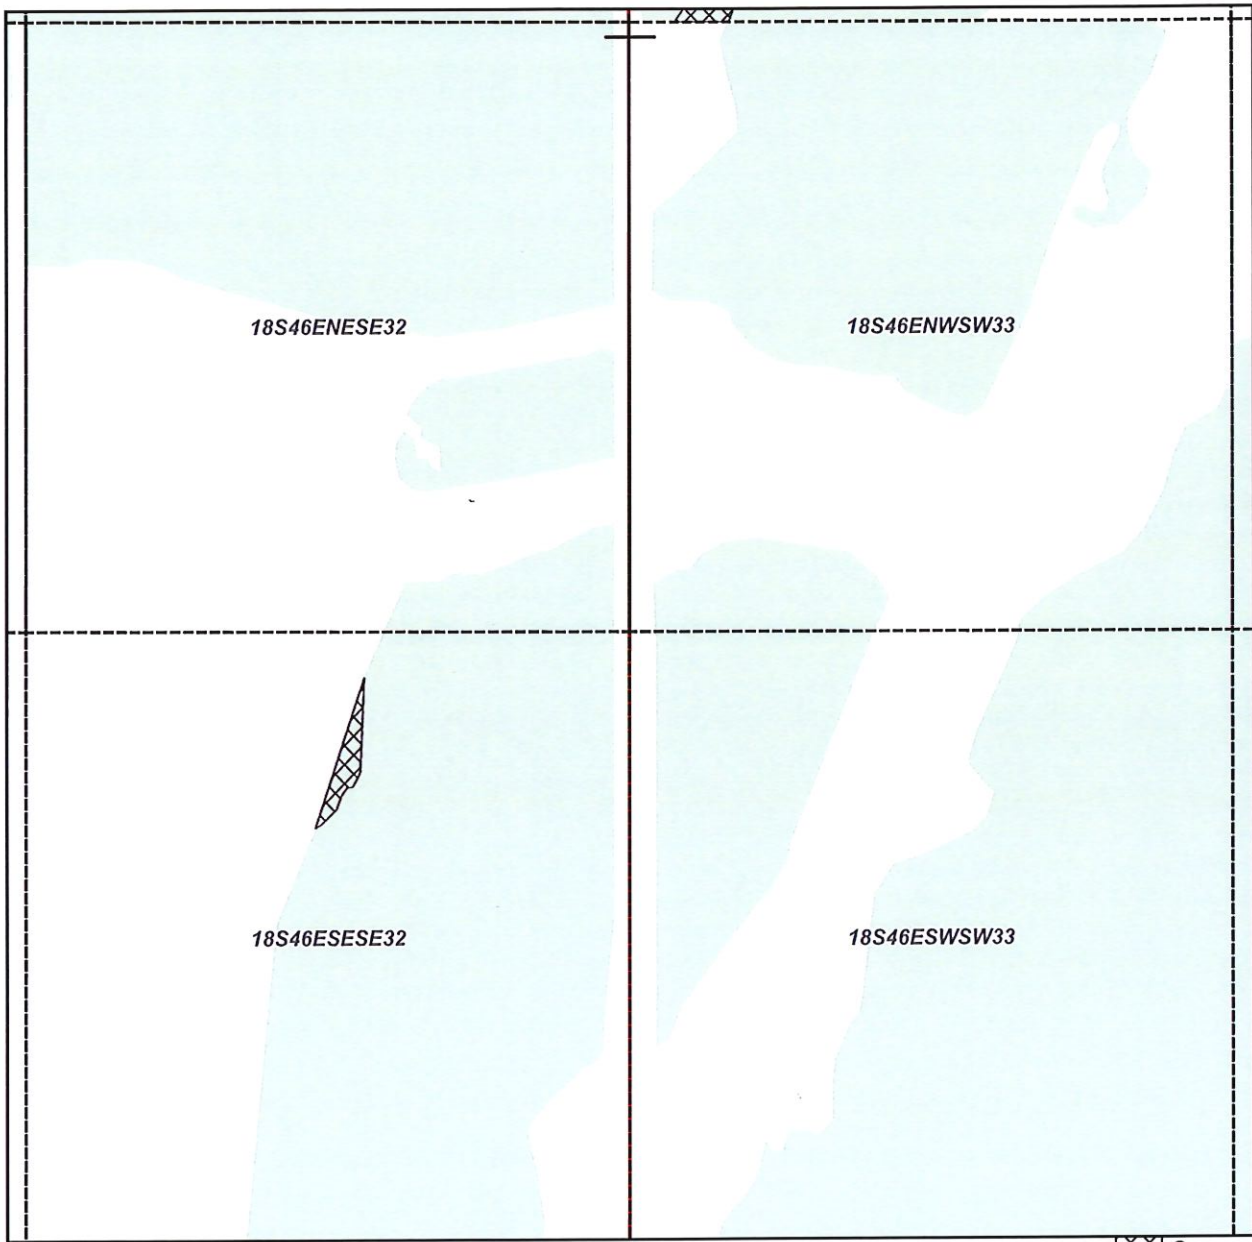

On
Off
Current Cert. 75691

"ON" Map

Received

OCT 14 2025

OWRD

Claim of Beneficial Use Map

NAME: Roger Enszt

TAXLOT - 800, 18S46E32 SE/SE: 0.24 Acres ON, 19.59 Acres Remaining (Cert 75691 IR)



Date: 8/29/2025

Owyhee Irrigation District

SEC. 35 T18S R46E


Scale - 1" = 400'

DINN: 23-41800

Transfer Number: T-14375

NW 1/4 of the SW 1/4

NE 1/4 of the SW 1/4

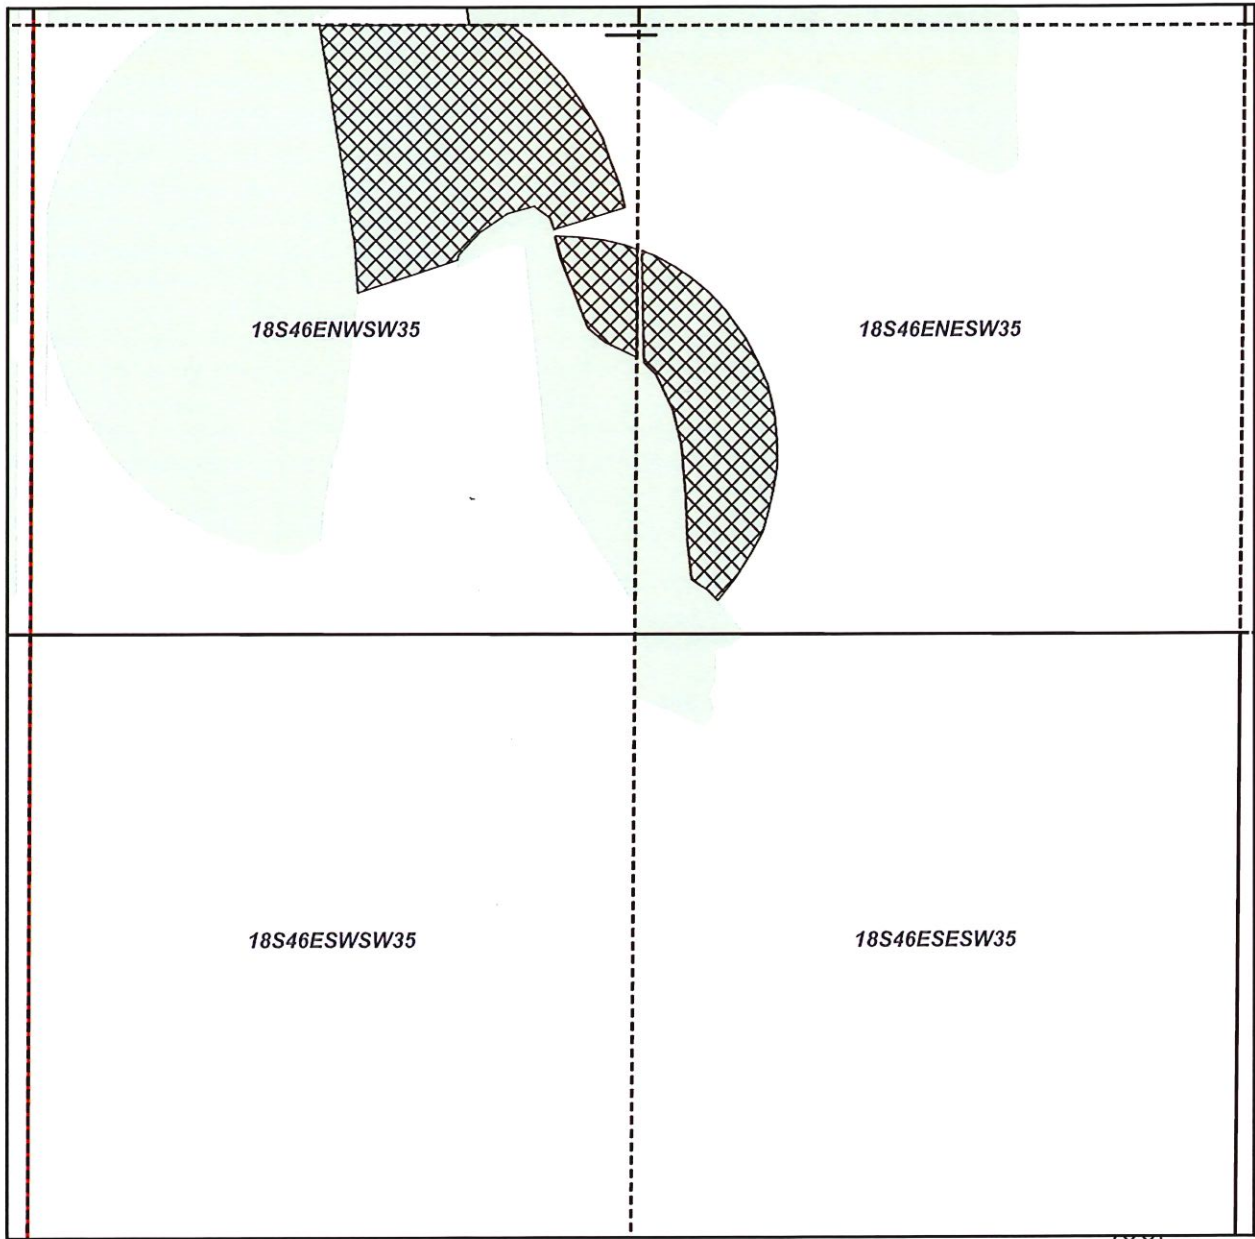

On
Off
Current Cert. 75691

"ON" Map

Received
SEP 14 2025

OWRD

Claim of Beneficial Use Map

Nick Van Engen

TAXLOT - 300, 18S46E35 NW/SW: 6.63 Acres ON, 24.18 Acres Remaining (Cert 75691 IR)

TAXLOT - 300, 18S46E35 NE/SW: 3.05 Acres ON, 4.35 Acres Remaining (Cert 75691 IR)



Date: 9/8/2025

Owyhee Irrigation District

SEC. 35 T18S R46E


Scale - 1" = 400'

DINN: 23-41800

Transfer Number: T-14375

NW 1/4 of the NW 1/4

SW 1/4 of the NW 1/4

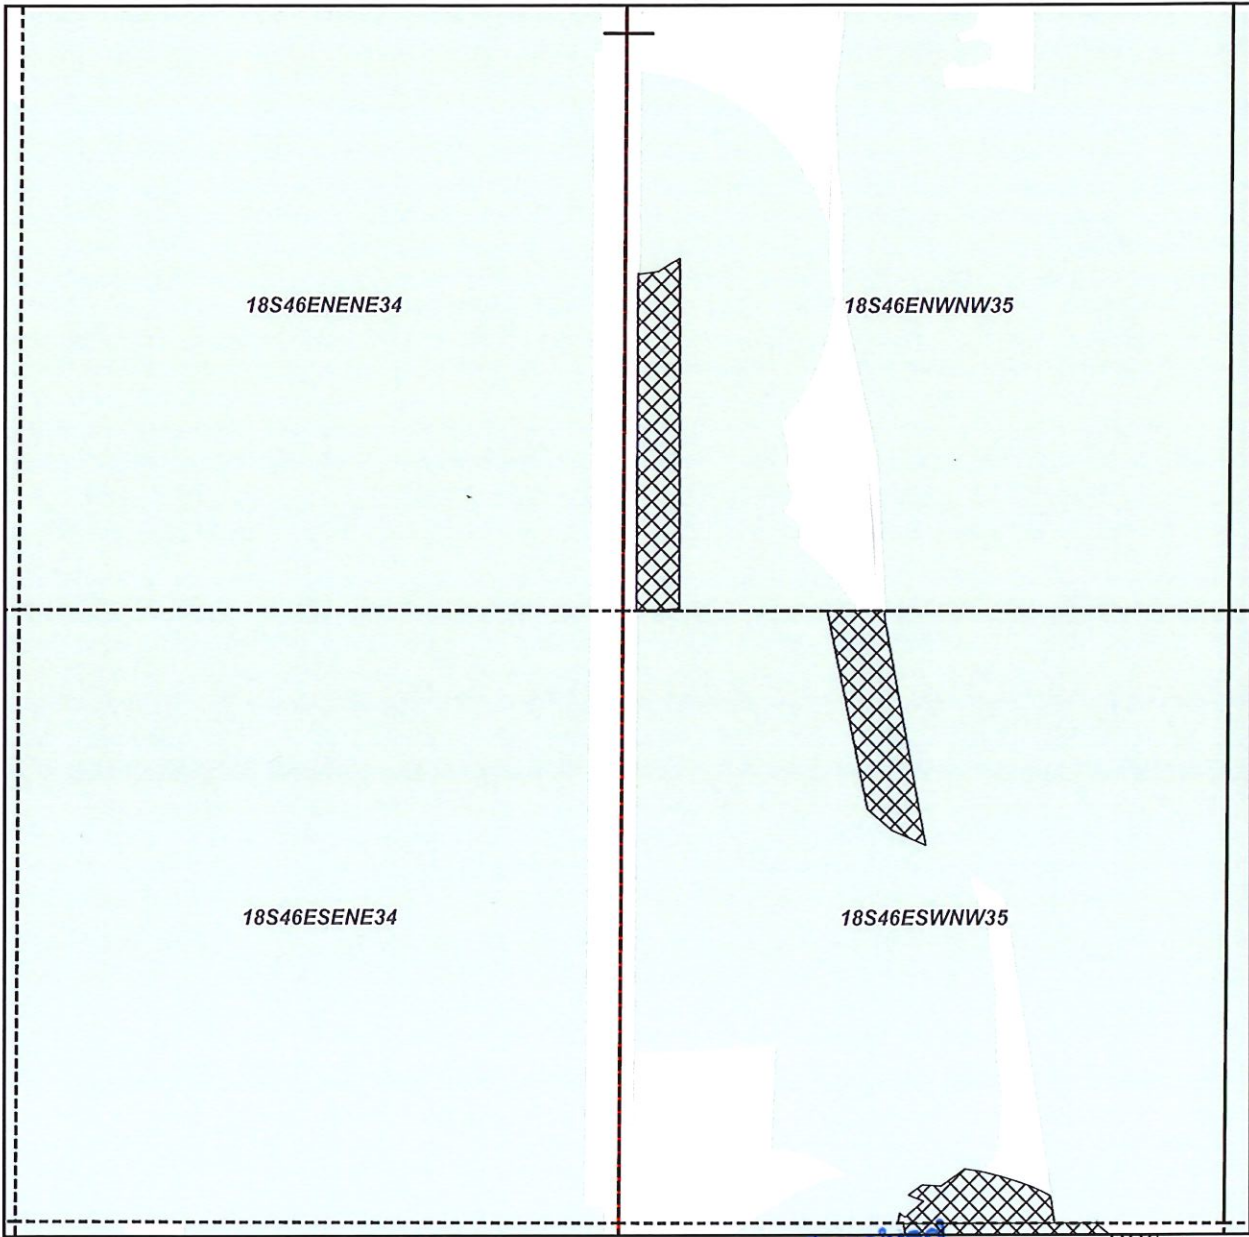

Received
OCT 14 2025
OWIRD

On
Off
Current Cert. 75691

"ON" Map

Claim of Beneficial Use Map

Nick Van Engen

TAXLOT - 300, 18S46E35 NW/NW: 1.56 Acres ON, 5 Acres Remaining (Cert 75691 IR)

TAXLOT - 300, 18S46E35 SW/NW: 1.69 Acres ON, 7.24 Acres Remaining (Cert 75691 IR)




Date: 9/8/2025

Owyhee Irrigation District

SEC. 34 T18S R46E

DINN: 23-43400
Transfer Number: T-14375

Scale - 1" = 400'
NW 1/4 of the SW 1/4
SW 1/4 of the SW 1/4

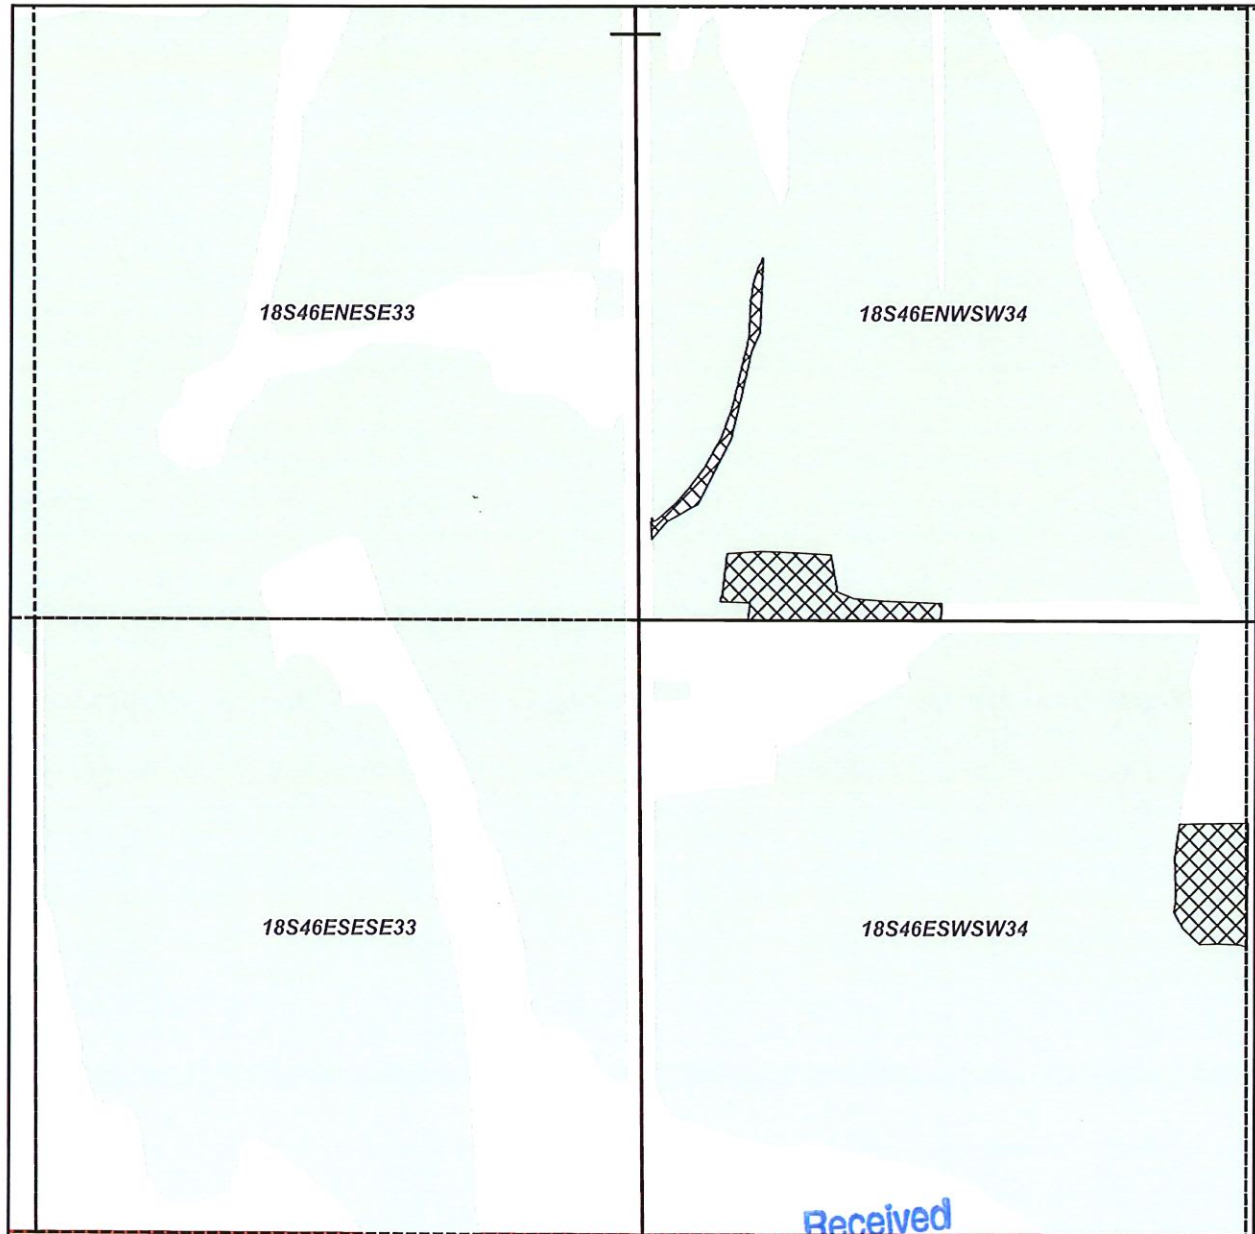

 On
 Off
Current Cert. 75691

"ON" Map

Claim of Beneficial Use Map

NAME: Alvin & Jeanna Hall

TAXLOT - 900, 18S46E34 NW/SW: 1.27 Acres ON, 18.82 Acres Remaining (Cert 75691 IR)
TAXLOT - 900, 18S46E34 SW/SW: .91 Acres ON, 30.88 Acres Remaining (Cert 75691 IR)



Date: 9/8/2025

Owyhee Irrigation District


SEC. 5 T20S R46E

Scale - 1" = 400'

SE 1/4 of the SW 1/4

DINN: 23-23003

Transfer Number: T-14375

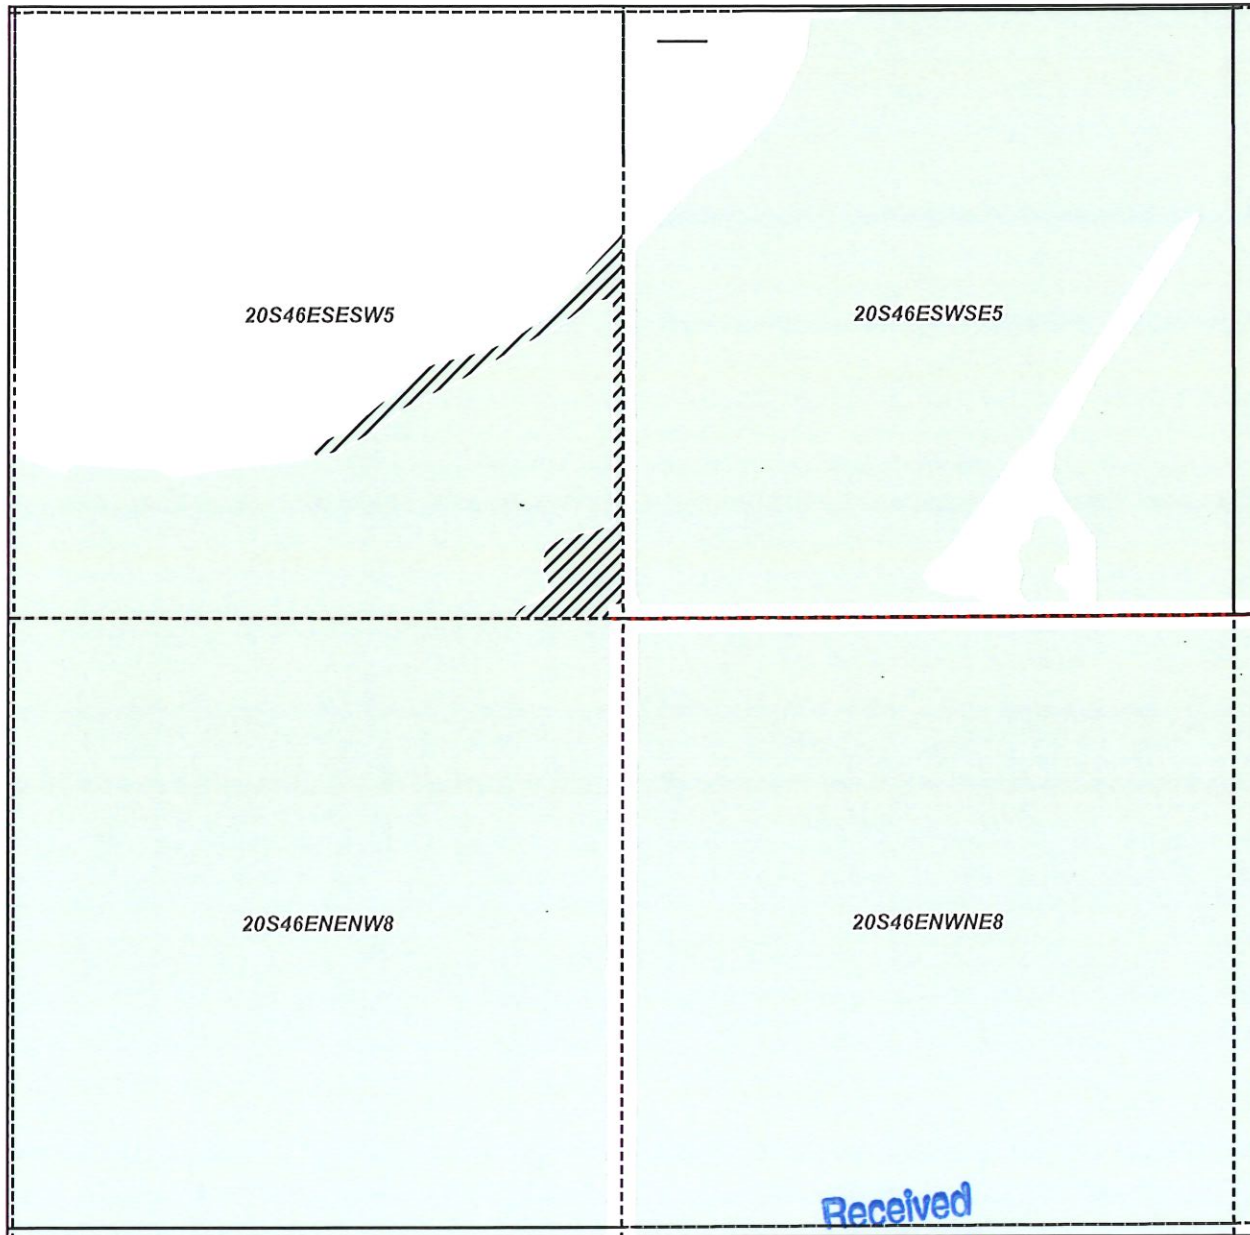

"ON" Map

Claim of Beneficial Use Map

Kiah Jones

TAXLOT - 801, 20S46E5 SE/SW: 1.7 Acres ON, 13.13 Acres Remaining (Cert 75691 IR)



Date: 10/10/2025

Owyhee Irrigation District


SEC. 33 T18S R46E

Scale - 1" = 400'

DINN: 23-48100

Transfer Number: T-14375

NW 1/4 of the NW 1/4

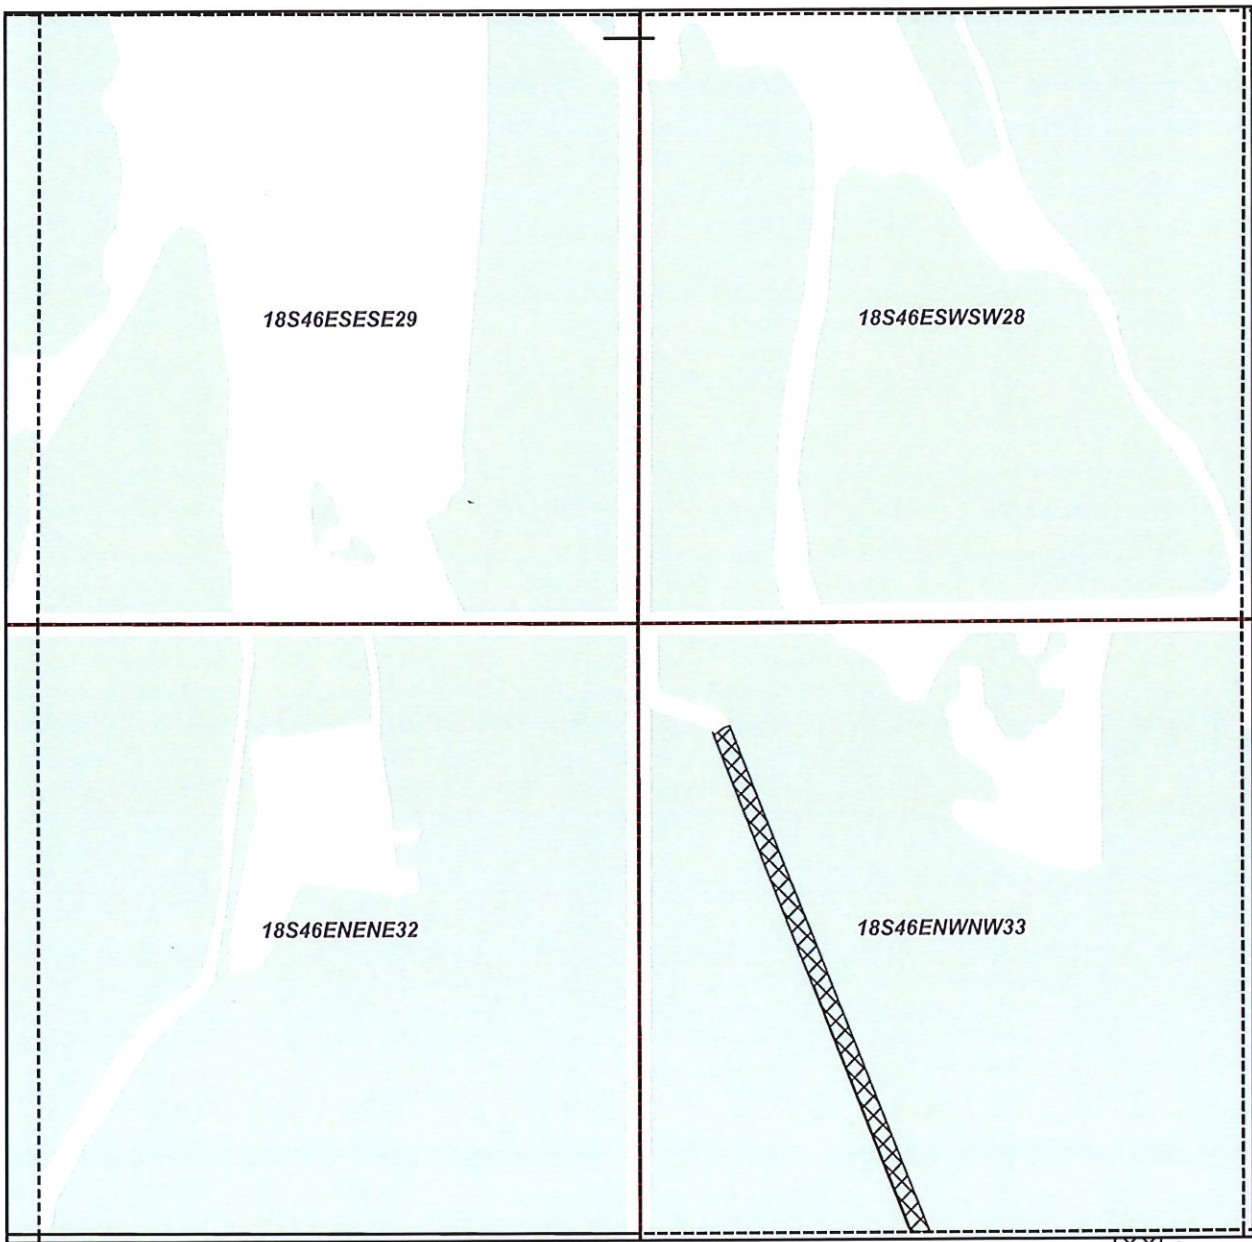

On
Off

Current Cert. 75691

"ON" Map

Received
OCT 14 2025

OWRD

Claim of Beneficial Use Map

NAME: David Tschida

TAXLOT - 600, 18S46E33 NW/NW: 1.08 Acres ON, 34.3 Acres Remaining (Cert 75691 IR)



Date: 8/29/2025

Owyhee Irrigation District


SEC. 33 T18S R46E

Scale - 1" = 400'

DINN: 23-50000

Transfer Number: T-14375

SW 1/4 of the NW 1/4

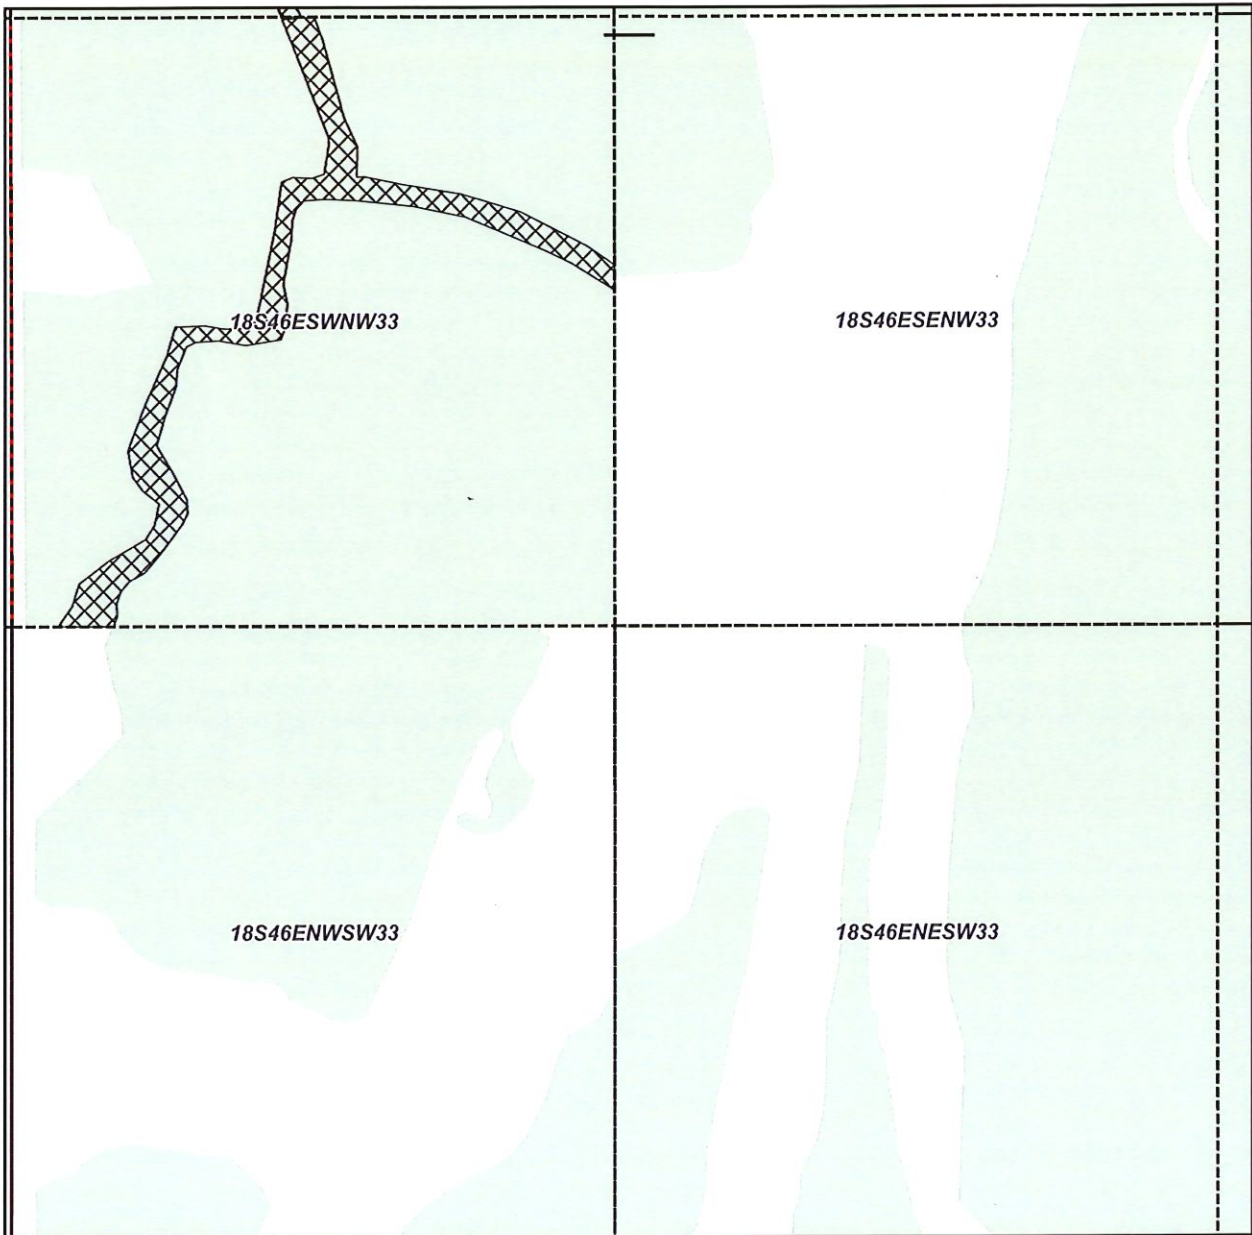

 On
Off
 Current Cert. 75691

"ON" Map

Received
OCT 14 2025

OWIRD

Claim of Beneficial Use Map

NAME: Fred Hussey

TAXLOT - 700, 18S46E33 SW/NW: 2.83 Acres ON, 35.5 Acres Remaining (Cert 75691 IR)



Date: 8/29/2025

Owyhee Irrigation District


SEC. 29 T17S R47E

Scale - 1" = 400'

DINN: 23-58201

Transfer Number: T-14375

NE 1/4 of the NW 1/4

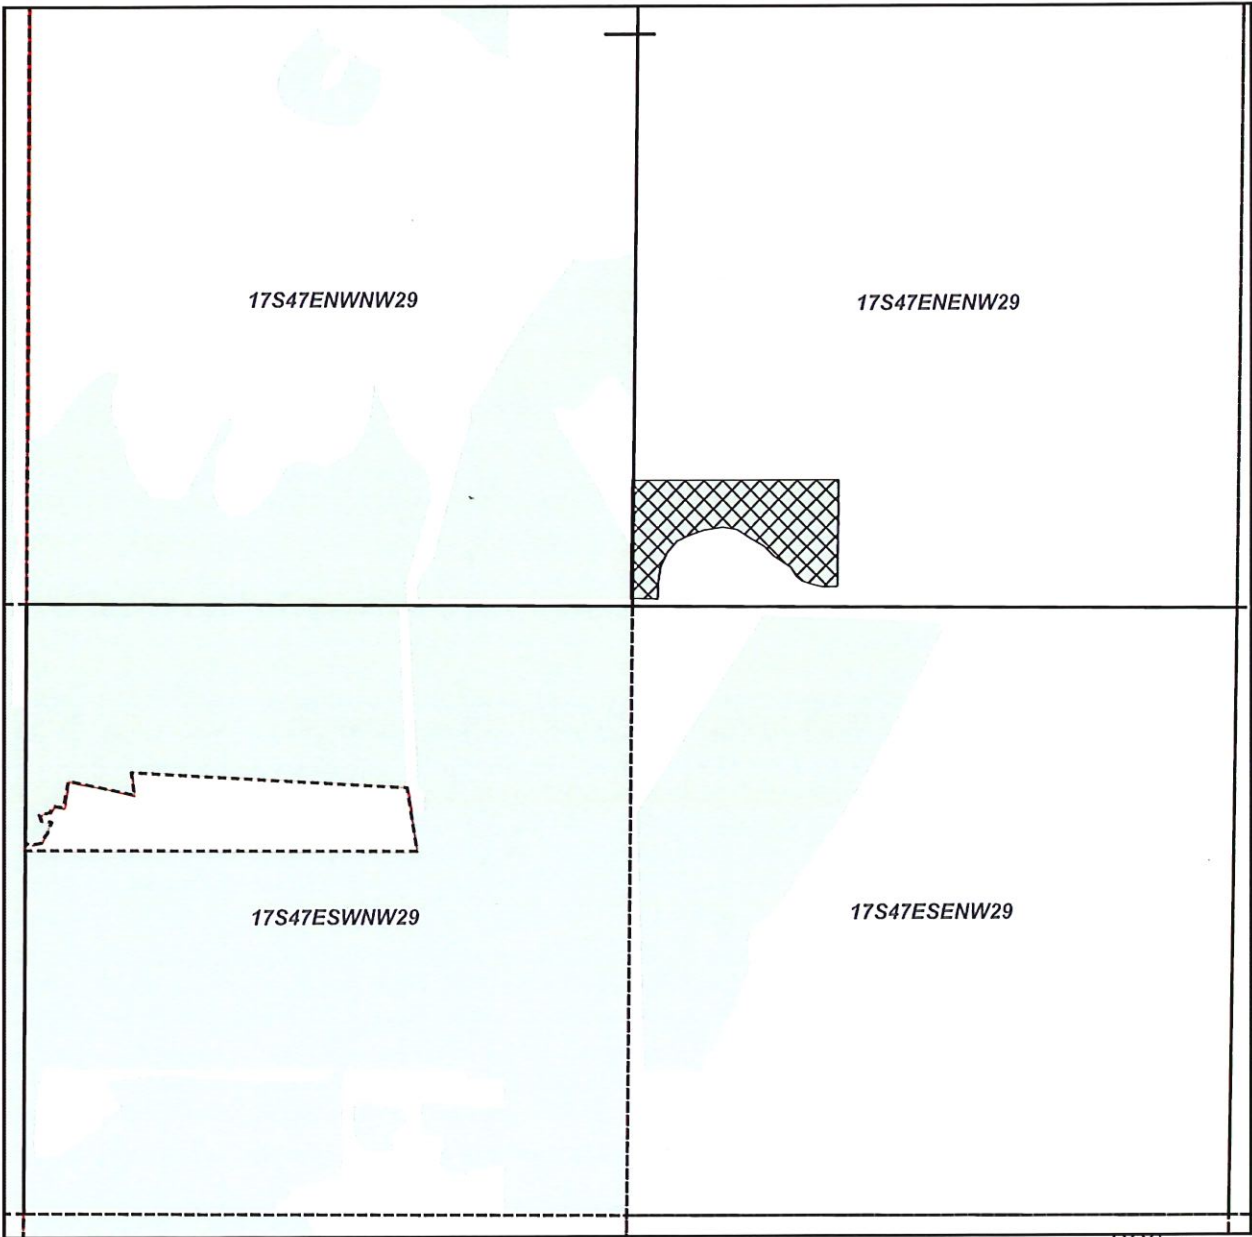

On
Off
Current Cert. 75691

"ON" Map

Received
OCT 14 2025

OWRD

Claim of Beneficial Use Map

NAME: Lance King

TAXLOT - 1104, 17S47E29 NE/NW: 1.07 Acres ON, 1.07 Acres Remaining (Cert 75691 IR)



Date: 8/28/2025

Owyhee Irrigation District


SEC. 27 T18S R46E

Scale - 1" = 400'

DINN: 23-41500

Transfer Number: T-14375

NW 1/4 of the NW 1/4

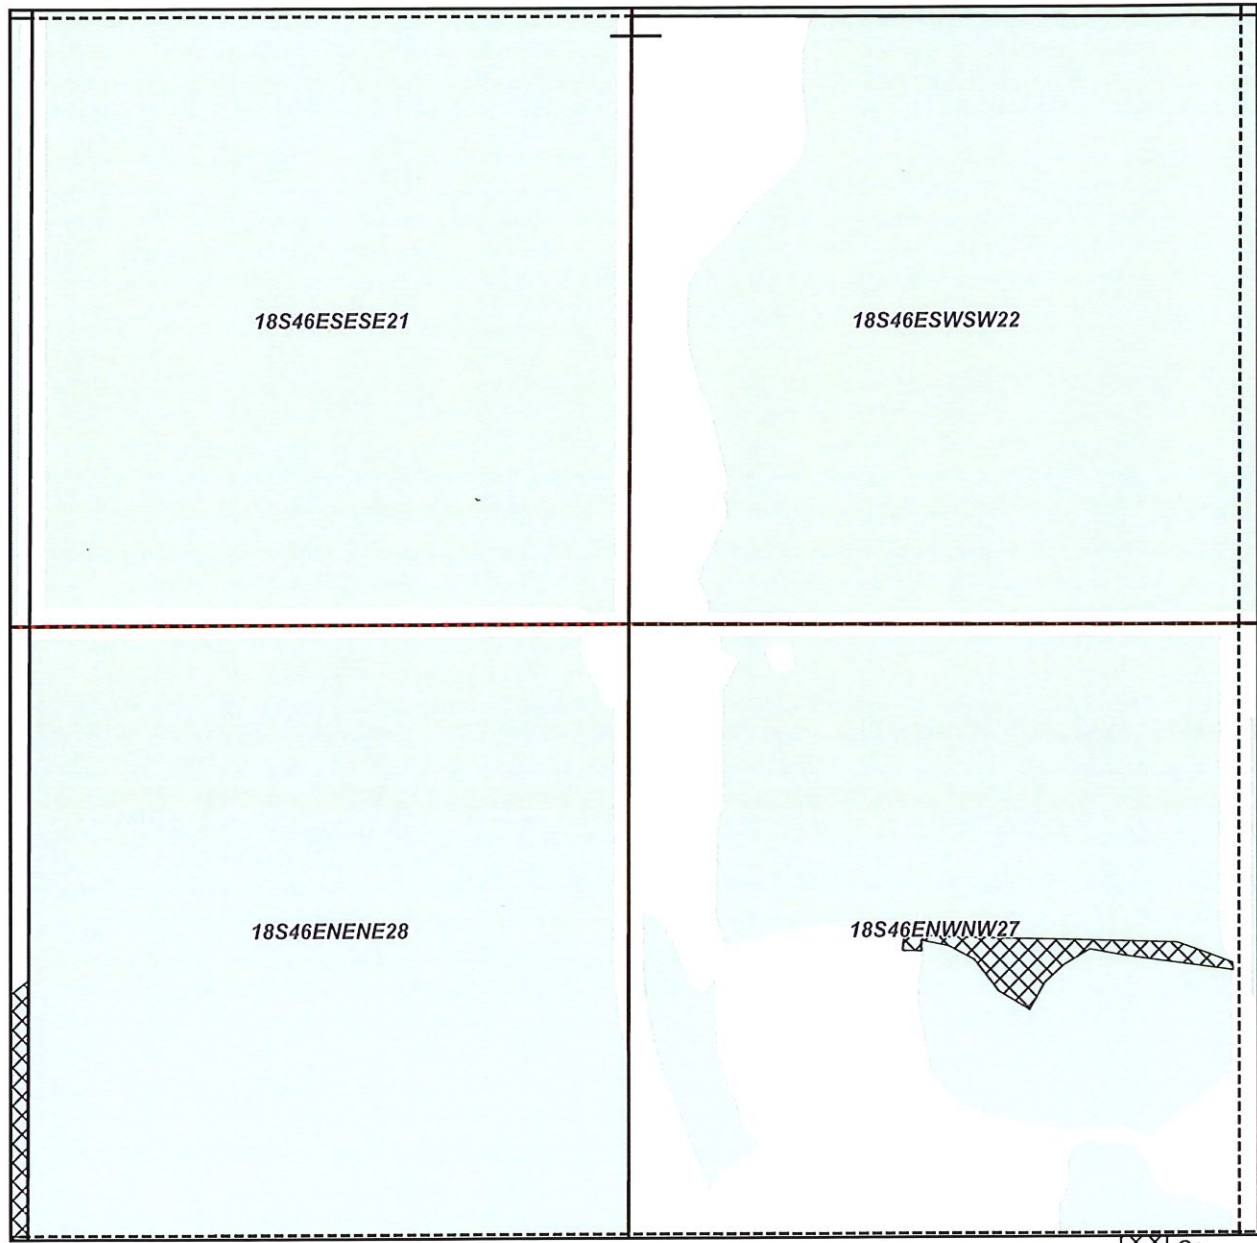

On

Off

Current Cert. 75691

"ON" Map

Received

OCT 14 2025

OWRD

Claim of Beneficial Use Map

NAME: Pounds, Marlow

TAXLOT - 400, 18S46E27 NW/NW: 0.94 Acres ON, 21.44 Acres Remaining (Cert 75691 IR)



Date: 8/28/2025

Owyhee Irrigation District


SEC. 26 T17S R46E

Scale - 1" = 400'

DINN: 23-62900

Transfer Number: T-14375

NE 1/4 of the SE 1/4

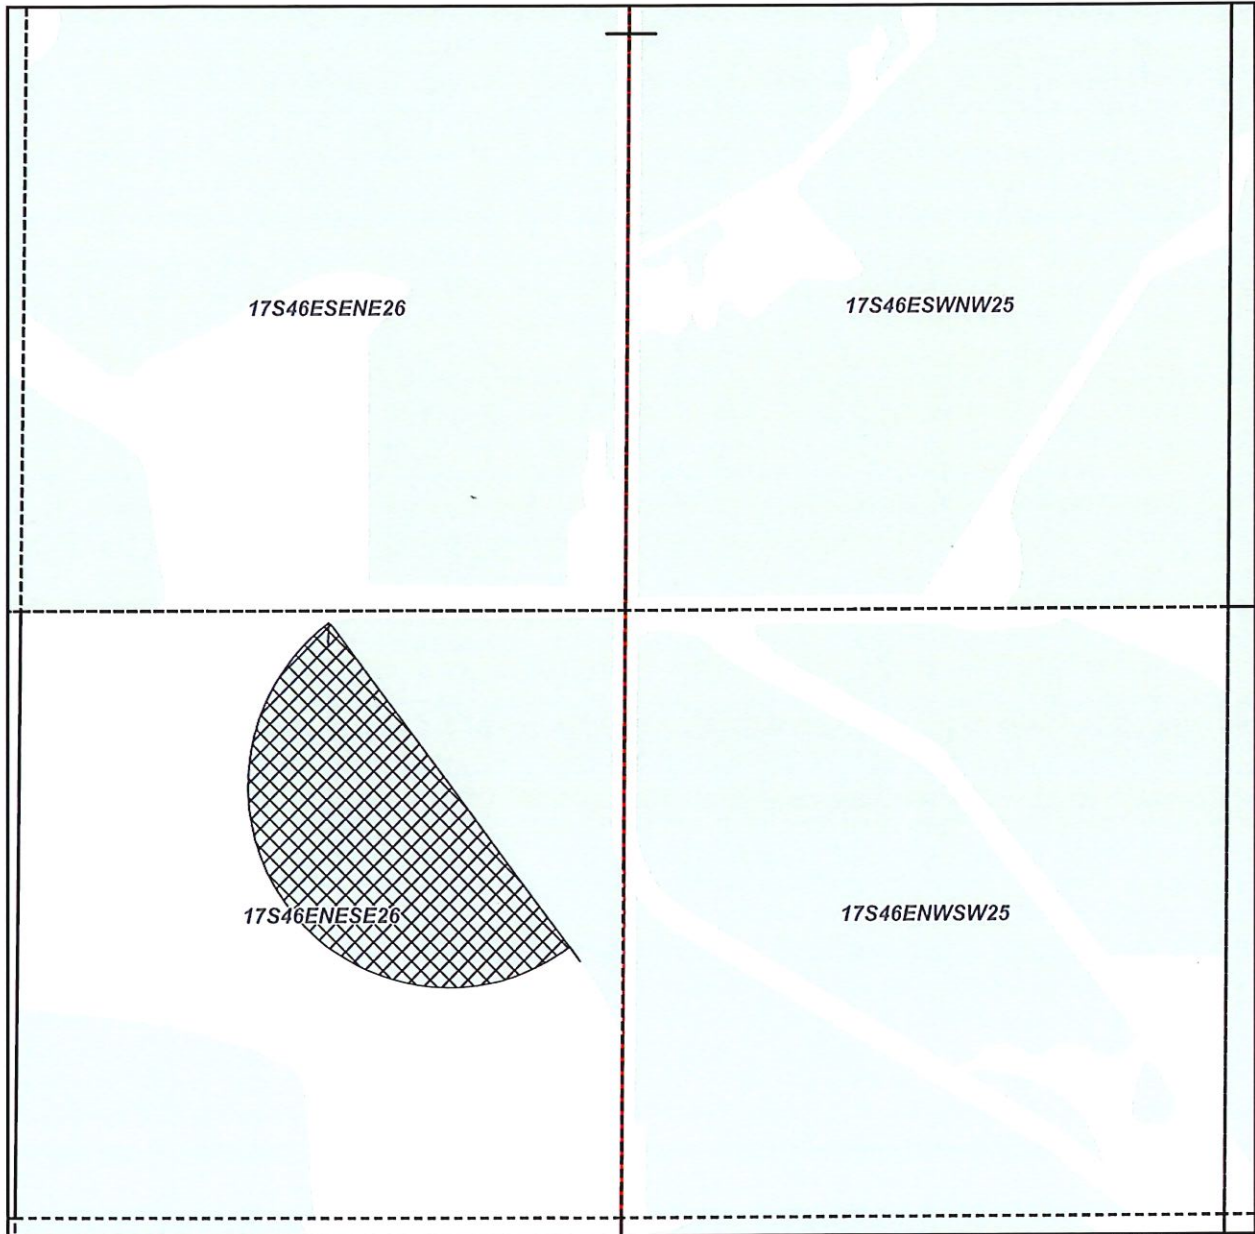

Received
OCT 14 2025

 On
Off
Current Cert. 75691

"ON" Map

Claim of Beneficial Use Map

NAME: Joseph Davis

OWRD

TAXLOT - 6500, 17S46E26 NE/SE: 6.0 Acres ON, 18.8 Acres Remaining (Cert 75691 IR)



Date: 8/28/2025