

Name Carl C. Jorgensen

By _____

Address Star Rt Box 405Gales Creek, Oregon 97117Change in POD & POVDate filed Nov 19, 1979

Date of hearing _____

Place of hearing _____

Date of order 2-14-80 Vol. 33, page 8Date for application of water 10-1-81

Proof mailed _____

Proof received _____

Certificate issued _____ Vol. _____, page _____

4327

DESCRIPTION OF WATER RIGHT

Name of stream Eiler CreekTrib. of Gales Creek County of WashingtonUse IrrigationQuantity of water 0.13 cfs No. of acres 10²

Name of ditch _____

Date of priority December 19, 1949In name of Sake Van Loo

_____ Adjudication, Vol. _____, page _____

App. No. 24354^{SR6} Per. No. 19140 Cert. No. 22913^{SR6}

Certificate cancelled _____

Notation made on record by _____

FEES PAID

Date	Amount	Receipt No.
<u>11-19-79</u>	<u>45⁰⁰</u>	<u>15054</u>
TOTAL . . .		
	Cert. Fee	

FEES REFUNDED

Date	Amount	Check No.

REMARKS

to survey 9/80

W.R.I.S.

Assembled 7-3-85 by SR6


Entered _____ by _____

Verified _____ by _____

INDEX CARDS:

TO BE ENTERED WHERE CHECKED	Entered	Checked
☒ Name	<u>Qcy</u>	<u> </u>
☒ Stream	<u>Qcy</u>	<u> </u>
☒ Pt. of Div.	<u>Qcy</u>	<u> </u>
☒ Calendar	<u>Qcy</u>	<u> </u>
☒ Twp. & Rge.	<u>SR6</u>	<u> </u>
☒ Decree-vault	<u> </u>	<u> </u>
☒ Decree-safe	<u> </u>	<u> </u>
☒ Cert. of W/R	<u>SR6</u>	<u> </u>
☒ Per. Folder	<u>SR6</u>	<u> </u>
☒ Chainindex	<u> </u>	<u> </u>
☒ Cross Ref.	<u> </u>	<u> </u>
☒ Power Claim	<u> </u>	<u> </u>
☒ Abstracts	<u>Qcy</u>	<u> </u>

T.1N.,R.4W.,W.M.

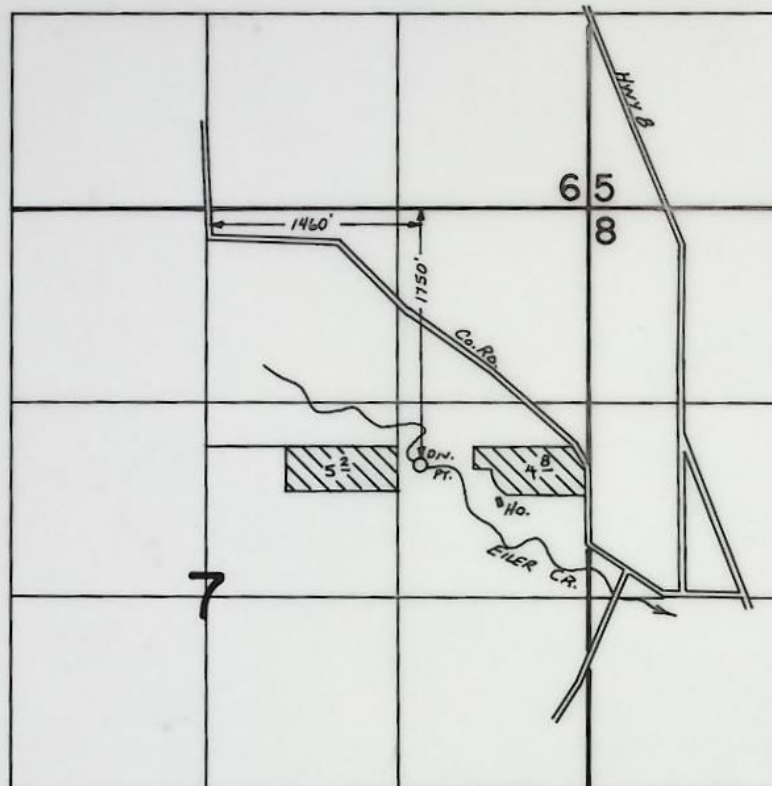

FINAL PROOF SURVEY
UNDER

Transfer No. 4327

Application No. Permit No.

IN NAME OF

.....**CARL C. JORGENSEN**.....

Surveyed ..Nov...1... 1983, by J.M.TOLL.....

POD
POU
USE
Add'l POD

County Washington

1. Name Carl C. Jorgensen

2. Source of Supply Eiler Creek, Trib of Dales Cr.

3. Use $\frac{1}{10^2} ac$

4. Amount of Water 0.11 g. 13 c. f. s.

5. Priority Date December 19, 1949

6. Proposed Point of Diversion 1750' S + 1460' E from E. Corner of

Sec 7. ~~1/4~~ SE $\frac{1}{4}$ NE $\frac{1}{4}$ Sec 7. T1N. R4W. Wm

7. Completion Date 10-1-81

[illegible]

INFO - MR JORGENSEN - SHOWED us Div 5 P.O.U.

DIV - DIRECT FROM Miller Creek

PUMP - ? DDC 2x2

MOTOR - GE 7 1/2 @ 2930 RPM

PIPE - 1200' 2" Ann Main 1/3 Lat

HEADS - 12 RB 20 1/8 x 0 (12 MAX)

USE - Pasture 1/3 Hay

LIFT - +15

TIE - DBS - 2LL-128

Notes: INCLUDE ALL LAND EAST OF
Miller Creek. THEN GO TO WEST ~~BOUNDARY~~ FIELD.

GO FROM EAST BOUNDARY WEST UNTIL
YOU COME UP WITH ENOUGH ACRES
TO BRING TOTAL TO 10⁰ ac

$$\frac{10^0}{80} = .125$$

$$\frac{7.5(6.6)}{15 + 127} = .35$$

@ sepi

$$\frac{12(3.2)}{448.8} = .09$$

80 psi

$$\frac{7.5(6.6)}{15 + 203} = .22$$

$$\frac{12(4.1)}{448.8} = .11$$

[Signature]
11/1/83


T1N, R4W, 14M

RECEIVED

NOV 10 1979

WATER RESOURCES DEPT
SALEM, OREGON

T-4327

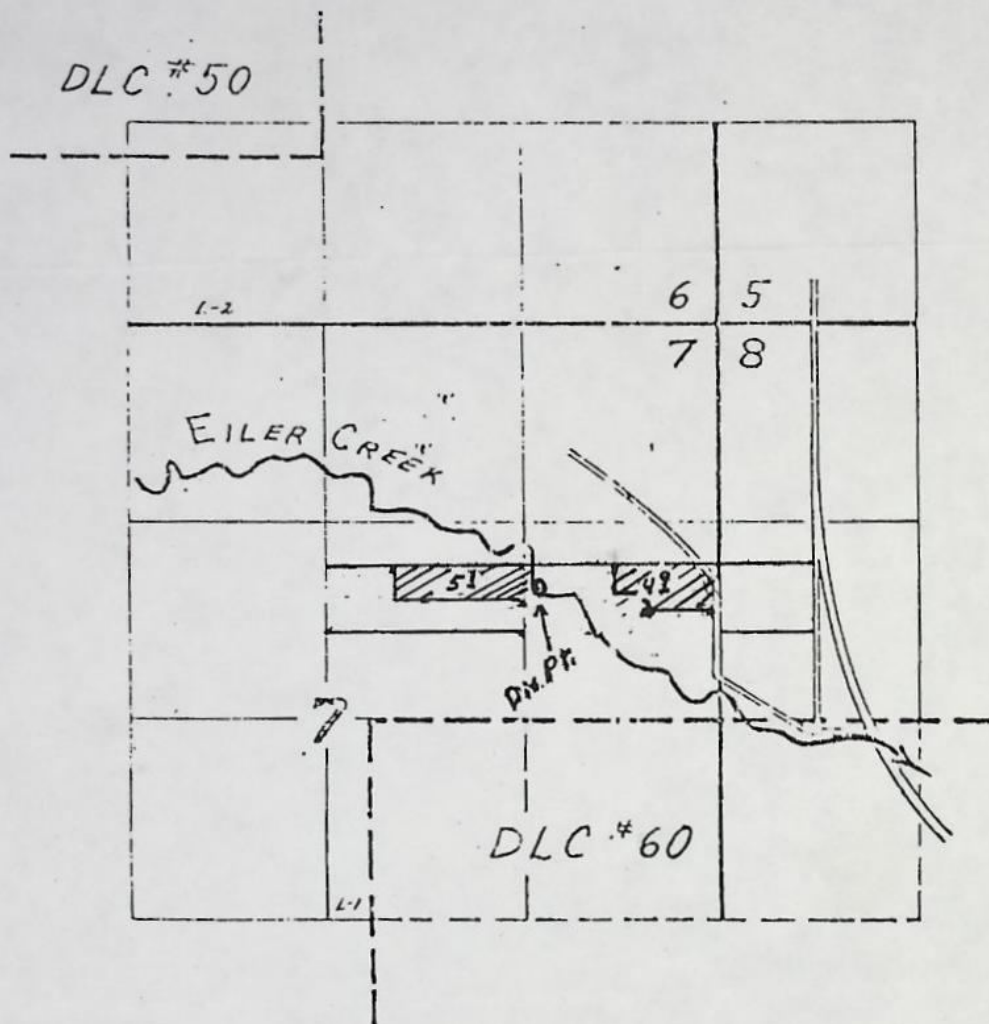

~~FINAL PROOF SURVEY~~
~~UNDER~~

Application No. 24354 Permit No. 19140

IN NAME OF:

JAKE VAN LOAN

Surveyed 4-12 1956, by R.D. Best

TRANSFER; POINT OF DIVERSION & PLACE OF USE

CARL TORGENSEN

P-19140

DFR-3D-43 WC

BEFORE THE WATER RESOURCES DIRECTOR OF OREGON

WASHINGTON COUNTY

IN THE MATTER OF THE APPLICATION OF)
CARL C. JORGENSEN FOR APPROVAL OF)
CHANGES IN PLACE OF USE & POINT OF)
DIVERSION OF WATER FROM EILER CREEK)

ORDER APPROVING
TRANSFER NO. 4327

On November 19, 1979, an application was filed in the office of the Water Resources Director by Carl C. Jorgensen for approval of changes in place of use and point of diversion of water from Eiler Creek, pursuant to the provisions of ORS 540.0510 to 540.530.

The certificate recorded at page 22913, Volume 16, State Record of Water Right Certificates, in the name of Jake Van Loo, describes a right for the use of not to exceed 0.13 cubic foot per second from Eiler (Iler) Creek for irrigation of a certain 9.7 acres in SE $\frac{1}{4}$ NE $\frac{1}{4}$ and 0.3 acre in SW $\frac{1}{4}$ NE $\frac{1}{4}$ of Section 7, Township 1 North, Range 4 West, W.M., with a date of priority of DEcember 19, 1949.

Water for said right is diverted from a point located 625 feet North and 825 feet West from the East Quarter Corner of Section 7, being within the SE $\frac{1}{4}$ NE $\frac{1}{4}$ of Section 7, Township 1 North, Range 4 West, W.M.

The applicant herein, owner of the lands above described, proposes to sever the right therefrom and, without loss of priority, to irrigate in lieu thereof a certain 5.1 acres in SW $\frac{1}{4}$ NE $\frac{1}{4}$ and 4.9 acres in SE $\frac{1}{4}$ NE $\frac{1}{4}$ of Section 7, from a point located 850 feet North and 1250 feet West from the East Quarter Corner of Section 7, being within the SE $\frac{1}{4}$ NE $\frac{1}{4}$ of Section 7, Township 1 North, Range 4 West, W.M.

Mr. Clayton Gardner, Watermaster, has filed a statement to the effect that the proposed changes in place of use and point of diversion may be made without injury to existing rights.

No objections having been filed and it appearing that the proposed changes in place of use and point of diversion may be made without injury to existing rights, the application should be approved.

NOW, THEREFORE, it hereby is ORDERED that the requested changes in place of use and point of diversion, as described herein, without loss of priority, are approved.

It is FURTHER ORDERED that the quantity of water diverted at the new point of diversion shall not exceed the quantity of water available at the old point of

diversion under the subject right.

It is FURTHER ORDERED that the following provisions shall be effective when in the judgment of the watermaster it becomes necessary to install headgates and measuring devices:


That the diversion works shall include an in line flow meter, a weir, or other suitable device for measuring the water to which the applicant is entitled;

That the type and plans of the measuring device be approved by the watermaster before the beginning of construction work and that the weir or measuring device be installed under the general supervision of said watermaster.

It is FURTHER ORDERED that the construction work shall be completed and the change in point of diversion of water made and that said water so transferred shall be applied to beneficial use on or before October 1, 1981.

It is FURTHER ORDERED that the certificate recorded at page 22913, Volume 16, State Record of Water Right Certificates, is canceled; and upon proof satisfactory to the Water Resources Director of completion of works and beneficial use of water to the extent intended under the provisions of this order, a confirming certificate of water right shall be issued to the applicant herein.

Dated at Salem, Oregon this 14th day of February, 1980.

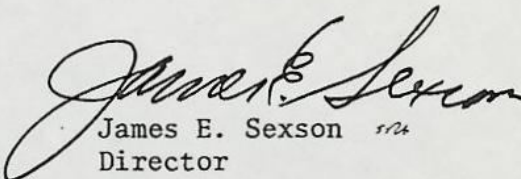
James E. Sexson
Director

ILER CR - GALE'S CR
(EILER)
IIR T-0982-C1

*** OREGON WATER RESOURCES DEPARTMENT ***
*** WATER RIGHTS DIVISION ***
*** WATER RIGHT DATA INPUT FORM ***

PAGE 1
RUN ON: 3/20/81 AT: 9:08

WATER RIGHT NO. 1000043271 PERMIT NO. 019140 CERTIF. NO.
ORIG. NO. 1000243541 PREV. NO. 1000243541 SUPER. NO.

NAME: CARL S. JORGENSEN

ADDRESS: STAR RT, BOX 405

CITY/STATE/ZIP/COUNTY: GALE'S CREEK, OR 97117

34

STREAM-ID 02 1140 0300 0560 170

RIV. MI.

WM. DIST. 01 W.R. TYPE SA STATUS V

CANCEL YEAR----

CONSTR. COMPLT--> 09 03 1980

YR. LAST USED----->

NEXT ACTION DUE-->

PRIORITY-----> 12 19 1949

PUT TO USE-----> 09 03 1980

LAST TRANS. DATE-->

LAST TRANS. TYPE-->

APPLICATION----> 11 19 1979

SURVEYED----->

EXAM. FEE----->

RECORDING FEE----->

25.00

PERMIT ISSUE--> 02 14 1980

CONCURRENCE----->

CYCLE STATUS----->

REPORTED FLAG----->

CONSTR. STRT.--> 02 14 1980

CERTIFIED----->

CORRES. INIT.----->

CORRES. DATE----->

POINT-OF-DIVERSION DATA:
TWNSP RNGE SECT QTR/QTR STREAM-ID

RIV. MI.

RATE

STATUS S OR P

** REMARKS;----->
** DATED-->

** POD: 850' N & 1250' W FM E 1/4

** COR. S.T. CHANGES POD & POD

** ALL OF C-22913.

**-----

**-----

**-----

**-----

PLACE-OF-USE DATA:

TWNSP RNGE SECT QTR/QTR CNTY USE % CNSMTV ACRES

STATUS S OR P

010N 090W 07 A C 34 1R 100 5.10

V P

1 1 A D 1 1 4.90

1 1

W.R. I.S.

Assembled 4-3-85 by Sops

Entered by

Verified by

RECEIVED

SEP 03 1980

WATER RESOURCES DEPT
SALEM, OREGON

NOTICE OF COMPLETION OF CHANGE IN

place of use & point of diversion of water from Eiler Cr.
PURSUANT TO TRANSFER APPLICATION NO. 4327

I, Carl C. Jorgensen, hereby certify that completion
of works and use of water to the extent intended within the provisions
of the order of the Water Resources Director approving said water
right transfer application was accomplished by September 1, 19 80

Sept 1, 1980
Date

Carl C. Jorgensen
Signature

OK
CJ
(Mail to the Water Resources Department, Salem, Oregon 97310.)



STATE OF OREGON

INTEROFFICE MEMO

Please Rush!
Leg

TO: TRANSFERS, WATER RIGHTS DIVISION

DATE: 1 - 30, 1980.

FROM: ** Clayton Gardner, Watermaster

RECEIVED

JAN 31 1980

WATER RESOURCES DEPT
SALEM, OREGONSUBJECT: WATER RIGHT TRANSFER APPLICATION NO. 4327IN THE NAME OF Carl C. Jorgensen

In my opinion the proposed changes in POU & POD of water from Eiler Creek
MAY BE MADE WITHOUT INJURY ~~WOULD RESULT IN INJURY~~* to an existing water right.

Headgate notices ~~HAVE~~ HAVE NOT been issued for diversion from the sources which
serves this right.

If for change in point of diversion, is there any intervening point of diversion
between the authorized and the proposed points of diversion? No
(yes or no)

In my opinion, the order approving the subject transfer application should include
the following in regard to the appropriator installing suitable measuring devices
in the diversion works:

- ____ (1) PRIOR to the diverting of water at the new point of diversion . . .
X (2) When in the judgment of the watermaster it becomes necessary . . .

* The approval of this transfer application would result in injury to other water
rights because _____

** *Clayton Gardner*
Watermaster's signature or initials

T-4327
RECEIVED

NOV 19 1979

Application for Transfer of Water Right

WATER RESOURCES DEPT
SALEM, OREGON

To the WATER RESOURCES DIRECTOR OF OREGON:

I, Carl C. Jorgensen
(Name of applicant)
of Star Rt Box 405, Gales Creek,
(Mailing address) (City)
State of Oregon, 97117, 357 2421, do hereby make application for change
(Zip Code) (Phone number)
in point of diversion and place of use
(In point of diversion; place of use; use heretofore made of the water)

1. Is the water right recorded in your name? Jake Van Loo
(If not, give name)

2. Was your water right determined by Decree of Court? no If so, give title of proceedings
(Yes or No)

number of certificate

3. Was your water right acquired by Water Right Permit? yes If so, give number
(Yes or No)
of permit 19140 Number of certificate 22913
A 29354

NOTE: If the entire right of record is not directly involved in the requested change, only that part of the right that is directly involved should be considered in answering the balance of the questions on this form.

4. The source of water is Eiler Creek

5. What is the date of priority of your water right? Dec. 19, 1949

6. The authorized point of diversion is located 625 ft. N and 825 ft. W from the E 1/4 corner of Sec. 7 being within the SE 1/4 NE 1/4 of Section 7 Tp. N R. 4 W W. M.,
(N. or S.) (E. or W.) (No. N. or S.) (No. E. or W.)
in the county of Washington. The name of the ditch used is

NOTE: Answer question if the application is for change in point of diversion.

7. The proposed point of diversion is located 850 ft. N and 1250 ft. W from the E 1/4 corner of Sec. 7 being within the SE 1/4 NE 1/4 of Section 7 Tp. N R. 4 W W. M.,
(N. or S.) (E. or W.) (No. N. or S.) (No. E. or W.)
in the county of Washington. The name of the ditch to be used is

8. The use to which the water is applied is Irrigation
(Irrigation, Mining, Power, Manufacturing, etc.)

Location of area irrigated, or place of use if other than irrigation:

Township North or South	Range E. or W. of Willamette Meridian	Section	List $\frac{1}{4}$ - $\frac{1}{4}$ of Section	Number Acres To Be Irrigated
1. N	R 4 W	7	SE $\frac{1}{4}$ of the NE $\frac{1}{4}$	9.7
1. N.	R 4 W	7	SW $\frac{1}{4}$ of the NE $\frac{1}{4}$	.3

(If more space required, attach separate sheet)

9. Are you the legal owner of the above described lands? yes
(If not owner, explain your interest)

10. To your knowledge, has any portion of the water right above described undergone a period of five or more consecutive years of nonuse? No
(Yes or No)

NOTE: Answer questions 11, 12 and 13 if application is for change in use or place of use.

11. Are the lands from which you propose to transfer your water right free of all encumbrances, including taxes, mortgages, liens, etc.? yes
(Answer Yes or No)

12. If not, give below a description of existing encumbrances:

NATURE OF ENCUMBRANCE	HELD BY	AMOUNT

13. The use to which the water is to be applied is Irrigation
(Irrigation, power, mining, manufacturing, domestic supplies, etc.)

Location of area to be irrigated, or place of use if other than irrigation:

Township North or South	Range E. or W. of Willamette Meridian	Section	List $\frac{1}{4}$ - $\frac{1}{4}$ of Section	Number Acres To Be Irrigated
1. N.	R 4 W	7	SE $\frac{1}{4}$ of the NE $\frac{1}{4}$	4.9
1. N.	R 4 W	7	SW $\frac{1}{4}$ of the NE $\frac{1}{4}$	5.1

(If more space required, attach separate sheet)

14. Reasons for the proposed changes are I wish to irrigate the

most productive part of my property

15. Construction work will be completed on or before October 1, 1980

16. The water will be completely applied to the proposed use on or before October 1, 1980

Remarks

NOTE: THIS APPLICATION MUST BE ACCOMPANIED BY A MAP OR MAPS SHOWING THE BEFORE AND AFTER LOCATIONS OF THE POINT OF DIVERSION AND/OR PLACE OF USE, AS THE CASE MAY BE.

AFFIDAVIT OF APPLICANT

I, Carl C Jorgensen, the applicant herein, being first duly sworn, depose and say that I have read the above and foregoing application for transfer of water right; that I know the contents thereof and that the statements therein made are true and correct to the best of my knowledge and belief.

In Witness Whereof, I have hereunto set my hand this 13 day of Nov, 1979

Carl C Jorgensen
(Name of applicant)

Subscribed and sworn to before me this 13th day of November, 1979


[Notarial Seal]

Sandra Dees
NOTARY PUBLIC FOR OREGON

My commission expires 1-8-83

T-4327

T1N, R4W, WM

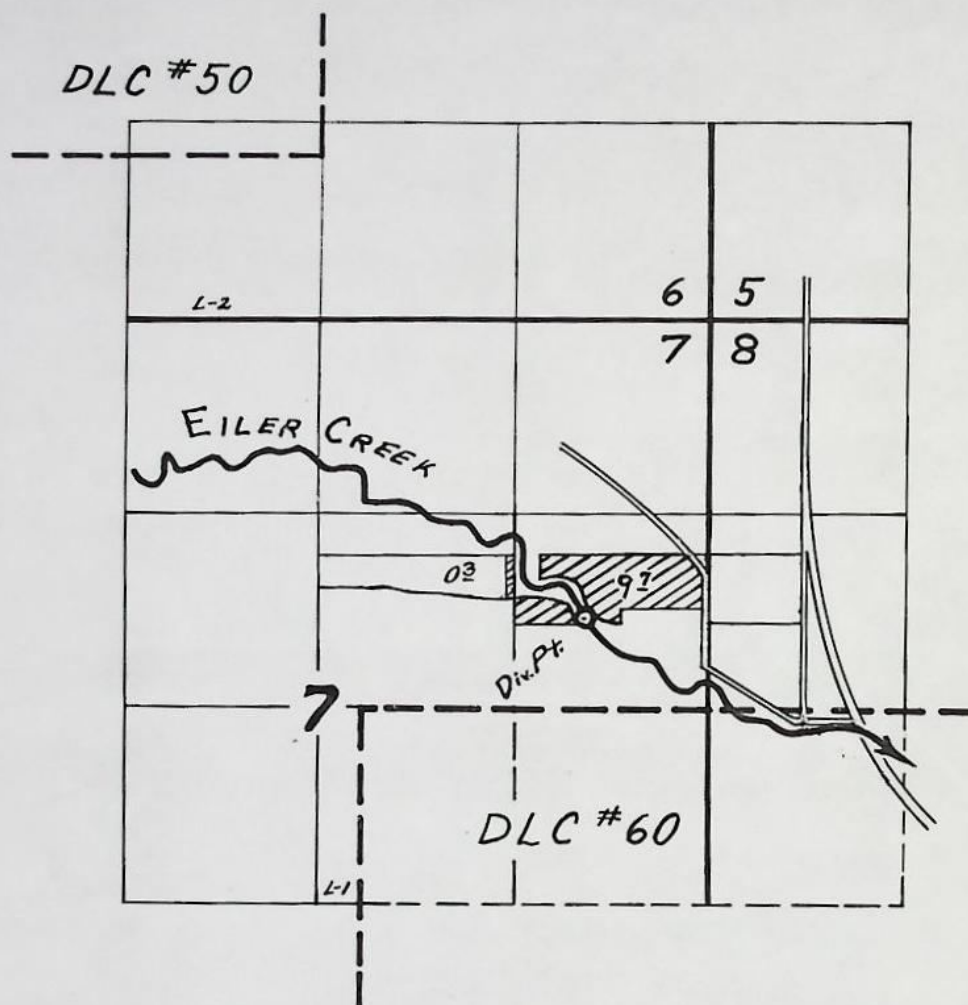

FINAL PROOF SURVEY
UNDER

Application No. 24354 Permit No. 19140
IN NAME OF

JAKE VAN LOO

Surveyed 4-12 1956, by R.D. Best

37 ⁸⁰			
38 ¹⁵			
38 ⁵¹		7 Lot 1 800 Lot 2 800	Q.L.C. No. 60 No. 7465
38 ⁸⁶			