

DISTRICT

Name Owyhee Irrigation DistrictAddress 422 Thunderegg Blvd
Nyssa, OR 97913
office@oidnh.govChange in POUDate Filed 12/15/2025Initial notice date 12/23/2025

DPD issued date _____

PD issued date _____

PD notice date _____

Date of FO 4/3/2026Vol 138 Page 570-573

C-Date _____

COBU due date _____

COBU Received date _____

Certificate issued _____

DESCRIPTION OF WATER RIGHT(s)

Name of Stream Owyhee River, Owyhee ReservoirTrib. of Snake River, Owyhee RiverUse Irrigation, Supplemental IrrigationCounty Malheur

Quantity of water (CFS) _____

No. of Acres _____

Name of ditch _____

App# S-11769Per # S-8171Cert # 75691

PR Date _____

App# S-71431Per # S-54398

Cert # _____

PR Date 3/25/1991

App# _____

Per # _____

Cert # _____

PR Date _____

App# _____

Per # _____

Cert # _____

PR Date _____

App# _____

Per # _____

Cert # _____

PR Date _____

FEES PAID

Date	Amount	Receipt #
<u>12-15-25</u>	<u>92,040.00</u>	<u>146557</u>

FEES REFUNDED

Date	Amount	Receipt #
------	--------	-----------

Assignments: _____

Irrigation District _____

Agent _____

CWRE _____

CC's list V.S. BOR☐ - Oversized map - Location _____



Oregon

Tina Kotek, Governor

Water Resources Department

North Mall Office Building

725 Summer St NE, Suite A

Salem, OR 97301

Phone 503 986-0900

Fax 503 986-0904

www.oregon.gov/owrd

April 3, 2026

Owyhee Irrigation District
422 Thunderegg Blvd
Nyssa, OR 97913

REFERENCE: District Transfer T-14778

Enclosed is a copy of the final order approving your District Transfer.

The time allowed to complete the transfer is specified in the final order. You are required to submit a claim of beneficial use to this Department within one year of the date you complete the change(s) or within one year of the completion date authorized in the final order whichever comes first. If necessary, you may request more time by filing for a transfer extension. All extensions are subject to approval.

To file a claim please include:

- 1) **A CLAIM OF BENEFICIAL USE FORM**
- 2) **A CLAIM OF BENEFICIAL USE SITE REPORT**
- 3) **A CLAIM OF BENEFICIAL USE MAP** (this map does not need to be prepared by a Certified Water Rights Examiner (CWRE))

All forms needed to file a claim for a district transfer are available at:

<https://www.oregon.gov/OWRD/programs/WaterRights/Transfers/DistTransfer/Pages/Forms.aspx>

If you have any questions related to the approval of this transfer, you may contact your caseworker Adam Frederick by telephone at (971) 707-8400 or by e-mail at Adam.m.frederick@water.oregon.gov.

Sincerely,

David V. Jones Jr
Water Right Services Support
Transfer and Conservation Section

cc: Jered L. Hoshaw, Watermaster Dist. # 9 (via email)
Bureau of Reclamation

Enclosure

**BEFORE THE WATER RESOURCES DEPARTMENT
OF THE
STATE OF OREGON**

In the Matter of Transfer Application	)	FINAL ORDER APPROVING
T-14778, Malheur County	)	A DISTRICT PERMANENT TRANSFER FOR
	)	CHANGES IN PLACES OF USE

Authority

Oregon Revised Statutes (ORS) 540.570 to 540.580 establish the process in which a district may submit a request to transfer a water right within district boundaries. Oregon Administrative Rule (OAR) Chapter 690, Division 385 implements the statutes and provides the Department's procedures and criteria for evaluating district transfer applications.

Applicant

OWYHEE IRRIGATION DISTRICT
422 THUNDEREGG BLVD
NYSSA, OR 97913

Findings of Fact

1. On December 15, 2025, Owyhee Irrigation District (OID) filed a completed district transfer application to permanently change the place of use under Certificate 75691 and amend , permit S-54398. The Department assigned the application number T-14778.
2. Notice of the District Permanent Transfer Application was published on December 23, 2025, pursuant to ORS 540.580 and OAR 690-385-4400. No comments were filed in response to the notice.
3. The U.S. Bureau of Reclamation was notified of the transfer application on December 23, 2025; no comments were received within 90 days of the notification.
4. On January 26, 2026, OID amended the application to remove the permit amendment for Permit S-54398.
5. On March 17, 2026, OID amended the Supplemental Form A to include all priority dates on Certificate 75691.

This final order in a contested case and is subject to judicial review by the Court of Appeals under ORS 183.482. Any petition for judicial review must be filed within the 60-day time period specified by ORS 183.482(1). Pursuant to ORS 536.075(2) and OAR 137-003-0675, you may petition for judicial review or petition the Director for reconsideration of this order. A petition for reconsideration may be granted or denied by the Director, and if no action is taken within 60 days following the date the petition was filed, the petition shall be deemed denied.

Within 20 days after this final order is issued (i.e., mailing date), the district or any protestant may file with the commission exceptions to the final order. The commission shall issue an order granting or denying the exceptions within 30 days after receiving the exceptions. ORS 540.580(10).

6. The portion of the right to be transferred is as follows:

Certificate: 75691 in the name of the UNITED STATES OF AMERICA; BUREAU OF RECLAMATION (perfected under Permit S-8171)

Use: IRRIGATION of 1.93 ACRES

Priority Date: FEBRUARY 14, 1916 for 0.01 cubic foot per second (CFS) and AUGUST 19, 1924 for 0.02 CFS from direct flow and FEBRUARY 15, 1916 for 1.9 acre-feet (AF) and AUGUST 20, 1924 for 11.2 AF from stored water

Rate: 0.03 CFS

Limit/ Duty: The amount of water from direct flow of the Owyhee River used for irrigation shall be limited to 1/60th of one cubic foot per second (cfs) per acre, or its equivalent for each acre irrigated and shall be further limited to 3.0 acre-feet per acre for each acre irrigated during the irrigation season of each year. The amount of water from direct flow of the Owyhee River together with water stored in Owyhee Reservoir and with the amount secured under any other water right existing for the same lands, shall be limited to a diversion of not to exceed 6.7 acre-feet for each acre irrigated during the irrigation season of each year and shall conform to any reasonable rotation system as may be ordered by the proper state officer.

Sources: The OWYHEE RIVER and water stored in OWYHEE RESERVOIR (constructed under Permit R-599), tributaries of the SNAKE RIVER

Authorized Points of Diversion:

Twp	Rng	Mer	Sec	Q-Q	Measured Distances
22 S	45 E	WM	20	NW SE	OWYHEE DAM: 200 FEET SOUTH AND 2010 FEET WEST FROM THE COMMON CORNER OF SECTIONS 20 AND 21
22 S	45 E	WM	20	NW SE	GLORY HOLE SPILLWAY: 200 FEET SOUTH AND 1680 FEET WEST FROM THE COMMON CORNER TO SECTIONS 20 AND 21
22 S	45 E	WM	21	NW SW	TUNNEL NO. 1: 495 FEET EAST AND 264 FEET SOUTH FROM THE COMMON CORNER TO SECTIONS 20 AND 21

Authorized Place of Use:

IRRIGATION								
Twp	Rng	Mer	Sec	Q-Q	Acres	Taxlot	Water User	Notice
16 S	47 E	WM	21	SW SE	0.06	8200	KOEHN	25-73000
17 S	47 E	WM	20	SW SW	0.60	600	WONKA	25-62508
21 S	46 E	WM	11	NE SW	0.95	1200	WHITE	25-7300
21 S	46 E	WM	11	SE SE	0.32	1700	WAGSTAFF	25-100
Total					1.93			

7. Transfer Application T-14778 proposes to change the place of use to:

Proposed Place of Use:

IRRIGATION								
Twp	Rng	Mer	Sec	Q-Q	Acres	Taxlot	Water User	Notice
20 S	46 E	WM	5	SW NE	0.66	300	CAMBELL	25-27403
21 S	46 E	WM	11	SE SE	0.32	1700	WAGSTAFF	25-100
21 S	46 E	WM	22	SW NE	0.95	300	WHITE	25-7300
Total					1.93			

8. The Department finds that the district permanent transfer application was submitted according to ORS 540.580 and OAR 690-385-4000, contains the information required under OARs 690-385-4200 and 690-385-2000, and includes maps meeting the requirements of OARs 690-385-4300 and 690-385-2200.
9. The Department finds that the proposed district permanent transfer meets all the criteria set forth in ORS 540.580 and OAR 690-385-4000.
10. The water right is subject to transfer as defined in OAR 690-385-0100(17).
11. The proposed changes in places of use will not result in enlargement of the right as defined in OAR 690-385-0100(4).
12. The proposed changes in places of use will not result in injury to other water rights as defined in OAR 690-385-0100(6).
13. Any other applicable requirements for district permanent water right transfers are met as required in OAR 690-385-4500.

Conclusions of Law


The proposed changes in places of use as proposed in Transfer Application T-14778 complies with and satisfies the requirements of ORS 540.580 and OAR 690-385-4500.

Now, therefore, it is ORDERED:

1. The proposed change in place of use to the water right evidenced by Certificate 75691 is approved.
2. The place of use from which the water right is transferred off by Transfer T-14778 shall no longer be irrigated and are cancelled from Certificate 75691.
3. The right to the use of the water at the place of use NOT modified by this order is restricted to beneficial and is subject to all other conditions and limitations contained in Certificate 75691.
4. The water user shall maintain and operate the existing measurement device and shall make such improvements as may be required by the Department.

5. Full beneficial use of the water shall be made, consistent with the terms of this order, on or before **October 1, 2027**. A Claim of Beneficial Use shall be submitted by OID to the Department within one year after the deadline for completion of the changes and full beneficial use of the water.
6. Water right Certificate 75691 is modified. After satisfactory proof of completion has been determined by the Department, superseding water right certificates will be issued when the Department determines it is necessary for record keeping.

Dated in Salem, Oregon on **APRIL 3, 2026**.

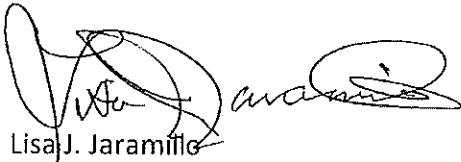

Lisa J. Jaramillo
Transfer and Conservation Section Manager, for
Ivan Gall, Director
Oregon Water Resources Department

Mailing Date: **APRIL 6, 2026**

-
- If you have any questions about statements contained in this document, please contact Adam Frederick at Adam.M.Frederick@water.oregon.gov or 971-707-8400.
 - If you have other questions about the Department or any of its programs, please contact our Water Resources Customer Service Group at 503-986-0900.
-



Oregon

Tina Kotek, Governor

Water Resources Department

North Mall Office Building

725 Summer St NE, Suite A

Salem, OR 97301

Phone 503 986-0900

Fax 503 986-0904

www.oregon.gov/owrd

December 22, 2025

Owyhee Irrigation District
422 Thunderegg Blvd
Nyssa, OR 97913

Reference: District Permanent Transfer T-14778

On December 15, 2025, we received your district transfer application requesting PLACE OF USE changes. The application was accompanied by \$2040.00. Your receipt number 146557 is enclosed.

By copy of this letter, we are asking the Watermaster for their report regarding the potential for injury to existing water rights which may be caused by the change.

This application will be published on the Department's weekly notice dated December 23, 2025, viewable at http://apps.wrd.state.or.us/apps/misc/wrd_notice_view/?notice_id=21. A copy of the application can be assessed through this public notice link. Pursuant to Oregon administrative rules, the Department is requesting public comments on the recently filed district transfer application listed above. Comments may be submitted by any interested persons within 30 days of the weekly notice publication date. Comments must be received by the Department on or before January 22, 2026. For details on how to file comments please refer to the Department's weekly notice. Details for filing protests, if applicable, are also noted on the weekly notice.

If you have any questions, please call the Transfer Section, (503) 986-0935.

cc: Watermaster # 9, Jered L. Hoshaw (*via email*)
Bureau of Reclamation
File

Enclosure



422 Thunderegg BLVD Nyssa, OR 97913

PH# (541)372-3540

December 5th, 2025

Oregon Water Resource Department
725 Summer Street, NE
Suite A
Salem, OR 97301

RE: 2025 Permanent Water Transfers

Hello,

Enclosed is the "Application for District Permanent Water Right Transfers", "Supplemental Form A", ON & OFF maps, & check for \$2,040.00.

Transfer application packet included for the following individuals:

Bruce Cambell
Guy Dean
Eric White
Austin Wagstaff
Brian Wonka
Russel Koehn

If you have any questions, please let me know.

Thank you,


Krista Kinzer

Received
DEC 15 2025
OWRD

14778 -

STATE OF OREGON
WATER RESOURCES DEPARTMENT

725 Summer St. N.E. Ste. A

SALEM, OR 97301-4172

(503) 986-0900 / (503) 986-0904 (fax)

RECEIPT # 146557

INVOICE # _____

RECEIVED FROM: Owyhee Irrigation District
BY: _____

APPLICATION	
PERMIT	
TRANSFER	<u>T-1478</u>

CASH: ☐ CHECK:# 2818 OTHER: (IDENTIFY) ☐

TOTAL REC'D \$ 2,040.00

1083 TREASURY 4170 WRD MISC CASH ACCT

0407 COPIES	\$
OTHER: (IDENTIFY)	\$

0243 I/S Lease _____ 0244 Muni Water Mgmt. Plan _____ 0245 Cons. Water _____

4270 WRD OPERATING ACCT

MISCELLANEOUS

0407 COPY & TAPE FEES	\$
0410 RESEARCH FEES	\$
0408 MISC REVENUE: (IDENTIFY)	\$
TC162 DEPOSIT LIAB. (IDENTIFY)	\$
0240 EXTENSION OF TIME	\$

WATER RIGHTS:

0201 SURFACE WATER	EXAM FEE	0202	RECORD FEE
0203 GROUND WATER	\$	0204	\$
0205 TRANSFER	\$ <u>2,040.00</u>		

WELL CONSTRUCTION

0218 WELL DRILL CONSTRUCTOR	EXAM FEE	0219	LICENSE FEE
LANDOWNER'S PERMIT	\$	0220	\$

OTHER (IDENTIFY) _____

0536 TREASURY 0437 WELL CONST. START FEE

0211 WELL CONST START FEE	\$	CARD#	
0210 MONITORING WELLS	\$	CARD#	
OTHER (IDENTIFY)			

0607 TREASURY 0467 HYDRO ACTIVITY LIC NUMBER

0233 POWER LICENSE FEE (FW/WRD)	\$
0231 HYDRO LICENSE FEE (FW/WRD)	\$
HYDRO APPLICATION	\$

TREASURY OTHER / RDX

FUND _____ TITLE _____
OBJ. CODE _____ VENDOR # _____
DESCRIPTION _____ \$ _____

RECEIPT: 146557

DATED: 12/15/25 BY: mmmm

Distribution - White Copy - Customer, Yellow Copy - Fiscal, Blue Copy - File, Buff Copy - Fiscal

Application for

**District Permanent Water
Right Transfer**

OWRD



Oregon Water Resources
Department
725 Summer Street NE, Suite A
Salem, Oregon 97301-1266
(503) 986-0900
www.oregon.gov/OWRD

Please type or print legibly in dark ink. If your application is incomplete or inaccurate, we will return it to you. If any requested information does not apply to your application, insert "N/A" to indicate "Not Applicable." As you complete this form, please refer to notes and guidance included on the application. A summary of review criteria and procedures that are generally applicable to the application is available at:

<https://www.oregon.gov/owrd/WRDFormsPDF/CriteriaforDistrictPERMANENTTransferApplications.pdf>

Change in Place of Use Only**1A. APPLICANT INFORMATION**

IRRIGATION DISTRICT Owyhee Irrigation District			PHONE NO. 541-372-3540	ADDITIONAL CONTACT NO.
ADDRESS 422 Thunderegg Blvd				COUNTY Malheur
CITY Nyssa	STATE OR	ZIP 97913	E-MAIL office@oidnh.gov	
BY PROVIDING AN E-MAIL ADDRESS, CONSENT IS GIVEN TO RECEIVE ALL CORRESPONDENCE FROM THE DEPARTMENT ELECTRONICALLY. COPIES OF THE FINAL ORDER DOCUMENTS WILL ALSO BE MAILED.				

1B. AGENT INFORMATION

AGENT/BUSINESS NAME			PHONE NO.	ADDITIONAL CONTACT NO.
ADDRESS				FAX NO.
CITY	STATE	ZIP	E-MAIL	
BY PROVIDING AN E-MAIL ADDRESS, CONSENT IS GIVEN TO RECEIVE ALL CORRESPONDENCE FROM THE DEPARTMENT ELECTRONICALLY. COPIES OF THE FINAL ORDER DOCUMENTS WILL ALSO BE MAILED.				

2. PROPOSED CHANGE(S) TO WATER RIGHT(S)

- List all water rights to be affected by this transfer. Indicate the certificate, permit, decree or other identifying number(s) in the table below: (Attach additional pages as necessary.)

	Certificate	Permit / Previous Transfer	Decree
1.	75691	-	
2.	S-54398	-	
3.		-	
4.		-	
5.		-	
6.		-	

3. ATTACHMENTS

Check each of the following **attachments** included with this application. The application will be returned if all required attachments are not included.

Supplemental Form A –

Description of Proposed Change(s) to a Water Right

- ☐ A separate Supplemental Form A is enclosed for each water right to be affected by this transfer.

Map

- ☒ Permanent Transfer

A map meeting the requirements of OAR 690-385-3300 must be included but need not be prepared by a Certified Water Right Examiner (CWRE).

Fees:

- ☒ Amount enclosed: \$ 2,040.00
See the Department's Fee Calculator at https://apps.wrd.state.or.us/apps/wr/wr_transfer_calculator/permanent_district_transfer.aspx


Land Use Compatibility Statement

- ☐ The Land Use Information Form is not required if water is to be diverted, conveyed and/or used only on federal lands or if ALL of the following apply: a) a change in place of use only, b) a change that does not involve the placement or modification of structures, c) the use of water is for irrigation **only** and d) the use is located within an irrigation district or an exclusive farm use zone.

4. SIGNATURES

The district certifies the following:

- (1) The water rights proposed for transfer are water rights subject to transfer and are not subject to forfeiture for nonuse under ORS 540.610;
- (2) Each user affected by the proposed transfer has provided written authorization for the transfer and such authorization is on file with the district;
- (3) For lands which are no longer irrigated or susceptible of irrigation that are included in this transfer under the authority of ORS 540.572 and OAR 690-385-5000, notices as required under ORS 540.572 and OAR 690-385-5100 have been given to the user and any security interest holder of record of intent to transfer the right and the user was provided an opportunity to resolve the matter in the manner described by ORS 540.572 and OAR 690-385-5400 and 690-385-5600.
- (4) On behalf of the district, I affirm to the best of my knowledge the information contained in this application is true and accurate.

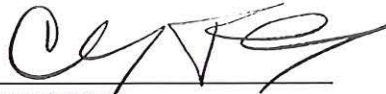

District Manager signature

Clancy Flynn
name (print)

12/03/2025
date

OR



Authorized District Representative signature

Krista Kinzer
name (print)

12/03/2025
date

Before submitting your application to the Department, be sure you have:

- Answered each question completely.
- Included all the required attachments.
- Included a check payable to the Oregon Water Resources Department for the appropriate amount.



District Permanent Water Right Transfer Application
Supplemental Form A

Received
DEC 15 2025
OWRD

DESCRIPTION OF PROPOSED CHANGE(S) TO A WATER RIGHT

List only one water right per page. **A separate Supplemental Form A must be completed for each certificate, permit, decree, or other right involved in the proposed transfer.**

Attach additional copies of Supplemental Form A as needed to describe other certificates, permits, decrees or other rights involved in this transfer.

1. CURRENT WATER RIGHT INFORMATION

Water Right Subject to Transfer (check and complete one of the following):

☒ Certificated Right	75691	
	Certificate Number	
☐ Adjudicated, Non-certificated Right		
	Name of Decree	Page Number
☐ Permit for which Proof has been Approved	-	
	Permit Number	Date Claim of Beneficial Use Submitted
☐ Transferred Right for which Proof has been Filed	-	
	Previous Transfer Number	Date Claim of Beneficial Use Submitted
☐ Permit for Supplemental Irrigation	-	
	Permit Number	

- Name on Permit, Certificate, or Decree: United States of America Bureau of Reclamation
- Priority Date(s): Feb. 14, 1916 - Aug. 19, 1924

If there are **multiple Priority Dates** identified on the water right, any information provided in Supplemental Form A of this application must identify which priority date is associated with each of the authorized points of diversion or appropriation and places of use.

Source(s) of Water to be Affected by Transfer: Owyhee River

Tributary to: Snake River

- Are there **other water rights**, Permits or Ground Water Registrations associated with this land?
Yes ☒ No ☐ If "Yes", what are the Permit, Registration or Certificate Numbers:

#'s : _____

Any "layered" water use or a right that is supplemental to a primary right proposed for transfer **must be included in the transfer or be cancelled.**

Received
DEC 15 2025
OWRD

▪ Certificate Number or other identifying number: _____

The following information must be provided only for those points of diversion or appropriation that are involved in the transfer.

If a point of diversion or appropriation is not numbered on the decree or water right certificate or permit, assign it a unique number in the following table (e.g. POD #1 or POA(well) #1). Use the number to refer to the point of diversion or appropriation serving the place of use described in Tables I and II. Note: Permanent district transfers do not allow for a change in point of diversion or appropriation to serve the proposed place of use.

Government lot and donation land claim numbers must be included in the table below **only** if the information is reflected on the existing water right.

Location of Existing Authorized Point(s) of Diversion (POD) or Appropriation (POA):
(i.e., the allowed point(s) of diversion or appropriation listed on the water right for the "FROM" or "OFF" lands)

AUTHORIZED POINT(S) of DIVERSION (POD) or APPROPRIATION (POA)							
POD# or POA#	TWP (N or S)	RNG (E or W)	SEC	Q-Q	DLC	GOV'T LOT	MEASURED DISTANCES
1	22S	45E	20	NWSE			within the NW1/4SE1/4, section 20: (Owyhee Dam) 200 feet south & 2010 feet West from common corner corner to section 20 and 21 and (Glory Hole Spillway) 200 feet South and 1680 feet West from common corner corner to Section 20 and 21 and within the NW1/4SW1/4, Section 21, (Tunnel No. 1) 495 feet East and 264 feet South from common corner corner to Section 20 and 21, all in T.22., R.45 E., W.M.

OWRD

14778 -

Received
DEC 15 2025
OWRD

14778 -

Owyhee Irrigation District


SEC. 05 T20S R46E

Scale - 1" = 400'



DINN: 25-27403

SW 1/4 of the NE 1/4

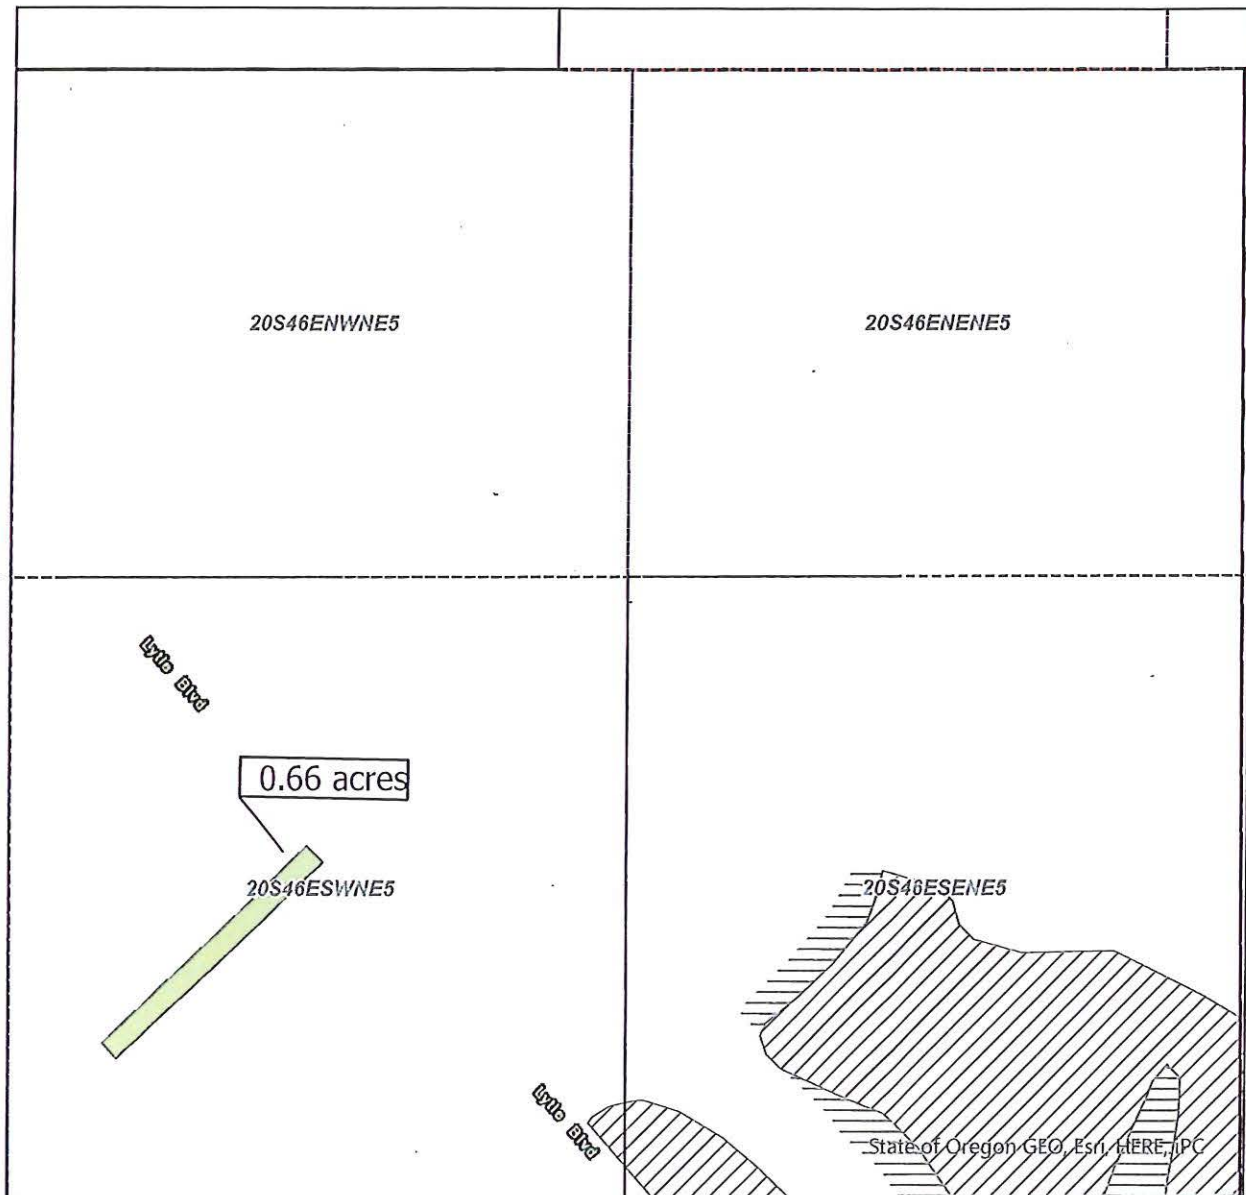

Received
DEC 15 2025
OWIRD

"ON" Map

2025 District Transfer Application

NAME: Campbell, Bruce

TAXLOT - 300, 20S46E05 SW/NE: 0.66 Acres ON, 5.7 Acres Remaining (Cert. 75691 IR)

14778 -



Date: 11/19/2025

14778 -


Owyhee Irrigation District

SEC. 21 T16S R47E

Scale - 1" = 400'

SW 1/4 of the SE 1/4

DINN: 25-73000

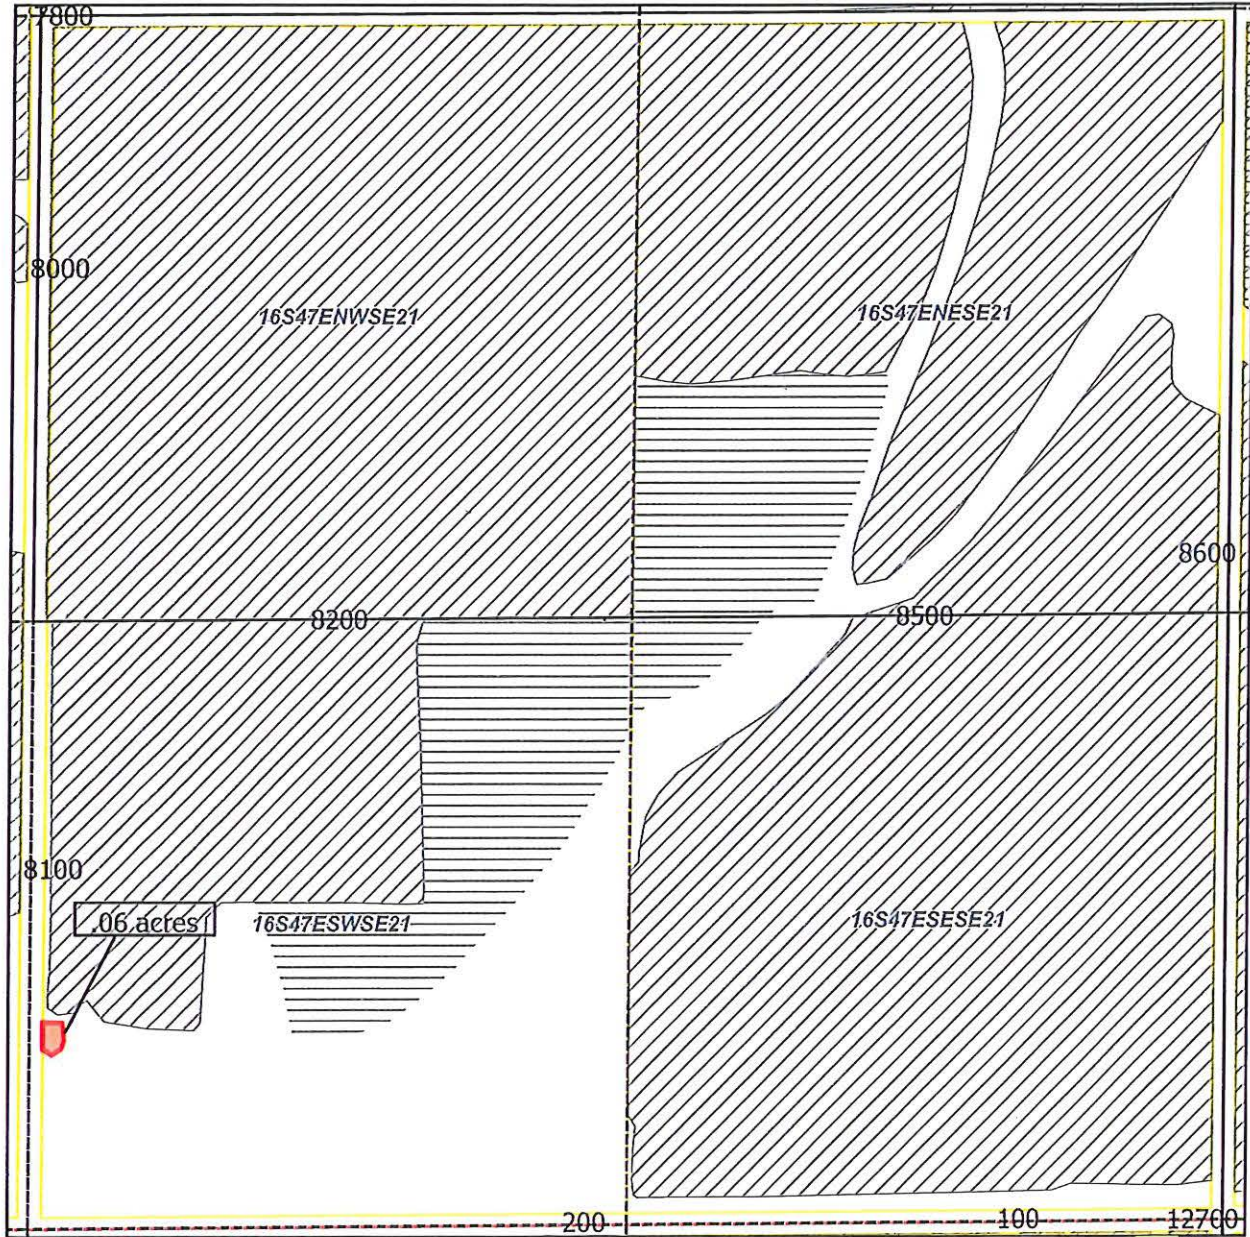

Received
DEC 15 2025
OWIRD

"OFF" Map

2025 District Transfer Application

NAME: Koehn, Russel

TAXLOT - 8200, 16S47E21 SW/SE: 0.06 Acres OFF, 13.24 Acres Remaining (Cert 75691 IR)

- On
- Off
- 75691
- 75712
- All Other Certificates
- TL_Apr2023



14778 -

Date: 11/4/2025

Owyhee Irrigation District

SEC. 20 T16S R47E


Scale - 1" = 400'

NW 1/4 of the NE 1/4

SW 1/4 of the NE 1/4

SE 1/4 of the NE 1/4

DINN: 25-76200

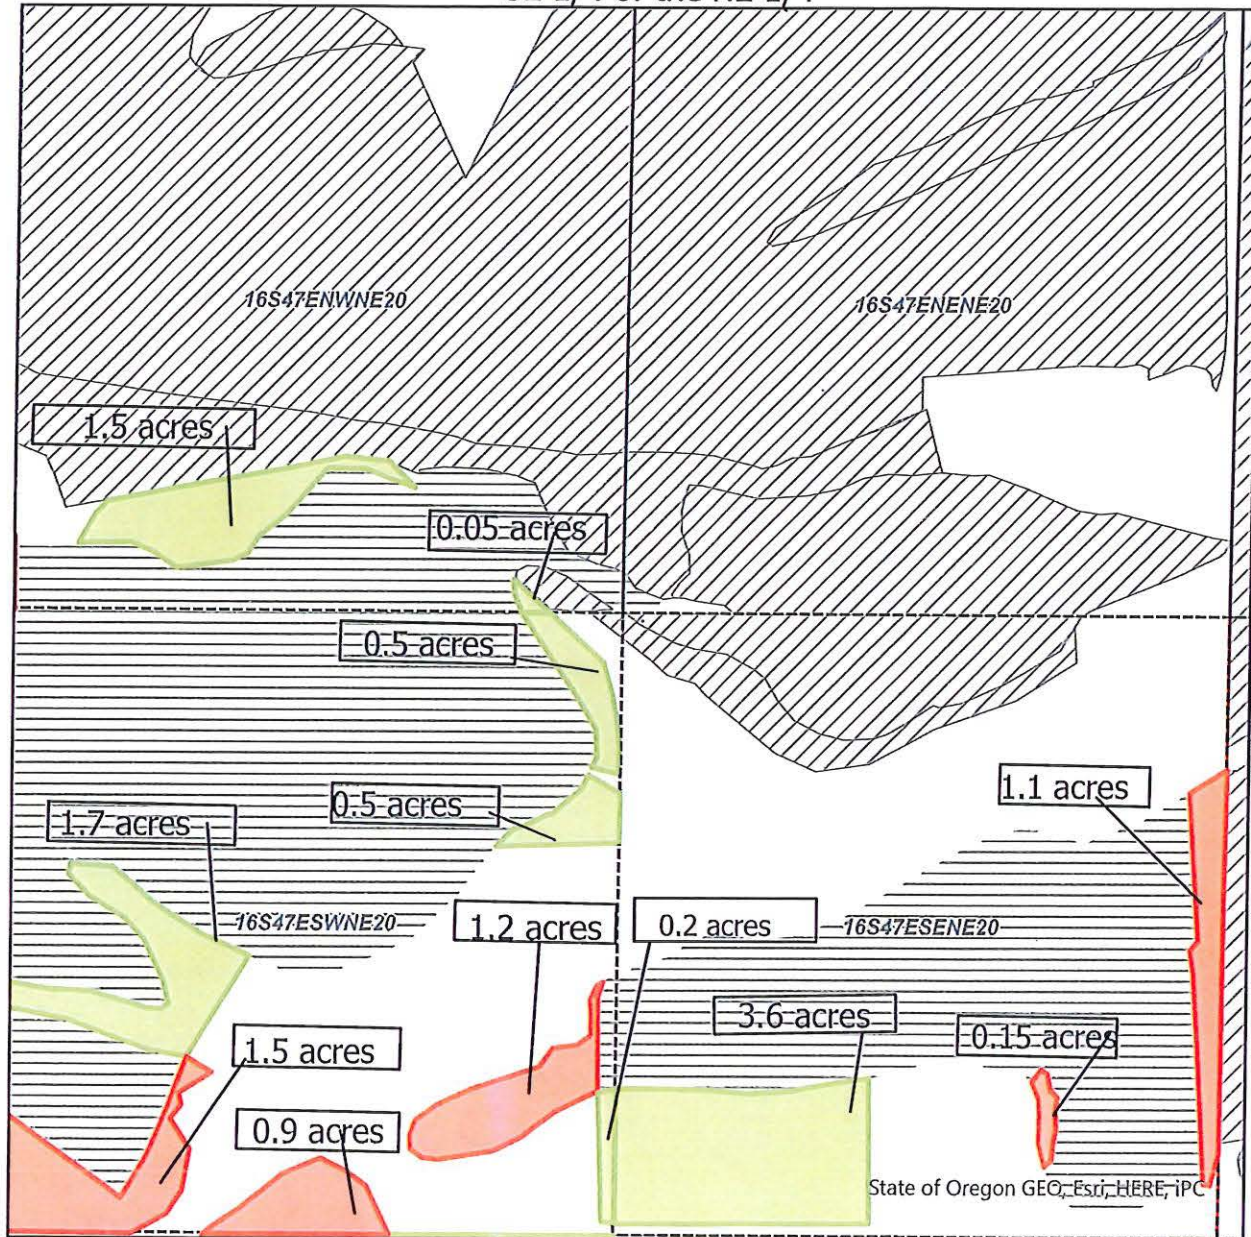

Received
DEC 15 2025
OWRD

"ON/OFF" Map

2025 District Transfer Application

NAME: Dean, Guy

14778 -

TAXLOT - 6900, 16S47E20 NW/NE: 1.55 Acres ON, 7.55 Acres Remaining (Permit S-54398)

TAXLOT - 6900, 16S47E20 SW/NE: 2.7 Acres OFF, 21.4 Acres Remaining (Permit S-54398)

TAXLOT - 6900, 16S47E20 SW/NE: 2.9 Acres ON, 24.3 Acres Remaining (Permit S-54398)

TAXLOT - 6900 16S47E20 SW/NE: 0.9 Acres OFF, 0 Acres Remaining (Cert. 75961 IR)

TAXLOT - 6900, 16S47E20 SE/NE: 1.25 Acres OFF, 13.65 Acres Remaining (Permit S-54398)

TAXLOT - 6900, 16S47E20 SE/NE: 3.6 Acres ON, 17.25 Acres Remaining (Permit S-54398)



Date: 11/6/2025

Owyhee Irrigation District


SEC. 20 T16S R47E

Scale - 1" = 400'

NE 1/4 of the NW 1/4

SE 1/4 of the NW 1/4

DINN: 25-76200

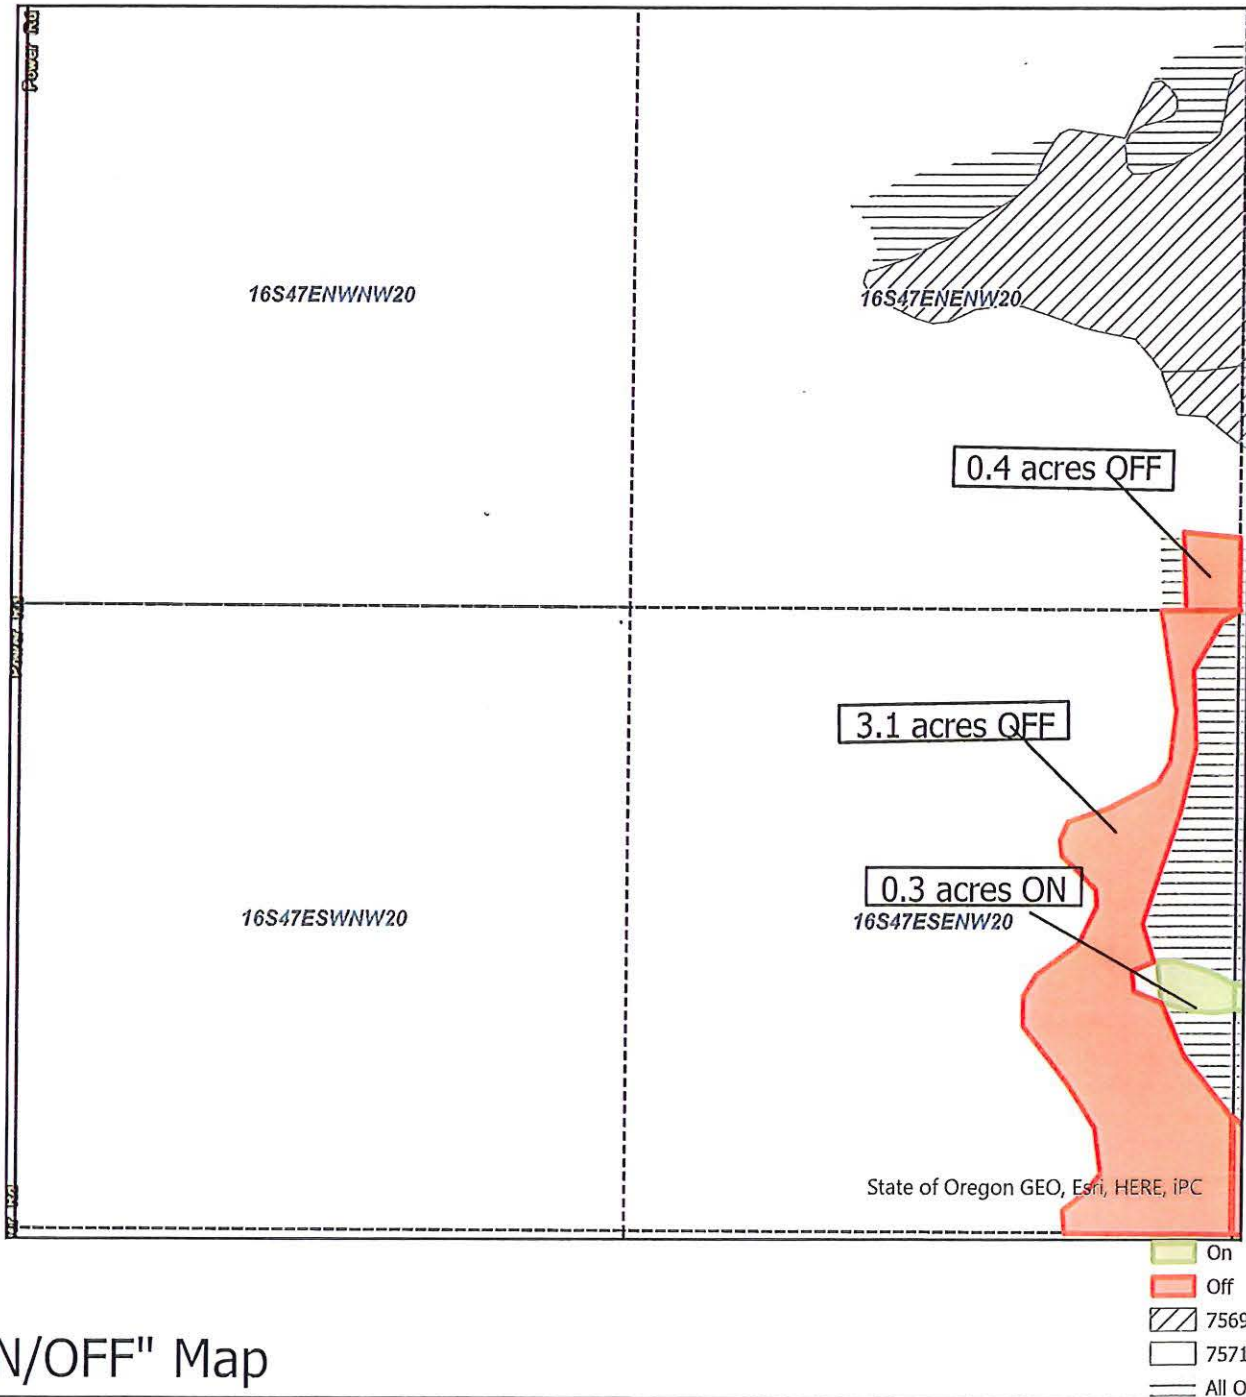

"ON/OFF" Map

2025 District Transfer Application

NAME: Dean, Guy

TAXLOT - 6900, 16S47E20 NE/NW: 0.40 Acres OFF, 8.6 Acres Remaining (Permit S-54398)
TAXLOT - 6900, 16S47E20 SE/NW: 3.1 Acres OFF, 2.6 Acres Remaining (S-54398)
TAXLOT - 6900, 16S47E20 SE/NW: 0.30 Acres ON, 2.9 Acres Remaining (Permit S-54398)

14778 -

Date: 11/6/2025



Owyhee Irrigation District


SEC. 22 T21S R46E

Scale - 1" = 400'



DINN: 25-7300

SW 1/4 of the NE 1/4

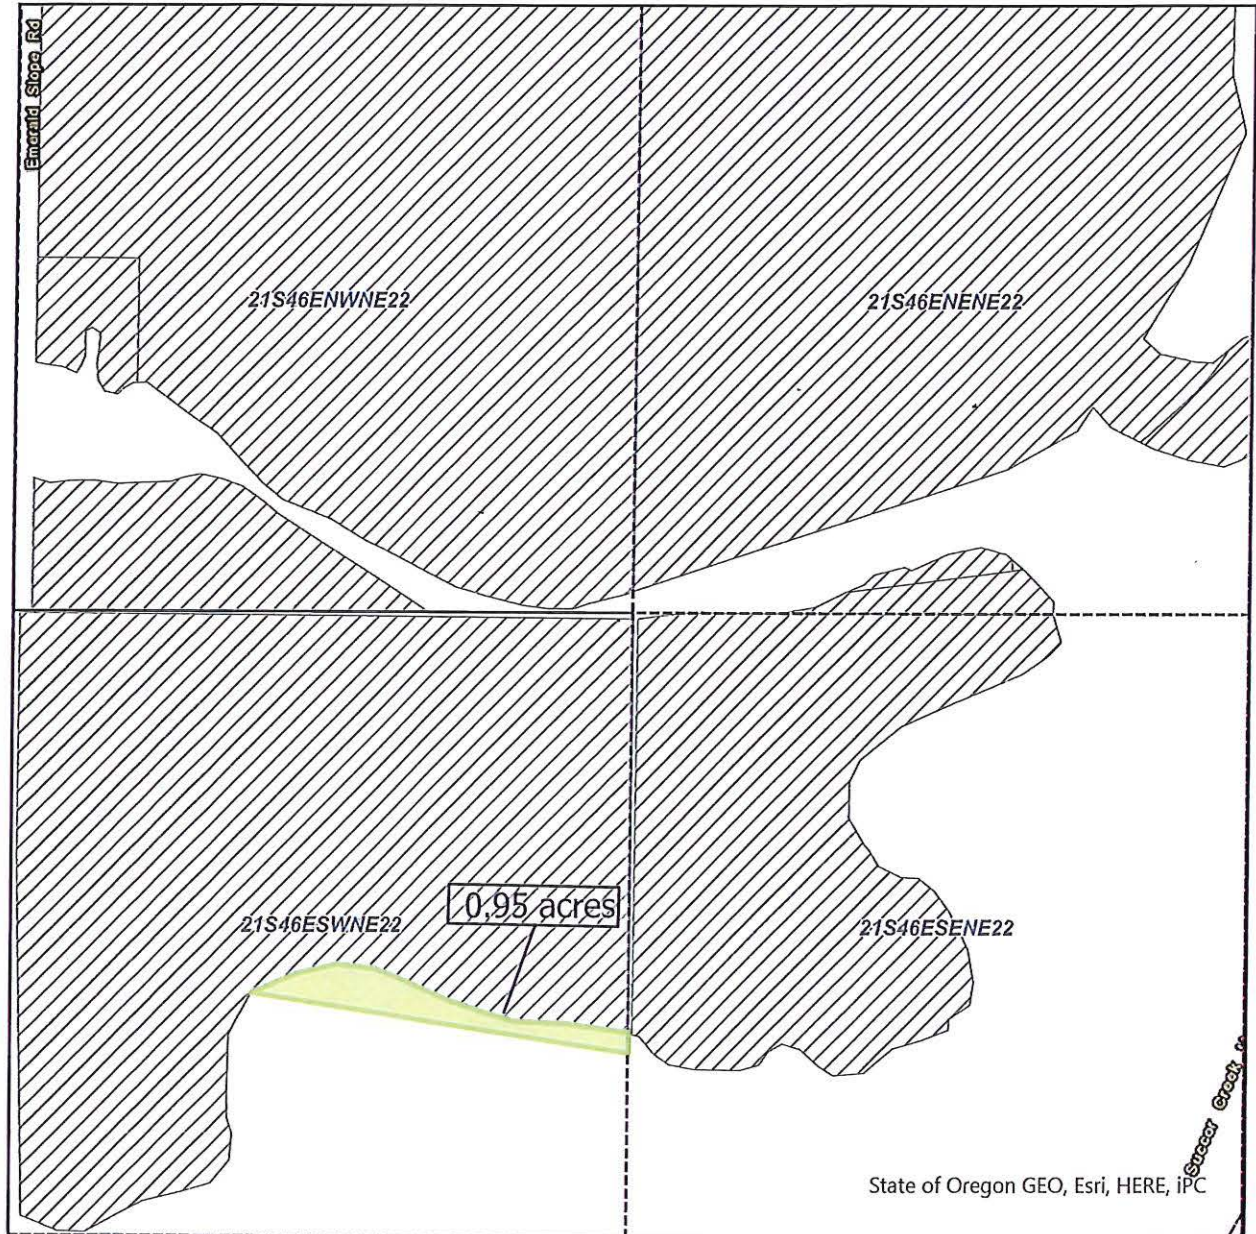

"ON" Map

2025 District Transfer Application

NAME: White, Eric

TAXLOT - 300, 21S46E22 SW/NE: 0.95 Acres ON, 27.85 Acres Remaining (Cert. 75691 II



14778 -

Date: 11/18/2025

Owyhee Irrigation District

SEC. 11 T21S R46E

Scale - 1" = 400'



DINN: 25-7300

NE 1/4 of the SW 1/4



Received
DEC 15 2025
OWRD

"OFF" Map

- On
- Off
- 75691
- 75712
- All Other Certificates

2025 District Transfer Application

NAME: White, Eric

TAXLOT - 1200, 21S46E11 NE/SW: 0.95 Acres OFF, 26.25 Acres Remaining (Cert. 75691 IF



14778 -

Date: 11/18/2025

Owyhee Irrigation District


SEC. 11 T21S R46E

Scale - 1" = 400'



DINN: 25-100

SE 1/4 of the SE 1/4

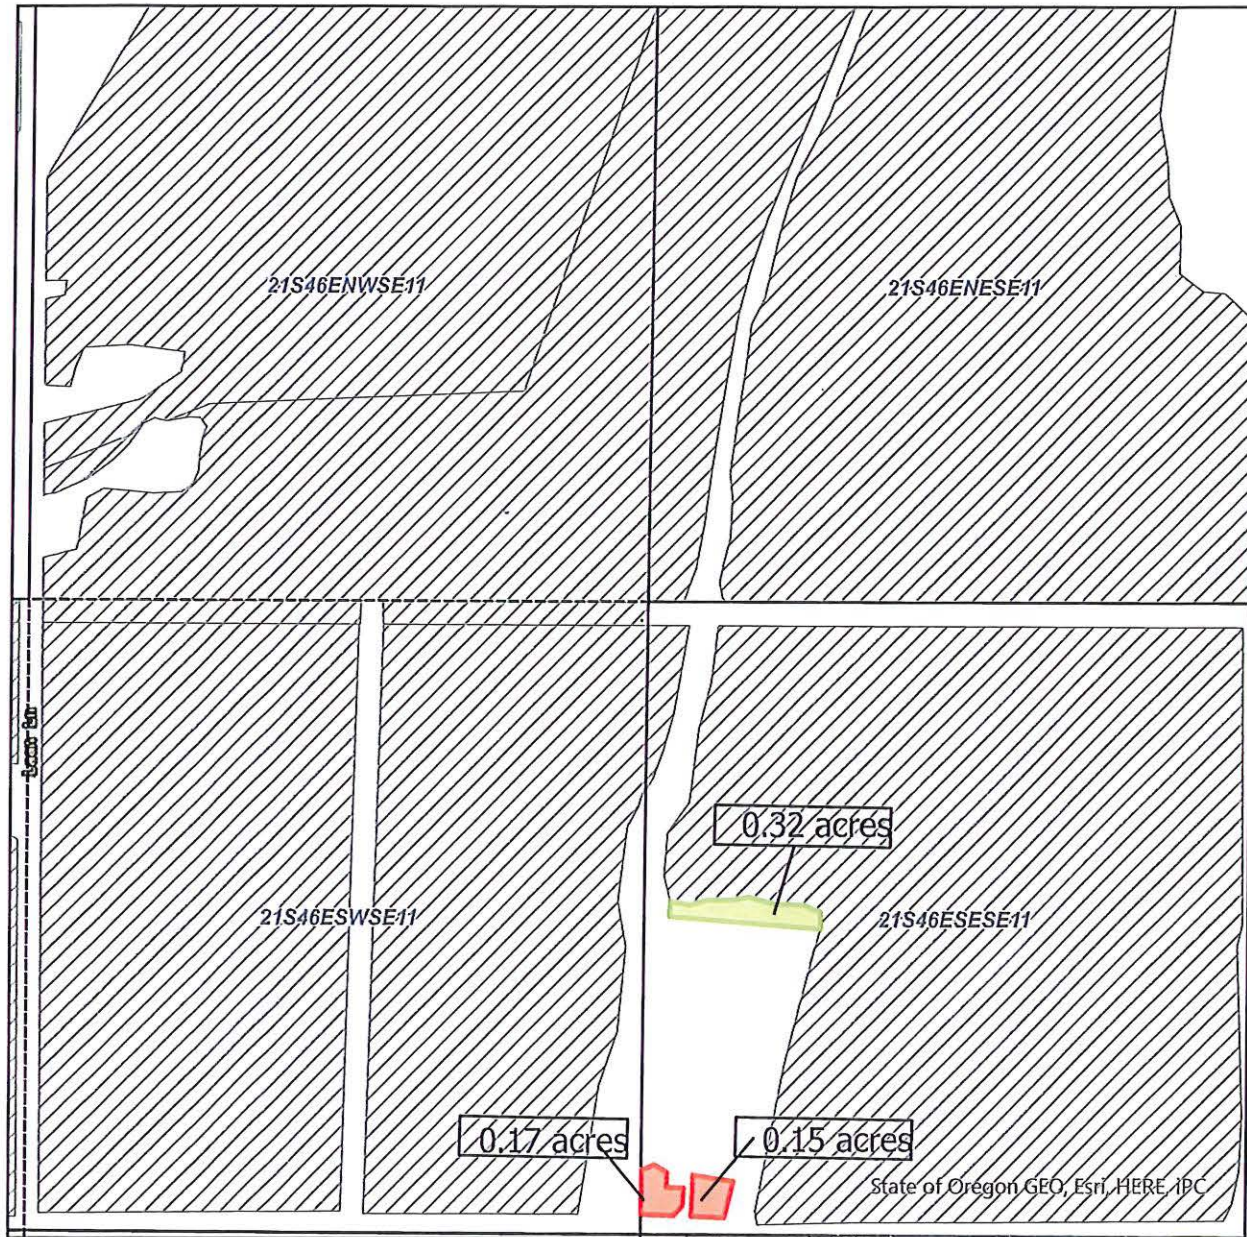

Received
DEC 15 2025
OWRD

"ON/OFF" Map

2025 District Transfer Application

NAME: Wagstaff, Austin

- On
- Off
- 75691
- 75712
- All Other Certificates

TAXLOT - 1700, 21S46E11 SE/SE: 0.32 Acres OFF, 33.1 Acres Remaining (Cert. 75691 IR)
TAXLOT - 1700, 21S46E11 SE/SE: 0.32 Acres ON, 33.1 Acres Remaining (Cert. 75691 IR)

14778 -