


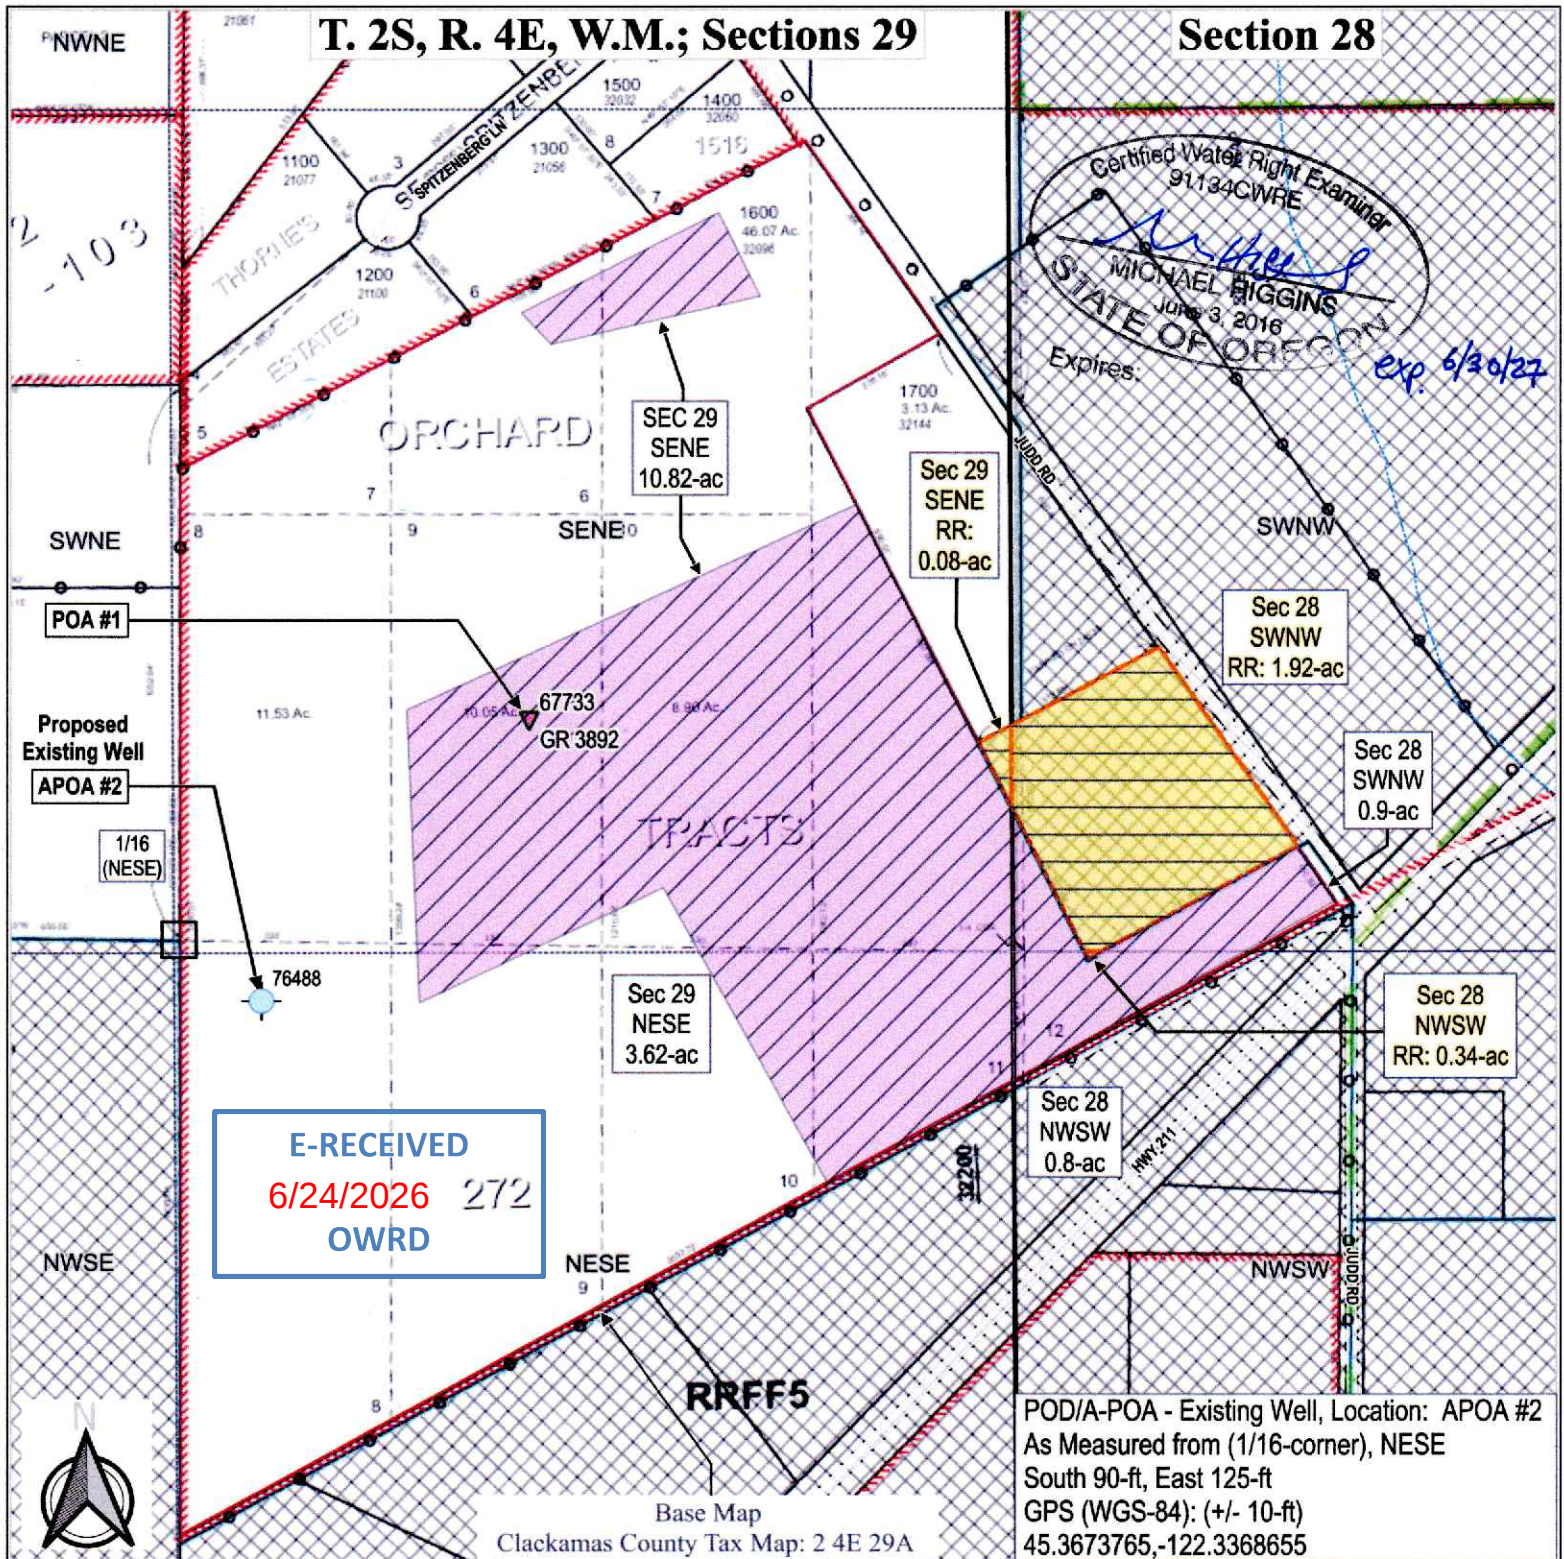

Transfer: Project Proposed
T 13817

Add - POA #2: Existing Well
Well Log ID (CLAC 76488)

POU: Cert. 67733

GW - POU
(QQ Acres Total: 16.14-ac)

OR Geospatial

T-R_Section (No.)

Section QQ

Clackamas County GIS

Streets

OWRD

Water Rights

POA #1

GW - Cert. 67733; GR 3892
Well Lod ID (CLAC 6386)

POA - CERT. 67733:
QQ - Remaining Right (RR): 2.34-ac
Tax Map_Lot: 24E28B_1600

DISCLAIMER

This map was prepared for the purpose of identifying the location for water right only and is not intended to provide legal dimensions or location of property ownership lines.

0 150 300 450 600 ft

1:3,600

Scale 1":300' when printed at 8.5"x11.0" (Letter)

Source:
Project CRS: EPSG: 6557 - NAD83(2011) / Oregon GIC Lambert (ft)
GIS Data: OR Geospatial, OWRD, Clackamas County

HGX Solutions, LLC
Survey Map Prepared By:
Michael Higgins, C.W.R.E.
Date: June 24, 2026

Transfer (T 13817) - APOA, Application Map (Amendment)
Under Certificate No. 67733
In the name of Patterson Nursery Sales Inc.
Clackamas County - Eagle Creek, Oregon