

District

T-10510

Name COIDAddress 1055 SW Lake CtRedmond, OR 97756541-548-6047 541-548-0243 FaxChange in POUDate Filed 12/24/2007Initial notice date 1-8-08

DPD issued date

PD issued date

PD notice date

Date of FO 9-16-08 Vol 75 Page 754

C-Date

COBU due date

COBU Received date

Certificate issued

DESCRIPTION OF WATER RIGHT(S)

Name of Stream Deschutes R / Crane PrairieTrib. of Columbia R / Deschutes RUse IO Tr. mu PD QM stCounty Cook Deschutes Jefferson

Quantity of water (CFS)

No. of Acres

Name of ditch

App # Deschutes R Dec Per #Cert # 76358 PR Date 1900, 1907App # 13180 Per # 23256Cert # 76214 PR Date 1913

App # Per #

Cert # PR Date

App # Per #

Cert # PR Date

App # Per #

Cert # PR Date

FEES PAID

Date	Amount	Receipt #
12/24/07	600.00	91037

FEES REFUNDED

Date	Amount	Receipt#
------	--------	----------

Assignments:

Irrigation District N/A OR COIDAgent N/A

CWRE

CC's list Deschutes County, Jefferson County Planning Dept☐ - Oversized map - Location

**STATE OF OREGON
WATER RESOURCES DEPARTMENT**

RECEIPT # **91037**

725 Summer St. N.E. Ste. A
SALEM, OR 97301-4172
(503) 986-0900 / (503) 986-0904 (fax)

INVOICE # _____

RECEIVED FROM:

BY: Central Oregon
Irrigation District

APPLICATION

PERMIT

TRANSFER

T-10510

CASH:

CHECK: #

OTHER: (IDENTIFY)

☐

☒ 4827

☐

TOTAL REC'D

\$ 600.00

1083 TREASURY 4170 WRD MISC CASH ACCT

0407

COPIES

PLA 4611

\$

OTHER:

(IDENTIFY)

\$

0243 I/S Lease

0244 Muni Water Mgmt. Plan

0245 Cons. Water

4270 WRD OPERATING ACCT

MISCELLANEOUS

0407

COPY & TAPE FEES

\$

0410

RESEARCH FEES

\$

0408

MISC REVENUE: (IDENTIFY)

\$

TC162

DEPOSIT LIAB. (IDENTIFY)

\$

0240

EXTENSION OF TIME

\$

WATER RIGHTS:

0201

SURFACE WATER

EXAM FEE

\$

0202

RECORD FEE

\$

0203

GROUND WATER

\$

0204

\$

0205

TRANSFER

\$ 600.00

WELL CONSTRUCTION

EXAM FEE

\$

0219

LICENSE FEE

\$

0218

WELL DRILL CONSTRUCTOR

0220

\$

LANDOWNER'S PERMIT

OTHER

(IDENTIFY)

0536 TREASURY 0437 WELL CONST. START FEE

0211

WELL CONST START FEE

\$

CARD #

0210

MONITORING WELLS

\$

CARD #

OTHER

(IDENTIFY)

0607 TREASURY 0467 HYDRO ACTIVITY LIC NUMBER

0233

POWER LICENSE FEE (FW/WRD)

\$

0231

HYDRO LICENSE FEE (FW/WRD)

\$

HYDRO APPLICATION

\$

TREASURY

OTHER / RDX

FUND

TITLE

OBJ. CODE

VENDOR #

DESCRIPTION

\$

RECEIPT: **91037**

DATED: 12/24/07

BY: [Signature]

Distribution - White Copy - Customer, Yellow Copy - Fiscal, Blue Copy - File, Buff Copy - Fiscal



Oregon

John A. Kitzhaber, MD, Governor

Water Resources Department
North Mall Office Building
725 Summer Street NE, Suite A
Salem, OR 97301-1271
503-986-0900
FAX 503-986-0904

June 30, 2011

Eagle Point Irrigation District
PO Box 157
Eagle Point OR 97524

RE: Correcting Order

Enclosed is a new correcting final order. Please read the order carefully.

If you have any questions regarding this certificate please contact the transfer section at 503-986-0883.

Sincerely,

Jonnine Skaug
Executive Support

enclosure

cc: Watermaster #11
File (T-10510)

**BEFORE THE WATER RESOURCES DEPARTMENT
OF THE
STATE OF OREGON**

In the Matter of Transfer Application)
T-10510, Jackson County) **FINAL ORDER CORRECTING A
DISTRICT PERMANENT TRANSFER**

Authority

ORS 540.570 to 540.580 establishes the process in which a district may submit a request to transfer a water right within district boundaries. OAR Chapter 690, Division 385 implements the statutes and provides the Department's procedures and criteria for evaluating district transfer applications.

Applicant

EAGLE POINT IRRIGATION DISTRICT
PO BOX 157
EAGLE POINT, OR 97524

Findings of Fact

1. On February 24, 2010, the Department issued an order approving Transfer Application T-10510 filed by Eagle Point Irrigation District (EPID). The order is recorded in Special Order Volume 80, Pages 338 – 341.
2. On June 28, 2011, the following scrivener's error was noted on the proposed places of use under Certificate 75429:

Proposed Place of Use:

IRRIGATION							
Twp	Rng	Mer	Sec	Q-Q	Acres	Owner Name	Notice
36 S	1 W	WM	34	NWNW	1.30	VALENCIA	005-008

3. The correct location for the proposed place of use under Certificate 75429 should have been listed as follows (cited below in **bold**):

Proposed Place of Use:

IRRIGATION							
Twp	Rng	Mer	Sec	Q-Q	Acres	Owner Name	Notice
35 S	1 W	WM	34	NWNW	1.30	VALENCIA	005-008

Now, therefore, it is ORDERED:

1. The proposed correction in place of use to the water rights evidenced by Certificate 75429 is corrected.

This is an order in other than a contested case. This order is subject to judicial review under ORS 183.484. Any petition for judicial review must be filed within the 60-day time period specified by ORS 183.484(2). Pursuant to ORS 536.075 and OAR 137-004-0080, you may petition for judicial review or petition the Director for reconsideration of this order. A petition for reconsideration may be granted or denied by the Director, and if no action is taken within 60 days following the date the petition was filed, the petition shall be deemed denied.

2. All other terms and conditions contained in the original approving order, Special Order Volume 80, Pages 418 – 421 remain unchanged.

Dated at Salem, Oregon this 30 day of June, 2011.


Dwight French, Water Right Services Administrator
PHILLIP C. WARD, DIRECTOR

Mailing Date: JUL 01 2011



Oregon

Theodore R. Kulongoski, Governor

Water Resources Department

North Mall Office Building
725 Summer Street NE, Suite A
Salem, OR 97301-1266
503-986-0900
FAX 503-986-0904

October 29, 2010

Central Oregon Irrigation District
1055 SW Lake Court
Redmond, OR 97756

RE: Determination of Satisfactory Proof

Enclosed is a copy of the Special Order Volume 82, Page 1198 approving the determination of satisfactory proof for Transfer application T-10510. This order was signed by the Department on October 29, 2010.

If you have any questions regarding this order please contact the transfer section at 503-986-0888.

Sincerely,

Sarah Henderson
Executive Support

enclosure

cc: Watermaster #11
Water Availability
File T-10510



**BEFORE THE WATER RESOURCES DEPARTMENT
OF THE
STATE OF OREGON**

In the Matter of the Completion of a	)	
Change of Place of Use Authorized by the	)	DETERMINATION OF
Final Order Approving District Permanent	)	SATISFACTORY PROOF
Transfer T-10510	)	

Authority

OAR 690-385-7600 describes the process for the Water Resources Department to issue a water right certificate upon determination that an applicant has made satisfactory proof of completion of the changes authorized by a final order approving a district permanent transfer.

Applicant

Central Oregon Irrigation District
1055 SW Lake Court
Redmond, OR 97756

Findings of Fact

1. On September 16, 2008, the Department issued a final order, recorded in Special Order Volume 75, Pages 754 - 758, approving district permanent transfer application T-10510. The order established October 1, 2009, as the date for completion of the authorized change in place of use.
2. On September 30, 2010, the Department received a claim of beneficial use for T-10510.
3. The Department reviewed the claim of beneficial use and final proof maps submitted by the applicant for district permanent transfer T-10510.
4. The claim of beneficial use did not contain map(s) of the point(s) of diversion from the source. However, since these changes are for place of use only within an irrigation district, and do not involve changes in point of diversion, the existing map(s) on file with the Department are sufficient to identify the point(s) of diversion from the source.
5. The claim of beneficial use and final proof maps for portions of T-10510 identify a portion of the completed change differently from that authorized by the final order approving the transfer as described in the tables below:

This is a final order in other than a contested case. This order is subject to judicial review under ORS 183.484. Any petition for judicial review must be filed within the 60-day time period specified by ORS 183.484(2). Pursuant to ORS 536.075 and OAR 137-004-0080, you may petition for judicial review or petition the Director for reconsideration of this order. A petition for reconsideration may be granted or denied by the Director, and if no action is taken within 60 days following the date the petition was filed, the petition shall be deemed denied.

Change authorized by final order approving transfer:

Twp	Rng	Sec	Mer	Q - Q	Tax Lot	Acres	User	Notice #
15 S	14 E	35	WM	NW SW	400	2.60	Powell Butte Farmers Club, Inc.	T-2007-028
17 S	12 E	24	WM	SE SE	1500	1.00	Monson	T-2007-029
Total:						3.60		

Change described by claim of beneficial use and final proof map:

Twp	Rng	Sec	Mer	Q - Q	Tax Lot	Acres	User	Notice #
15 S	14 E	35	WM	NW SW	400	2.60	Powell Butte Farmers Club, Inc.	T-2007-028
17 S	12 E	24	WM	SE SE	1500	1.00	Monson	T-2007-029
Total:						3.60		

*Changes are within the same quarter-quarter.

- The reconfigured change in location of use as mapped is determined satisfactory because the completed use is contiguous and on adjacent land within the same tax lot and ownership.
- A scrivener's error in tax lot number was noted in the final order approving the transfer as is further described below:

Description of place of use in the final order:

Twp	Rng	Sec	Q - Q	Tax Lot	Acres	User	Notice #
18 S	13 E	6	NE NE	101	1.40	Tuma	T-2007-023

Correction of the description of place of use in the final order:

Twp	Rng	Sec	Q - Q	Tax Lot	Acres	User	Notice #
18 S	13 E	6	NE NE	100	1.40	Tuma	T-2007-023

Note-Correction in bold.

- Satisfactory proof of the changes was submitted with evidence showing that water was used in the location and for the purpose as authorized by the final order approving T-10510, other than noted above.

Conclusions of Law


Pursuant to OAR 690-385-7600, the Department may issue a certificate upon a determination that the application of water to beneficial use under the terms of the final order approving a permanent district transfer was completed to the extent authorized.

Now, therefore, it is ORDERED:

The Department has determined that the application of water to beneficial use under the terms of the final order approving district permanent transfer T-10510 was completed to the extent authorized.

Pursuant to OAR 690-385-7600, the Department will issue a water right certificate on a determination that it is necessary to produce a certificate describing the right.

Dated at Salem, Oregon this 29 day of October, 2010.

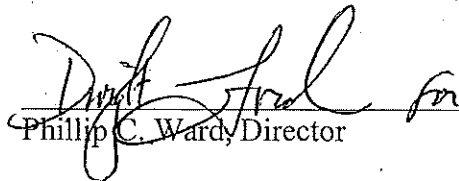
Phillip C. Ward, Director

Mailing Date: NOV 01 2010



CENTRAL OREGON IRRIGATION DISTRICT

1055 SW LAKE COURT, REDMOND, OR 97756

PHONE: 541.548.6047 FAX: 541.548.0243

www.coid.org

A MUNICIPAL CORPORATION OF THE STATE OF OREGON

September 23, 2010

Susan Douthit
Oregon Water Resources Department
725 Summer Street N.E. Suite "A"
Salem, OR 97301-1271

RE: FINAL PROOFS – Claim of Beneficial Use for T-10510

Dear Susan,

Central Oregon Irrigation District is submitting our claim of beneficial use for a permanent District transfer ("385").


Attached is a list of the "ON" lands. Site reports are attached to each map and any specific details about the properties are contained in each site report.

Please Note: The below noted properties have had mapping or ownership changes:

1. Powell Butte Farmer's Club 15-14-35 NW SW 00400 – map change
2. 16-12-01 SE NE 00200 ownership change to: Mary Sue Wallace Trustee of the W.F. Wallace Q-Tip Trust
3. Robert & Ester Monson 17-12-24 SE SE 01500 – map change
4. Correction to District internal transfer #2007-023, 18-13-06 NE NE 00100. Maps submitted with transfer were correct but the authorized and proposed lands were identified incorrectly – Order was issued reflecting the error and needs to be corrected.

The District has inspected all of the above parcels to confirm that the changes have been made as mapped and contained in the final proof report.

I am authorized to sign on behalf of Central Oregon Irrigation District.

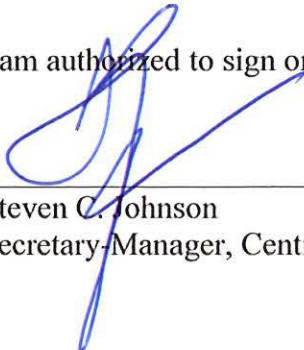

Steven C. Johnson
Secretary-Manager, Central Oregon Irrigation District

Date: 23 Sept. 2010



Central Oregon Irrigation District

Claim of Beneficial Use

For COID Petition # P-2007-006

STATE ORDER # 10510

For Permanent 385 Transfers

Submitted 09-29-10

TABLE 1. - AUTHORIZED PLACE OF USE

CORRECTED _ SEPTEMBER 22, 2010

Cert/Decree	Cert/Perm										
PRIMARY	SUPP	TRANSFER NBR	POD	USE	TWP	RNG	SEC	QQ	LOT	ACRES	USER NAME
83571	76714	T-2007-027	#11	IRRIG	16	12	01	NESE	00200	0.010	Wallace, Mary Sue
83571	76714	T-2007-027	#11	IRRIG	16	12	01	SENE	00200	0.250	Wallace, Mary Sue
83571	76714	T-2007-034	#1	IRRIG	16	14	08	SESE	00101	1.200	Schinkel Family Revocable Living Trust
83571	76714	T-2007-034	#1	IRRIG	16	14	08	SESE	00101	0.400	Schinkel Family Revocable Living Trust
83571	76714	T-2007-028	#1	IRRIG	16	14	16	NWSW	00201	2.600	Bovee, Alan/Margaret
83571	76714	T-2007-026	#1	IRRIG	17	13	33	SWNW	01106	0.150	Waits, Ronald/Michelle
83571	76714	T-2007-030	#1	IRRIG	17	14	15	SENE	00500	0.350	Bean, Darcy
83571	76714	T-2007-029	#1	IRRIG	17	14	22	NESE	00801	0.200	COID/Quitclaim
83571	76714	T-2007-029	#1	IRRIG	17	14	23	SWSE	01200	0.500	COID/Quitclaim
83571	76714	T-2007-029	#1	IRRIG	18	12	04	SESW	00600	0.300	COID/Quitclaim
83571	76714	T-2007-023	#1	IRRIG	18	13	06	NENE	00101	1.400	Tuma, Ben/Shelley

TABLE 2. - PROPOSED PLACE OF USE

CORRECTED _ SEPTEMBER 22, 2010

Cert/Decree	Cert/Perm										
PRIMARY	SUPP	TRANSFER NBR	POD	USE	TWP	RNG	SEC	QQ	LOT	ACRES	USER NAME
83571	76714	T-2007-028	#1	IRRIG	15	14	35	NWSW	00400	2.600	Powell Butte Farmers Club, Inc
83571	76714	T-2007-027	#11	IRRIG	16	12	01	SENE	00200	0.010	Wallace, Mary Sue
83571	76714	T-2007-027	#11	IRRIG	16	12	01	SENE	00200	0.250	Wallace, Mary Sue
83571	76714	T-2007-034	#1	IRRIG	16	14	08	SESE	00101	1.200	Schinkel Family Revocable Living Trust
83571	76714	T-2007-034	#1	IRRIG	16	14	17	NENE	00100	0.400	Schinkel Family Revocable Living Trust
83571	76714	T-2007-029	#1	IRRIG	17	12	24	SESE	01500	0.500	Monson, Robert/Esther
83571	76714	T-2007-029	#1	IRRIG	17	12	24	SESE	01500	0.200	Monson, Robert/Esther
83571	76714	T-2007-029	#1	IRRIG	17	12	24	SESE	01500	0.300	Monson, Robert/Esther
83571	76714	T-2007-026	#1	IRRIG	17	13	33	SWNW	01106	0.150	Waits, Ronald/Michelle
83571	76714	T-2007-030	#1	IRRIG	17	14	15	SENE	00500	0.350	Bean, Darcy
83571	76714	T-2007-023	#1	IRRIG	18	13	06	NENE	00100	1.400	Tuma, Ben/Shelley

The water right evidenced by Certificate 76714 allows the use of up to 50,000 acre-feet of water stored in Crane Prairie Reservoir, a tributary of the Deschutes River, for supplemental irrigation. The diversion rate is not specified and use is limited to the total volume of stored water to make up any deficiency in supply of the live flow water right appurtenant to specified lands.

Authorized Points of Diversion:

TWP	RNG	MER	SEC	Q-Q	Measured Distance
18S	11E	WM	13	SW NE	POD #1 (CENTRAL OREGON CANAL): 1520 FEET SOUTH AND 1535 FEET WEST OF THE NE CORNER OF SECTION 13
17S	12E	WM	29	SE NE	POD #11 (C.O.I.D. NORTH CANAL): 850 FEET NORTH AND 630 FEET WEST FROM THE E¼ CORNER OF SECTION 29

Authorized Place of Use:

TWP	RNG	MER	SEC	Q-Q	TAX LOT	ACRES	USER	NOTICE #	POD #
16 S	12 E	WM	1	SE NE	200	0.25	WALLACE, MARY SUE	T-2007-027	11
16 S	12 E	WM	1	NE SE	200	0.01	WALLACE, MARY SUE	T-2007-027	11
16 S	14 E	WM	8	SE SE	101	1.20	SCHINKEL FAMILY REVOCABLE LIVING TRUST	T-2007-034	1
16 S	14 E	WM	8	SE SE	101	0.40	SCHINKEL FAMILY REVOCABLE LIVING TRUST	T-2007-034	1
16 S	14 E	WM	16	NW SW	201	2.60	BOVEE, ALAN/MARGARET	T-2007-028	1
17 S	13 E	WM	33	SW NW	1106	0.15	WAITS, RONALD/MICHELLE	T-2007-026	1
17 S	14 E	WM	15	SE NE	500	0.35	BEAN, DARCY	T-2007-030	1
17 S	14 E	WM	22	NE SE	801	0.20	COID/QUITCLAIM	T-2007-029	1
17 S	14 E	WM	23	SW SE	1200	0.50	COID/QUITCLAIM	T-2007-029	1
18 S	12 E	WM	4	SE SW	600	0.30	COID/QUITCLAIM	T-2007-029	1
18 S	13 E	WM	6	NE NE	1001	1.40	TUMA, BEN /SHELLEY	T-2007-023	1
Total						7.36			

6. Transfer Application T-10510 proposes to change the place of use to:

TWP	RNG	MER	SEC	Q-Q	TAX LOT	ACRES	USER	NOTICE #	POD #
15 S	14 E	WM	35	NW SW	400	2.60	POWELL BUTTE FARMERS CLUB, INC.	T-2007-028	1
16 S	12 E	WM	1	SE NE	200	0.01	WALLACE, MARY SUE	T-2007-027	11
16 S	12 E	WM	1	SE NE	200	0.25	WALLACE, MARY SUE	T-2007-027	11
16 S	14 E	WM	8	SE SE	101	1.20	SCHINKEL FAMILY REVOCABLE LIVING TRUST	T-2007-034	1
16 S	14 E	WM	17	NE NE	100	0.40	SCHINKEL FAMILY REVOCABLE TRUST	T-2007-034	1
17 S	12 E	WM	24	SE SE	1500	0.50	MONSON, ROBERT/ESTHER	T-2007-029	1
17 S	12 E	WM	24	SE SE	1500	0.20	MONSON, ROBERT/ESTHER	T-2007-029	1
17 S	12 E	WM	24	SE SE	1500	0.30	MONSON, ROBERT/ESTHER	T-2007-029	1
17 S	13 E	WM	33	SW NW	1106	0.15	WAITS, RONALD/MICHELLE	T-2007-026	1
17 S	14 E	WM	15	SW NW	500	0.35	BEAN, DARCY	T-2007-030	1
18 S	13 E	WM	6	NE NE	1001	1.40	TUMA, BEN/SHELLEY	T-2007-023	1
Total						7.36			

FINAL PROOF SITE REPORT

Claim of Beneficial Use

Petition #: P-2007-006

State #: T-10510

Transfer #: T-2007-028

Property Owner (Applicant): Powell Butte Farmers Club, Inc

Canal: COC

Current Owner:

Head Gate: COC-44

Property Description: 15-14-35 NW SW 00400 Acres: 2.60

Type of Use: Irrig

Property Address: 8404 SW Reif Rd, Powell Butte

☐ Person interviewed (if any): None

☐ Method of irrigation (pump, flood, etc): Pump

☐ Use: crops produced: Grass

☐ Method used to calculate area irrigated: GPS

☐ Is beneficial use achieved in areas mapped: Yes

☐ Are there any mapping changes: Yes

IF NO,

☐ If not proved up, what measures have been completed: _____

☐ Failure to Prove up _____ acres of transferred water right

☐ If not irrigated as mapped, indicate changes on map: _____

☐ What measures are now needed?

Talk with water right user: _____

Follow up in _____ weeks/days

Re-visit site on _____

~~7-8-09 Dry, weeds
mowed. SK
No change 9-27-09 SK~~

NOTES: main line & handline in place new seed, irrigating, good growth

Inspected by: Stuart Keyte Date: 6-9-10



CROOK COUNTY
SEC.35 T15S. R14E. W.M.

SCALE - 1" = 400'



NW1/4 OF THE SW 1/4

OWRD TRANSFER #: T-10510

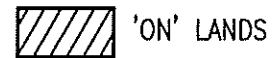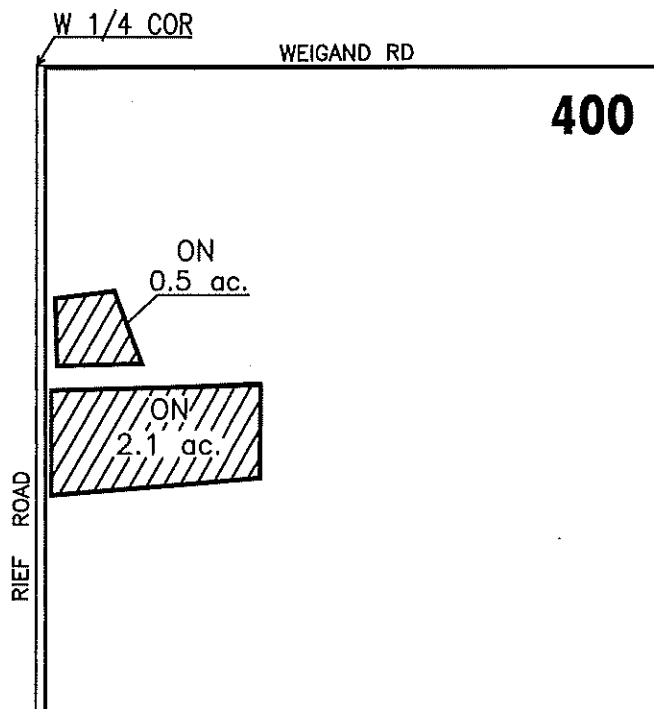

CENTRAL OREGON



IRRIGATION DISTRICT

FINAL PROOF MAP

NAME: POWELL BUTTE FARMERS CLUB, Inc.

TAXLOT #: 400

2.6 ACRES

DATE: 07-29-2010

FILE NO: I:\TRANSFER\FINALPRF\P2007-006\151435_NWSW

FINAL PROOF SITE REPORT

Claim of Beneficial Use

Petition #: P-2007-006

State #: T-10510

Transfer #: T-2007-027

Property Owner (Applicant): Wallace, Mary Sue

Current Owner: W.F. Wallace Q-Tip Trust

Property Description: 16-12-01 SE NE 00200 Acres: 0.26

Property Address: 6291 SW 46th St, Redmond

Canal: PBC

Head Gate: B-2-0-1

Type of Use: Irrig

☐ Person interviewed (if any): MARY WALLACE

☐ Method of irrigation (pump, flood, etc): PUMP SPRINKLE

☐ Use: crops produced: PASTURE GRASS

☐ Method used to calculate area irrigated: GPS

☐ Is beneficial use achieved in areas mapped: YES

☐ Are there any mapping changes: NO

IF NO,

☐ If not proved up, what measures have been completed: _____

☐ Failure to Prove up _____ acres of transferred water right

☐ If not irrigated as mapped, indicate changes on map: _____

☐ What measures are now needed?

Talk with water right user: _____

Follow up in _____ weeks/days

Re-visit site on _____

NOTES:

Inspected by: JED S Date: 8.27.09


**DESCHUTES COUNTY
SEC.01 T16S. R12E. W.M.**

SCALE - 1" = 400'


N ↑

SE 1/4 OF THE NE 1/4

OWRD TRANSFER #:T-10510

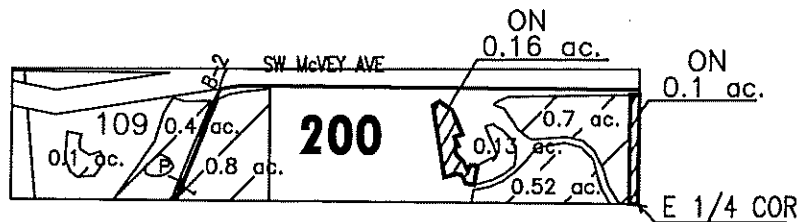

'ON' LANDS

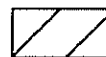

EXISTING WATER RIGHTS

CENTRAL OREGON



IRRIGATION DISTRICT

FINAL PROOF MAP

NAME: MARY SUE WALLACE

TAXLOT #: 200

0.26 ACRES

DATE: 07-29-2010

FILE NO: I:\TRANSFER\FINALPRF\P2007-008\161201_SENE

FINAL PROOF SITE REPORT

Claim of Beneficial Use

Petition #: P-2007-006

State #: T-10510

Transfer #: T-2007-034

Property Owner (Applicant): Schinkel Family Revocable Living Trust

Canal: COC

Current Owner:

Head Gate: K-6-1-1

Property Description: 16-14-08 SE SE 00101

Acres: 1.20

Type of Use: Irrig

16-14-17 NE NE 00100

Acres: 0.40

Type of Use: Irrig

Property Address: 12775 SW Powell Butte Hwy, Powell Butte

☒ Person interviewed (if any): Bob Schinkel

☒ Method of irrigation (pump, flood, etc): pump

☐ Use: crops produced: Hay, Grass

☐ Method used to calculate area irrigated: GPS

☐ Is beneficial use achieved in areas mapped: yes

☐ Are there any mapping changes: No

IF NO,

☐ If not proved up, what measures have been completed: _____

☐ Failure to Prove up _____ acres of transferred water right

☐ If not irrigated as mapped, indicate changes on map: _____

☐ What measures are now needed?

Talk with water right user: _____

Follow up in _____ weeks/days

Re-visit site on _____

NOTES:

Inspected by: Stuart Keyte Date: 8-17-09


CROOK COUNTY
SEC. 08 & 17 T16S. R14E. W.M.

SCALE - 1" = 400'



SE 1/4 OF THE SE 1/4 (SEC 08); NE 1/4 OF THE NE 1/4 (SEC 17)

OWRD TRANSFER #: T-10510

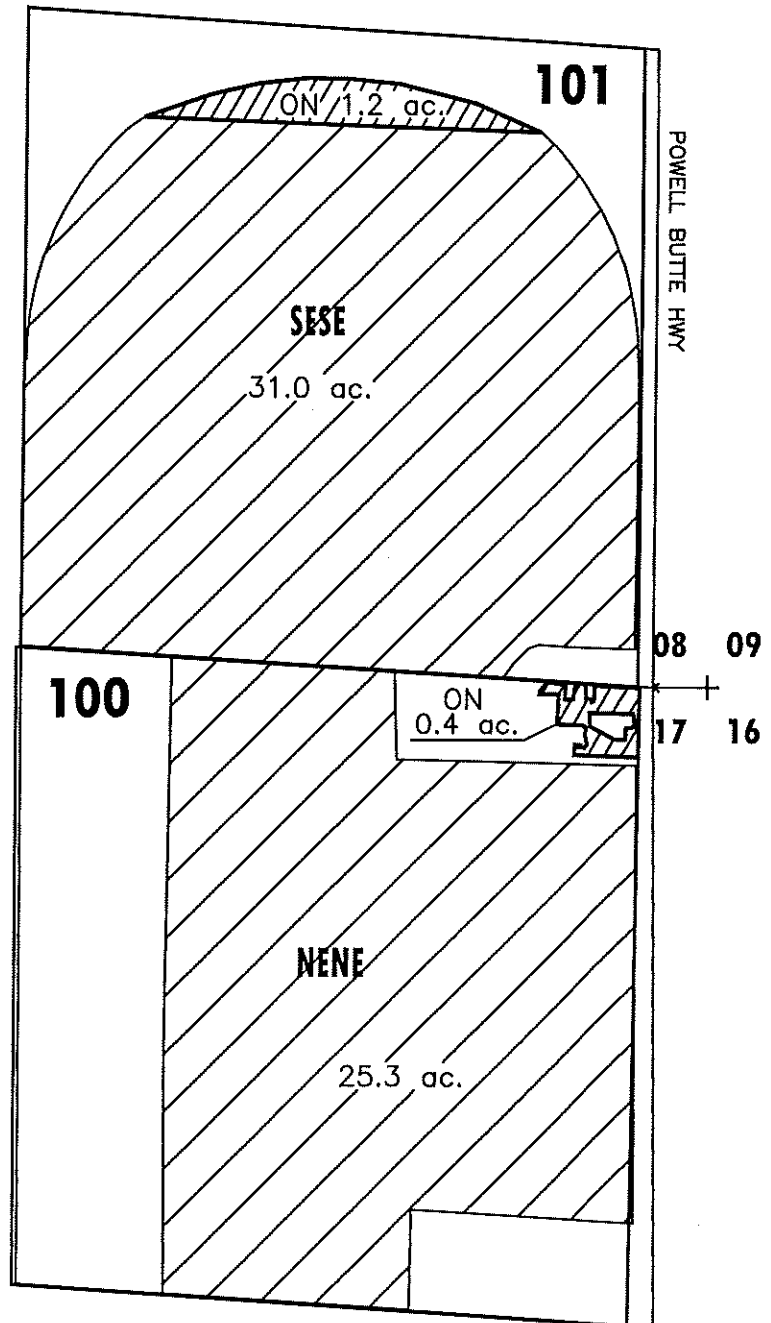

 'ON' LANDS

 EXISTING WATER RIGHTS

CENTRAL OREGON



IRRIGATION DISTRICT

FINAL PROOF MAP

NAME: SCHINKEL FAMILY REVOCABLE LIVING TRUST

TAXLOT #: 101, 100

1.6 ACRES

DATE: 07-29-2010

FILE NO: I:\TRANSFER\FINALPRF\P2007-006\161408_SESE

FINAL PROOF SITE REPORT

Claim of Beneficial Use

Petition #: P-2007-006

State #: T-10510

Transfer #: T-2007-029

Property Owner (Applicant): Monson, Robert & Esther

Current Owner:

Property Description: 17-12-24 SE SE 01500 Acres: 1.00

Property Address: 62887 Dickey Rd, Bend

Canal: COC

Head Gate: A-24-13

Type of Use: Irrig

☐ Person interviewed (if any): _____

☐ Method of irrigation (pump, flood, etc): pump

☐ Use: crops produced: Grass

☐ Method used to calculate area irrigated: GPS

☐ Is beneficial use achieved in areas mapped: Yes

☐ Are there any mapping changes: Yes

IF NO,

☐ If not proved up, what measures have been completed: _____

☐ Failure to Prove up _____ acres of transferred water right

☐ If not irrigated as mapped, indicate changes on map: _____

☐ What measures are now needed?

Talk with water right user: _____

Follow up in _____ weeks/days

Re-visit site on _____

NOTES:

Inspected by: Stuart Kaye Date: 8-24-09


DESCHUTES COUNTY
SEC. 24 T17S. R12E. W.M.

SCALE - 1" = 400'




SE 1/4 OF THE SE 1/4

OWRD TRANSFER #: T-10510

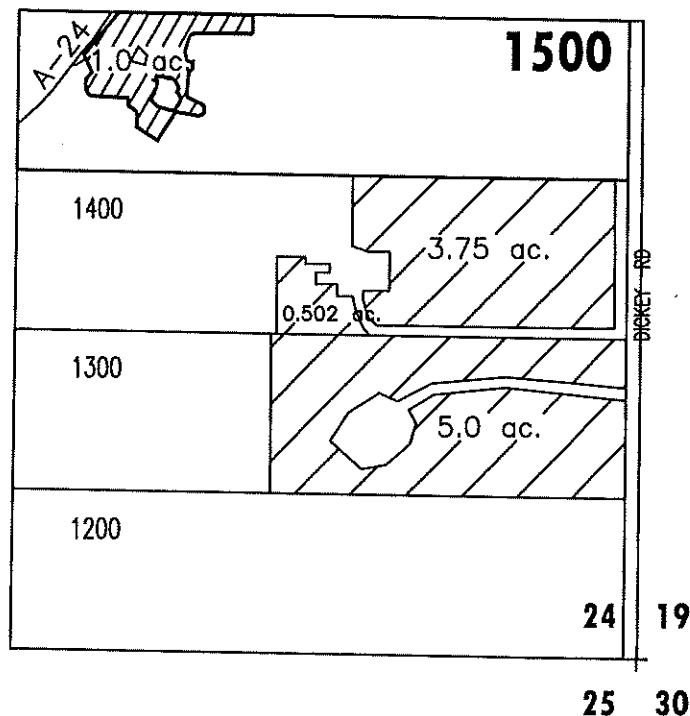

'ON' LANDS

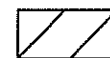

EXISTING WATER RIGHTS

CENTRAL OREGON



IRRIGATION DISTRICT

FINAL PROOF MAP

NAME: ROBERT & ESTHER MONSON

TAXLOT #: 1500

1.0 ACRES

DATE: 09-13-10

FILE NO: E:\TRANSFER\FINALPRF\P2007-006\171224_SESE

FINAL PROOF SITE REPORT

Claim of Beneficial Use

Petition #: P-2007-006

State #: T-10510

Transfer #: T-2007-026

Property Owner (Applicant): Waits, Ronald & Michelle

Current Owner:

Property Description: 17-13-33 SW NW 01106 Acres: 0.15

Property Address: 22233 Cody Rd, Bend

Canal: COC

Head Gate: D-12-0

Type of Use: Irrig

☐ Person interviewed (if any): Michelle

☐ Method of irrigation (pump, flood, etc): pump

☐ Use: crops produced: Grass

☐ Method used to calculate area irrigated: GPS

☐ Is beneficial use achieved in areas mapped: yes

☐ Are there any mapping changes: No

IF NO,

☐ If not proved up, what measures have been completed: _____

☐ Failure to Prove up _____ acres of transferred water right

☐ If not irrigated as mapped, indicate changes on map: _____

☐ What measures are now needed?

Talk with water right user: _____

Follow up in _____ weeks/days

Re-visit site on _____

NOTES:

Inspected by: Stuart Keyte Date: 8-25-09


DESCHUTES COUNTY
SEC.33 T17S. R13E. W.M.

SCALE - 1" = 400'




SW 1/4 OF THE NW 1/4


OWRD TRANSFER #: T-10510

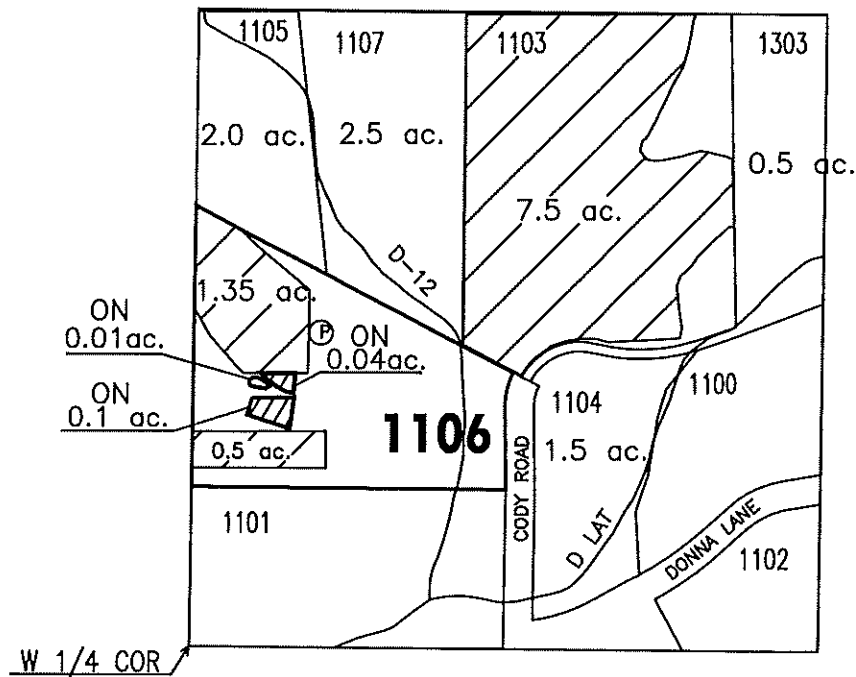

'ON' LANDS

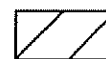

EXISTING WATER RIGHTS

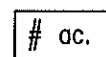

ac. PARCELS W/ WATER RIGHTS

CENTRAL OREGON



IRRIGATION DISTRICT

FINAL PROOF MAP

NAME: RONALD & MICHELLE WAITS

TAXLOT #: 1106

0.15 ACRES

DATE: 07-29-2010

FILE NO: I:\TRANSFER\FINALPRF\P2007-006\171333_SWNW

FINAL PROOF SITE REPORT

Claim of Beneficial Use

Petition #: P-2007-006

State #: T-10510

Transfer #: T-2007-030

Property Owner (Applicant): Bean, Darcy

Canal: COC

Current Owner:

Head Gate: COC-38-6

Property Description: 17-14-15 SE NE 00500 Acres: 0.35

Type of Use: Irrig

Property Address: 63455 Johnson Ranch Rd, Bend

☐ Person interviewed (if any): Darcy

☐ Method of irrigation (pump, flood, etc): Flood

☐ Use: crops produced: Grass

☐ Method used to calculate area irrigated: GPS

☐ Is beneficial use achieved in areas mapped: yes

☐ Are there any mapping changes: No

IF NO,

☐ If not proved up, what measures have been completed: _____

☐ Failure to Prove up _____ acres of transferred water right

☐ If not irrigated as mapped, indicate changes on map: _____

☐ What measures are now needed?

Talk with water right user: _____

Follow up in _____ weeks/days

Re-visit site on _____

NOTES:

Inspected by: Stuart Keys Date: 8-31-09


DESCHUTES COUNTY
SEC.15 T17S. R14E. W.M.

SCALE - 1" = 400'



SE 1/4 OF THE NE 1/4


OWRD TRANSFER #:T-10510

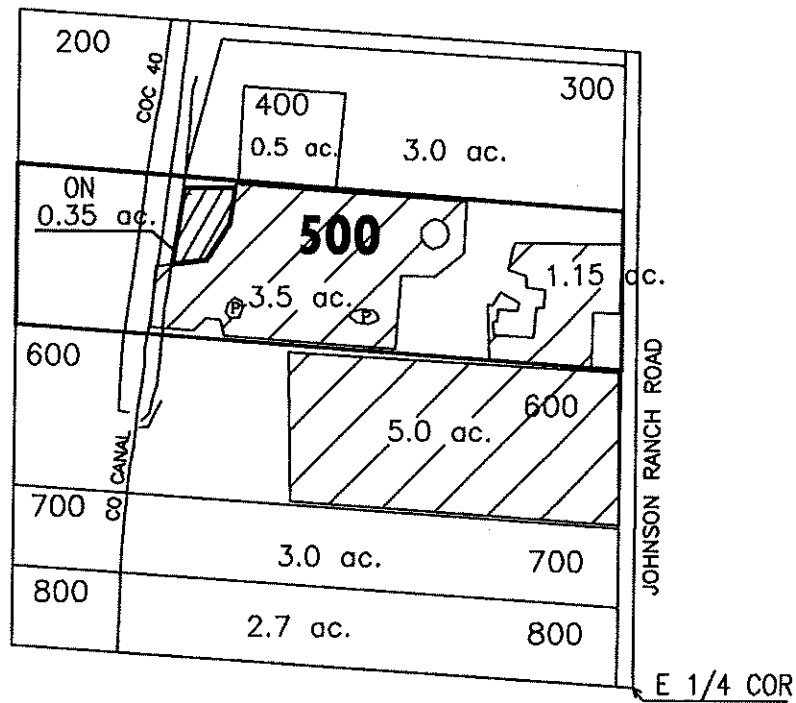

'ON' LANDS



EXISTING WATER RIGHTS

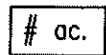

PARCELS W/ WATER RIGHTS

CENTRAL OREGON



IRRIGATION DISTRICT

FINAL PROOF MAP

NAME: DARCY BEAN

TAXLOT #: 500

0.35 ACRES

DATE: 08-02-2010

FILE NO: I:\TRANSFER\FINALPRF\P2007-006\171415_SENE

FINAL PROOF SITE REPORT

Claim of Beneficial Use

Petition #: P-2007-006

State #: T-10510

Transfer #: T-2007-023

Property Owner (Applicant): Tuma, Ben & Shelley

Canal: COC

Current Owner:

Head Gate: C-0-2

Property Description: 18-13-06 NE NE ⁰⁰¹⁰⁰~~00101~~ Acres: 1.40

Type of Use: Irrig

Property Address: 22345 Bear Creek Rd, Bend

☐ Person interviewed (if any): _____

☐ Method of irrigation (pump, flood, etc): pump

☐ Use: crops produced: Grass

☐ Method used to calculate area irrigated: GPS

☐ Is beneficial use achieved in areas mapped: yes

☐ Are there any mapping changes: No - Correction to transfer

IF NO,

☐ If not proved up, what measures have been completed: _____

☐ Failure to Prove up _____ acres of transferred water right

☐ If not irrigated as mapped, indicate changes on map: _____

☐ What measures are now needed?

Talk with water right user: _____

Follow up in _____ weeks/days

Re-visit site on _____

NOTES:

Inspected by: Stuart Kept Date: 8-28-07


**DESCHUTES COUNTY
SEC.06 T18S. R13E. W.M.**

SCALE - 1" = 400'




NE 1/4 OF THE NE 1/4

OWRD TRANSFER #:T-10510

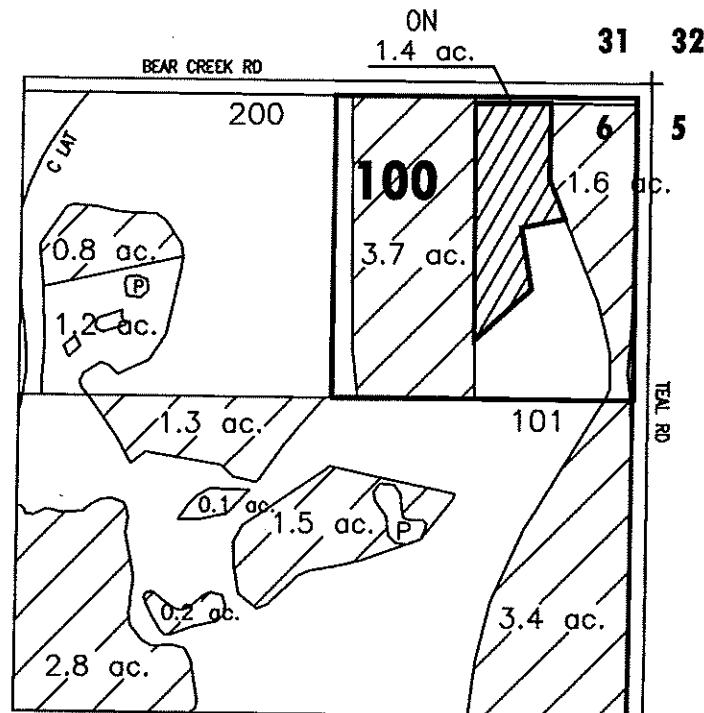

'ON' LANDS

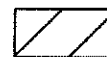

EXISTING WATER RIGHTS

CENTRAL OREGON



IRRIGATION DISTRICT

FINAL PROOF MAP

NAME: BEN & SHELLEY TUMA

TAXLOT #: 100

1.4 ACRES

DATE: 08-02-2010

FILE NO: I:\TRANSFER\FINALPRF\P2007-006\181306_NENE



Oregon

Theodore R. Kulongoski, Governor

Water Resources Department

North Mall Office Building
725 Summer Street NE, Suite A
Salem, OR 97301-1266
503-986-0900
FAX 503-986-0904

January 8, 2008

CENTRAL OREGON IRRIGATION DISTRICT
1055 SW LAKE COURT
REDMOND, OR 97756

Reference: Transfer 10510

On December 24, 2007 we received your water right transfer application requesting place of use. The application was accompanied by \$600.00. Our receipt 91037 is enclosed.

By copy of this letter, we are asking the Watermaster for a report regarding the potential for injury to existing water rights which may be caused by the change.

Your application will be examined to determine if additional information is needed. You will be contacted following this examination.

Except as provided under ORS 540.510(3) for municipalities, you may not use water for the new use, in the new place of use or from the new point of diversion until the transfer application has been approved. In order to avoid any possible forfeiture of the water right, you should continue to use the water as described by your existing water right. If the land is sold before the transfer is approved, the buyer's consent to the transfer will be required unless a recorded deed or other legal document clearly established that the water right was not conveyed in the sale.

We will notify you if additional information or corrections to the application or map are required.

If you have any questions, please call the Transfer Section, (503)986-0883.

cc: Watermaster # 11
Jefferson County
Deschutes County
Receiving Landowners

enclosure



Oregon

Theodore R. Kulongoski, Governor

Water Resources Department

725 Summer Street NE, Suite A

Salem, OR 97301-1271

503-986-0900

FAX 503-986-0904

Notice of Application for Water Right Transfer, Temporary Transfer, or Permit Amendment 01/08/2008

The Department seeks comment on the recently-filed application listed below. Any person may comment on the application. Comments must be received by the Department within 30 days of the date of this notice. The Director may presume that the transfer would be allowed by, and compatible with comprehensive plans unless an affected local government informs the Director otherwise within 30 days of this notice.

County: DESCHUTES
Transfer: 10510
Water Right: CERT 83571, 76358, 76714
Priority Date: 1900, 1907
Name: CENTRAL OREGON IRRIGATION DISTRICT
Address: 1055 SW LAKE CT REDMOND OR 97756
Change: POU
Source: DESCHUTES RIVER/CRANE PRAIRIE RESERVOIR
Authorized POU: T18S R13E 6
T18S R12E 4
T17S R14E 15, 22, 23
T17S R13E 33
T16S R14E 8, 16
T16S R12E 1
Proposed POU: T18S R13E 6
T17S R14E 15
T17S R13E 33
T17S R12E 24
T16S R14E 8, 17
T16S R12E 1
T15S R14E 35

The holder of a water right may apply to permanently change an existing water use subject to transfer. A transfer application may involve any of the following changes: Point of diversion or appropriation (POD; POA); Additional point of diversion or appropriation (APOD; APOA); Historic POD (HIST); Place of use (POU); Character of use (USE); Instream (ISWR); Substitution (SUB); or Exchange (EXCH).

The holder of a water right subject to transfer may request to temporarily change the place of use of the water for up to 5 years and, if necessary to convey the water, to temporarily change the point of diversion or appropriation.

The holder of a water right permit may apply to change a point of diversion (POD) or appropriation (POA) or to change the place of use (POU).

Any person who provides comments within the comment period will receive a copy of the Department's preliminary determination of whether the application should be approved or rejected after the Department has completed a review of the application and will be provided an opportunity to protest the application and preliminary determination at that time. Comments should be sent to the Transfers Section at the Department's Salem office.

State of Oregon
WATER RESOURCES DEPARTMENT
DISTRICT PETITION FOR PERMANENT TRANSFER
(ORS 540.580)
PETITION YEAR AND NUMBER P-2007-006

DISTRICT CENTRAL OREGON IRRIGATION DISTRICT

ADDRESS 1055 SW Lake Ct.

REDMOND, OR 97756 PHONE 541-548-6047 (fax 541-548-0243)

1. WATER RIGHT

1958 Deschutes Consolidated Decree- Deschutes River
Certificate # 76358 & 76714 – Rate: 1 cfs = 32.40 acres
Priority date: October 31, 1900 and December 2, 1907
Source: Deschutes River & Crane Prairie Reservoir

2. TYPE OF CHANGE: PERMANENT CHANGE IN PLACE OF USE

3. LOCATION OF AUTHORIZED PLACE OF USE: (PRESENT USER)

No	Name	Legal Description Township South, Range East, W.M.	Tax Lot #	Acres	Use	District Notice #
		SEE EXHIBIT "A"				
		Total "OFF" acres		7.36		

4. LOCATION OF PROPOSED PLACE OF USE: (PROPOSED USER)

No	Name	Legal Description Township South, Range East, W.M.	Tax Lot #	Acres	Use	District Notice #
		SEE EXHIBIT "B"				
		Total "ON" acres		7.36		

5 ITEMS ATTACHED:

1. MAPS REPRESENTING "OFF" LANDS AND PROPOSED "ON" LANDS.


2. DISTRICT BOUNDARIES

Description & map already on file with OWRD's office in Salem and Bend.

3. FEES: \$ 600 IS ATTACHED TO THIS PETITION FOR FILING AND RECORDING

A notarized statement from all landowners affected in this petition is on file in the District's office authorizing the changes.

The District (PETITIONER) hereby certifies that the maps and petition are accurate to the best of our knowledge and that the water rights referenced in this application have either been used within the last 2 years, or are not subject to forfeiture.

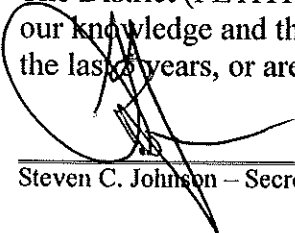
Steven C. Johnson – Secretary Manager

Date 18 Dec. 2007

RECEIVED

24 2007

T 10510

WATER RESOURCES DEP
SALEM, OREGON

TABLE 1. - AUTHORIZED PLACE OF USE

Cert/Decree	Cert/Perm										
PRIMARY	SUPP	TRANSFER NBR	POD	USE	TWP	RNG	SEC	QQ	LOT	ACRES	USER NAME
76358	76714	T-2007-023	#1	JRRIG	18	13	06	NENE	00100	1.400	Tuma, Ben/Shelley
83571	76714	T-2007-026	#1	IRRIG	17	13	33	SWNW	01106	0.150	Waits, Ronald/Michelle
83571	76714	T-2007-027	#11	IRRIG	16	12	01	NESE	00200	0.010	Wallace, Mary Sue
83571	76714	T-2007-027	#11	IRRIG	16	12	01	SENE	00200	0.250	Wallace, Mary Sue
83571	76714	T-2007-028	#1	IRRIG	16	14	16	NWSW	00201	2.600	Bovee, Alan/Margaret
83571		T-2007-029	#1	IRRIG	17	14	23	SWSE	01200	0.500	COID/Quitclaim
83571		T-2007-029	#1	IRRIG	17	14	22	NESE	00801	0.200	COID/Quitclaim
83571	76714	T-2007-029	#1	IRRIG	18	12	04	SESW	00600	0.300	COID/Quitclaim
83571	76714	T-2007-030	#1	IRRIG	17	14	15	SENE	00500	0.350	Bean, Darcy
83571	76714	T-2007-034	#1	IRRIG	16	14	08	SESE	00101	1.200	Schinkel Family Revocable Living Trust
83571	76714	T-2007-034	#1	IRRIG	16	14	08	SESE	00101	0.400	Schinkel Family Revocable Living Trust

T 10510

RECEIVED
 DEC 24 2007
 WATER RESOURCES DEPT
 SALEM, OREGON

TABLE 2. - PROPOSED PLACE OF USE

Cert/Decree PRIMARY	Cert/Perm SUPP	TRANSFER NBR	POD	USE	TWP	RNG	SEC	QQ	LOT	ACRES	USER NAME
76358	76714	T-2007-023	#1	IRRIG	18	13	06	NENE	00101	1.400	Tuma, Ben/Shelley
83571	76714	T-2007-026	#1	IRRIG	17	13	33	SWNW	01106	0.150	Waits, Ronald/Michelle
83571	76714	T-2007-027	#11	IRRIG	16	12	01	SENE	00200	0.010	Wallace, Mary Sue
83571	76714	T-2007-027	#11	IRRIG	16	12	01	SENE	00200	0.250	Wallace, Mary Sue
83571		T-2007-028	#1	IRRIG	15	14	35	NWSW	00400	2.600	Powell Butte Farmers Club, Inc
83571		T-2007-029	#1	IRRIG	17	12	24	SESE	01500	0.500	Monson, Robert/Esther
83571		T-2007-029	#1	IRRIG	17	12	24	SESE	01500	0.200	Monson, Robert/Esther
83571		T-2007-029	#1	IRRIG	17	12	24	SESE	01500	0.300	Monson, Robert/Esther
83571	76714	T-2007-030	#1	IRRIG	17	14	15	SENE	00500	0.350	Bean, Darcy
83571	76714	T-2007-034	#1	IRRIG	16	14	08	SESE	00101	1.200	Schinkel Family Revocable Living Trust
83571	76714	T-2007-034	#1	IRRIG	16	14	17	NENE	00100	0.400	Schinkel Family Revocable Living Trust

T 10510

RECEIVED
DEC 24 2007
WATER RESOURCES DEPT
SALEM, OREGON

12/18/07


DESCHUTES COUNTY SEC.01 T16S R12E

SCALE - 1" = 400'



SE 1/4 OF THE NE 1/4; NE 1/4 OF THE SE 1/4

DISTRICT INTERNAL
NOTICE #: T-2007-027

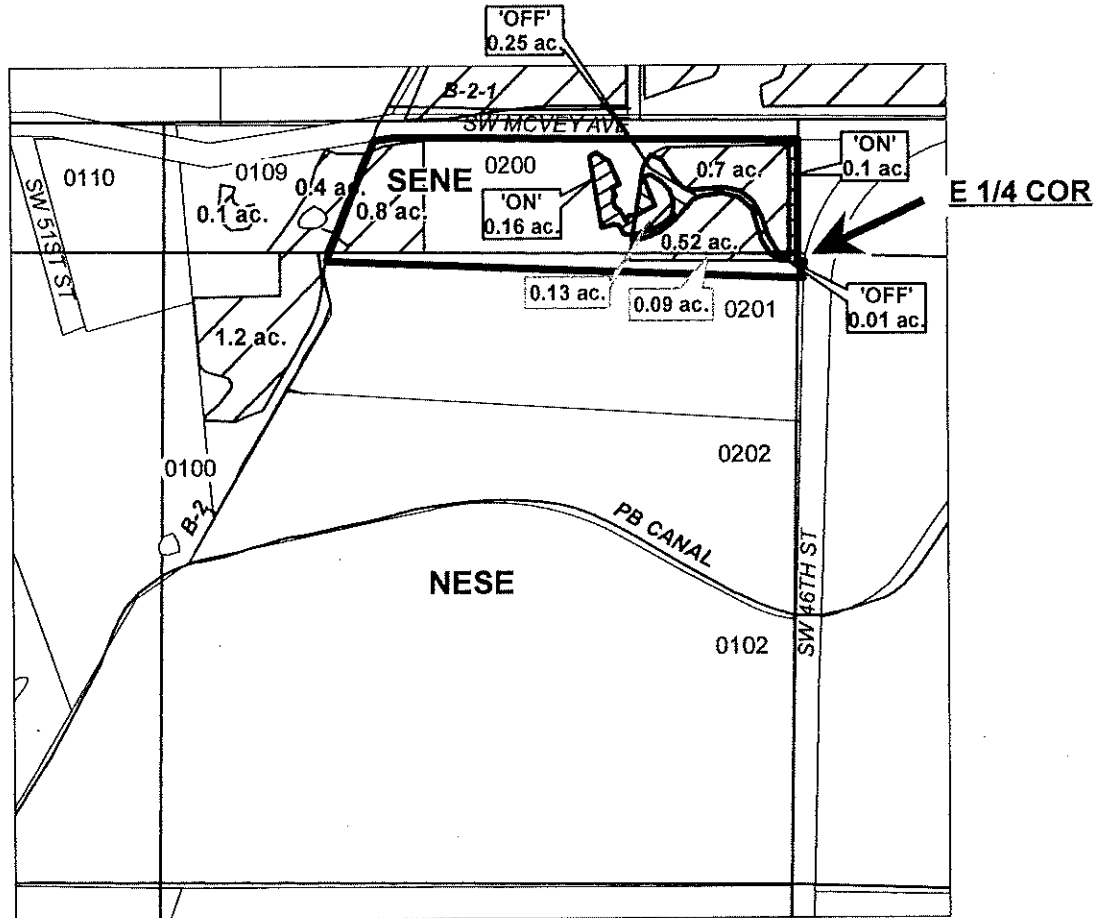

RECEIVED

DEC 24 2007

WATER RESOURCES DEPT
SALEM, OREGON

"OFF" / "ON" MAP

APPLICATION FOR WATER RIGHTS TRANSFER
MARGARET J. WALLACE,
TRUSTEE OF THE W.F. WALLACE MARTIAL Q-TIP TRUST

TAXLOT #: 200 T 10510

0.26 ACRES

DATE: 09-26-07

FILE: E:\TRANSFER\WRTRANS07\WALLACE.PDF




CROOK COUNTY
SEC.08 & 17 T16S R14E

SCALE - 1" = 400'




SE 1/4 OF THE SE 1/4; NE 1/4 OF THE NE 1/4

DISTRICT INTERNAL
NOTICE #: T-2007-034

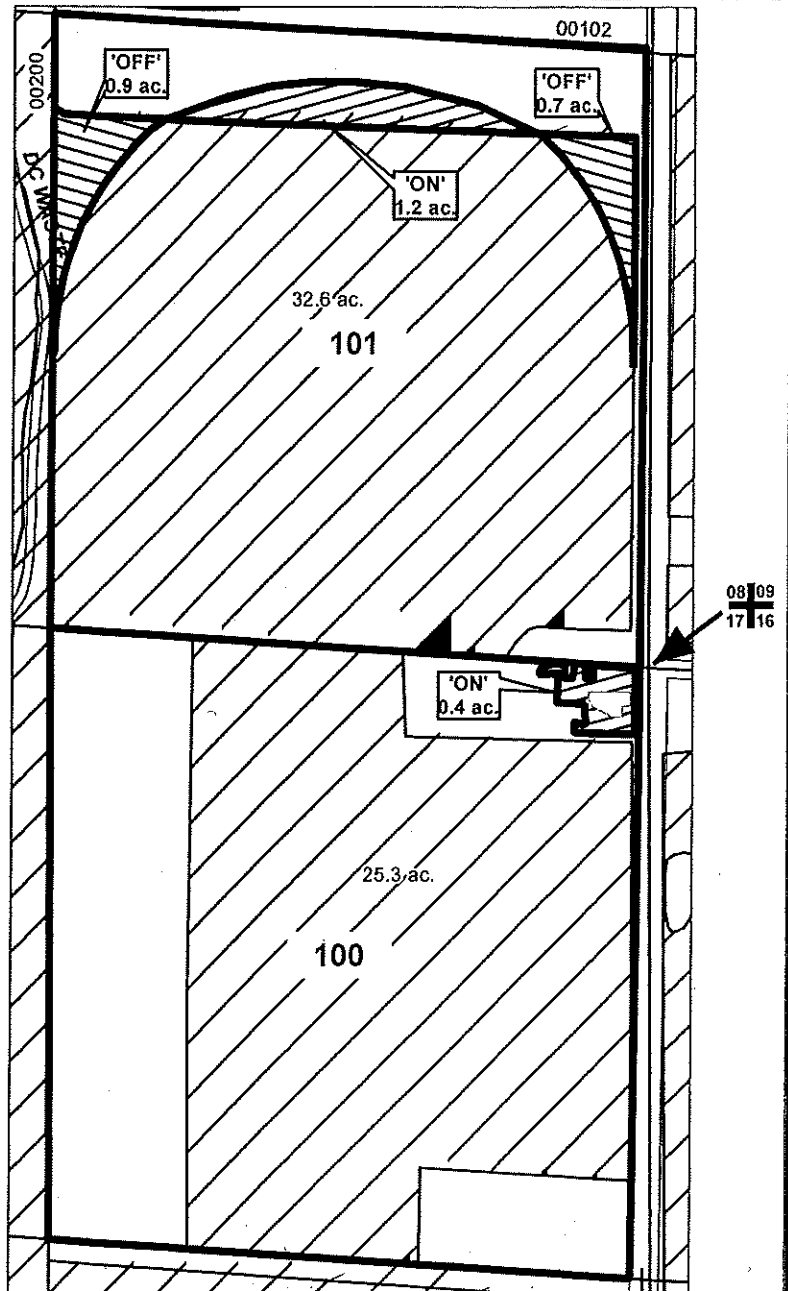

"OFF / ON" MAP

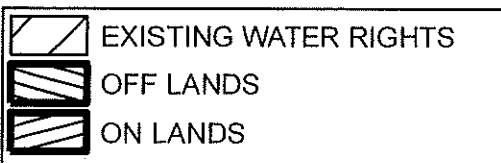

APPLICATION FOR WATER RIGHTS TRANSFER
SCHINKEL FAMILY REVOCABLE TRUST

TAXLOT #:101 & 100

DATE: 11-28-07

T 10510

1.5 ACRES

FILE: E:\TRANSFER\WTR\TRANS07SCHINKEL

RECEIVED

DEC 24 2007

WATER RESOURCES DEP
SALEM, OREGON


**CROOK COUNTY
SEC.16 T16S R14E**

SCALE - 1" = 400'



NW 1/4 OF THE SW 1/4

DISTRICT INTERNAL
NOTICE #: T-2007-028

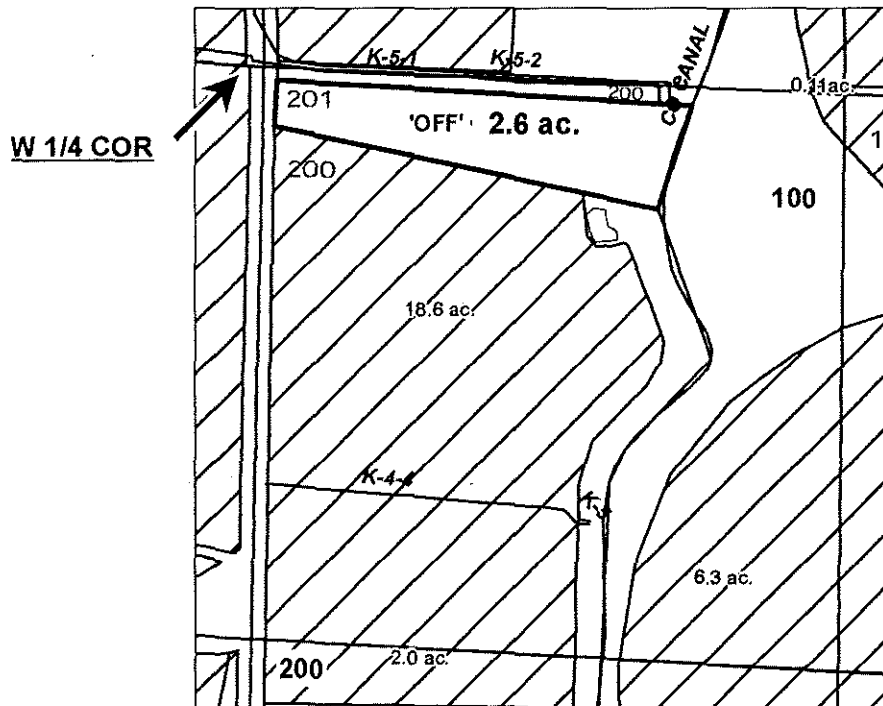

"OFF" MAP

# ac.	'OFF' LAND PARCELS
	EXISTING WATER RIGHTS



APPLICATION FOR WATER RIGHTS TRANSFER
ALAN F. & MARGARET M. BOVEE / POWELL BUTTE FARMERS CLUB

TAXLOT #: 201

RECEIVED

2.6 ACRES

DATE: 10-02-07

DEC 24 2007

FILE: E:\TRANSFER\WR\TRANS07\BOVEE.PDF

WATER RESOURCES DEPT
SALEM, OREGON

T 10510


DESCHUTES COUNTY SEC.33 T17S R13E

SCALE - 1" = 400'



SW 1/4 OF THE NW 1/4

DISTRICT INTERNAL
NOTICE # T-2007-026

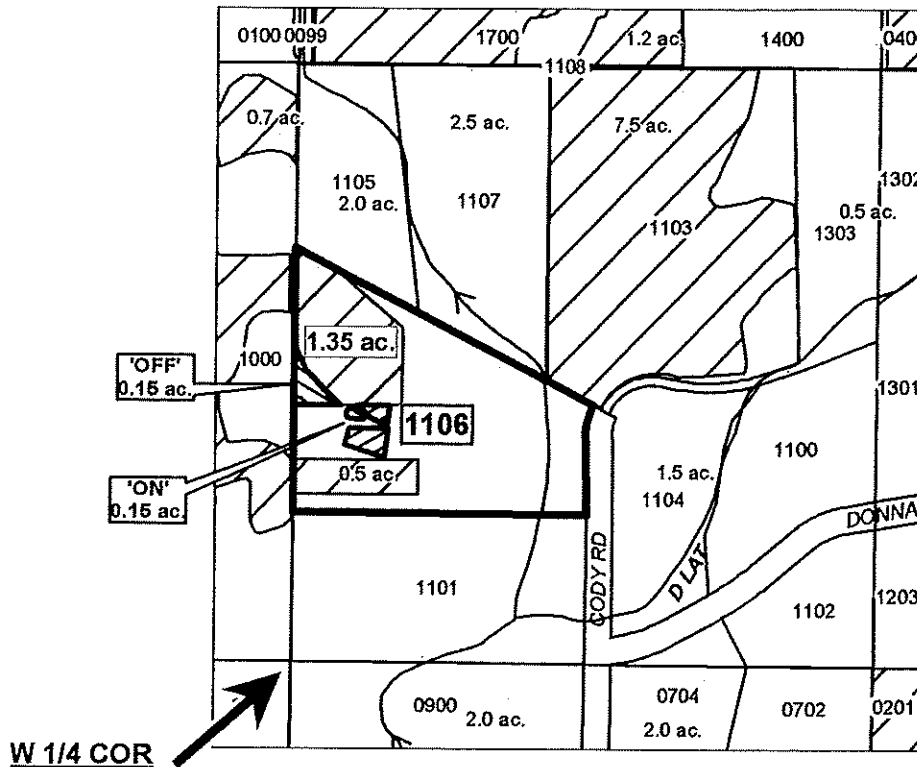

"OFF/ON" MAP

	EXISTING WATER RIGHTS
	OFF LANDS
	ON LANDS
	PARCELS W/ WATER RIGHTS



APPLICATION FOR WATER RIGHTS TRANSFER

RONALD L. & MICHELLE A. WAITS / RONALD L. & MICHELLE A. WAITS

TAXLOT #: 1106

DATE: 09-25-07

RECEIVED

0.15 ACRES

FILE: E:\TRANSFER\WR\TRANS07\WAITS.PDF

DEC 24 2007

WATER RESOURCES DEPT
SALEM, OREGON

T 10510

WATER RESOURCES DEPT T 10510
SALEM, OREGON


DESCHUTES COUNTY
SEC.22 T17S R14E

SCALE - 1" = 400'



NE 1/4 OF THE SE 1/4


DISTRICT INTERNAL
NOTICE #: T-2007-029

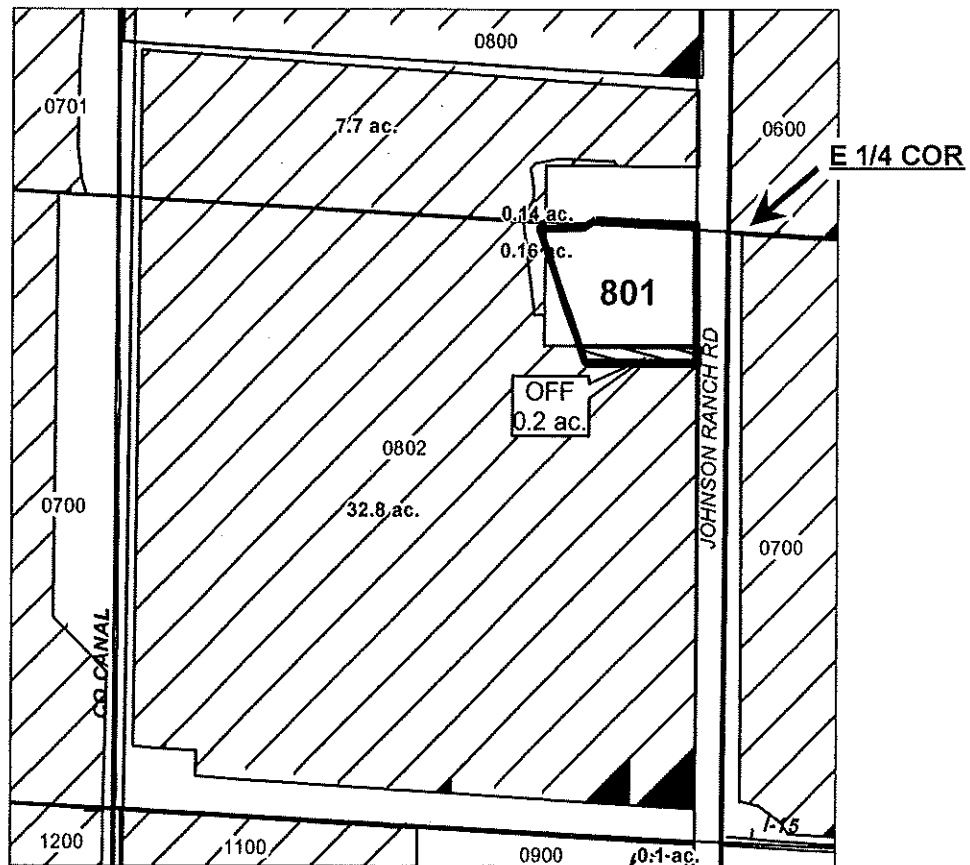

RECEIVED

DEC 24 2007

WATER RESOURCES DEPT
SALEM, OREGON

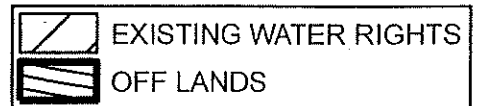

OFF MAP

CENTRAL OREGON



IRRIGATION DISTRICT

APPLICATION FOR WATER RIGHTS TRANSFER

COID / ROBERT W. & ESTHER A. MONSON

TAXLOT #: 801

0.2 ACRES

DATE: 10-16-07

FILE: E:\TRANSFER\WRTRANS07\COID_171422_801

T 10510


DESCHUTES COUNTY
SEC.23 T17S R14E

SCALE - 1" = 400'



SW 1/4 OF THE SE 1/4

DISTRICT INTERNAL
NOTICE #: T-2007-029

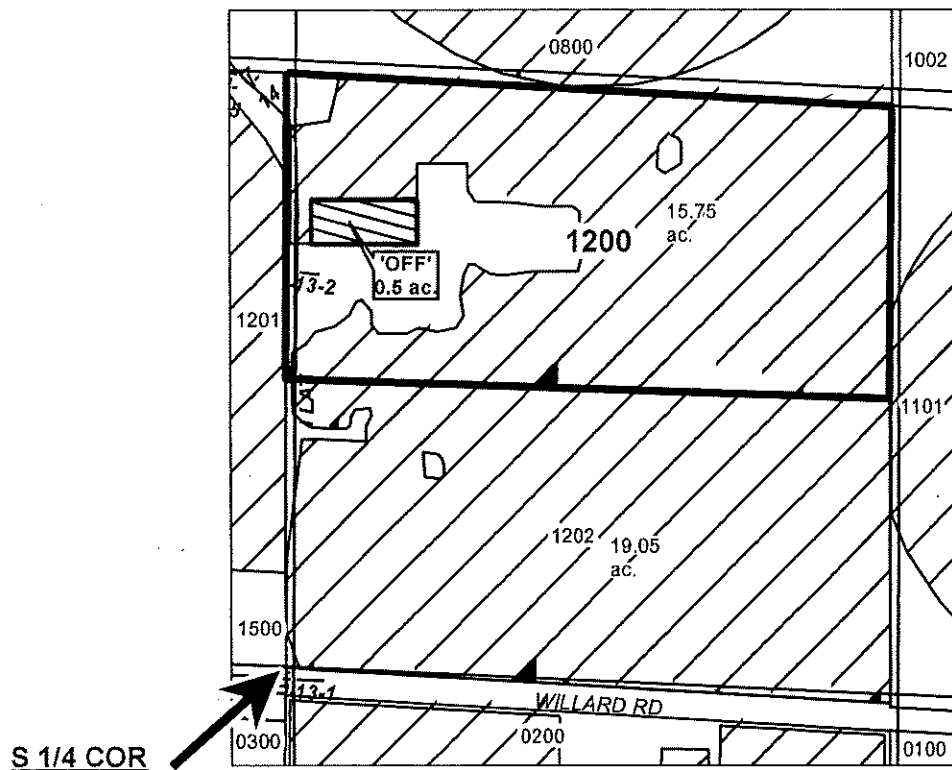

RECEIVED

DEC 24 2007

WATER RESOURCES DEPT
SALEM, OREGON

"OFF" MAP



APPLICATION FOR WATER RIGHTS TRANSFER

COID / ROBERT W. & ESTHER A. MONSON

TAXLOT #: 1200

0.5 ACRES

DATE: 10-16-07

FILE: E:\TRANSFER\WR\TRANS07\COID_171423_1200

T 10510


DESCHUTES COUNTY SEC.04 T18S R12E

SCALE - 1" = 400'



SE 1/4 OF THE SW 1/4

DISTRICT INTERNAL
NOTICE #: T-2007-029

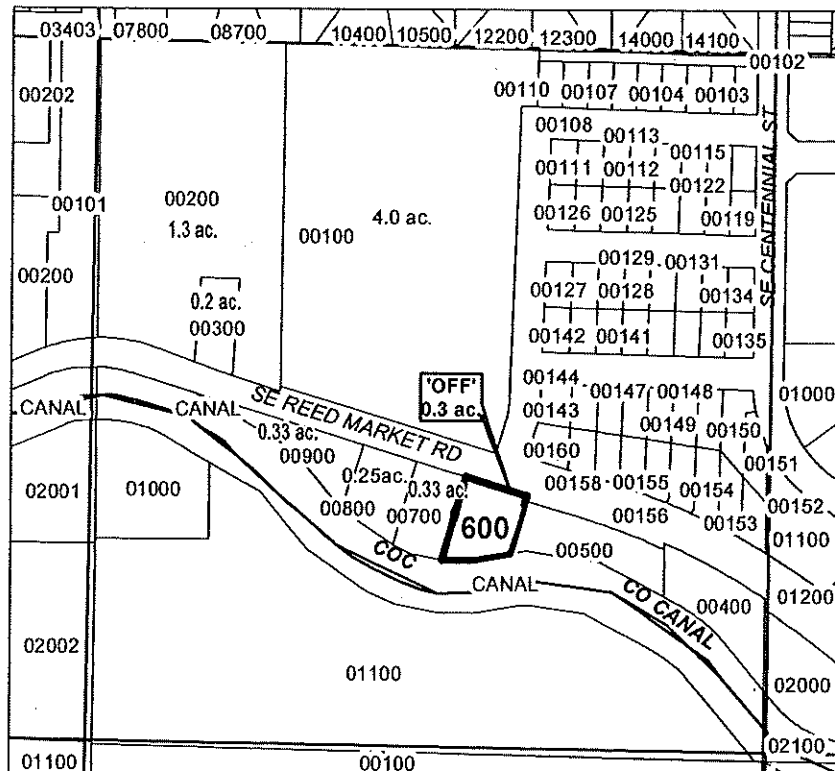


S 1/4 COR

RECEIVED

DEC 24 2007

WATER RESOURCES DEPT
SALEM OREGON

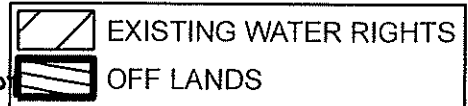

"OFF" MAP



APPLICATION FOR WATER RIGHTS TRANSFER

COID / ROBERT W. & ESTHER A. MONSON

TAXLOT #: 600

T 10510

0.3 ACRES

DATE: 10-16-07

FILE: E:\TRANSFER\WTRTRANS07\COID_181204_600


DESCHUTES COUNTY SEC.06 T18S R13E

SCALE - 1" = 400'



NE 1/4 OF THE NE 1/4

DISTRICT INTERNAL
NOTICE #: T-2007-023

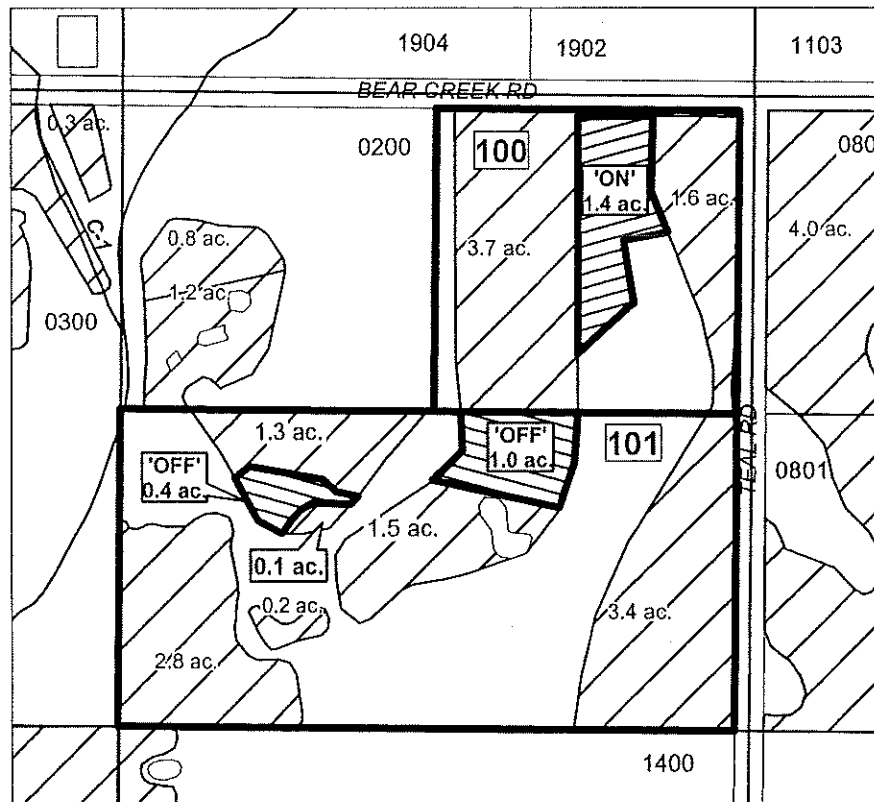

RECEIVED

DEC 24 2007

WATER RESOURCES DEPT
SALEM, OREGON

	EXISTING WATER RIGHTS
	OFF LANDS
	ON LANDS

"OFF" / "ON" MAP



APPLICATION FOR WATER RIGHTS TRANSFER

BEN F. & SHELLEY L. TUMA/ BEN F. & SHELLEY L. TUMA

TAXLOT #: 100, 101
T 10510

1.4 ACRES

DATE: 08-02-07

FILE: E:\TRANSFER\WRTRANS07\TUMA.PDF


**CROOK COUNTY
SEC.35 T15S R14E**

SCALE - 1" = 400'



NW 1/4 OF THE SW 1/4

DISTRICT INTERNAL
NOTICE #: T-2007-028

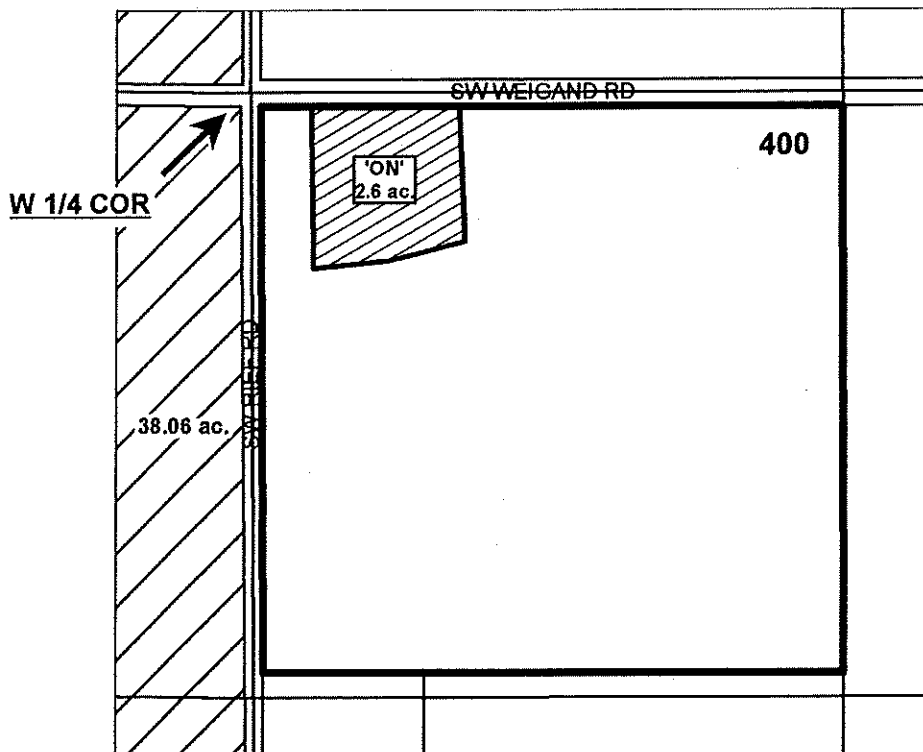


RECEIVED

DEC 24 2007

WATER RESOURCES DEPT
SALEM, OREGON

"ON" MAP

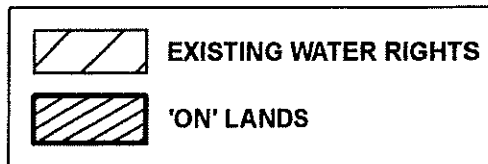

APPLICATION FOR WATER RIGHTS TRANSFER

ALAN F. & MARGARET M. BOVEE / POWELL BUTTE FARMERS CLUB

TAXLOT #: 400

2.6 ACRES

DATE: 10-02-07

FILE: E:\TRANSFER\WR\TRANS07\PB_FARMERS.PDF

T 10510


DESCHUTES COUNTY SEC.01 T16S R12E

SCALE - 1" = 400'



SE 1/4 OF THE NE 1/4; NE 1/4 OF THE SE 1/4

DISTRICT INTERNAL
NOTICE #: T-2007-027

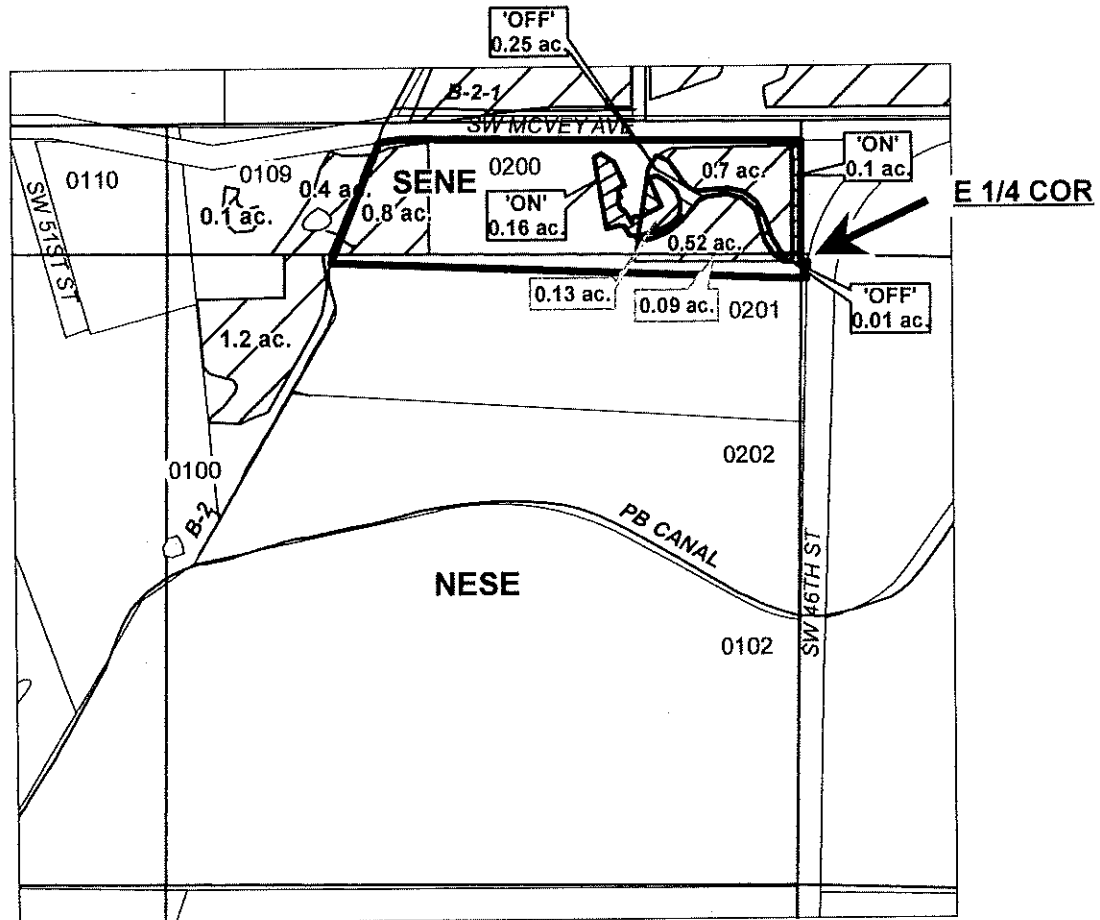

RECEIVED

DEC 24 2007

WATER RESOURCES DEPT
SALEM, OREGON

"OFF" / "ON" MAP

APPLICATION FOR WATER RIGHTS TRANSFER
MARGARET J. WALLACE,
TRUSTEE OF THE W.F. WALLACE MARTIAL Q-TIP TRUST

TAXLOT #: 200

T 10510

0.26 ACRES

DATE: 09-26-07

FILE: E:\TRANSFER\WRTRANS07\WALLACE.PDF




CROOK COUNTY SEC.08 & 17 T16S R14E

SCALE - 1" = 400'



SE 1/4 OF THE SE 1/4; NE 1/4 OF THE NE 1/4

DISTRICT INTERNAL
NOTICE #: T-2007-034

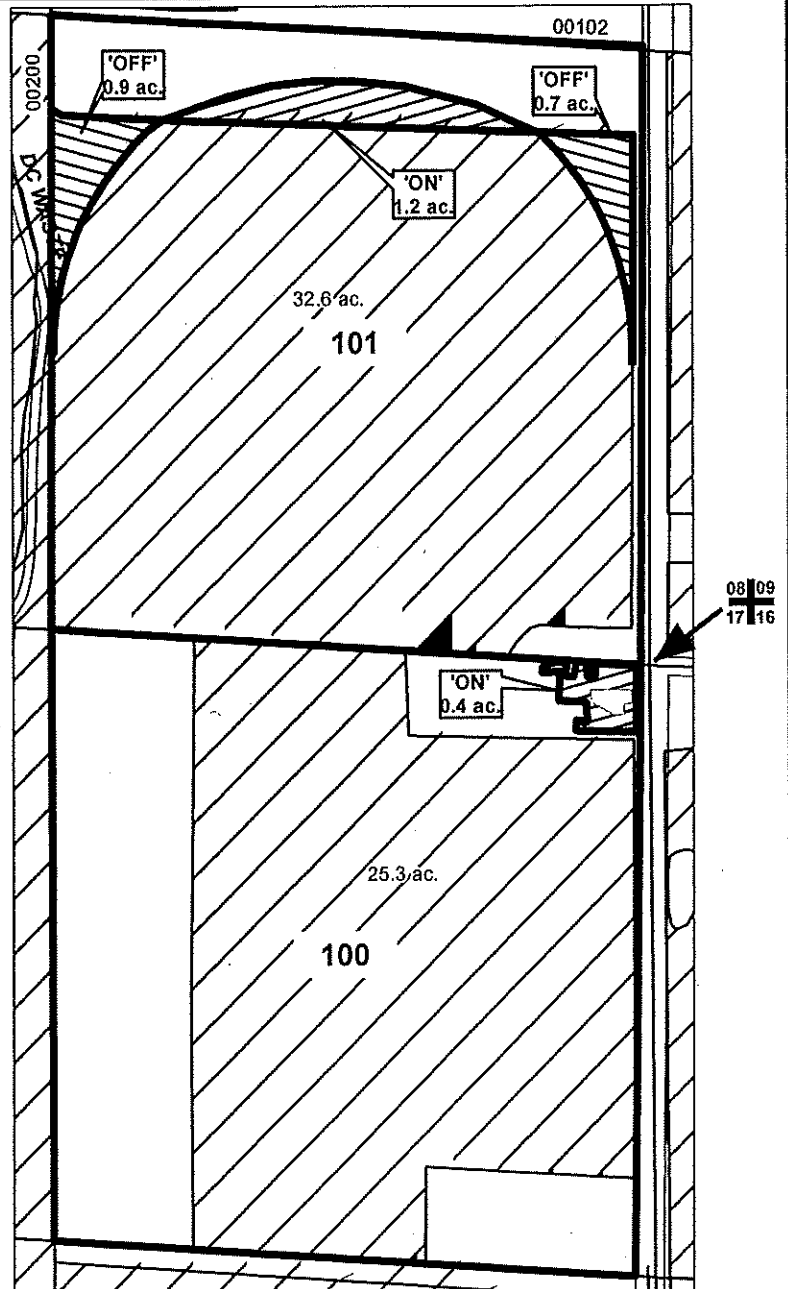

"OFF / ON" MAP

	EXISTING WATER RIGHTS
	OFF LANDS
	ON LANDS

CENTRAL OREGON



IRRIGATION DISTRICT

APPLICATION FOR WATER RIGHTS TRANSFER
SCHINKEL FAMILY REVOCABLE TRUST

TAXLOT #:101 & 100

DATE: 11-28-07

T 10510

1.5 ACRES
WATER RESOURCES DEPT
SALEM, OREGON

FILE: E:\TRANSFER\WR\TRANS07\SCHINKEL

RECEIVED

DEC 24 2007


DESCHUTES COUNTY SEC.24 T17S R12E

SCALE - 1" = 400'




SE 1/4 OF THE SE 1/4

DISTRICT INTERNAL
NOTICE #: T-2007-029

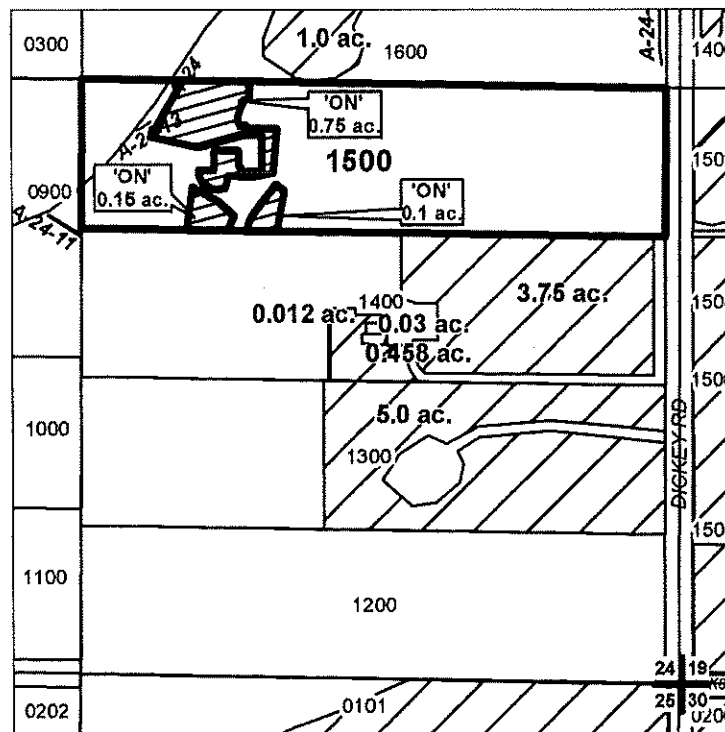

"ON" MAP

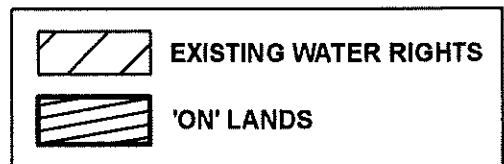

CENTRAL OREGON



IRRIGATION DISTRICT

APPLICATION FOR WATER RIGHTS TRANSFER

COID / ROBERT W. & ESTHER A. MONSON

TAXLOT #: 1500

1.0 ACRES

DATE: 12-13-07

FILE: E:\TRANSFER\WRTRANS07\

RECEIVED

DEC 24 2007

WATER RESOURCES DEPT
SALEM, OREGON

T 10510

WATER RESOURCES DEPT
SALEM, OREGON


DESCHUTES COUNTY SEC.15 T17S R14E

SCALE - 1" = 400'



SE 1/4 OF THE NE 1/4

DISTRICT INTERNAL
NOTICE #: T-2007-030

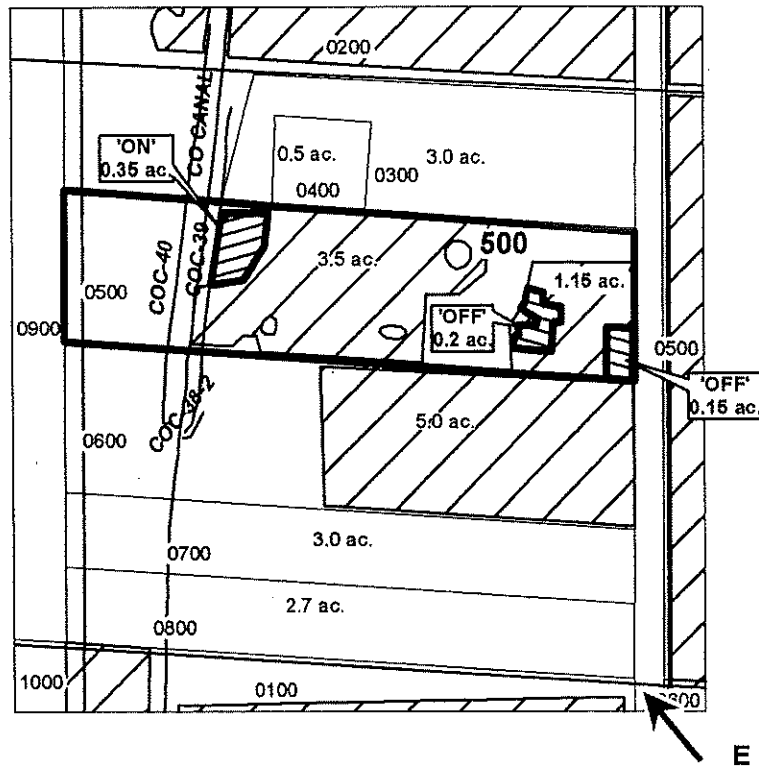

"OFF / ON" MAP

	EXISTING WATER RIGHTS
	OFF LANDS
	ON LANDS
	PARCELS W/ WATER RIGHTS



APPLICATION FOR WATER RIGHTS TRANSFER

DARCY BEAN & JAMES HOLLANDER / DARCY BEAN & JAMES HOLLANDER

TAXLOT #: 500

0.35 ACRES

DATE: 11-05-07

FILE: E:\TRANSFER\WR\TRANS07\HOLLANDER

RECEIVED

DEC 24 2007

T 10510

WATER RESOURCES DEPT
SALEM, OREGON


DESCHUTES COUNTY SEC.06 T18S R13E

SCALE - 1" = 400'




NE 1/4 OF THE NE 1/4

DISTRICT INTERNAL
NOTICE #: T-2007-023

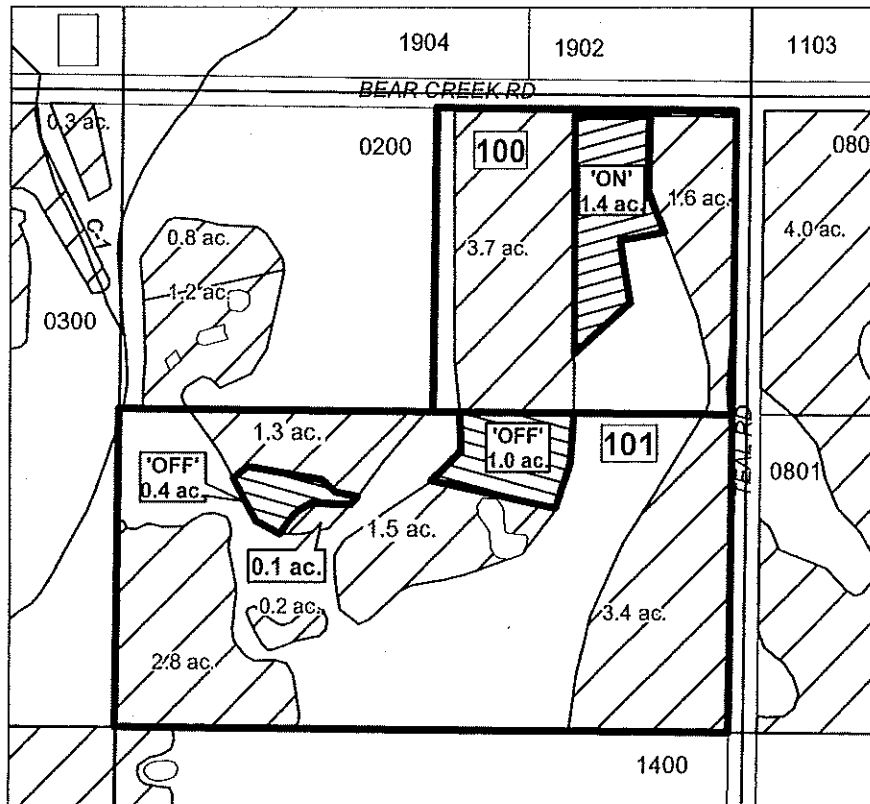

"OFF" / "ON" MAP

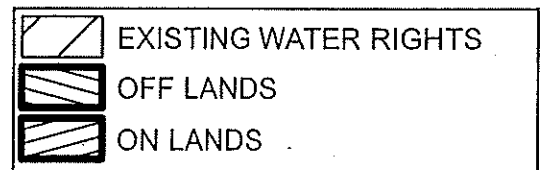

APPLICATION FOR WATER RIGHTS TRANSFER

BEN F. & SHELLEY L. TUMA/ BEN F. & SHELLEY L. TUMA

TAXLOT #: 100, 101

1.4 ACRES

T 10510

DATE: 08-02-07

RECEIVED
DEC 24 2007
WATER RESOURCES DE
SALEM, OREGON

FILE: EATRANSFER\WRTRANS07\TUMA.BEN

L-385 L-387 L-389 L-391 L-393 L-395 L-397 L-399 L-401 L-403
L-396 L-398 L-400 L-402 L-404 L-406

T-8692 spo. v. 55p 941 v. 56p 2014

T-8693 spo. v. 55p 617 v. 56p 999 v. 57p 01203

T-8982 v. 56p 124

T-8983 v. 56p 127

T-8984 v. 56p 130

T-8985 v. 56p 133

T-9214 a pou/pod v. 57p 1490 (withdrawn)

THIS CERTIFICATE ISSUED TO

T-9163 v. 64p 43

T-9814 v. 63p 521

CENTRAL OREGON IRRIGATION DISTRICT

2598 N HIGHWAY 97

REDMOND, OREGON 97756

COUNTY OF DESCHUTES

CERTIFICATE OF WATER RIGHT

T-9555 WITHDRAWN

T-9553

T-9557

T-9558

T-9597

T-9605

T-9603

T-9608

T-9604

T-9299 AUSE/POU

T-9313 APOU

T-9314 v. 58p 115

T-9315

(div 15) T-9343 AUSE/POU

T-9500

T-9499

T-9423 WITHDRAWN

T-9424 WITHDRAWN

T-9439

T-9440

T-9441

T-9463

T-9462

T-9150

T-9156 v. 56p 1033

T-9195 v. 56p 2051

T-9276

T-9516

T-9769

T-9784

T-9785

T-9816

T-9817

confirms the right to use the waters of THE DESCHUTES RIVER, a tributary of THE COLUMBIA RIVER, for IRRIGATION OF ACRES 43,746.93 ACRES, 781.957 ACRES/EQUIVALENT FOR MUNICIPAL USE, 158.01 ACRES/EQUIVALENT FOR POND MAINTENANCE, 87.10 ACRES/EQUIVALENT FOR INDUSTRIAL USE, 7.0 ACRES/EQUIVALENT FOR QUASI-MUNICIPAL USE, 2.80 ACRES/EQUIVALENT FOR DUST ABATEMENT, STOCK WATER, AND DOMESTIC USE.

This right was confirmed by decree of the Circuit Court of the State of Oregon for DESCHUTES County. The decree is of record at Salem, in the Order Record of the WATER RESOURCES DIRECTOR, in Volume 12, at Page 282 and in Volume 16, at pages 1 and 390. The dates of priority are OCTOBER 31, 1900 FOR 985.0 CUBIC FEET PER SECOND, AND DECEMBER 2, 1907 FOR THE BALANCE ALLOWED BY DECREE.

The amount of water used for irrigation, together with the amount secured under any other right existing for the same lands, is limited to a diversion of not to exceed the quantity determined by decree of the Circuit Court for Deschutes County, dated March 24, 1933, being:

April 1 to May 1 and Oct. 1 to Nov. 1
May 1 to May 15 and Sept. 15 to Oct. 1
May 15 to Sept. 15

1 cfs to 80.0 acres
1 cfs to 60.0 acres
1 cfs to 32.4 acres

for each acre irrigated by the Central Oregon Irrigation District main canal systems during the irrigation season of each year, not to exceed 9.91 acre-feet for each acre irrigated during the irrigation season as measured at the diversion from the source. The quantities reflect a 45% transmission loss as determined by decree of the Circuit Court for Deschutes County, dated March 24, 1933. Those lands not served from the district main canal systems but by direct pumping from the Deschutes River will not be allowed the 45% transmission loss.

The points of diversion are located as follows:

L-637

L-370

L-371

L-372

L-373

L-374

L-375

L-376

L-377

L-378

L-379

L-381

L-382

L-383

L-384

L-385

L-386

L-387

L-388

L-389

L-390

L-391

L-392

L-393

L-394

L-395

1. Central Oregon Canal: SW 1/4 NE 1/4, Section 13, T. 18 S., R. 11 E., W.M.; 1520 feet south and 1535 feet west from the NE Corner of Section 13.

2. Smith Properties, Inc.: Lot 4 (NW 1/4 NW 1/4), Section 5, T. 18 S., R. 12 E., W.M.; 440 feet south and 970 feet east from the NW Corner of Section 5.

3. Columbia Park: SE 1/4 SE 1/4, Section 31, T. 17 S., R. 12 E., W.M.; 740 feet north and 490 feet west from the SE Corner of Section 31.

4. Drake Park South: NE 1/4 SE 1/4, Section 31, T. 17 S., R. 12 E., W.M.; 700 feet north and 120 feet west from the SE Corner of NE 1/4 SE 1/4, Section 31.

5. Drake Park North: SW 1/4 NW 1/4, Section 32, T. 17 S., R. 12 E., W.M.; 2150 feet south and 750 feet east from the NW Corner of Section 32.

6. Harmon Park: SW 1/4 NW 1/4, Section 32, T. 17 S., R. 12 E., W.M.; 700 feet south and 680 feet west from the NE Corner of SW 1/4 NW 1/4, Section 32.

T-9534 v. 55p 1365 ext. of time v. 61p 525

HB3111.bwb

L-389

L-390

L-391

L-392

L-393

L-394

L-395

v. 54p 566 v. 54p 560

T-8532 T-8514















T-9055, 9056, 9040

T-9027

T-8486

T-8485







AMENDED by special order

L-380 Instream Lease #187 5/2/2001-10/31/2002

L-368 Instream Lease #234 9-19-01/9-30-01

v. 55 pg. 167

7. Pioneer Park (South): NW¼ NE¼, Section 32, T. 17 S., R. 12 E., W.M.; 600 feet south and 450 feet west from the NE Corner of the NW¼ NE¼ of Section 32.
8. Pioneer Park (North): NW¼ NE¼, Section 32, T. 17 S., R. 12 E., W.M.; 560 feet west from the NE Corner of the NW¼ NE¼ of Section 32.
9. T.I.D. Bend Feed Canal: NW¼ NE¼, Section 32, T. 17 S., R. 12 E., W.M.; 2050 feet west from the NE Corner of Section 32.
10. Rivers Edge Golf Club: SW¼ NE¼, Section 29, T. 17 S., R. 12 E., W.M.; 1980 feet south and 1160 feet east from the N¼ Corner of Section 29.
11. C.O.I.D. North Canal: SE¼ NE¼, Section 29, T. 17 S., R. 12 E., W.M.; 850 feet north and 630 feet west from the E¼ Corner of Section 29.
12. Cline Falls State Park: NW¼ SE¼, Section 14, T. 15 S., R. 12 E., W.M.; 425 feet south and 1475 feet west from the E¼ Corner of Section 14.

A description of the place of use to which this right is appurtenant is as follows:

QTR/QTR	TL	USE	ACRES	DIV. PT.	OWNER
SW¼ SE¼	401	IR	1.820	12	OREGON STATE PARKS
SE¼ SE¼	600	IR	1.660	12	OREGON STATE PARKS
Section 32					
SW¼ NE¼	200	IR	6.600	11	THORNBURGH, EVERETT
SE¼ NE¼	200	IR	8.900	11	THORNBURGH, EVERETT
NE¼ SW¼	500	IR	13.250	11	BRADEN, SONDRAD
NW¼ SW¼	500	IR	1.000	11	BRADEN, SONDRAD
SW¼ SW¼	500	IR	19.200	11	BRADEN, SONDRAD
SE¼ SW¼	600	IR	26.000	11	PRATT, DOROTHY LOU
NE¼ SE¼	300	IR	36.650	11	THORNBURGH, EVERETT
SW¼ SE¼	400	IR	0.100	11	THORNBURGH, EVERETT
SE¼ SE¼	400	IR	32.350	11	THORNBURGH, EVERETT
Section 33					
SW¼ NW¼	400	IR	7.700	11	THORNBURGH, EVERETT
NE¼ SW¼	100	IR	4.000	11	HARPER, VIRGIL
NW¼ SW¼	400	IR	36.300	11	THORNBURGH, EVERETT
SW¼ SW¼	400	IR	37.400	11	THORNBURGH, EVERETT
SE¼ SW¼	100	IR	2.000	11	HARPER, VIRGIL
SE¼ SW¼	103	IR	14.000	11	GREGG, GARY E
Section 34					
Township 13 South, Range 13 East, W.M.					
NE¼ NE¼	300	IR	12.000	11	CLARK, DAVID L
SE¼ NE¼	300	IR	6.200	11	CLARK, DAVID L
Section 12					
SE¼ NE¼	4300	IR	14.000	11	BETTESWORTH, JAY
SE¼ NE¼	4400	IR	5.000	11	GREGG, MARGARET
NE¼ SE¼	300	IR	1.000	11	BITTLER, SCOTT
NE¼ SE¼	400	IR	1.400	11	SCHULTZ, RUTH A
Section 36					
Township 14 South, Range 12 East, W.M.					
SW¼ NE¼	600	IR	3.200	11	HUMPHREYS FAMILY TRUST
SE¼ NE¼	600	IR	4.000	11	HUMPHREYS FAMILY TRUST
NE¼ NW¼	700	IR	8.100	11	GARDNER, JAMES

NE¼ NW¼ 1800	IR	0.030	9	SHORT, WALTER JOHN
NE¼ NW¼ 2200	IR	0.080	9	BARRIE, BETTY J. & COX, SUSAN
NE¼ NW¼ 2400	IR	0.140	9	BRAINERD, HAROLD G. ET UX
NE¼ NW¼ 2500	IR	0.330	9	BIANUCCI, JOHN ET AL
NE¼ NW¼ 2700	IR	0.190	9	CURL, ANITA G.
NE¼ NW¼ 2900	IR	0.120	9	THOMSON, G.J. & OTTENFELD, D.
NE¼ NW¼ 3000	IR	0.200	9	BOLLMAN, A.W., TRUSTEE
NE¼ NW¼ 3101	IR	0.200	9	DE KAT, GARY H. & VIRGINIA A.
NE¼ NW¼ 3300	IR	1.710	9	RIMROCK ASSOC. OF BEND, INC.
NE¼ NW¼ 3800	IR	1.170	9	RIMROCK ASSOC. OF BEND, INC.
NW¼ NW¼ 500	IR	0.350	9	LAMARCHE, H.J. ET UX
NW¼ NW¼ 600	IR	0.520	9	NASH, DONAL B. & DEBORAH L.
NW¼ NW¼ 700	IR	0.310	9	HEISTUMAN, T. & LAMBERT, S.
NW¼ NW¼ 2700	IR	0.180	9	CURL, ANITA G.
NW¼ NW¼ 3200	IR	0.030	9	CREASEY, DOUGLAS K. & KAREN L.

Section 20

Township 17 South, Range 12 East, W.M.

This certificate is issued to confirm changes in use and place of use approved by an order of the Water Resources Department Director entered 12/6/99, approving the Central Oregon Irrigation District petition for water rights mapping under ORS 541.325 to 541.331 and confirms those changes in place of use and points of diversion approved by orders of the Water Resources Director entered May 9, 1980; January 19, 1981; January 19, 1990; and May 9, 1990, not eligible for inclusion in the district water rights mapping petition.

This certificate supersedes certificate of water right numbered 29052.

The right to the use of the water for the above purpose is restricted to beneficial use on the lands or place of use described and is subject to all other conditions and limitations contained in said decrees.

WITNESS the signature of the Water Resources Director, affixed 12/6/99.


Martha O. Pagel, Director

Instrument Leads #306 7-02/10-02
#307 7-02/10-02
#297 7-02/10-02
#325 8-02/10-02
#326 8-02/10-02
#327 8-02/10-02
#259 7-02/10-02
#298 7-02/10-02
#262 6-02/10-02
#261 6-02/10-02
#265 6-02/10-02

L-385 L-387 L-389 L-391 L-393 L-395 L-397 L-399 L-401 L-403
L-396 L-398 L-390 L-392 L-394 L-396 L-398 L-400 L-402 L-404 L-406

T-8692 spo. v. 55p 941 v. 56p. 2014
T-8693 spo. v. 55p 617 v. 56p. 999 v. 57p. 1203
T-8982 v. 56p. 124
T-8983 v. 56p. 127
T-8984 v. 56p. 130
T-8985 v. 56p. 133
T-9214 A pou/po v. 57p. 1490 (withdrawn)
T-9105 v. 44p. 93
T-9104 v. 43p. 520

COUNTY OF DESCHUTES

CERTIFICATE OF WATER RIGHT

THIS CERTIFICATE ISSUED TO

CENTRAL OREGON IRRIGATION DISTRICT
2598 N HIGHWAY 97
REDMOND, OREGON 97756

T-9555 WITHDRAWN
T-9557
T-9558
T-9559
T-9605
T-9603
T-9604

T-9299 AUSE/POU
T-9313 APOU
T-9314 v. 58p
T-9315
(divis) T-9343 AUSE/POU
T-9500
T-9499
T-9423 WITHDRAWN
T-9424 WITHDRAWN
T-9439
T-9440
T-9441
T-9463
T-9462

Instream Lease #1's
115, 260, 261, 257, 259,
258, 256, 266, 263,
262, 264, 265, 2117
v. 56p. 2042
T-9017, 9018, 9020, 9021,
9022, 9023, 9024
v. 57p. 1155
T-9283
T-9113 v. 56p. 1030

T-9150
T-9156 v. 56p. 1033
T-9195 v. 56p. 2051
T-9276
T-9516

confirms the right to use the waters of THE DESCHUTES RIVER, a tributary of THE COLUMBIA RIVER, for IRRIGATION OF ACRES 43,746.93 ACRES, 781.957 ACRES/EQUIVALENT FOR MUNICIPAL USE, 158.01 ACRES/EQUIVALENT FOR POND MAINTENANCE, 87.10 ACRES/EQUIVALENT FOR INDUSTRIAL USE, 7.0 ACRES/EQUIVALENT FOR QUASI-MUNICIPAL USE, 2.80 ACRES/EQUIVALENT FOR DUST ABATEMENT, STOCK WATER, AND DOMESTIC USE.

This right was confirmed by decree of the Circuit Court of the State of Oregon for DESCHUTES County. The decree is of record at Salem, in the Order Record of the WATER RESOURCES DIRECTOR, in Volume 12, at Page 282 and in Volume 16, at pages 1 and 390. The dates of priority are OCTOBER 31, 1900 FOR 985.0 CUBIC FEET PER SECOND, AND DECEMBER 2, 1907 FOR THE BALANCE ALLOWED BY DECREE.

The amount of water used for irrigation, together with the amount secured under any other right existing for the same lands, is limited to a diversion of not to exceed the quantity determined by decree of the Circuit Court for Deschutes County, dated March 24, 1933, being:

April 1 to May 1 and Oct. 1 to Nov. 1	1 cfs to 80.0 acres
May 1 to May 15 and Sept. 15 to Oct. 1	1 cfs to 60.0 acres
May 15 to Sept. 15	1 cfs to 32.4 acres

for each acre irrigated by the Central Oregon Irrigation District main canal systems during the irrigation season of each year, not to exceed 9.91 acre-feet for each acre irrigated during the irrigation season as measured at the diversion from the source. The quantities reflect a 45% transmission loss as determined by decree of the Circuit Court for Deschutes County, dated March 24, 1933. Those lands not served from the district main canal systems but by direct pumping from the Deschutes River will not be allowed the 45% transmission loss.

The points of diversion are located as follows:

1. Central Oregon Canal: SW 1/4 NE 1/4, Section 13, T. 18 S., R. 11 E., W.M.; 1520 feet south and 1535 feet west from the NE Corner of Section 13.
2. Smith Properties, Inc.: Lot 4 (NW 1/4 NW 1/4), Section 5, T. 18 S., R. 12 E., W.M.; 440 feet south and 970 feet east from the NW Corner of Section 5.
3. Columbia Park: SE 1/4 SE 1/4, Section 31, T. 17 S., R. 12 E., W.M.; 740 feet north and 490 feet west from the SE Corner of Section 31.
4. Drake Park South: NE 1/4 SE 1/4, Section 31, T. 17 S., R. 12 E., W.M.; 700 feet north and 120 feet west from the SE Corner of NE 1/4 SE 1/4, Section 31.
5. Drake Park North: SW 1/4 NW 1/4, Section 32, T. 17 S., R. 12 E., W.M.; 2150 feet south and 750 feet east from the NW Corner of Section 32.
6. Harmon Park: SW 1/4 NW 1/4, Section 32, T. 17 S., R. 12 E., W.M.; 700 feet south and 680 feet west from the NE Corner of SW 1/4 NW 1/4, Section 32.

HB3111.bwb
T-9534 v. 55p. 1365 ext. of time v. 61p. 525
v. 54p. 566 v. 54p. 560
T-8532 T-8514

Page 1 of 105

AMENDED by special order

L-380 Instream Lease #187 5/2/2001-10/31/2002
L-368 Instream Lease #234 9-19-01/9-30-01

v. 55 pg. 167

7. Pioneer Park (South): NW¼ NE¼, Section 32, T. 17 S., R. 12 E., W.M.; 600 feet south and 450 feet west from the NE Corner of the NW¼ NE¼ of Section 32.
8. Pioneer Park (North): NW¼ NE¼, Section 32, T. 17 S., R. 12 E., W.M.; 560 feet west from the NE Corner of the NW¼ NE¼ of Section 32.
9. T.I.D. Bend Feed Canal: NW¼ NE¼, Section 32, T. 17 S., R. 12 E., W.M.; 2050 feet west from the NE Corner of Section 32.
10. Rivers Edge Golf Club: SW¼ NE¼, Section 29, T. 17 S., R. 12 E., W.M.; 1980 feet south and 1160 feet east from the NE Corner of Section 29.
11. C.O.I.D. North Canal: SE¼ NE¼, Section 29, T. 17 S., R. 12 E., W.M.; 850 feet north and 630 feet west from the NE Corner of Section 29.
12. Cline Falls State Park: NW¼ SE¼, Section 14, T. 15 S., R. 12 E., W.M.; 425 feet south and 1475 feet west from the NE Corner of Section 14.

A description of the place of use to which this right is appurtenant is as follows:

QTR/QTR	TL	USE	ACRES	DIV. PT.	OWNER
SW¼ SE¼	401	IR	1.820	12	OREGON STATE PARKS
SE¼ SE¼	600	IR	1.660	12	OREGON STATE PARKS
Section 32					
SW¼ NE¼	200	IR	6.600	11	THORNBURGH, EVERETT
SE¼ NE¼	200	IR	8.900	11	THORNBURGH, EVERETT
NE¼ SW¼	500	IR	13.250	11	BRADEN, SONDRAD
NW¼ SW¼	500	IR	1.000	11	BRADEN, SONDRAD
SW¼ SW¼	500	IR	19.200	11	BRADEN, SONDRAD
SE¼ SW¼	600	IR	26.000	11	PRATT, DOROTHY LOU
NE¼ SE¼	300	IR	36.650	11	THORNBURGH, EVERETT
SW¼ SE¼	400	IR	0.100	11	THORNBURGH, EVERETT
SE¼ SE¼	400	IR	32.350	11	THORNBURGH, EVERETT
Section 33					
SW¼ NW¼	400	IR	7.700	11	THORNBURGH, EVERETT
NE¼ SW¼	100	IR	4.000	11	HARPER, VIRGIL
NW¼ SW¼	400	IR	36.300	11	THORNBURGH, EVERETT
SW¼ SW¼	400	IR	37.400	11	THORNBURGH, EVERETT
SE¼ SW¼	100	IR	2.000	11	HARPER, VIRGIL
SE¼ SW¼	103	IR	14.000	11	GREGG, GARY E
Section 34					
Township 13 South, Range 13 East, W.M.					
NE¼ NE¼	300	IR	12.000	11	CLARK, DAVID L
SE¼ NE¼	300	IR	6.200	11	CLARK, DAVID L
Section 12					
SE¼ NE¼	4300	IR	14.000	11	BETTESWORTH, JAY
SE¼ NE¼	4400	IR	5.000	11	GREGG, MARGARET
NE¼ SE¼	300	IR	1.000	11	BITTLER, SCOTT
NE¼ SE¼	400	IR	1.400	11	SCHULTZ, RUTH A
Section 36					
Township 14 South, Range 12 East, W.M.					
SW¼ NE¼	600	IR	3.200	11	HUMPHREYS FAMILY TRUST
SE¼ NE¼	600	IR	4.000	11	HUMPHREYS FAMILY TRUST
NE¼ NW¼	700	IR	8.100	11	GARDNER, JAMES

NE¼ NW¼ 1800	IR	0.030	9	SHORT, WALTER JOHN
NE¼ NW¼ 2200	IR	0.080	9	BARRIE, BETTY J. & COX, SUSAN
NE¼ NW¼ 2400	IR	0.140	9	BRAINERD, HAROLD G. ET UX
NE¼ NW¼ 2500	IR	0.330	9	BIANUCCI, JOHN ET AL
NE¼ NW¼ 2700	IR	0.190	9	CURL, ANITA G.
NE¼ NW¼ 2900	IR	0.120	9	THOMSON, G.J. & OTTENFELD, D.
NE¼ NW¼ 3000	IR	0.200	9	BOLLMAN, A.W., TRUSTEE
NE¼ NW¼ 3101	IR	0.200	9	DE KAT, GARY H. & VIRGINIA A.
NE¼ NW¼ 3300	IR	1.710	9	RIMROCK ASSOC. OF BEND, INC.
NE¼ NW¼ 3800	IR	1.170	9	RIMROCK ASSOC. OF BEND, INC.
NW¼ NW¼ 500	IR	0.350	9	LAMARCHE, H.J. ET UX
NW¼ NW¼ 600	IR	0.520	9	NASH, DONAL B. & DEBORAH L.
NW¼ NW¼ 700	IR	0.310	9	HEISTUMAN, T. & LAMBERT, S.
NW¼ NW¼ 2700	IR	0.180	9	CURL, ANITA G.
NW¼ NW¼ 3200	IR	0.030	9	CREASEY, DOUGLAS K. & KAREN L.

Section 20


Township 17 South, Range 12 East, W.M.

This certificate is issued to confirm changes in use and place of use approved by an order of the Water Resources Department Director entered 12/6/99, approving the Central Oregon Irrigation District petition for water rights mapping under ORS 541.325 to 541.331 and confirms those changes in place of use and points of diversion approved by orders of the Water Resources Director entered May 9, 1980; January 19, 1981; January 19, 1990; and May 9, 1990, not eligible for inclusion in the district water rights mapping petition.

This certificate supersedes certificate of water right numbered 29052.

The right to the use of the water for the above purpose is restricted to beneficial use on the lands or place of use described and is subject to all other conditions and limitations contained in said decrees.

WITNESS the signature of the Water Resources Director, affixed 12/6/99.

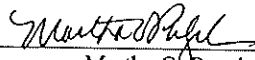
Martha O. Pagel, Director

Instream lease #306 7-02/10-02
#307 7-02/10-02
#297 7-02/10-02
#325 8-02/10-02
#326 8-02/10-02
#327 8-02/10-02
#259 7-02/10-02
#298 7-02/10-02
#262 6-02/10-02
#261 6-02/10-02
#265 6-02/10-02



Oregon

Theodore R. Kulongoski, Governor

Water Resources Department

North Mall Office Building
725 Summer Street NE, Suite A
Salem, OR 97301-1266
503-986-0900
FAX 503-986-0904

September 16, 2008

CENTRAL OREGON IRRIGATION DISTRICT
1055 SW LAKE COURT
REDMOND OR 97756

Reference: District Transfer T- 10510

Enclosed is a copy of the order approving your District transfer.

A time to complete the transfer is given the order.

Sincerely,

Sarah Henderson
Executive Support

cc: Watermaster #11

Enclosure



**BEFORE THE WATER RESOURCES DEPARTMENT
OF THE
STATE OF OREGON**

In the Matter of Transfer Application	)	FINAL ORDER APPROVING A
T-10510, Deschutes County	)	DISTRICT
	)	PERMANENT TRANSFER

Authority

ORS 540.570 to 540.580 establishes the process in which a district may submit a request to transfer a water right within district boundaries. OAR Chapter 690, Division 385 implements the statutes and provides the Department's procedures and criteria for evaluating district transfer applications.

Applicant

CENTRAL OREGON IRRIGATION DISTRICT
1055 SW LAKE COURT
REDMOND, OR 97756

Findings of Fact

1. On December 24, 2007, Central Oregon Irrigation District filed a district transfer application to permanently change the place of use under Certificates 83571 and 76714. The Department assigned the application number T-10510.
2. Notice of the application for transfer was published pursuant to ORS 540.580 and OAR 690-385-4400. No comments were filed in response to the notice.
3. On September 16, 2008, Department staff spoke to representatives of Central Oregon Irrigation District and obtained clarifications related to the authorized and proposed place of use for Certificate 76714.
4. The portion of the primary right to be transferred is as follows:
Certificate: 83571 in the name of CENTRAL OREGON IRRIGATION DISTRICT
Use: IRRIGATION
Priority Date: OCTOBER 31, 1900 and DECEMBER 2, 1907
Season of Use: April 1 through October 31, further limited as follows:
 April 1 through April 30 & October 1 through October 31 described herein as Season 1.
 May 1 through May 14 & September 16 through September 30 described herein as Season 2.
 May 15 through September 15 described herein as Season 3.

This is a final order in other than contested case. This order is subject to judicial review under ORS 183.484. Any petition for judicial review must be filed within the 60 day time period specified by ORS 183.484(2). Pursuant to ORS 536.075 and OAR 137-004-0080 you may either petition for judicial review or petition the Director for reconsideration of this order. A petition for reconsideration may be granted or denied by the Director, and if no action is taken within 60 days following the date the petition was filed, the petition shall be deemed denied.

Maximum Quantity (Rate) that can be applied to an acre:

Season 1: Limited to 1/80 cubic foot per second (CFS) per acre

Season 2: Limited to 1/60 CFS per acre

Season 3: Limited to 1/32.4 CFS per acre

Maximum Duty that can be applied to an acre:

Not to exceed 9.91 acre-feet (AF) per acre per year.

The above listed rates and duty reflect allowance of a 45% transmission loss as determined by decree of the Circuit Court of Deschutes County, dated March 24, 1933. Those lands not served from the district main canal systems, but by direct pumping from the Deschutes River, are not allowed the 45% transmission loss.

Source: Deschutes River, tributary to the Columbia River**Authorized Points of Diversion:**

TWP	RNG	MER	SEC	Q-Q	Measured Distance
18S	11E	WM	13	SW NE	POD #1 (CENTRAL OREGON CANAL): 1520 FEET SOUTH AND 1535 FEET WEST OF THE NE CORNER OF SECTION 13
17S	12E	WM	29	SE NE	POD #11 (C.O.I.D. NORTH CANAL): 850 FEET NORTH AND 630 FEET WEST FROM THE E¼ CORNER OF SECTION 29

Authorized Place of Use:

TWP	RNG	MER	SEC	Q-Q	TAX LOT	ACRES	USER	NOTICE #	POD #
16 S	12 E	WM	1	SE NE	200	0.25	WALLACE, MARY SUE	T-2007-027	11
16 S	12 E	WM	1	NE SE	200	0.01	WALLACE, MARY SUE	T-2007-027	11
16 S	14 E	WM	8	SE SE	101	1.20	SCHINKEL FAMILY REVOCABLE LIVING TRUST	T-2007-034	1
16 S	14 E	WM	8	SE SE	101	0.40	SCHINKEL FAMILY REVOCABLE LIVING TRUST	T-2007-034	1
16 S	14 E	WM	16	NW SW	201	2.60	BOVEE, ALAN/MARGARET	T-2007-028	1
17 S	13 E	WM	33	SW NW	1106	0.15	WAITS, RONALD/MICHELLE	T-2007-026	1
17 S	14 E	WM	15	SE NE	500	0.35	BEAN, DARCY	T-2007-030	1
17 S	14 E	WM	22	NE SE	801	0.20	COID/QUITCLAIM	T-2007-029	1
17 S	14 E	WM	23	SW SE	1200	0.50	COID/QUITCLAIM	T-2007-029	1
18 S	12 E	WM	4	SE SW	600	0.30	COID/QUITCLAIM	T-2007-029	1
18 S	13 E	WM	6	NE NE	100	1.40	TUMA, BEN /SHELLEY	T-2007-023	1
Total						7.36			

4. Transfer Application T-10510 proposes to change the place of use to:

TWP	RNG	MER	SEC	Q-Q	TAX LOT	ACRES	USER	NOTICE #	POD #
15 S	14 E	WM	35	NW SW	400	2.60	POWELL BUTTE FARMERS CLUB, INC.	T-2007-028	1
16 S	12 E	WM	1	SE NE	200	0.01	WALLACE, MARY SUE	T-2007-027	11
16 S	12 E	WM	1	SE NE	200	0.25	WALLACE, MARY SUE	T-2007-027	11
16 S	14 E	WM	8	SE SE	101	1.20	SCHINKEL FAMILY REVOCABLE LIVING TRUST	T-2007-034	1
16 S	14 E	WM	17	NE NE	100	0.40	SCHINKEL FAMILY REVOCABLE TRUST	T-2007-034	1
17 S	12 E	WM	24	SE SE	1500	0.50	MONSON, ROBERT/ESTHER	T-2007-029	1
17 S	12 E	WM	24	SE SE	1500	0.20	MONSON, ROBERT/ESTHER	T-2007-029	1

TWP	RNG	MER	SEC	Q-Q	TAX LOT	ACRES	USER	NOTICE #	POD #
17 S	12 E	WM	24	SE SE	1500	0.30	MONSON, ROBERT/ESTHER	T-2007-029	1
17 S	13 E	WM	33	SW NW	1106	0.15	WAITS, RONALD/MICHELLE	T-2007-026	1
17 S	14 E	WM	15	SW NW	500	0.35	BEAN, DARCY	T-2007-030	1
18 S	13 E	WM	6	NE NE	101	1.40	TUMA, BEN/SHELLEY	T-2007-023	1
Total						7.36			

5. Certificate 83571 is a deficient water right. If water were diverted simultaneously to all authorized lands and uses described in the right at the maximum rates and duty allowed (described in Finding of Fact #4), the total rate and duty for the water right would be exceeded. In the event water were diverted simultaneously to all authorized lands and uses described in the right at the maximum rates and duty allowed at the PODs (described in Finding of Fact #4), the portion of the right involved in this transfer would be limited as described in the tables below. These rates and duty are also the quantities by which Certificate 83571 shall be reduced are indicated in the tables below:

POINT OF DIVERSION (POD) NUMBER 1				
Priority Date	Season 1	Season 2	Season 3	Duty (AF)
October 31, 1900 (cfs)	0.088	0.118	0.156	70.05
December 2, 1907 (cfs)			0.062	

POINT OF DIVERSION (POD) NUMBER 11				
Priority Date	Season 1	Season 2	Season 3	Duty (AF)
October 31, 1900 (cfs)	0.003	0.004	0.006	2.57
December 2, 1907 (cfs)			0.002	

6. The season of use described in Certificate 83571 contains scrivener errors. Consistent with the Decree for the Deschutes River (Volume 12, Page 282), the irrigation season is:

Season of Use: April 1 through October 31, further limited as follows:

April 1 through April 30 & October 1 through October 31 described herein as Season 1.

May 1 through May 14 & September 15 through September 30 described herein as Season 2.

May 15 through September 14 described herein as Season 3.

7. The portion of the supplemental right to be transferred is as follows:

Certificate: 76714 in the name of CENTRAL OREGON IRRIGATION DISTRICT

Use: SUPPLEMENTAL IRRIGATION

Priority Date: February 28, 1913

Limit/Duty: limited to 50,000 acre-feet of stored water only

Source: Crane Prairie Reservoir, constructed under Permit R-1687, a tributary of the Deschutes River

The water right evidenced by Certificate 76714 allows the use of up to 50,000 acre-feet of water stored in Crane Prairie Reservoir, a tributary of the Deschutes River, for supplemental irrigation. The diversion rate is not specified and use is limited to the total volume of stored water to make up any deficiency in supply of the live flow water right appurtenant to specified lands.

Authorized Points of Diversion:

TWP	RNG	MER	SEC	Q-Q	Measured Distance
18S	11E	WM	13	SW NE	POD #1 (CENTRAL OREGON CANAL): 1520 FEET SOUTH AND 1535 FEET WEST OF THE NE CORNER OF SECTION 13
17S	12E	WM	29	SE NE	POD #11 (C.O.I.D. NORTH CANAL): 850 FEET NORTH AND 630 FEET WEST FROM THE E $\frac{1}{4}$ CORNER OF SECTION 29

Authorized Place of Use:

TWP	RNG	MER	SEC	Q-Q	TAX LOT	ACRES	USER	NOTICE #	POD #
16 S	12 E	WM	1	SE NE	200	0.25	WALLACE, MARY SUE	T-2007-027	11
16 S	12 E	WM	1	NE SE	200	0.01	WALLACE, MARY SUE	T-2007-027	11
16 S	14 E	WM	8	SE SE	101	1.20	SCHINKEL FAMILY REVOCABLE LIVING TRUST	T-2007-034	1
16 S	14 E	WM	8	SE SE	101	0.40	SCHINKEL FAMILY REVOCABLE LIVING TRUST	T-2007-034	1
16 S	14 E	WM	16	NW SW	201	2.60	BOVEE, ALAN/MARGARET	T-2007-028	1
17 S	13 E	WM	33	SW NW	1106	0.15	WAITS, RONALD/MICHELLE	T-2007-026	1
17 S	14 E	WM	15	SE NE	500	0.35	BEAN, DARCY	T-2007-030	1
17 S	14 E	WM	22	NE SE	801	0.20	COID/QUITCLAIM	T-2007-029	1
17 S	14 E	WM	23	SW SE	1200	0.50	COID/QUITCLAIM	T-2007-029	1
18 S	12 E	WM	4	SE SW	600	0.30	COID/QUITCLAIM	T-2007-029	1
18 S	13 E	WM	6	NE NE	100	1.40	TUMA, BEN /SHELLEY	T-2007-023	1
Total						7.36			

6. Transfer Application T-10510 proposes to change the place of use to:

TWP	RNG	MER	SEC	Q-Q	TAX LOT	ACRES	USER	NOTICE #	POD #
15 S	14 E	WM	35	NW SW	400	2.60	POWELL BUTTE FARMERS CLUB, INC.	T-2007-028	1
16 S	12 E	WM	1	SE NE	200	0.01	WALLACE, MARY SUE	T-2007-027	11
16 S	12 E	WM	1	SE NE	200	0.25	WALLACE, MARY SUE	T-2007-027	11
16 S	14 E	WM	8	SE SE	101	1.20	SCHINKEL FAMILY REVOCABLE LIVING TRUST	T-2007-034	1
16 S	14 E	WM	17	NE NE	100	0.40	SCHINKEL FAMILY REVOCABLE TRUST	T-2007-034	1
17 S	12 E	WM	24	SE SE	1500	0.50	MONSON, ROBERT/ESTHER	T-2007-029	1
17 S	12 E	WM	24	SE SE	1500	0.20	MONSON, ROBERT/ESTHER	T-2007-029	1
17 S	12 E	WM	24	SE SE	1500	0.30	MONSON, ROBERT/ESTHER	T-2007-029	1
17 S	13 E	WM	33	SW NW	1106	0.15	WAITS, RONALD/MICHELLE	T-2007-026	1
17 S	14 E	WM	15	SW NW	500	0.35	BEAN, DARCY	T-2007-030	1
18 S	13 E	WM	6	NE NE	101	1.40	TUMA, BEN/SHELLEY	T-2007-023	1
Total						7.36			

Transfer Review Criteria (OAR 690-385-5000)

16. The district permanent transfer application satisfies the criteria of OAR 690-385-4000, contains the information required under OAR 690-385-2000, and includes maps meeting the requirements of OAR 690-385-2200.
17. The water rights are subject to transfer as defined in OAR 690-385-0100(17).
18. The proposed change in place of use would not result in enlargement of the rights.
19. The proposed change in place of use would not result in injury to other water rights

Conclusions of Law

The proposed changes in place of use in Transfer Application T-10510 satisfy the requirements of ORS 540.574(3) and 540.580.

Now, therefore, it is ORDERED:

1. The proposed changes to the water rights evidenced by Certificates 83571 and 76714 are approved.
2. The right to the use of the water is restricted to beneficial use at the place of use described and is subject to all other conditions and limitations contained in Certificates 83571 and 76714 and any related decree.
3. The former places of use shall no longer be irrigated as part of these water rights.
4. The proposed change, as authorized by this final order, shall be completed within one full year from the approval date plus any additional time before or until October 1, 2009.
5. A Claim of Beneficial Use shall be submitted by the applicant to the Department by October 1, 2010.
6. Certificates 83571 and 76714 are hereby modified. The Department will issue superseding certificates describing the rights when it determines that it is necessary for record keeping.

Dated at Salem, Oregon this 16th day of September, 2008.


Phillip C. Ward, Director

Mailing Date: SEP 18 2008

Water Right Transfer Checklist

Sue

Transfer T-10510

Transfer Specialist: Kody Thurgood

Transfer Type: District

Applicant Name/Address: Central Oregon Irrigation District

Agent Name/Address: N/A

CWRE Name/Number: N/A

Rec Landowner Name/Address: Ben/Shelly Tuma, Ronald/Michelle Waits, Mary Sue Wallace, Alan/Margaret Bovee, Darcy Bean, Schinkel Family Revocable Living Trust Powell Butte Farmers Club, Inc., Robert/Esther Monson

Irr. District Name/Address: COID

Affected Gov'ts Name/Address: Jefferson County Planning Dept. 66 SE D Street, Madras, OR 97741; Deschutes County Planning Dept. 1300 NW Wall St., Suite 200 Bend, OR 97701

Commentors: Name/Address: N/A

Water Rights Affected

Records Marked	Records Copied	App File No. or Decree Name	Permit No.	Certificate No.	RR/CR Needed	RR/CR Nos.
☒	☒	Deschutes River Decree	None	76358	☐ Yes ☐ No	
☒	☒	13180	23256	76714	☐ Yes ☐ No	
☐	☐				☐ Yes ☐ No	

Key Dates & Initial Actions

Rec'd: <u>12/24/2007</u>	Proposed Action(s): POU POD HST APOD USE OTHER: POU	
Fees Pd: <u>600.00</u>	WM District: <u>11</u>	ODFW District: <u>none</u>
Initial Notice: <u>1/8/2008</u>	WM Review sent: <u>1/10/2008</u>	ODFW Review sent: <u>none</u>
Acknowledgement Letter Sent ☒		GW Review sent: <u>none</u>

Processing Dates & Actions

Deficiency Contacts: _____

Newspaper Pub Affid Due: _____

☐ not required

DPD Mailed: _____

Affid of Pub Rec'd: _____

☐ ODFW contact sheet sent with DPD, or ☐ N/A

Last Day Published: _____

PD Mailed: _____

Affidavit Reminder Sent: _____

PD Weekly Notice: _____

Reminder Deadline: _____

Preliminary Determination

☐ Electronic Files uploaded

☐ Preliminary Determination

☐ PD Cover letter

☐ Fee Refund Due

☐ PD Notice

☐ Remaining Rights

☐ File Assigned/ ModPod updated

DPD Review (Optional)	PD Review (Salem)	Final Order Review (Salem)
Reviewer: _____	Reviewer: _____	Reviewer: <u>ST</u>
Date: _____	Date: _____	Date: <u>9-16-08</u>
Coordinator: _____	Coordinator: _____	Coordinator: _____
Date: _____	Date: _____	Date: _____
Comments/Special Issues:		

Special Order Volume: Vol 75 Pages 754

Final Order Signature Date: 9-16-08

Notice of FO email'd to processors Susan

Application

- ☐ The type of change is clearly indicated.
☐ The application is appropriately signed.
☐ Appropriate fees were paid. ☐ If overpayment, Refund Request to be sent with FO
☐ Land use form matches affected tax lots and is signed by proper official. (*from ALL affected Govt's*)
☐ Ditch company, district and/or BOR, sent a copy of the application and map, if appropriate.
☐ All required attachments received.

Water right subject to transfer

- ☐ Certificated right or Proof accepted "to the satisfaction...."
☐ The right been exercised according to terms & conditions of certificate.
☐ Delivery system has the capacity to fully divert the rate/duty of the right.
☐ No information in record that suggests forfeiture.
☐ No conflicts identified on the plat cards and plat card reports printed.
☐ Affidavits prepared for rights that need to be canceled or diminished.

Application Map

- ☐ The map has an original CWRE signature.
☐ The map size and scale accurate and appropriate per OAR 690-380-3100(1)(b)(c)&(d).
☐ All authorized and proposed POD's/POA's and POU's shown and clearly labeled.
☐ Metes and bounds for the POD's/POA's are properly described on the map.
☐ The POD/POA dimensions & ¼ ¼ on map match the transfer application and certificate descriptions.
☐ Map acres match the tabulation on the certificate.
☐ Have final proof maps/deed maps for the rights. ☐ Application map matches certificate FPS.
☐ Have necessary aerial photos.

Determining the "From" and "To" Lands (*make working copy of application and certificates to mark on*)

- ☐ Only the authorized POD's/POA's and POU's to be transferred are listed.
☐ Application & certificate tabulations match. (*Mark on appl. and cert. copies and note corrections needed*)
☐ Marked on certificate the acreage being transferred, cancelled and remaining by ¼ ¼.

Ownership

- ☐ The deed/ROLI matches the "from" lands. (Don't need to check "to" lands.)
☐ Have current tax lot map. (*If transfer application is several years old, contact assessor's office*)
☐ The applicant is the owner of the "from" lands.
☐ All owners on the deed/ROLI have signed the application.
☐ If necessary, there is a notarized, signed statement of consent from landowners other than applicant.
☐ If necessary, there is a copy of written notification to each lien holder identified on ROLI.
☐ Agent has authorization to make decisions.

Evaluation (materials needed for peer reviewer in bold)


- | | | | | |
|---|--------------------------------------|------------------------------------|--|--|
| ☐ application complete | ☐ map | ☐ FPS | ☐ evidence of use | ☐ land-use form |
| ☐ deed/ROLI | ☐ certificate | ☐ fees paid | ☐ well logs | ☐ plat card |
| ☐ audit | ☐ dpd | | | |

Reviews/comments/conditions received? ☐ Watermaster ☐ ODFW ☐ GW

Headgate	☐ When in the judgment	☐ Prior to diverting	☐ Existing and maintain
Measuring Devices	☐ When in the judgment	☐ Prior to diverting	☐ Existing and maintain
Fish Screen Devices	☐		

Injury: Y N Enlargement: Y N

Conditions to avoid enlargement/injury –

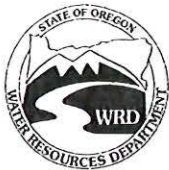

Oregon Water Resources Department
725 Summer Street NE, Suite A
Salem, Oregon 97301-1271
(503) 986-0900
www.wrd.state.or.us

Watermaster Review Form: Water Right Transfer

Transfer Application: T-10510

Review Due Date: 2/8/2008

Applicant Name: COID

Proposed Changes: ☒ POU ☐ POD ☐ POA ☐ USE ☐ OTHER

Reviewer(s): Giffin

Date of Review: Jan. 14, 2008

1. Do you have information suggesting that the water rights may be subject to forfeiture?
☐ Yes ☒ No If "Yes", describe the information and indicate if you intend to file a cancellation affidavit or if you need additional time to determine if a cancellation affidavit should be filed: _____
2. Is there a history of regulation on the source that serves the right proposed for transfer that has involved the right and downstream water rights? ☐ Yes ☒ No Generally characterize the frequency of any regulation or explain why regulation has not occurred: _____
3. Check here if it appears that downstream water rights benefit from return flows resulting from the current use of the right? ☐ If you check the box, generally characterize the locations where the return flows likely occur and list the water rights that benefit most: _____
4. Are there upstream water rights that would be affected by the proposed change?
☐ Yes ☒ No If "Yes", describe how the rights would be affected and list the rights most affected: _____
5. For POD changes and instream transfers, check here if there are channel losses between the old and new PODs or within the proposed instream reach? ☐ If you check the box, describe and, if possible, estimate the losses: _____
6. Would distribution of water for the right after the proposed change result in regulation of other water rights that would not have occurred if use of the existing right was maximized?
☐ Yes ☒ No If "Yes", explain: _____
7. For POU changes, would the original place of use continue to receive water from the same source? ☐ Yes ☒ No ☐ N/A If "Yes", explain: _____
8. For POU or USE changes, would use of the existing right at "full face value," result in the diversion of more water than can be used beneficially and without waste? ☐ Yes ☒ No If "Yes", explain: _____
9. Are there other issues not identified through the above questions? ☐ Yes ☒ No If "Yes", explain: _____
10. What alternatives may be available for addressing any issues identified above: _____

RECEIVED

JAN 22 2008

**WATER RESOURCES DEPT
SALEM, OREGON**

11. Have headgate notices been issued for the source that serves the right? ☐ Yes ☒ No

12. What water control and measurement conditions should be included in the transfer:

Measurement Devices	☒ Present and should be maintained.	☐ Should be required prior to diverting water.	☐ May be required in the future.
Headgates	☒ Present and should be maintained.	☐ Should be required prior to diverting water.	☐ May be required in the future.



Oregon

Theodore R. Kulongoski, Governor

Water Resources Department

North Mall Office Building
725 Summer Street NE, Suite A
Salem, OR 97301-1266
503-986-0900
FAX 503-986-0904

January 15, 2008

CENTRAL OREGON IRRIGATION DISTRICT
1055 SW LAKE COURT
REDMOND, OR 97756

Reference: Transfer 10510

On December 24, 2007 we received your water right transfer application requesting place of use. The application was accompanied by \$600.00. The receipt # 91037 was previously sent.

By copy of this letter, we are asking the Watermaster for a report regarding the potential for injury to existing water rights which may be caused by the change.

Your application will be examined to determine if additional information is needed. You will be contacted following this examination.

We will notify you if additional information or corrections to the application or map are required.

Please disregard the previous acknowledgement letter.

If you have any questions, please call the Transfer Section, (503)986-0883.

Sincerely,

Sarah Henderson
Executive Support

cc: Watermaster # 11

enclosure



Oregon

Theodore R. Kulongoski, Governor

Water Resources Department

725 Summer Street NE, Suite A

Salem, OR 97301-1271

503-986-0900

FAX 503-986-0904

Notice of Application for Water Right Transfer, Temporary Transfer, or Permit Amendment 01/08/2008

The Department seeks comment on the recently-filed application listed below. Any person may comment on the application. Comments must be received by the Department within 30 days of the date of this notice. The Director may presume that the transfer would be allowed by, and compatible with comprehensive plans unless an affected local government informs the Director otherwise within 30 days of this notice.

County: DESCHUTES
Transfer: 10510
Water Right: CERT 83571, 76358, 76714
Priority Date: 1900, 1907
Name: CENTRAL OREGON IRRIGATION DISTRICT
Address: 1055 SW LAKE CT REDMOND OR 97756
Change: POU
Source: DESCHUTES RIVER/CRAVE PRAIRIE RESERVOIR
Authorized POU: T18S R13E 6
T18S R12E 4
T17S R14E 15, 22, 23
T17S R13E 33
T16S R14E 8, 16
T16S R12E 1
Proposed POU: T18S R13E 6
T17S R14E 15
T17S R13E 33
T17S R12E 24
T16S R14E 8, 17
T16S R12E 1
T15S R14E 35

The holder of a water right may apply to permanently change an existing water use subject to transfer. A transfer application may involve any of the following changes: Point of diversion or appropriation (POD; POA); Additional point of diversion or appropriation (APOD; APOA); Historic POD (HIST); Place of use (POU); Character of use (USE); Instream (ISWR); Substitution (SUB); or Exchange (EXCH).

The holder of a water right subject to transfer may request to temporarily change the place of use of the water for up to 5 years and, if necessary to convey the water, to temporarily change the point of diversion or appropriation.

The holder of a water right permit may apply to change a point of diversion (POD) or appropriation (POA) or to change the place of use (POU).

Any person who provides comments within the comment period will receive a copy of the Department's preliminary determination of whether the application should be approved or rejected after the Department has completed a review of the application and will be provided an opportunity to protest the application and preliminary determination at that time. Comments should be sent to the Transfers Section at the Department's Salem office.

State of Oregon
WATER RESOURCES DEPARTMENT
DISTRICT PETITION FOR PERMANENT TRANSFER
(ORS 540.580)
PETITION YEAR AND NUMBER P-2007-006

DISTRICT CENTRAL OREGON IRRIGATION DISTRICT

ADDRESS 1055 SW Lake Ct.

REDMOND, OR 97756 PHONE 541-548-6047 (fax 541-548-0243)

1. WATER RIGHT

1958 Deschutes Consolidated Decree- Deschutes River

Certificate # 76358 & 76714 – Rate: 1 cfs = 32.40 acres

Priority date: October 31, 1900 and December 2, 1907

Source: Deschutes River & Crane Prairie Reservoir

2. TYPE OF CHANGE: PERMANENT CHANGE IN PLACE OF USE

3. LOCATION OF AUTHORIZED PLACE OF USE: (PRESENT USER)

No	Name	Legal Description Township South, Range East, W.M.	Tax Lot #	Acres	Use	District Notice #
		SEE EXHIBIT "A"				
		Total "OFF" acres		7.36		

4. LOCATION OF PROPOSED PLACE OF USE: (PROPOSED USER)

No	Name	Legal Description Township South, Range East, W.M.	Tax Lot #	Acres	Use	District Notice #
		SEE EXHIBIT "B"				
		Total "ON" acres		7.36		

5 ITEMS ATTACHED:

1. MAPS REPRESENTING "OFF" LANDS AND PROPOSED "ON" LANDS.


2. DISTRICT BOUNDARIES

Description & map already on file with OWRD's office in Salem and Bend.

3. FEES: \$ 600 IS ATTACHED TO THIS PETITION FOR FILING AND RECORDING

A notarized statement from all landowners affected in this petition is on file in the District's office authorizing the changes.

The District (PETITIONER) hereby certifies that the maps and petition are accurate to the best of our knowledge and that the water rights referenced in this application have either been used within the last 5 years, or are not subject to forfeiture.

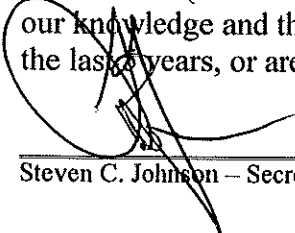
Steven C. Johnson – Secretary Manager

Date

18 Dec. 2007

RECEIVED

24 2007

T 10510

WATER RESOURCES DEP
SALEM, OREGON

TABLE 1. - AUTHORIZED PLACE OF USE

Cert/Decree	Cert/Perm	TRANSFER NBR	POD	USE	TWP	RNG	SEC	QQ	LOT	ACRES	USER NAME
PRIMARY	SUPP										
76358	76714	T-2007-023	#1	IRRIG	18	13	06	NENE	00100	1.400	Tuma, Ben/Shelley
83571	76714	T-2007-026	#1	IRRIG	17	13	33	SWNW	01106	0.150	Waits, Ronald/Michelle
83571	76714	T-2007-027	#11	IRRIG	16	12	01	NESE	00200	0.010	Wallace, Mary Sue
83571	76714	T-2007-027	#11	IRRIG	16	12	01	SENE	00200	0.250	Wallace, Mary Sue
83571	76714	T-2007-028	#1	IRRIG	16	14	16	NWSW	00201	2.600	Bovee, Alan/Margaret
83571	76714	T-2007-029	#1	IRRIG	17	14	23	SWSE	01200	0.500	COID/Quitclaim
83571	76714	T-2007-029	#1	IRRIG	17	14	22	NESE	00801	0.200	COID/Quitclaim
83571	76714	T-2007-029	#1	IRRIG	18	12	04	SESW	00600	0.300	COID/Quitclaim
83571	76714	T-2007-030	#1	IRRIG	17	14	15	SENE	00500	0.350	Bean, Darcy
83571	76714	T-2007-034	#1	IRRIG	16	14	08	SESE	00101	1.200	Schinkel Family Revocable Living Trust
83571	76714	T-2007-034	#1	IRRIG	16	14	08	SESE	00101	0.400	Schinkel Family Revocable Living Trust

7.36

999

T 10510

0.7

RECEIVED
DEC 24 2007
WATER RESOURCES DEPT
SALEM, OREGON

TABLE 2. - PROPOSED PLACE OF USE

Cert/Decree	Cert/Perm	TRANSFER NBR	POD	USE	TWP	RNG	SEC	QQ	LOT	ACRES	USER NAME
PRIMARY	SUPP										
76358	76714	T-2007-023	#1	IRRIG	18	13	06	NENE 11	00101	1.400	Tuma, Ben/Shelley
83571	76714	T-2007-026	#1	IRRIG	17	13	33	SWNW 9	01106	0.150	Waits, Ronald/Michelle
83571	76714	T-2007-027	#11	IRRIG	16	12	01	SENE 2	00200	0.010	Wallace, Mary Sue
83571	76714	T-2007-027	#11	IRRIG	16	12	01	SENE 3	00200	0.250	Wallace, Mary Sue
83571	76714	T-2007-028	#1	IRRIG	15	14	35	NWSW 1	00400	2.600	Powell Butte Farmers Club, Inc
83571	76714	T-2007-029	#1	IRRIG	17	12	24	SESE 6	01500	0.500	Monson, Robert/Esther
83571	76714	T-2007-029	#1	IRRIG	17	12	24	SESE 7	01500	0.200	Monson, Robert/Esther
83571	76714	T-2007-029	#1	IRRIG	17	12	24	SESE 8	01500	0.300	Monson, Robert/Esther
83571	76714	T-2007-030	#1	IRRIG	17	14	15	SENE 10	00500	0.350	Bean, Darcy
83571	76714	T-2007-034	#1	IRRIG	16	14	08	SESE 4	00101	1.200	Schinkel Family Revocable Living Trust
83571	76714	T-2007-034	#1	IRRIG	16	14	17	NENE 5	00100	0.400	Schinkel Family Revocable Living Trust

7.36 3.70

-36 on 76714

?

T 10510

RECEIVED
DEC 24 2007
WATER RESOURCES DEPT
SALEM, OREGON


DESCHUTES COUNTY SEC.01 T16S R12E

SCALE - 1" = 400'



SE 1/4 OF THE NE 1/4; NE 1/4 OF THE SE 1/4

DISTRICT INTERNAL
NOTICE #: T-2007-027

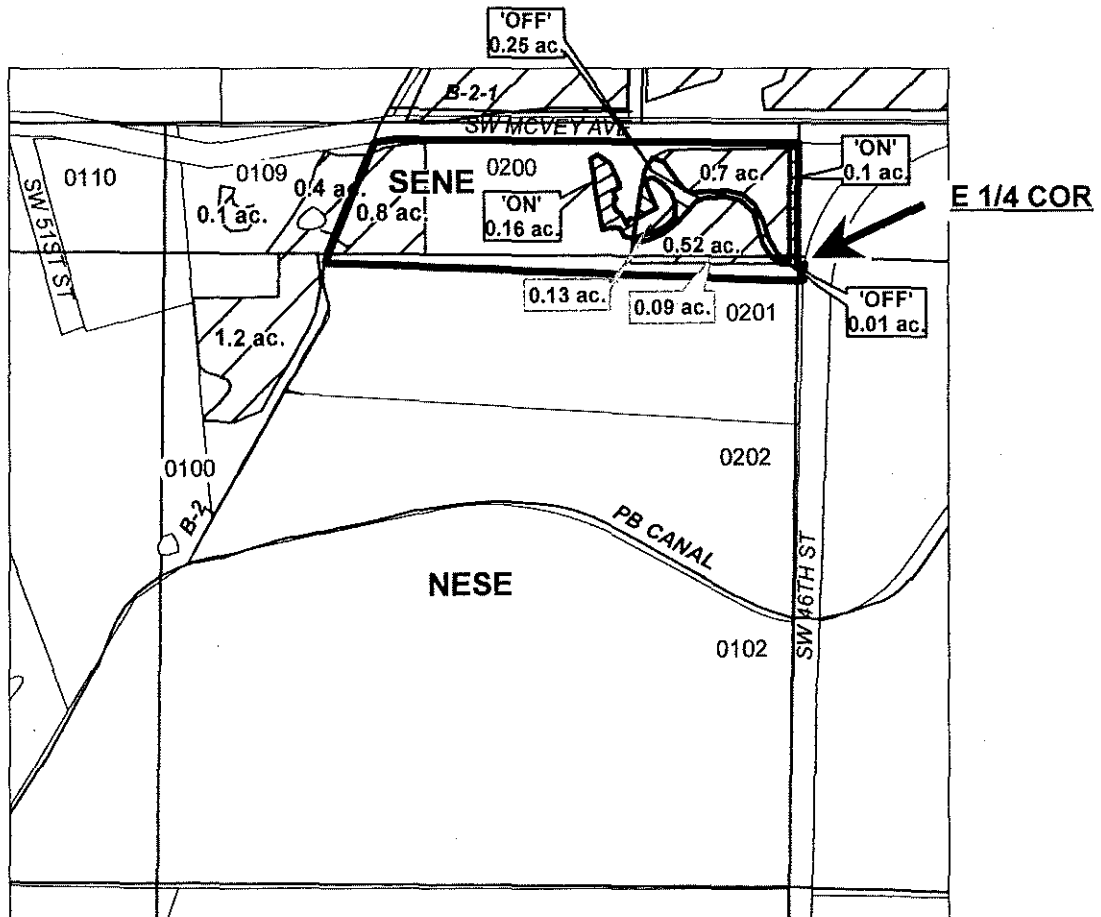

RECEIVED

DEC 24 2007

WATER RESOURCES DEPT
SALEM, OREGON

"OFF" / "ON" MAP

APPLICATION FOR WATER RIGHTS TRANSFER
MARGARET J. WALLACE,
TRUSTEE OF THE W.F. WALLACE MARTIAL Q-TIP TRUST

TAXLOT #: 200 T 10510

0.26 ACRES

DATE: 09-26-07

FILE: E:\TRANSFER\WRTRANS07\WALLACE.PDF

CENTRAL OREGON



IRRIGATION DISTRICT


DESCHUTES COUNTY SEC.06 T18S R13E

SCALE - 1" = 400'



NE 1/4 OF THE NE 1/4

DISTRICT INTERNAL
NOTICE #: T-2007-023

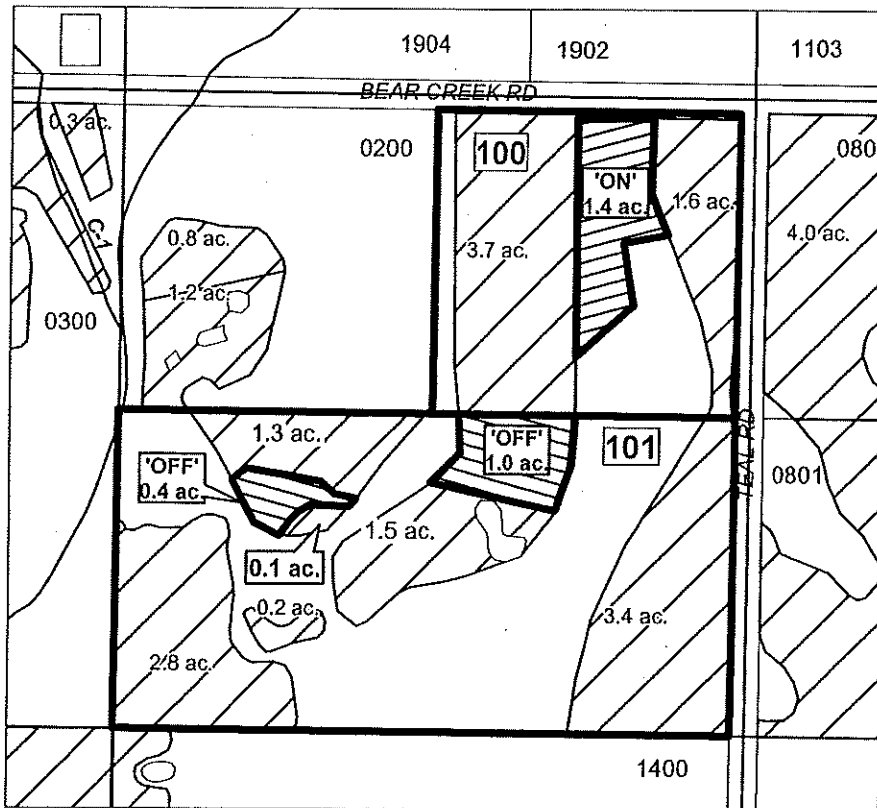

RECEIVED

DEC 24 2007

WATER RESOURCES DEPT
SALEM, OREGON

	EXISTING WATER RIGHTS
	OFF LANDS
	ON LANDS

"OFF" / "ON" MAP



APPLICATION FOR WATER RIGHTS TRANSFER

BEN F. & SHELLEY L. TUMA/ BEN F. & SHELLEY L. TUMA

TAXLOT #: 100, 101, 10510

1.4 ACRES

DATE: 08-02-07

FILE: E:\TRANSFER\WR\TRANS07\TUMA.PDF


DESCHUTES COUNTY SEC.04 T18S R12E

SCALE - 1" = 400'



SE 1/4 OF THE SW 1/4

DISTRICT INTERNAL
NOTICE #: T-2007-029

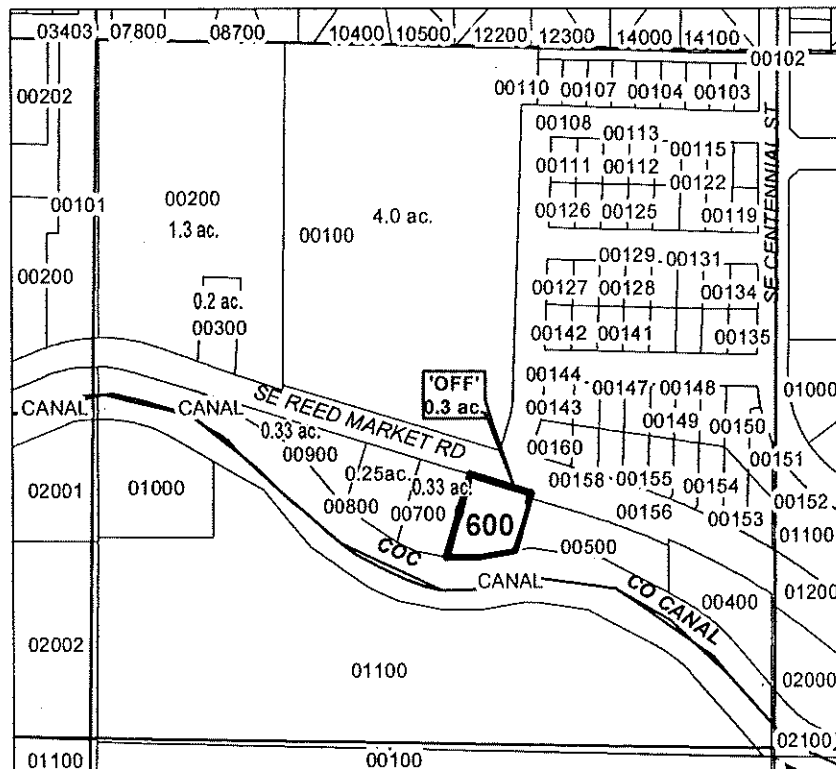


S 1/4 COR

RECEIVED

DEC 24 2007

WATER RESOURCES DEPT
SALEM, OREGON

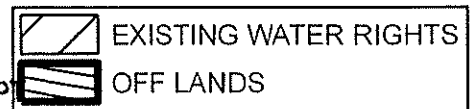

"OFF" MAP



APPLICATION FOR WATER RIGHTS TRANSFER

COID / ROBERT W. & ESTHER A. MONSON

TAXLOT #: 600

T 10510

0.3 ACRES

DATE: 10-16-07

FILE: E:\TRANSFER\WRTRANS07\COID_181204_600


DESCHUTES COUNTY SEC.23 T17S R14E

SCALE - 1" = 400'



SW 1/4 OF THE SE 1/4

DISTRICT INTERNAL
NOTICE #: T-2007-029

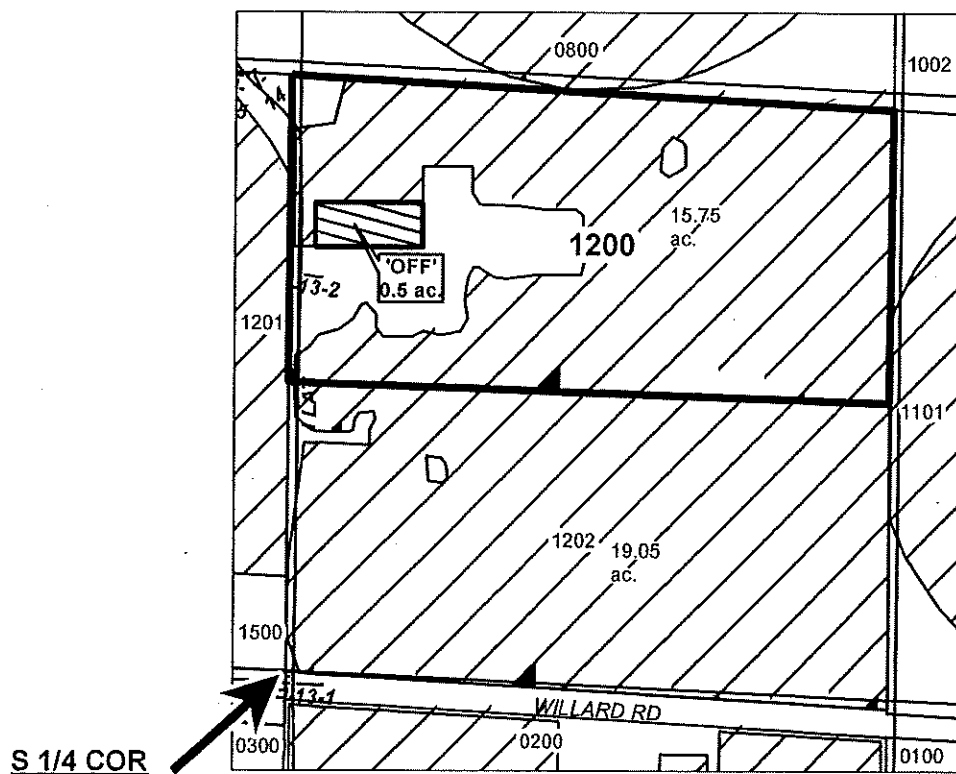


RECEIVED

DEC 24 2007

WATER RESOURCES DEPT
SALEM, OREGON

"OFF" MAP

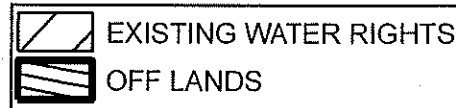

APPLICATION FOR WATER RIGHTS TRANSFER

COID / ROBERT W. & ESTHER A. MONSON

TAXLOT #: 1200

0.5 ACRES

DATE: 10-16-07

FILE: E:\TRANSFER\WRTRANS\07\COID_171423_1200

T 10510


**DESCHUTES COUNTY
SEC.22 T17S R14E**

SCALE - 1" = 400'



NE 1/4 OF THE SE 1/4

DISTRICT INTERNAL
NOTICE #: T-2007-029

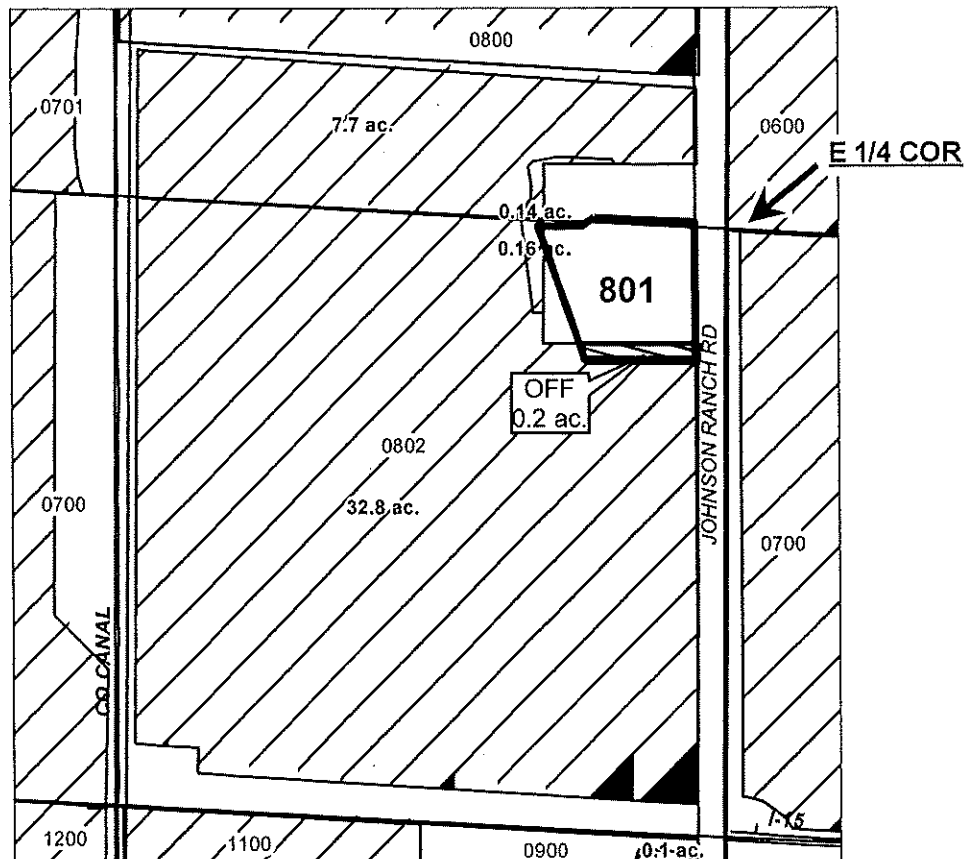


RECEIVED

DEC 24 2007

WATER RESOURCES DEPT
SALEM, OREGON

OFF MAP

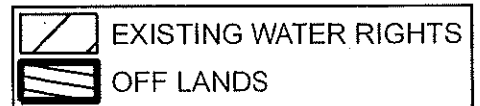

APPLICATION FOR WATER RIGHTS TRANSFER

COID / ROBERT W. & ESTHER A. MONSON

TAXLOT #: 801

0.2 ACRES

DATE: 10-16-07

FILE: E:\TRANSFER\WTRANS07\COID_171422_801

T 10510


DESCHUTES COUNTY SEC.15 T17S R14E

SCALE - 1" = 400'



SE 1/4 OF THE NE 1/4

DISTRICT INTERNAL
NOTICE #: T-2007-030

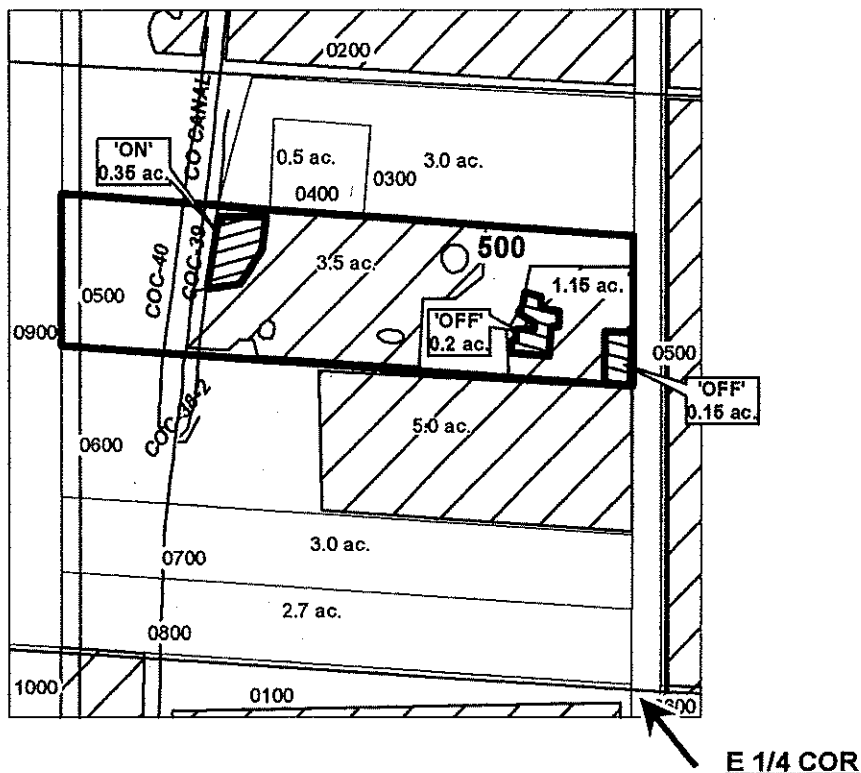

	EXISTING WATER RIGHTS
	OFF LANDS
	ON LANDS
	PARCELS W/ WATER RIGHTS

"OFF / ON" MAP



APPLICATION FOR WATER RIGHTS TRANSFER

DARCY BEAN & JAMES HOLLANDER / DARCY BEAN & JAMES HOLLANDER

TAXLOT #: 500

0.35 ACRES

RECEIVED

DATE: 11-05-07

FILE: E:\TRANSFER\WR\TRANS07\HOLLANDER

DEC 24 2007

WATER RESOURCES DEPT T 10510
SALEM, OREGON


DESCHUTES COUNTY SEC.33 T17S R13E

SCALE - 1" = 400'



SW 1/4 OF THE NW 1/4

DISTRICT INTERNAL
NOTICE #: T-2007-026

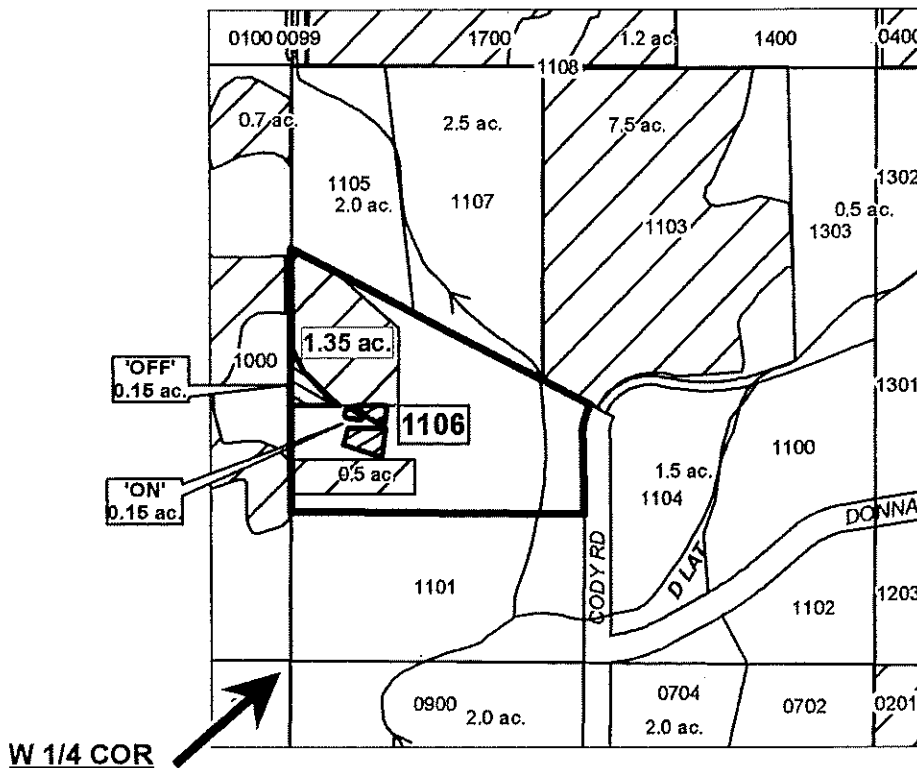

	EXISTING WATER RIGHTS
	OFF LANDS
	ON LANDS
	PARCELS W/ WATER RIGHTS

"OFF/ON " MAP



APPLICATION FOR WATER RIGHTS TRANSFER

RONALD L. & MICHELLE A. WAITS / RONALD L. & MICHELLE A. WAITS

TAXLOT #: 1106

DATE: 09-25-07

RECEIVED

0.15 ACRES

FILE: E:\TRANSFER\WR\TRANS07\WAITS.PDF

DEC 24 2007

WATER RESOURCES DEPT
SALEM, OREGON

T 10510


**CROOK COUNTY
SEC.16 T16S R14E**

SCALE - 1" = 400'



NW 1/4 OF THE SW 1/4

DISTRICT INTERNAL
NOTICE #: T-2007-028

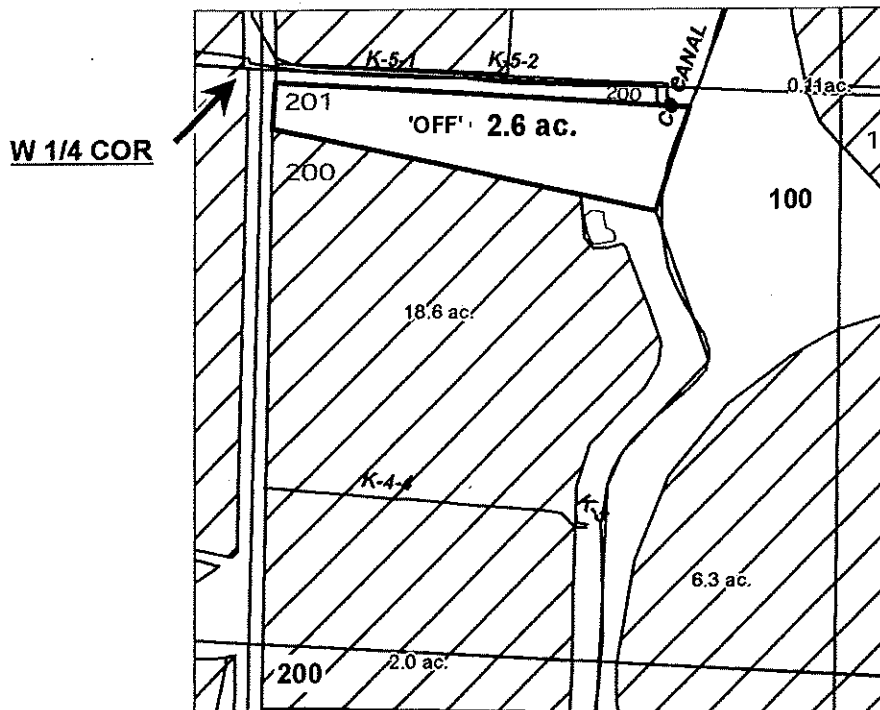

"OFF" MAP



APPLICATION FOR WATER RIGHTS TRANSFER
ALAN F. & MARGARET M. BOVEE / POWELL BUTTE FARMERS CLUB

TAXLOT #: 201

RECEIVED

2.6 ACRES

DATE: 10-02-07

DEC 24 2007

FILE: E:\TRANSFER\WRTRANS07\BOVEE.PDF

WATER RESOURCES DEPT
SALEM, OREGON

T 10510


CROOK COUNTY SEC.08 & 17 T16S R14E

SCALE - 1" = 400'



SE 1/4 OF THE SE 1/4; NE 1/4 OF THE NE 1/4

DISTRICT INTERNAL
NOTICE #: T-2007-034

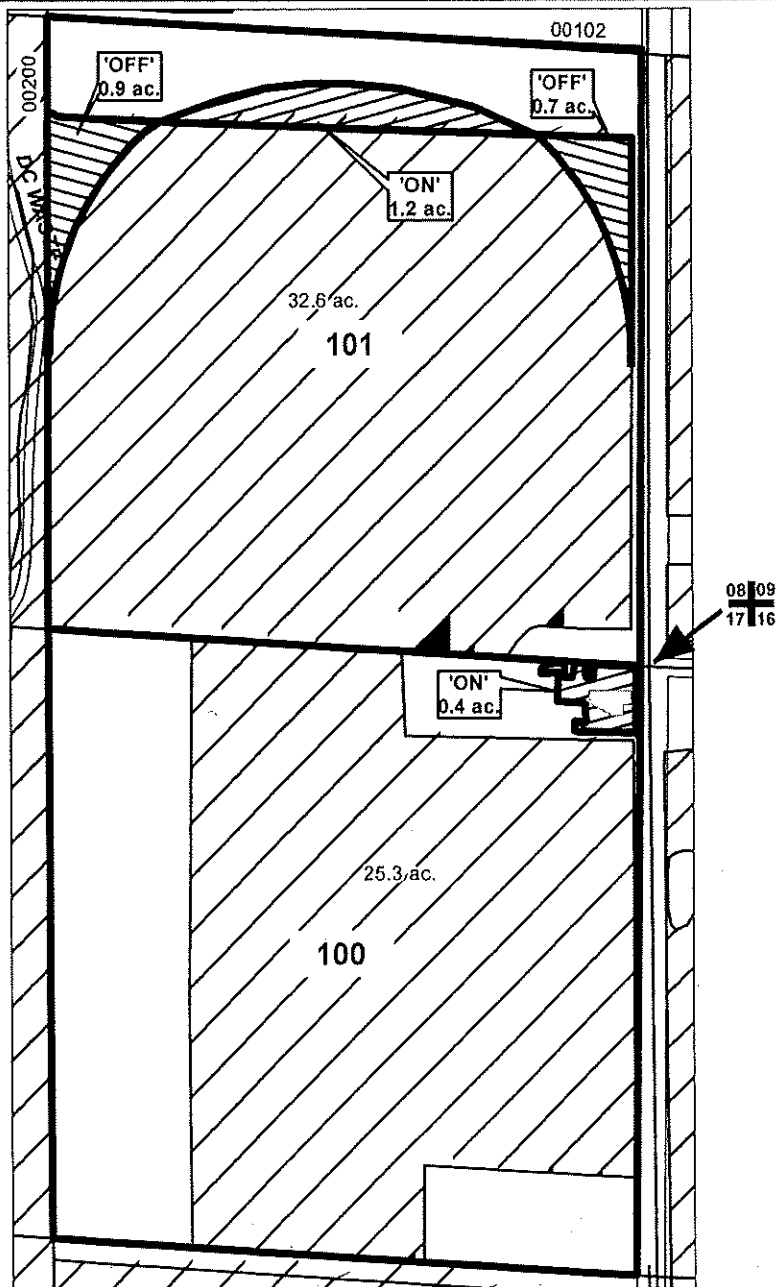

"OFF / ON" MAP

	EXISTING WATER RIGHTS
	OFF LANDS
	ON LANDS



APPLICATION FOR WATER RIGHTS TRANSFER
SCHINKEL FAMILY REVOCABLE TRUST

TAXLOT #:101 & 100

DATE: 11-28-07

T 10510

FILE: E:\TRANSFER\WR\TRANS07\SCHINKEL

1.5 ACRES

RECEIVED

DEC 24 2007

WATER RESOURCES DEP
SALEM, OREGON


DESCHUTES COUNTY SEC.01 T16S R12E

SCALE - 1" = 400'



SE 1/4 OF THE NE 1/4; NE 1/4 OF THE SE 1/4

DISTRICT INTERNAL
NOTICE #: T-2007-027

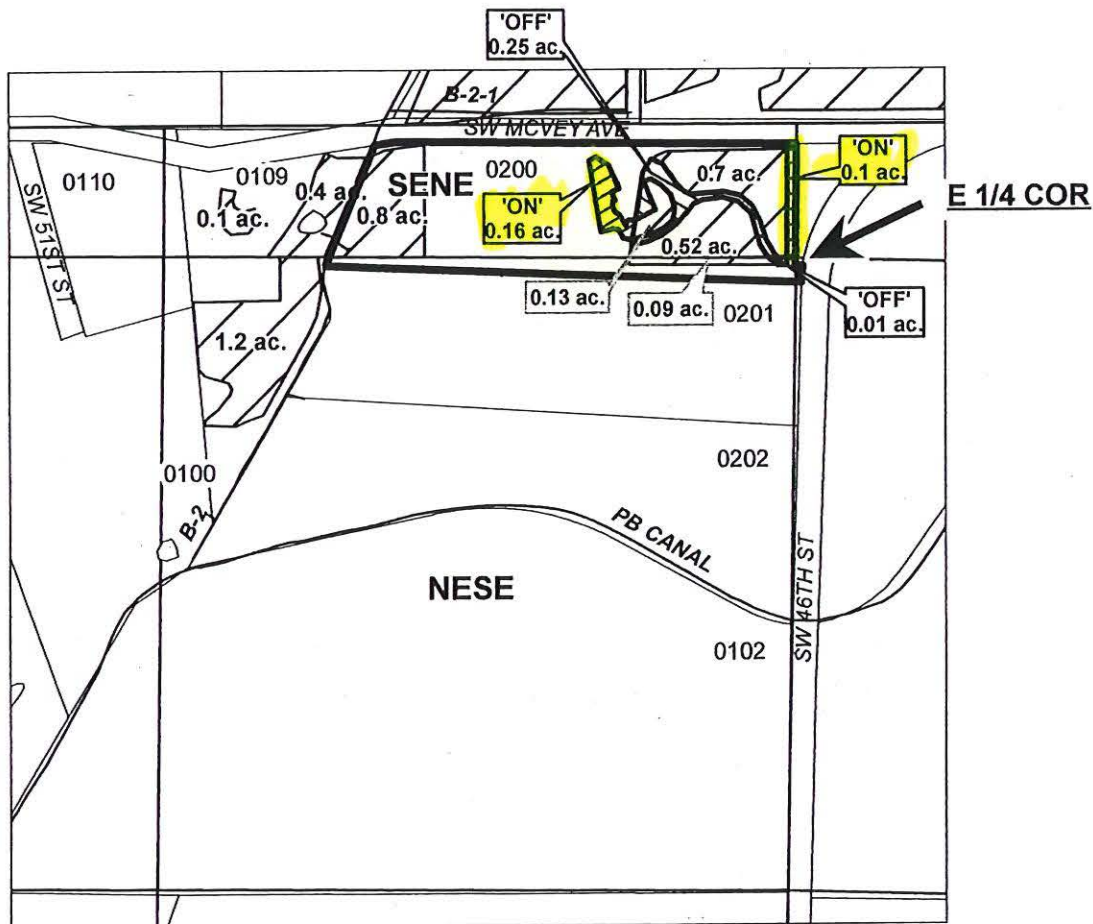

RECEIVED

DEC 24 2007

WATER RESOURCES DEPT
SALEM, OREGON

"OFF" / "ON" MAP

APPLICATION FOR WATER RIGHTS TRANSFER

MARGARET J. WALLACE,
TRUSTEE OF THE W.F. WALLACE MARTIAL Q-TIP TRUST

TAXLOT #: 200

T 10510

0.26 ACRES

DATE: 09-26-07

FILE: E:\TRANSFER\WRTRANS07\WALLACE.PDF

CENTRAL OREGON



IRRIGATION DISTRICT


**CROOK COUNTY
SEC.35 T15S R14E**

SCALE - 1" = 400'



NW 1/4 OF THE SW 1/4

DISTRICT INTERNAL
NOTICE #: T-2007-028

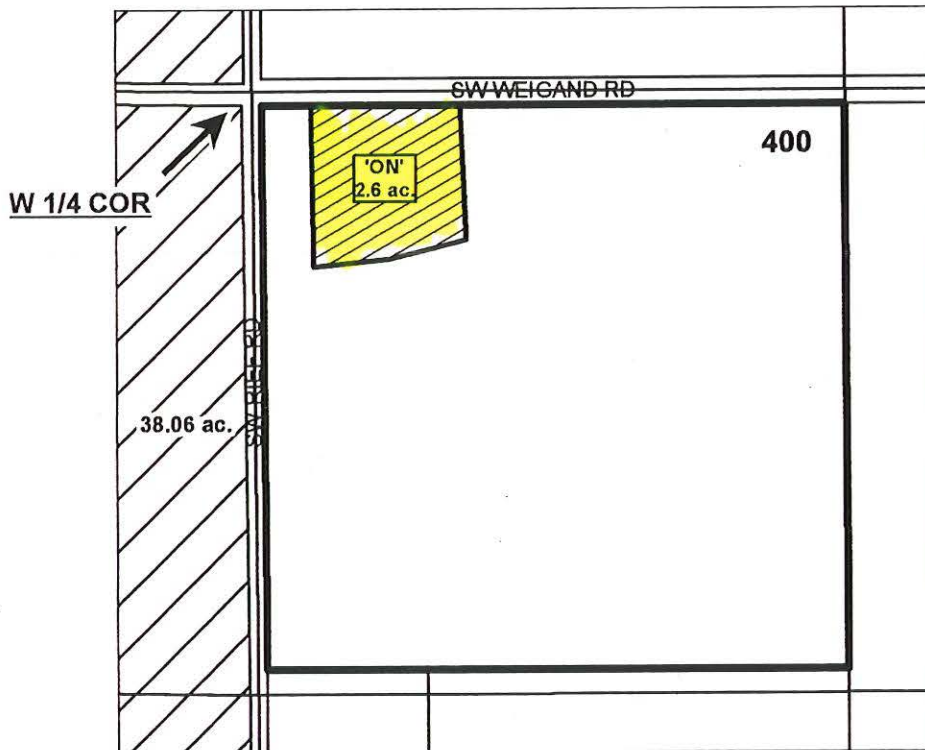


RECEIVED

DEC 24 2007

WATER RESOURCES DEPT
SALEM, OREGON

"ON" MAP

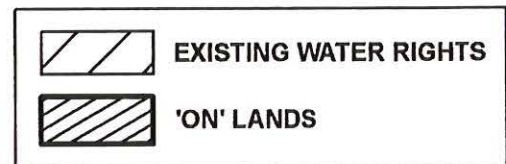

APPLICATION FOR WATER RIGHTS TRANSFER

ALAN F. & MARGARET M. BOVEE / POWELL BUTTE FARMERS CLUB

TAXLOT #: 400

2.6 ACRES

DATE: 10-02-07

FILE: E:\TRANSFER\WR\TRANS07\PB_FARMERS.PDF

T 10510


DESCHUTES COUNTY SEC.33 T17S R13E

SCALE - 1" = 400'



SW 1/4 OF THE NW 1/4

DISTRICT INTERNAL
NOTICE # T-2007-026

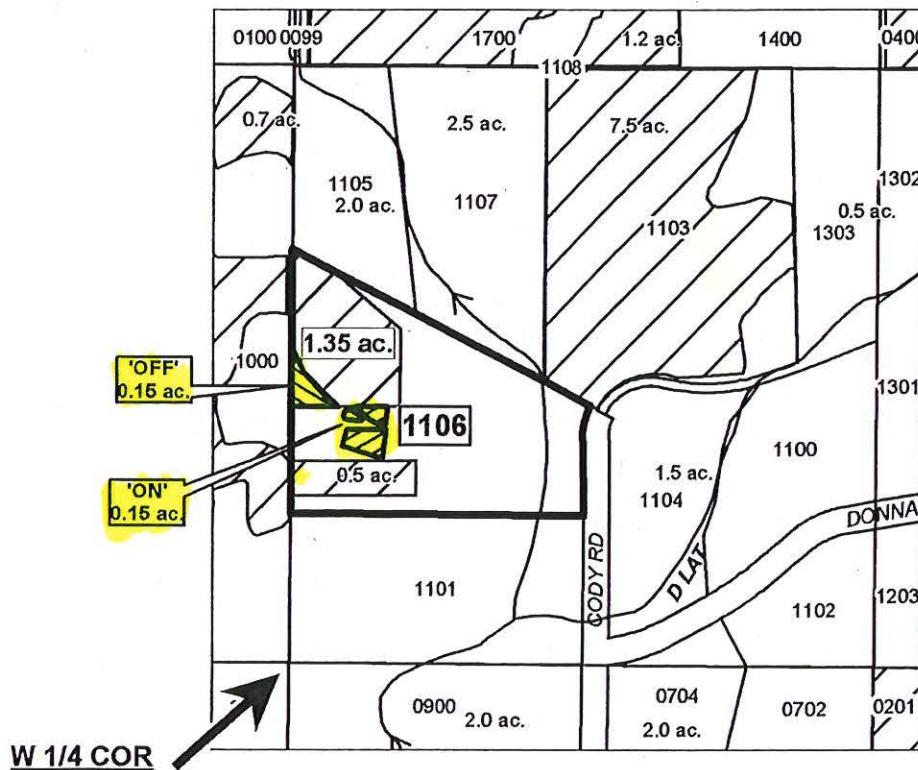

	EXISTING WATER RIGHTS
	OFF LANDS
	ON LANDS
	PARCELS W/ WATER RIGHTS

"OFF/ON " MAP



APPLICATION FOR WATER RIGHTS TRANSFER

RONALD L. & MICHELLE A. WAITS / RONALD L. & MICHELLE A. WAITS

TAXLOT #: 1106

0.15 ACRES

DATE: 09-25-07

FILE: E:\TRANSFER\WR\TRANS07\WAITS.RDF

RECEIVED

T 10510

DEC 24 2007
WATER RESOURCES DEPT
SALEM, OREGON


DESCHUTES COUNTY SEC.15 T17S R14E

SCALE - 1" = 400'



SE 1/4 OF THE NE 1/4

DISTRICT INTERNAL
NOTICE #: T-2007-030

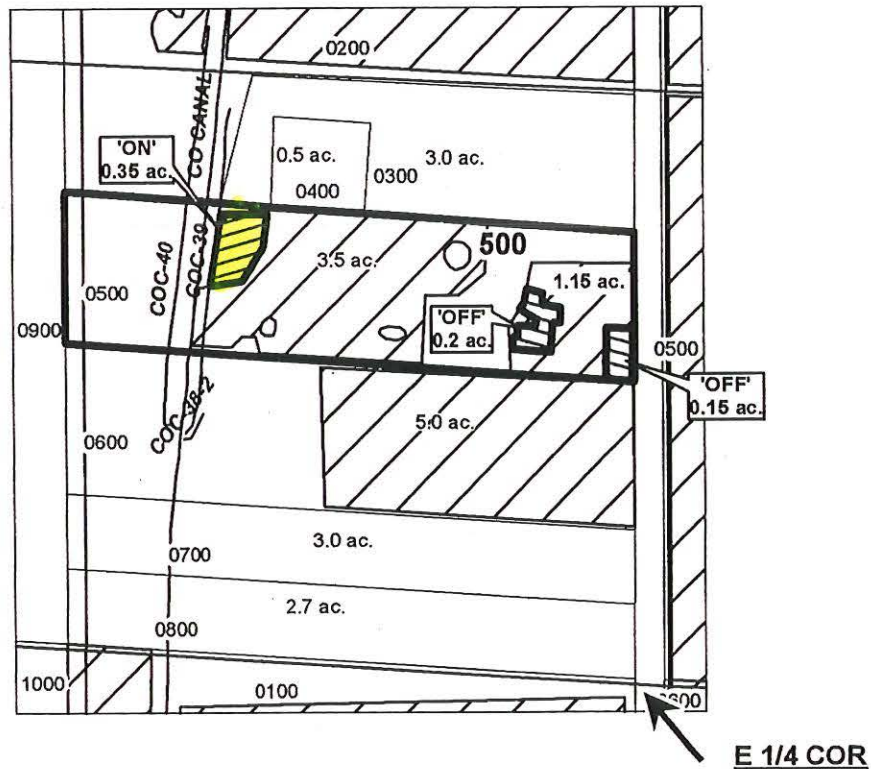

"OFF / ON" MAP

	EXISTING WATER RIGHTS
	OFF LANDS
	ON LANDS
	PARCELS W/ WATER RIGHTS



APPLICATION FOR WATER RIGHTS TRANSFER

DARCY BEAN & JAMES HOLLANDER / DARCY BEAN & JAMES HOLLANDER

TAXLOT #: 500

0.35 ACRES

DATE: 11-05-07

FILE E:\TRANSFER\WR\TRANS07\HOLLANDER

RECEIVED

DEC 24 2007

T 10510

WATER RESOURCES DEPT
SALEM, OREGON


DESCHUTES COUNTY SEC.24 T17S R12E

SCALE - 1" = 400'




SE 1/4 OF THE SE 1/4

DISTRICT INTERNAL
NOTICE #: T-2007-029

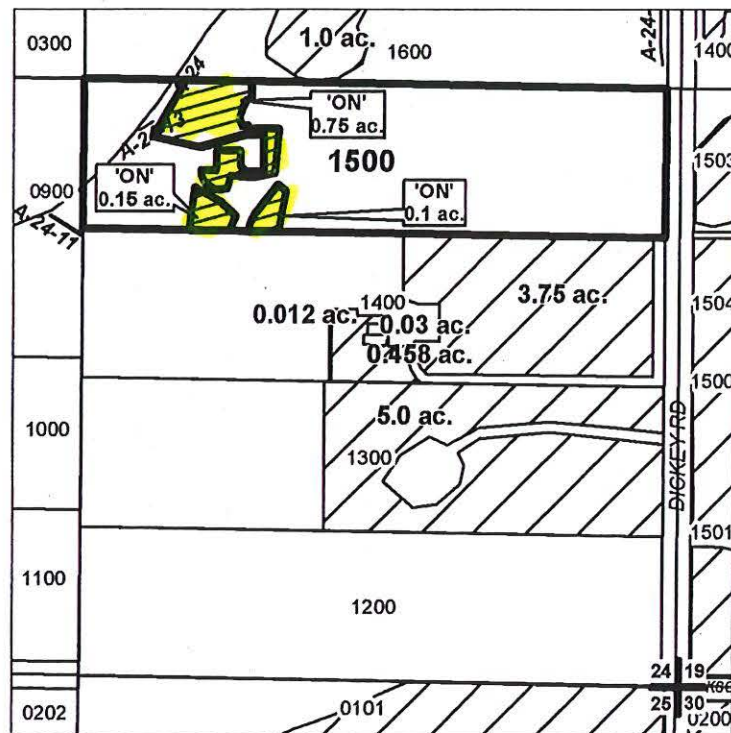

"ON" MAP

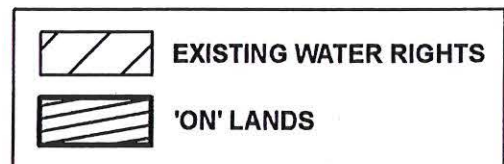

CENTRAL OREGON



IRRIGATION DISTRICT

APPLICATION FOR WATER RIGHTS TRANSFER

COID / ROBERT W. & ESTHER A. MONSON

TAXLOT #: 1500

1.0 ACRES

DATE: 12-13-07

FILE: E:\TRANSFER\WRTRANS07\MONSON

RECEIVED

DEC 24 2007

WATER RESOURCES DEPT
SALEM, OREGON

T 10510


CROOK COUNTY
SEC.08 & 17 T16S R14E

SCALE - 1" = 400'



SE 1/4 OF THE SE 1/4; NE 1/4 OF THE NE 1/4

DISTRICT INTERNAL
NOTICE #: T-2007-034

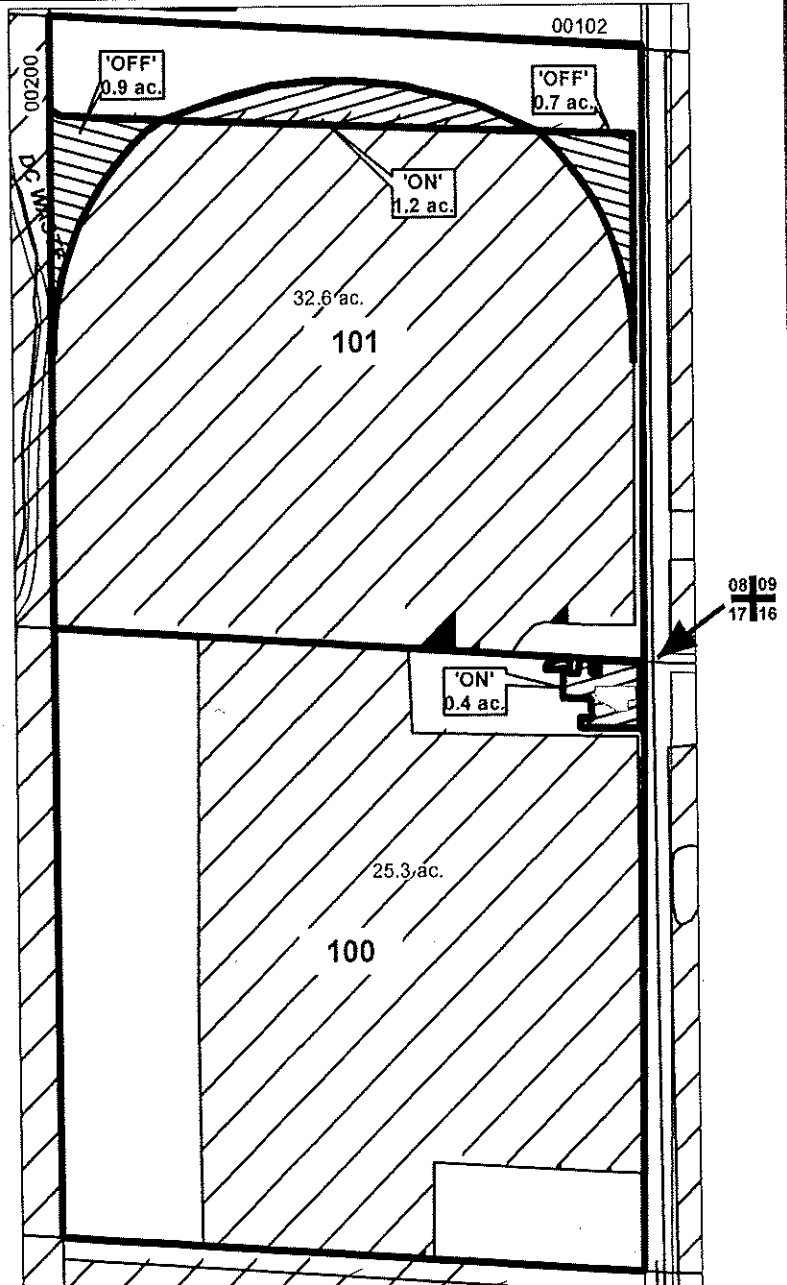

"OFF / ON" MAP

	EXISTING WATER RIGHTS
	OFF LANDS
	ON LANDS

CENTRAL OREGON



IRRIGATION DISTRICT

APPLICATION FOR WATER RIGHTS TRANSFER **RECEIVED**
SCHINKEL FAMILY REVOCABLE TRUST

DEC 24 2007

TAXLOT #:101 & 100

1.5 ACRES WATER RESOURCES DEPT
SALEM, OREGON

DATE: 11-28-07

T 10510

FILE: E:\TRANSFER\WR\TRANS07\SCHINKEL


DESCHUTES COUNTY SEC.06 T18S R13E

SCALE - 1" = 400'




NE 1/4 OF THE NE 1/4

DISTRICT INTERNAL
NOTICE #: T-2007-023

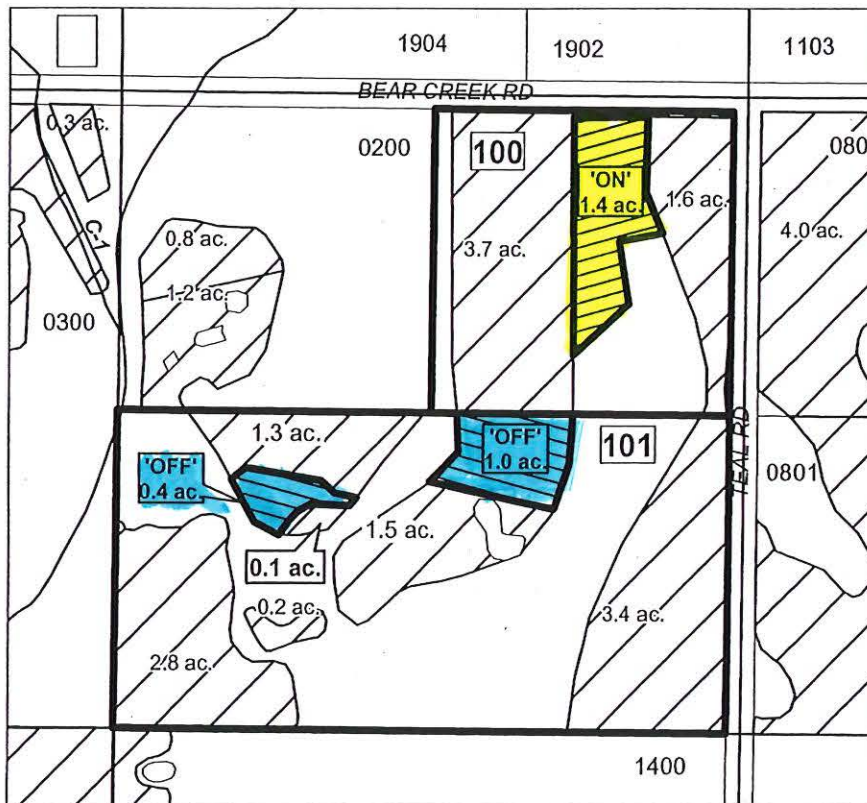

"OFF" / "ON" MAP

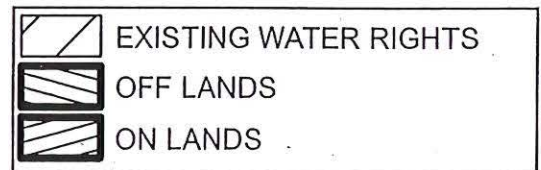

APPLICATION FOR WATER RIGHTS TRANSFER

BEN F. & SHELLEY L. TUMA/ BEN F. & SHELLEY L. TUMA

TAXLOT #: 100, 101

1.4 ACRES

DEC 24 2007

T 10510

DATE: 08-02-07

WATER RESOURCES DE
SALEM, OREGON

RECEIVED

FILE: E:\TRANSFER\WR\TRANS07\TUMA.BEN



CENTRAL OREGON IRRIGATION DISTRICT

1055 SW LAKE COURT, REDMOND, OR 97756

PHONE: 541.548.6047 FAX: 541.548.0243

www.coid.org

A MUNICIPAL CORPORATION OF THE STATE OF OREGON

December 21, 2007

Greg Nelson
Oregon Water Resources Department
725 Summer St N.E. Suite A
Salem, OR 97301-1271

RE: 580 Transfers
District transfer number 2007-006

Dear Greg,

Enclosed is a District 580 permanent transfer application along with our check #4827 for \$600.00.

Please let me know if you need any additional information or have any questions.

Thank you for your assistance!

Sincerely,

Leslie Clark
Water Transfer Specialist


Encl.

T 10510

RECEIVED

DEC 24 2007

WATER RESOURCES DEPT
SALEM, OREGON

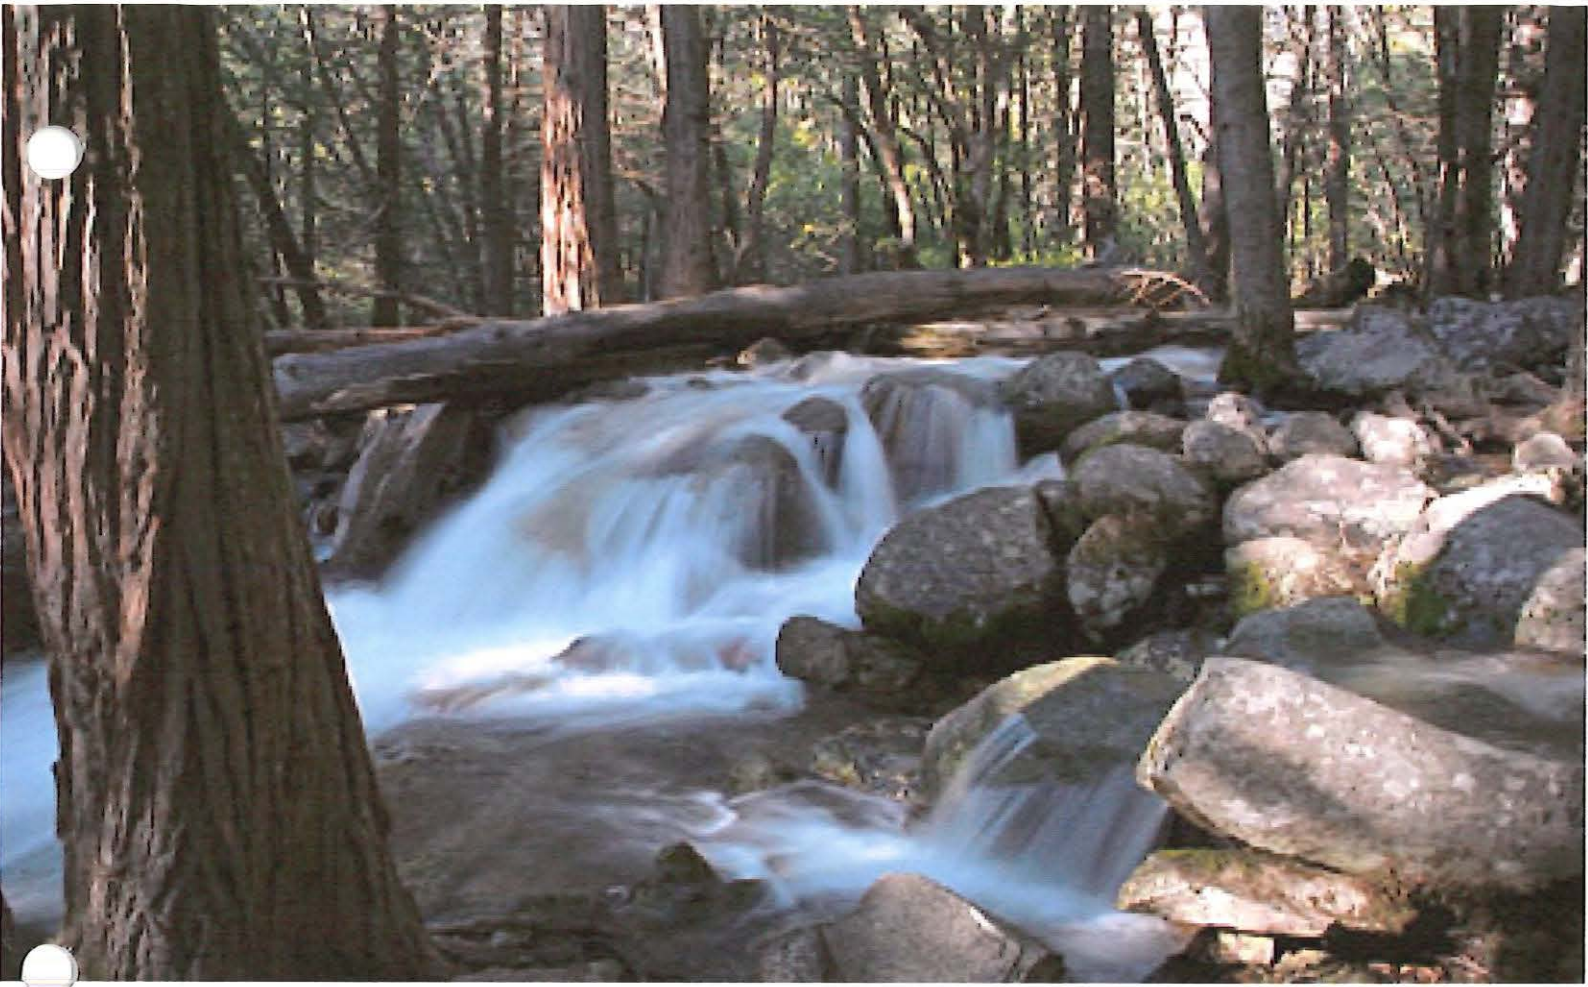

**CENTRAL OREGON IRRIGATION
DISTRICT**

PETITION 2007-006

DECEMBER FILING FOR 2007

PERMANENT 580 TRANSFERS

State of Oregon
WATER RESOURCES DEPARTMENT
DISTRICT PETITION FOR PERMANENT TRANSFER
(ORS 540.580)
PETITION YEAR AND NUMBER P-2007-006

DISTRICT CENTRAL OREGON IRRIGATION DISTRICT

ADDRESS 1055 SW Lake Ct.

REDMOND, OR 97756

PHONE

541-548-6047 (fax 541-548-0243)

1. WATER RIGHT

1958 Deschutes Consolidated Decree- Deschutes River

Certificate # 76358 & 76714 – Rate: 1 cfs = 32.40 acres

Priority date: October 31, 1900 and December 2, 1907

Source: Deschutes River & Crane Prairie Reservoir

2. TYPE OF CHANGE: PERMANENT CHANGE IN PLACE OF USE

3. LOCATION OF AUTHORIZED PLACE OF USE: (PRESENT USER)

No	Name	Legal Description Township South, Range East, W.M.	Tax Lot #	Acres	Use	District Notice #
		SEE EXHIBIT "A"				
		Total "OFF" acres		7.36		

4. LOCATION OF PROPOSED PLACE OF USE: (PROPOSED USER)

No	Name	Legal Description Township South, Range East, W.M.	Tax Lot #	Acres	Use	District Notice #
		SEE EXHIBIT "B"				
		Total "ON" acres		7.36		

5 ITEMS ATTACHED:

1. MAPS REPRESENTING "OFF" LANDS AND PROPOSED "ON" LANDS.


2. DISTRICT BOUNDARIES

Description & map already on file with OWRD's office in Salem and Bend.

3. FEES: \$ 600 IS ATTACHED TO THIS PETITION FOR FILING AND RECORDING

A notarized statement from all landowners affected in this petition is on file in the District's office authorizing the changes.

The District (PETITIONER) hereby certifies that the maps and petition are accurate to the best of our knowledge and that the water rights referenced in this application have either been used within the last 5 years, or are not subject to forfeiture.

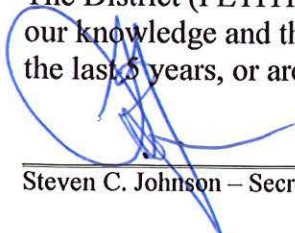
Steven C. Johnson – Secretary Manager

Date

18 Dec. 2007

RECEIVED

24 2007

T 10510

WATER RESOURCES DEPT
SALEM, OREGON

TABLE 1. - AUTHORIZED PLACE OF USE

Cert/Decree	Cert/Perm											
PRIMARY	SUPP	TRANSFER NBR	POD	USE	TWP	RNG	SEC	QQ	LOT	ACRES	USER NAME	
76358	76714	T-2007-023	#1	IRRIG	18	13	06	NENE ✓	00100	1.400	Tuma, Ben/Shelley	
83571	76714	T-2007-026	#1	IRRIG	17	13	33	SWNW ✓	01106	0.150	Waits, Ronald/Michelle	
83571	76714	T-2007-027	#11	IRRIG	16	12	01	NESE ✓	00200	0.010	Wallace, Mary Sue	
83571	76714	T-2007-027	#11	IRRIG	16	12	01	SENE ✓	00200	0.250	Wallace, Mary Sue	
83571	76714	T-2007-028	#1	IRRIG	16	14	16	NWSW ✓	00201	2.600	Bovee, Alan/Margaret	
83571		T-2007-029	#1	IRRIG	17	14	23	SWSE ✓	01200	0.500	COID/Quitclaim	
83571		T-2007-029	#1	IRRIG	17	14	22	NESE ✓	00801	0.200	COID/Quitclaim	
83571	76714	T-2007-029	#1	IRRIG	18	12	04	SESW ✓	00600	0.300	COID/Quitclaim	
83571	76714	T-2007-030	#1	IRRIG	17	14	15	SENE ✓	00500	0.350	Bean, Darcy	
83571	76714	T-2007-034	#1	IRRIG	16	14	08	SESE ✓	00101	1.200	Schinkel Family Revocable Living Trust	
83571	76714	T-2007-034	#1	IRRIG	16	14	08	SESE ✓	00101	0.400	Schinkel Family Revocable Living Trust	

T 10510

RECEIVED
 DEC 24 2007
 WATER RESOURCES DEPT
 SALEM, OREGON

TABLE 2. - PROPOSED PLACE OF USE

Cert/Decree	Cert/Perm										
PRIMARY	SUPP	TRANSFER NBR	POD	USE	TWP	RNG	SEC	QQ	LOT	ACRES	USER NAME
76358	76714	T-2007-023	#1	IRRIG	18	13	06	NENE	00101	1.400	Tuma, Ben/Shelley
83571	76714	T-2007-026	#1	IRRIG	17	13	33	SWNW	01106	0.150	Waits, Ronald/Michelle
83571	76714	T-2007-027	#11	IRRIG	16	12	01	SENE	00200	0.010	Wallace, Mary Sue
83571	76714	T-2007-027	#11	IRRIG	16	12	01	SENE	00200	0.250	Wallace, Mary Sue
83571		T-2007-028	#1	IRRIG	15	14	35	NWSW	00400	2.600	Powell Butte Farmers Club, Inc
83571		T-2007-029	#1	IRRIG	17	12	24	SESE	01500	0.500	Monson, Robert/Esther
83571		T-2007-029	#1	IRRIG	17	12	24	SESE	01500	0.200	Monson, Robert/Esther
83571		T-2007-029	#1	IRRIG	17	12	24	SESE	01500	0.300	Monson, Robert/Esther
83571	76714	T-2007-030	#1	IRRIG	17	14	15	SENE	00500	0.350	Bean, Darcy
83571	76714	T-2007-034	#1	IRRIG	16	14	08	SESE	00101	1.200	Schinkel Family Revocable Living Trust
83571	76714	T-2007-034	#1	IRRIG	16	14	17	NENE	00100	0.400	Schinkel Family Revocable Living Trust

T 10510

RECEIVED
 DEC 24 2007
 WATER RESOURCES DEPT
 SALEM, OREGON


DESCHUTES COUNTY SEC.01 T16S R12E

SCALE - 1" = 400'



SE 1/4 OF THE NE 1/4; NE 1/4 OF THE SE 1/4

DISTRICT INTERNAL
NOTICE #: T-2007-027

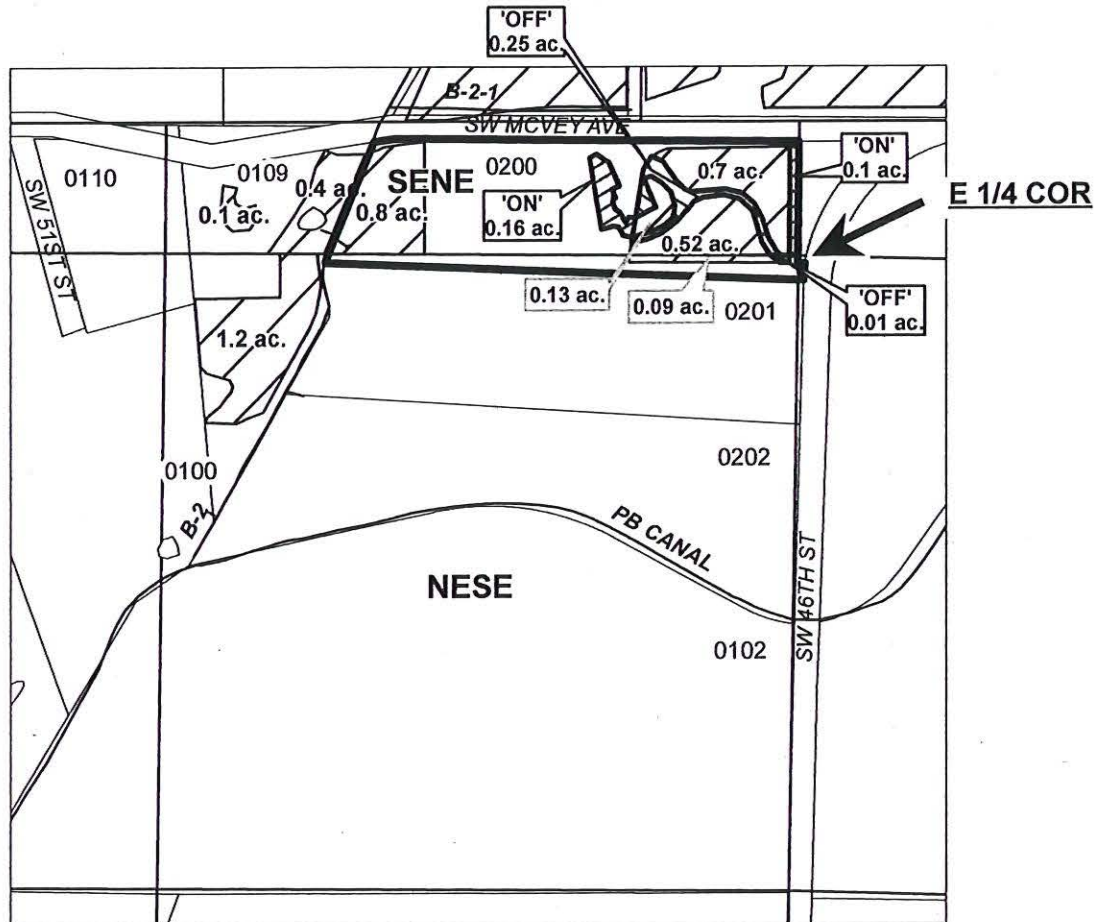

RECEIVED

DEC 24 2007

WATER RESOURCES DEPT
SALEM, OREGON

"OFF" / "ON" MAP



APPLICATION FOR WATER RIGHTS TRANSFER
MARGARET J. WALLACE,
TRUSTEE OF THE W.F. WALLACE MARTIAL Q-TIP TRUST

TAXLOT #: 200 T 10510

0.26 ACRES

DATE: 09-26-07

FILE: E:\TRANSFER\WRTRANS07\WALLACE.PDF


CROOK COUNTY SEC.08 & 17 T16S R14E

SCALE - 1" = 400'



SE 1/4 OF THE SE 1/4; NE 1/4 OF THE NE 1/4

DISTRICT INTERNAL
NOTICE #: T-2007-034

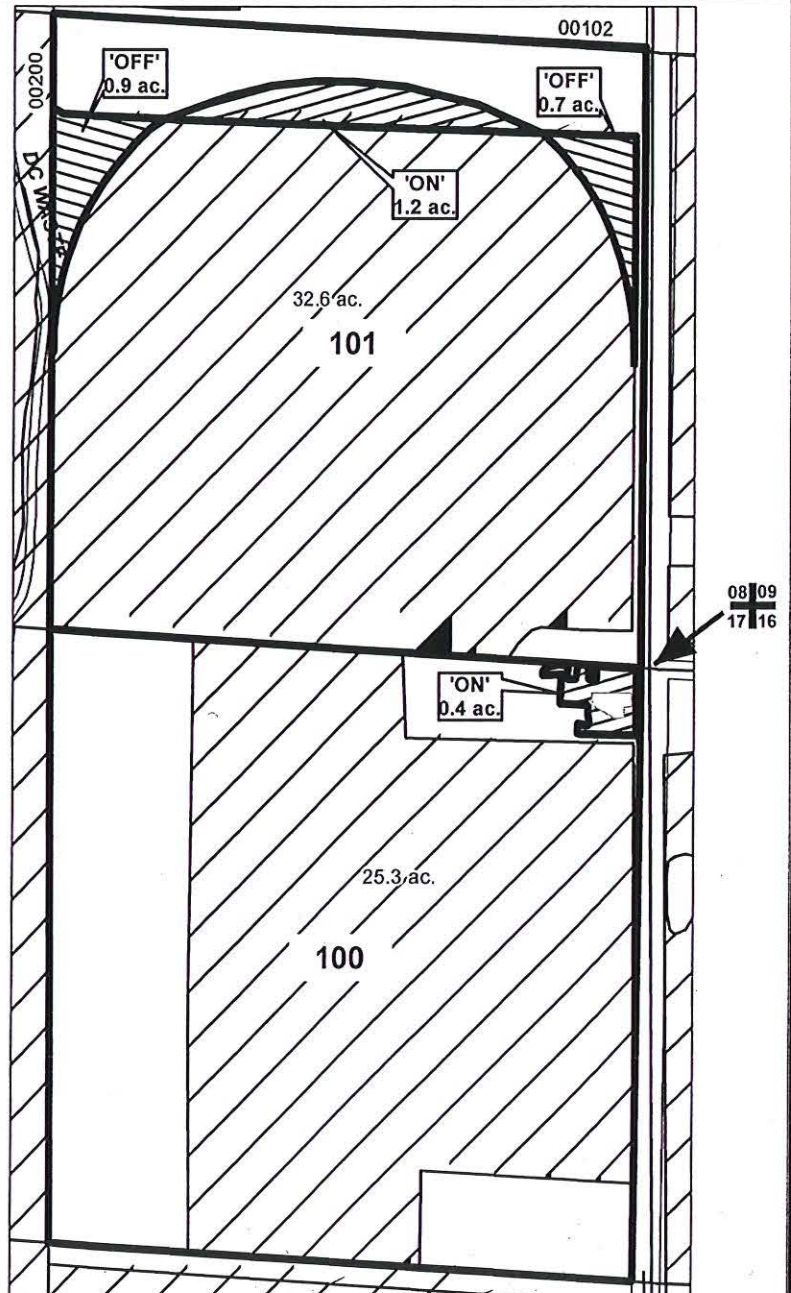

"OFF / ON" MAP

	EXISTING WATER RIGHTS
	OFF LANDS
	ON LANDS



APPLICATION FOR WATER RIGHTS TRANSFER
SCHINKEL FAMILY REVOCABLE TRUST

TAXLOT #:101 & 100

1.5 ACRES

DATE: 11-28-07

T 10510

FILE: E:\TRANSFER\WRTRANS07\SCHINKEL

RECEIVED

DEC 24 2007

WATER RESOURCES DEPT
SALEM, OREGON


**CROOK COUNTY
SEC.16 T16S R14E**

SCALE - 1" = 400'




NW 1/4 OF THE SW 1/4

DISTRICT INTERNAL
NOTICE #: T-2007-028

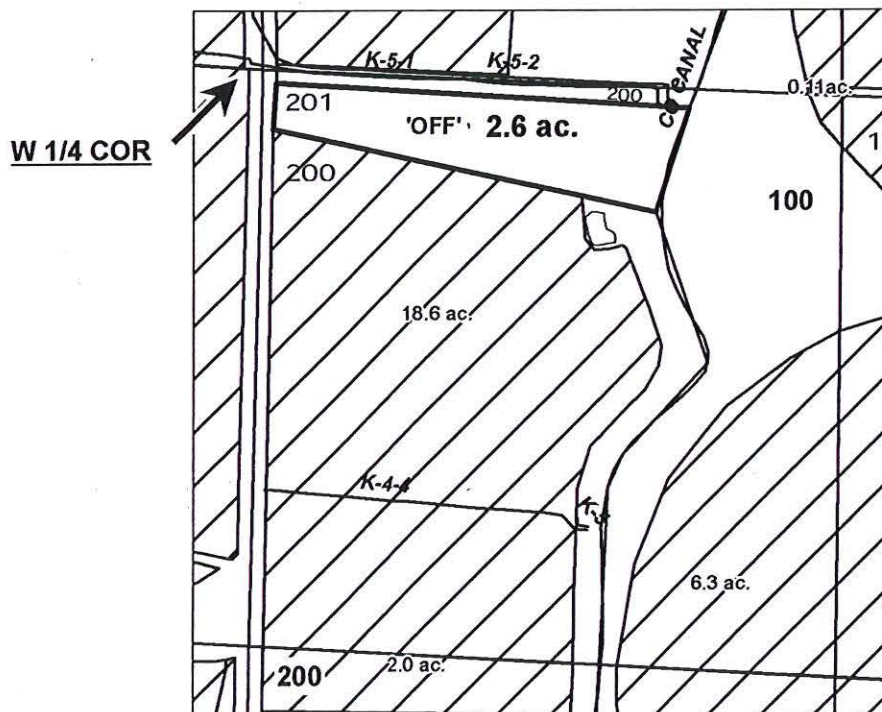

"OFF" MAP

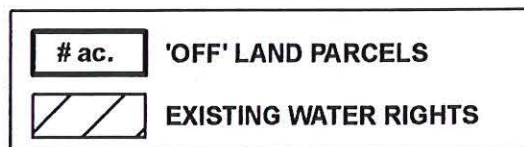

APPLICATION FOR WATER RIGHTS TRANSFER
ALAN F. & MARGARET M. BOVEE / POWELL BUTTE FARMERS CLUB

TAXLOT #: 201

RECEIVED

2.6 ACRES

DATE: 10-02-07

DEC 24 2007

FILE: E:\TRANSFER\WRTRANS07\BOVEE.PDF

WATER RESOURCES DEPT
SALEM, OREGON

T 10510


DESCHUTES COUNTY SEC.33 T17S R13E

SCALE - 1" = 400'



SW 1/4 OF THE NW 1/4

DISTRICT INTERNAL
NOTICE #: T-2007-026

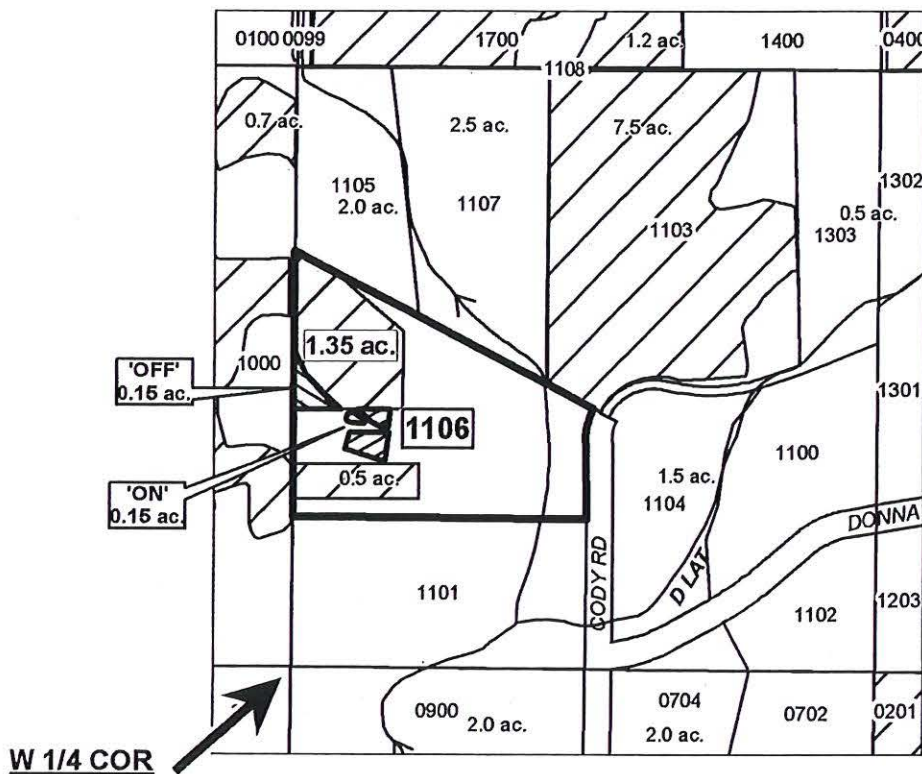

	EXISTING WATER RIGHTS
	OFF LANDS
	ON LANDS
	PARCELS W/ WATER RIGHTS

"OFF/ON " MAP



APPLICATION FOR WATER RIGHTS TRANSFER

RONALD L. & MICHELLE A. WAITS / RONALD L. & MICHELLE A. WAITS

TAXLOT #: 1106

DATE: 09-25-07

RECEIVED

0.15 ACRES

FILE: E:\TRANSFER\WRTRANS07\WAITS.PDF

DEC 24 2007
WATER RESOURCES DEPT
SALEM, OREGON

T 10510


DESCHUTES COUNTY SEC.15 T17S R14E

SCALE - 1" = 400'



SE 1/4 OF THE NE 1/4

DISTRICT INTERNAL
NOTICE #: T-2007-030

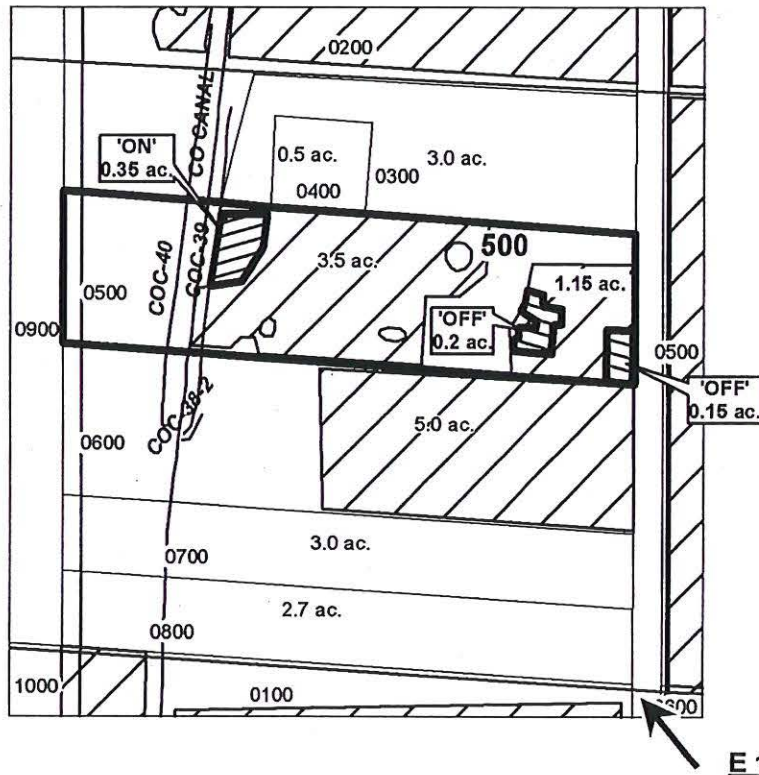

E 1/4 COR

"OFF / ON" MAP

	EXISTING WATER RIGHTS
	OFF LANDS
	ON LANDS
	PARCELS W/ WATER RIGHTS



APPLICATION FOR WATER RIGHTS TRANSFER

DARCY BEAN & JAMES HOLLANDER / DARCY BEAN & JAMES HOLLANDER

TAXLOT #: 500

0.35 ACRES

DATE: 11-05-07

RECEIVED

FILE E:\TRANSFER\WR\TRANS07\HOLLANDER

DEC 24 2007

WATER RESOURCES DEPT T 10510
SALEM, OREGON


DESCHUTES COUNTY
SEC.22 T17S R14E

SCALE - 1" = 400'



NE 1/4 OF THE SE 1/4

DISTRICT INTERNAL
NOTICE #: T-2007-029

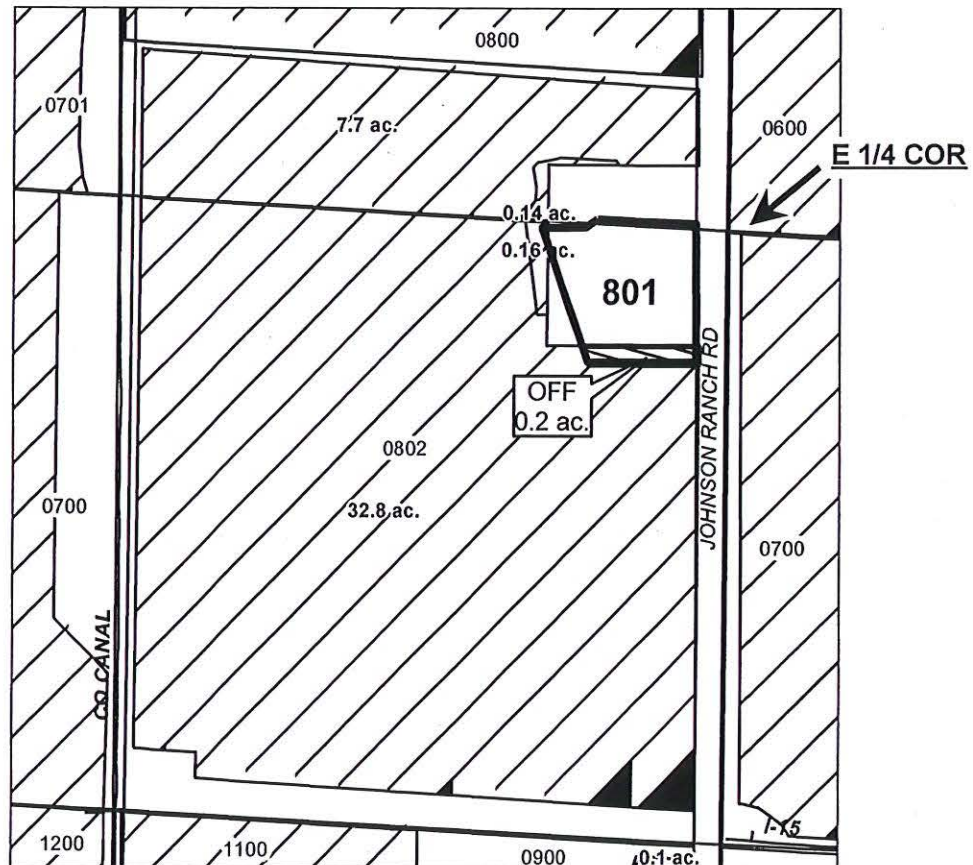


RECEIVED

DEC 24 2007

WATER RESOURCES DEPT
SALEM, OREGON

OFF MAP

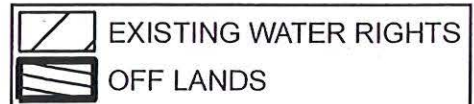

CENTRAL OREGON



IRRIGATION DISTRICT

APPLICATION FOR WATER RIGHTS TRANSFER

COID / ROBERT W. & ESTHER A. MONSON

TAXLOT #: 801

0.2 ACRES

DATE: 10-16-07

FILE: E:\TRANSFER\WTRTRANS07\ COID_171422_801

T 10510


DESCHUTES COUNTY SEC.23 T17S R14E

SCALE - 1" = 400'



SW 1/4 OF THE SE 1/4

DISTRICT INTERNAL
NOTICE #: T-2007-029

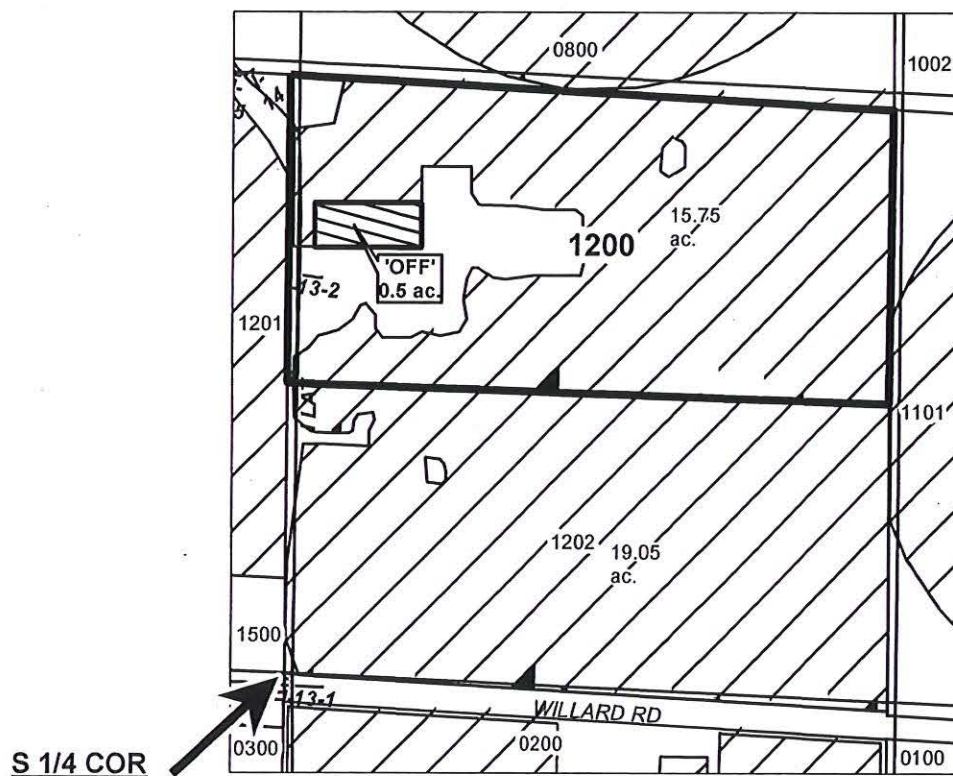


RECEIVED

DEC 24 2007

WATER RESOURCES DEPT
SALEM, OREGON

"OFF" MAP

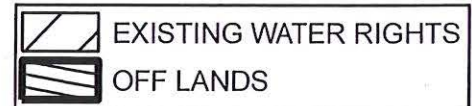

APPLICATION FOR WATER RIGHTS TRANSFER

COID / ROBERT W. & ESTHER A. MONSON

TAXLOT #: 1200

0.5 ACRES

DATE: 10-16-07

FILE: E:\TRANSFER\WRTRANS07\COID_171423_1200

T 10510


DESCHUTES COUNTY SEC.04 T18S R12E

SCALE - 1" = 400'



SE 1/4 OF THE SW 1/4

DISTRICT INTERNAL
NOTICE #: T-2007-029

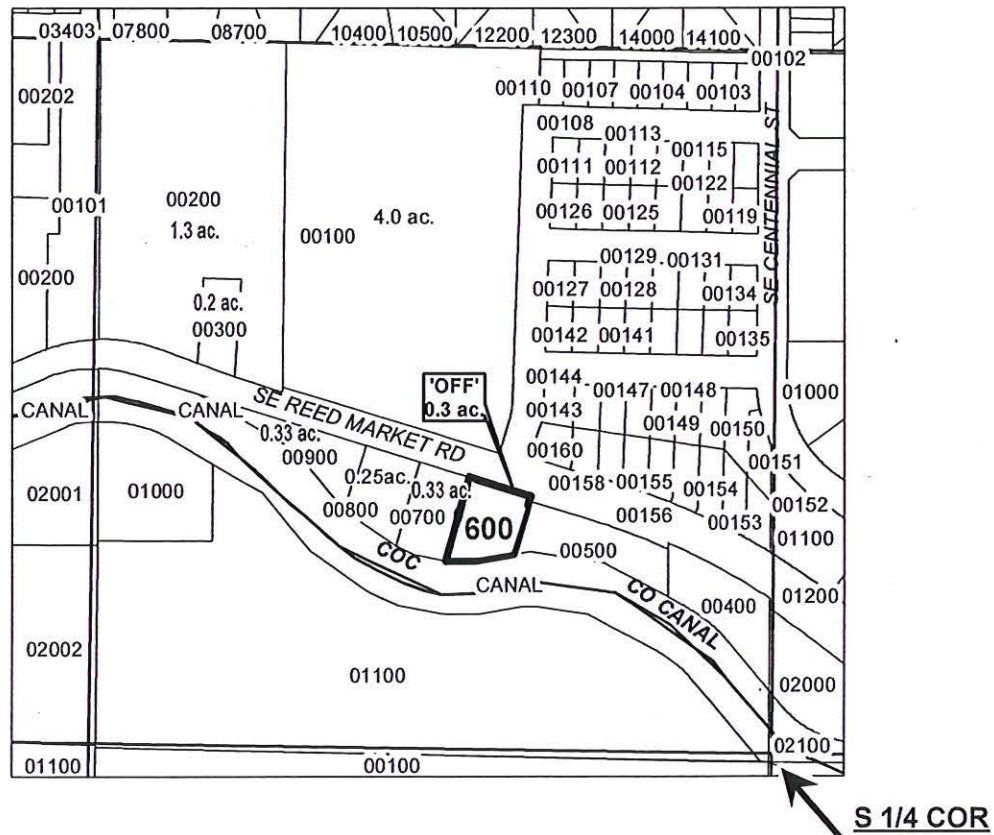

RECEIVED

DEC 24 2007

WATER RESOURCES DEPT
SALEM OREGON

"OFF" MAP



APPLICATION FOR WATER RIGHTS TRANSFER

COID / ROBERT W. & ESTHER A. MONSON

TAXLOT #: 600

T 10510

0.3 ACRES

DATE: 10-16-07

FILE: E:\TRANSFER\WRTRANS07\COID_181204_600


DESCHUTES COUNTY SEC.06 T18S R13E

SCALE - 1" = 400'



NE 1/4 OF THE NE 1/4

DISTRICT INTERNAL
NOTICE #: T-2007-023

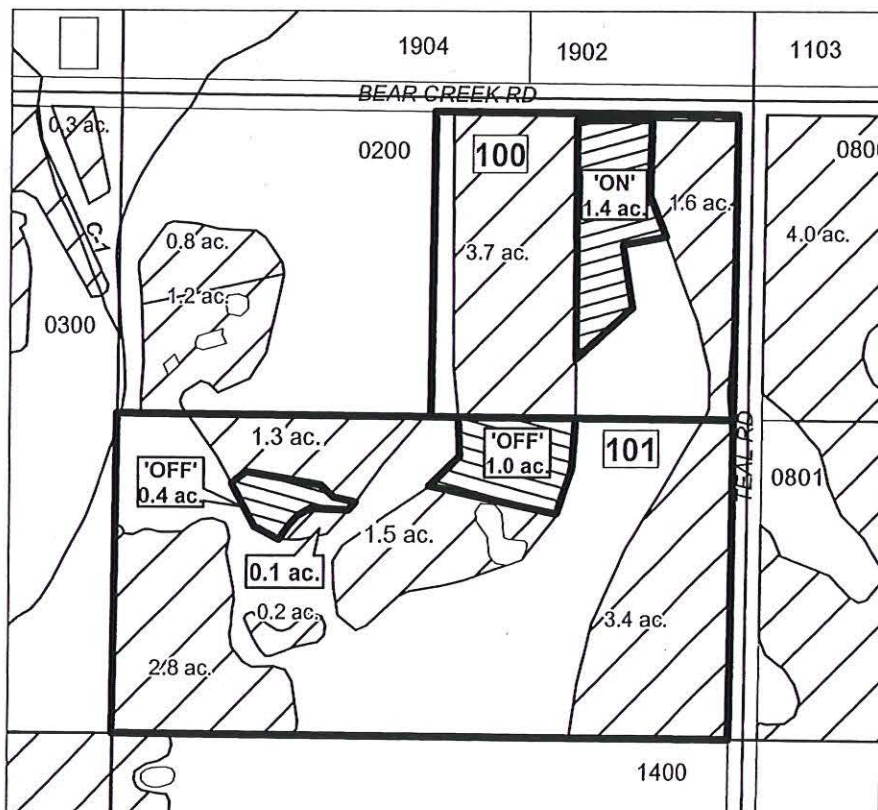

RECEIVED

DEC 24 2007

WATER RESOURCES DEPT
SALEM, OREGON

	EXISTING WATER RIGHTS
	OFF LANDS
	ON LANDS

"OFF" / "ON" MAP



APPLICATION FOR WATER RIGHTS TRANSFER

BEN F. & SHELLEY L. TUMA/ BEN F. & SHELLEY L. TUMA

TAXLOT #: 100, 101
10510

1.4 ACRES

DATE: 08-02-07

FILE: E:\TRANSFER\WRTRANS07\TUMA.PDF


**CROOK COUNTY
SEC.35 T15S R14E**

SCALE - 1" = 400'



NW 1/4 OF THE SW 1/4

DISTRICT INTERNAL
NOTICE #: T-2007-028

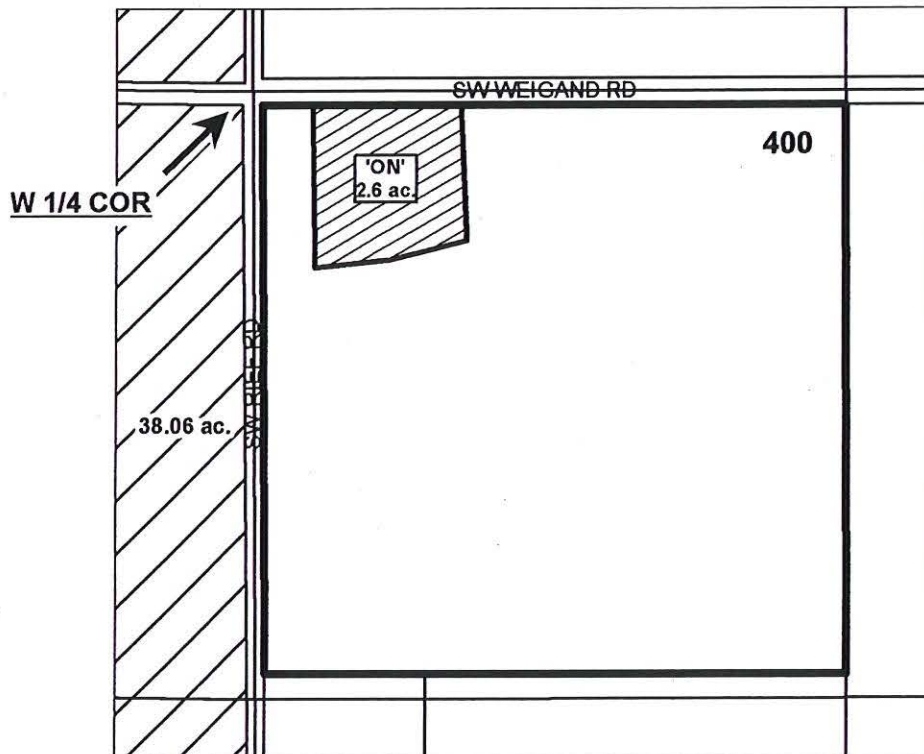


RECEIVED

DEC 24 2007

WATER RESOURCES DEPT
SALEM, OREGON

"ON" MAP

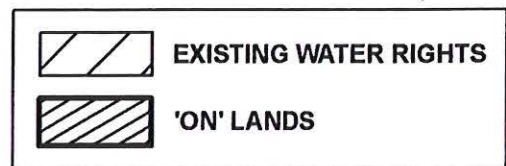

APPLICATION FOR WATER RIGHTS TRANSFER

ALAN F. & MARGARET M. BOVEE / POWELL BUTTE FARMERS CLUB

TAXLOT #: 400

2.6 ACRES

DATE: 10-02-07

FILE: E:\TRANSFER\WR\TRANS07\PB_FARMERS.PDF

T 10510


DESCHUTES COUNTY SEC.01 T16S R12E

SCALE - 1" = 400'



SE 1/4 OF THE NE 1/4; NE 1/4 OF THE SE 1/4

DISTRICT INTERNAL
NOTICE #: T-2007-027

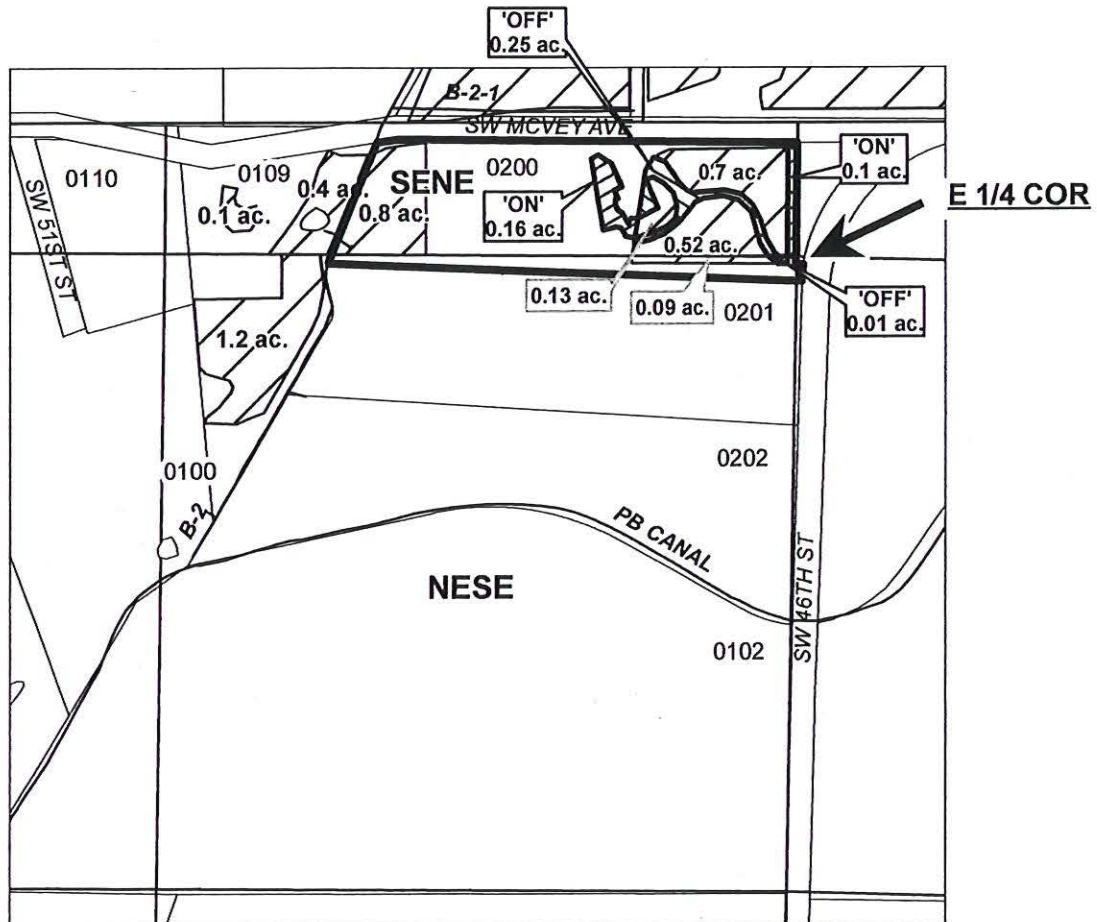

RECEIVED

DEC 24 2007

WATER RESOURCES DEPT
SALEM, OREGON

"OFF" / "ON" MAP



APPLICATION FOR WATER RIGHTS TRANSFER

MARGARET J. WALLACE,
TRUSTEE OF THE W.F. WALLACE MARTIAL Q-TIP TRUST

TAXLOT #: 200

T 10510

0.26 ACRES

DATE: 09-26-07

FILE: E:\TRANSFER\WRTRANS07\WALLACE.PDF


CROOK COUNTY SEC.08 & 17 T16S R14E

SCALE - 1" = 400'



SE 1/4 OF THE SE 1/4; NE 1/4 OF THE NE 1/4

DISTRICT INTERNAL
NOTICE #: T-2007-034

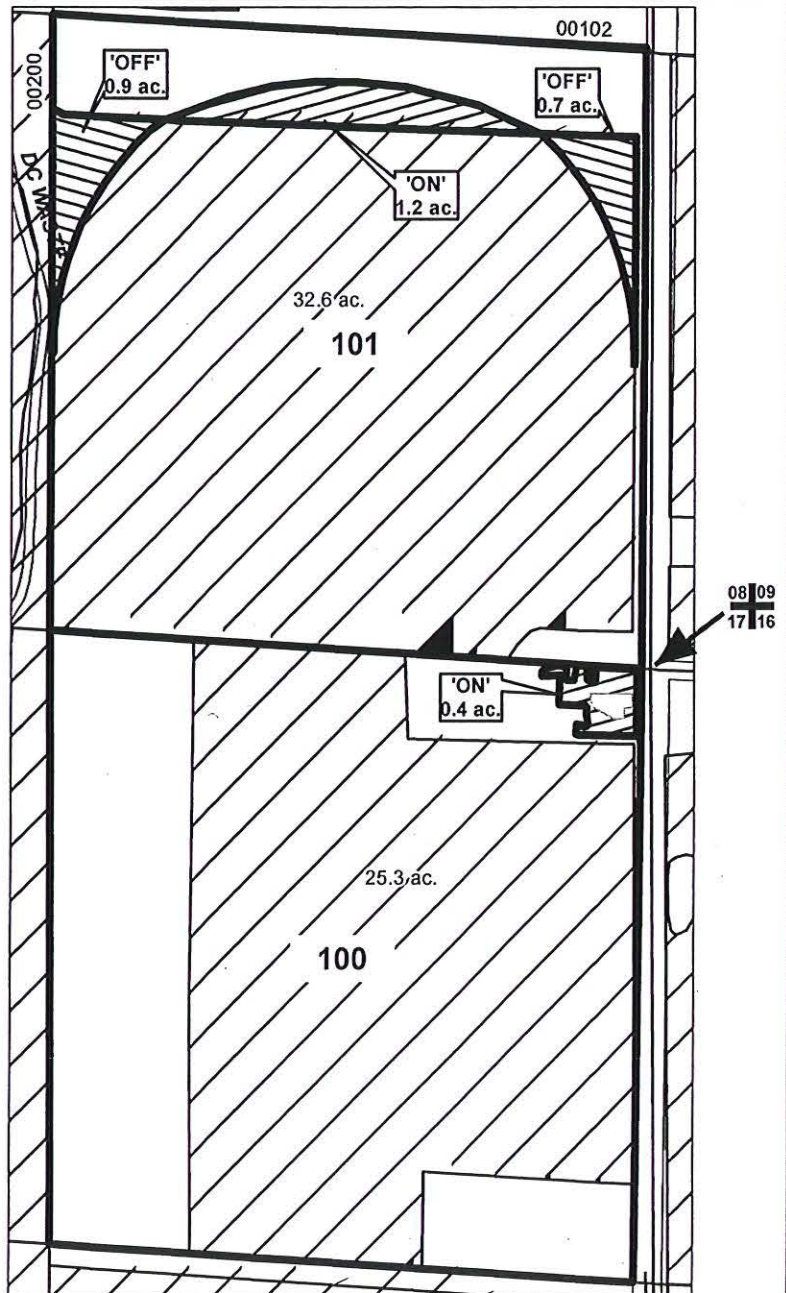

"OFF / ON" MAP

	EXISTING WATER RIGHTS
	OFF LANDS
	ON LANDS



APPLICATION FOR WATER RIGHTS TRANSFER
SCHINKEL FAMILY REVOCABLE TRUST

TAXLOT #:101 & 100

DATE: 11-28-07

T 10510

1.5 ACRES

FILE: E:\TRANSFER\WRTRANS07\SCHINKEL

RECEIVED

DEC 24 2007

WATER RESOURCES DEPT
SALEM, OREGON


DESCHUTES COUNTY SEC.24 T17S R12E

SCALE - 1" = 400'




SE 1/4 OF THE SE 1/4

DISTRICT INTERNAL
NOTICE #: T-2007-029

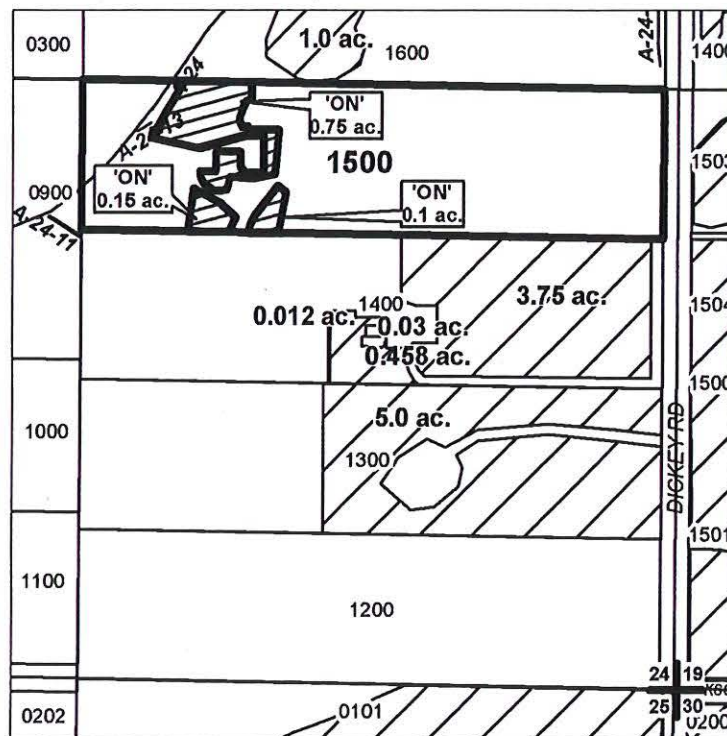

"ON" MAP

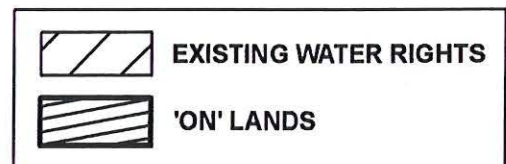

APPLICATION FOR WATER RIGHTS TRANSFER

COID / ROBERT W. & ESTHER A. MONSON

TAXLOT #: 1500

1.0 ACRES

DATE: 12-13-07

FILE: E:\TRANSFER\WR\TRANS07\MONSON

RECEIVED

DEC 24 2007

WATER RESOURCES DEPT
SALEM, OREGON

T 10510


DESCHUTES COUNTY SEC.33 T17S R13E

SCALE - 1" = 400'



SW 1/4 OF THE NW 1/4

DISTRICT INTERNAL
NOTICE # T-2007-026

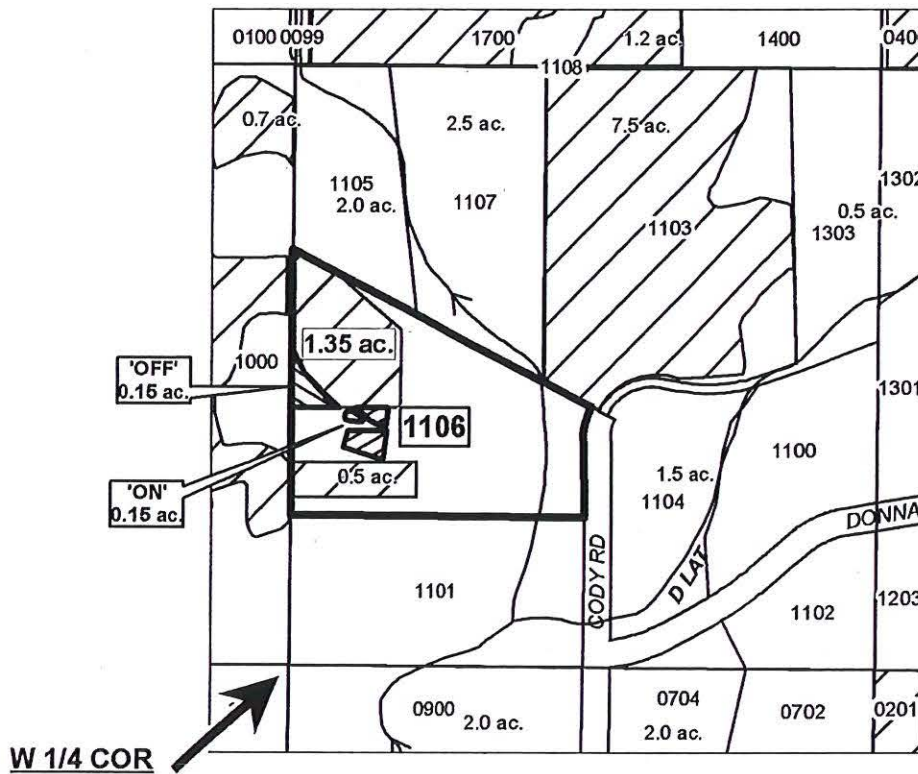

	EXISTING WATER RIGHTS
	OFF LANDS
	ON LANDS
	PARCELS W/ WATER RIGHTS

"OFF/ON " MAP



APPLICATION FOR WATER RIGHTS TRANSFER

RONALD L. & MICHELLE A. WAITS / RONALD L. & MICHELLE A. WAITS

TAXLOT #: 1106

0.15 ACRES

DATE: 09-25-07

FILE: E:\TRANSFER\WTRANS07\WAITS.PDF

RECEIVED

T 10510

DEC 24 2007
WATER RESOURCES DEPT
SALEM, OREGON


DESCHUTES COUNTY SEC.15 T17S R14E

SCALE - 1" = 400'



SE 1/4 OF THE NE 1/4

DISTRICT INTERNAL
NOTICE #: T-2007-030

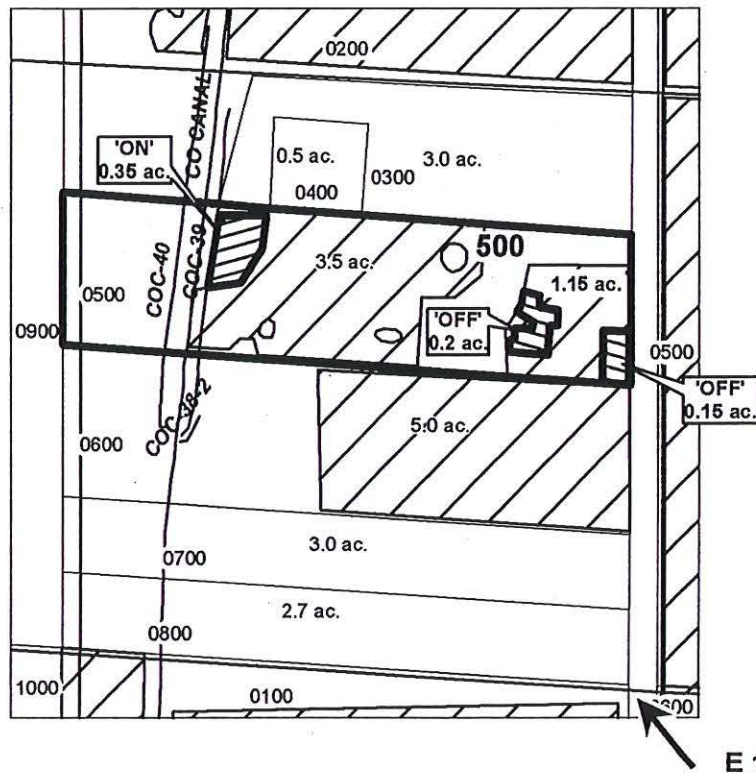

"OFF / ON" MAP

	EXISTING WATER RIGHTS
	OFF LANDS
	ON LANDS
	PARCELS W/ WATER RIGHTS



APPLICATION FOR WATER RIGHTS TRANSFER

DARCY BEAN & JAMES HOLLANDER / DARCY BEAN & JAMES HOLLANDER

TAXLOT #: 500

0.35 ACRES

DATE: 11-05-07

FILE: E:\TRANSFER\WR\TRANS07\HOLLANDER

RECEIVED
OCT 24 2007

T 10510

WATER RESOURCES DEPT
SALEM, OREGON


DESCHUTES COUNTY SEC.06 T18S R13E

SCALE - 1" = 400'



NE 1/4 OF THE NE 1/4

DISTRICT INTERNAL
NOTICE #: T-2007-023

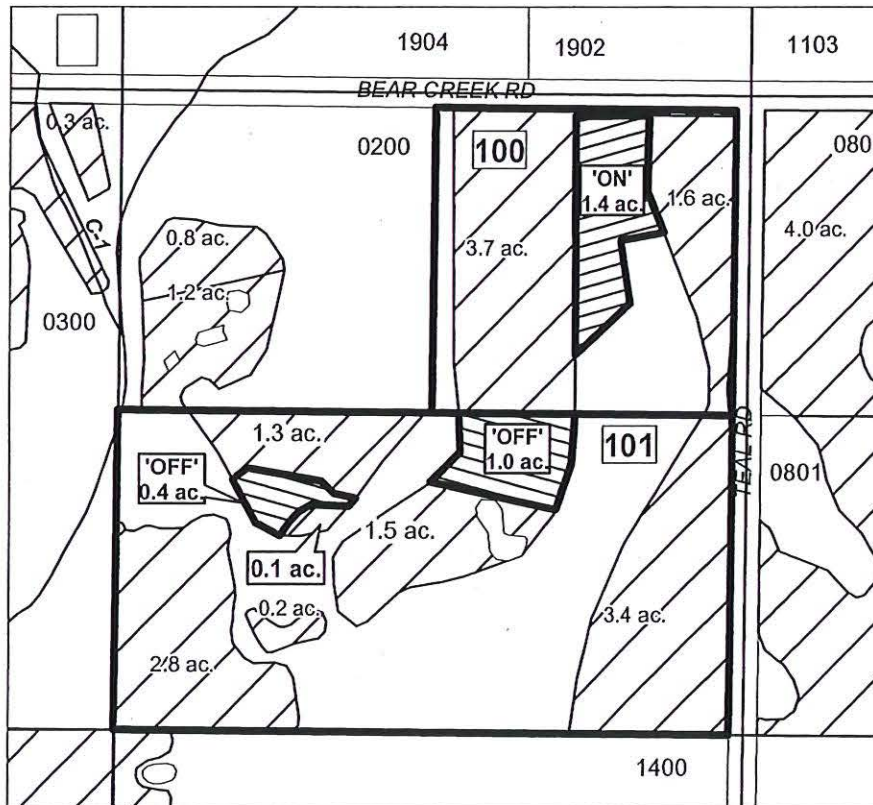

	EXISTING WATER RIGHTS
	OFF LANDS
	ON LANDS

"OFF" / "ON" MAP



APPLICATION FOR WATER RIGHTS TRANSFER

BEN F. & SHELLEY L. TUMA/ BEN F. & SHELLEY L. TUMA

TAXLOT #: 100, 101

1.4 ACRES

T 10510

DATE: 08-02-07

FILE: E:\TRANSFER\WR\TRANS07\TUMA.RDF

RECEIVED
DEC 24 2007
WATER RESOURCES DEP
SALEM, OREGON