

E-RECEIVED

7/9/2026

OWRD

Please use and attach additional pages of Table 2 as needed.
See page 5 for instructions.

Do you have questions about how to fill-out the tables?
Contact the Department at 503-986-0900 and ask for Transfer

Table 2. Description of Modifications to Registration GR-139

List only the part of the registration that will be modified. For the acreage in each $\frac{1}{4}$ $\frac{1}{4}$, list the modification proposed. If more than one modification, specify the acreage associated with each modification. If more than one POA, specify the acreage associated with each POA.

AUTHORIZED (the “from” or “off” lands) The listing that appears in the registration BEFORE PROPOSED CHANGES List only that part or portion of the groundwater registration that will be changed.											Proposed Changes (see “CODES” from previous page)	PROPOSED (the “to” or “on” lands) The listing as it would appear AFTER PROPOSED CHANGES are made.															
Twp	Rng		Sec	¼ ¼		Tax Lot	Gvt Lot or DLC	Acres	Type of USE listed on Certificate	POA(s) (name or number from Table 1)		Priority Date	Twp	Rng		Sec	¼ ¼		Tax Lot	Gvt Lot or DLC	Acres	New Type of USE	POA(s) to be used (from Table 1)	Priority Date			
6	S	3	W	6	SE	SE	100	4682	10.7	Irrigation/ Domestic	POA-1	10/1952	POU	6	S	3	W	6	SW	SE	100	4682	9.3	Irrigation/ Domestic	POA -1, POA-2	10/1952	
6	S	3	W	6	SE	SE	101	4682	0.1					6	S	3	W	6	SE	SE	100	4682	1.7				
6	S	3	W	6	SE	SE	102	4682	0.2					6	S	3	W	6	SW	SE	2100	4682	0.6				
6	S	3	W	6	SE	SE	2100	4682	0.8					6	S	3	W	6	SE	SE	2100	4682	0.2				
TOTAL ACRES								11.8						TOTAL ACRES								11.8					

Additional remarks: *The proposed modification includes a change of place of use and the addition of a new point of appropriation. Although the original GR describes the 30-acre place of use as extending into the NESE $\frac{1}{4}$ $\frac{1}{4}$ of Section 6, this is based on a scrivener's error (see Application Cover Letter), and the actual 30-acre place of use is located fully within the SESE $\frac{1}{4}$ $\frac{1}{4}$. Additionally, discrepancies exist between the hand-drawn place of use map on the original GR document and the shapefile depicting the place of use in OWRD's database. Both appear to show a place of use larger than 30 acres (31-32 acres). For this reason, the "from" and "to" lands in the table are not equivalent areas. The proposed place of use is exactly 30 acres. This modification proposes the movement of a portion of these 30 acres to acres within the SWSE $\frac{1}{4}$ $\frac{1}{4}$ (11.8 acres), while the remaining acres will stay in the current location or move to new locations within the SESE $\frac{1}{4}$ $\frac{1}{4}$.*

All "From" and "To" acres are located within the Wm. S. Cooper D.L.C.

"From" Lands
Section 6
SESE: 11.8 acres

"To" Lands
Section 6
SESE: 1.9 acres
SWSE: 9.9 acres


"From" Lands
Taxlot 100: 10.7 acres
Taxlot 2100: 0.8 acres
Taxlot 101: 0.1 acres
Taxlot 102: 0.2 acres

"To" Lands
Taxlot 100: 11.0 acres
Taxlot 2100: 0.8 acres

E-RECEIVED

7/9/2026

OWRD

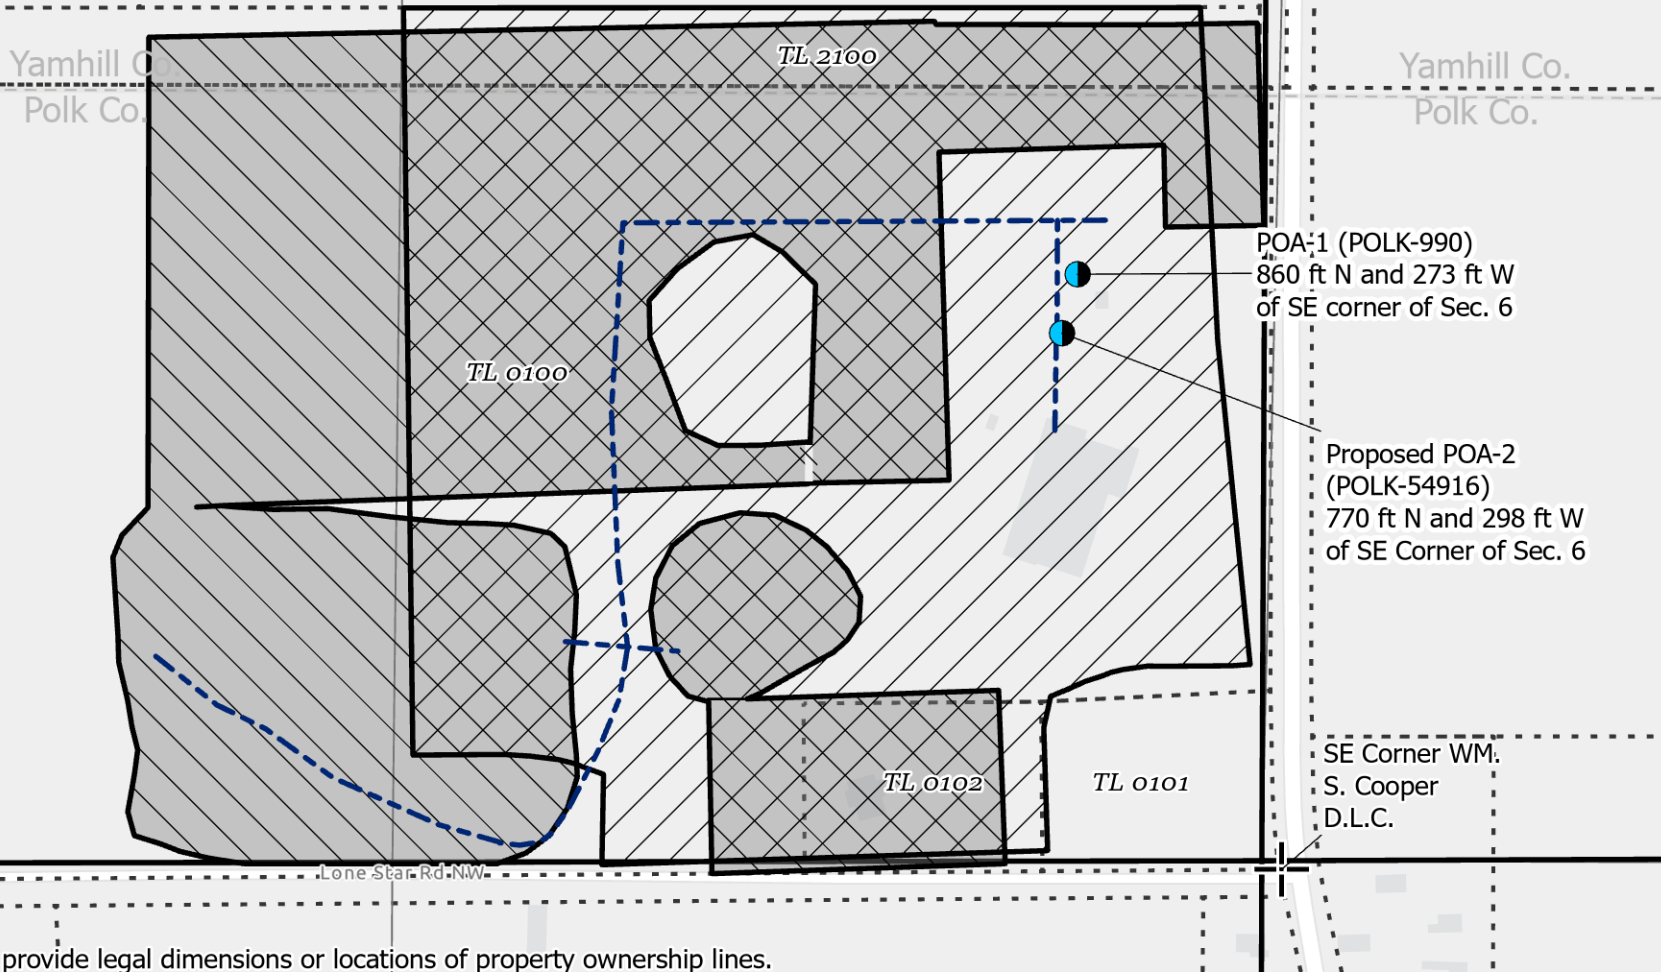

This map is not intended to provide legal dimensions or locations of property ownership lines.



EVREN Northwest Environmental, Inc.
PO Box 14488
Portland, OR 97293

Figure 1
GR-139 Modification Map
Priority Date: 10/31/1952
Use: Irrigation and Domestic

1	DATE	AUTH	DRAFT
No.	Date	By	Revisions



0 250 500 Feet
1:4,800

- POA
- Distribution Lines
- Proposed POU (Irr. & Dom.)
- GR-139 POU
- Taxlots