

T-13514

District

T-13514

Name Central Oregon Irrigation DistrictAddress Attn: Leslie
1055 SW Lake Court
Redmond Oregon 97560

DESCRIPTION OF WATER RIGHT(S)

Name of Stream Deschutes river, Crane PrairieTrib. of Columbia River, Deschutes RiverUse dom. IR, min. 9 min. mining, per County Cook, Deschutes, JeffersonQuantity of water (CFS) domestic, livestock No. of AcresName of ditch Pollution abatementApp# Decree Per # Deschutes R Cert # 94950 PR DateApp# S-13180 Per # S-23250 Cert # 716714 PR Date 2/28/1983

App# Per # Cert # PR Date

App# Per # Cert # PR Date

App# Per # Cert # PR Date

App# Per # Cert # PR Date

FEES PAID

Date 8-24-2020 Amount \$1,680.00 Receipt # 133309

FEES REFUNDED

Date Amount Receipt #

Change in POWDate Filed 8/24/2020Initial notice date 9/8/2020

DPD issued date

PD issued date

PD notice date

Date of FO 11/6/2021Vol 118Page 319-25

3/21/23

127

952-954

C-Date 10/1/2022COBU due date 10/01/2023COBU Received date 9/15/22

Certificate issued

Assignments:

Irrigation District

Agent

CWRE

CC's list Bureau of reclamation☐ - Oversized map - Location



Oregon

Tina Kotek, Governor

Water Resources Department

North Mall Office Building

725 Summer St NE, Suite A

Salem, OR 97301

Phone 503 986-0900

Fax 503 986-0904

March 21, 2023

CENTRAL OREGON IRRIGATION DISTRICT
1055 SW LAKE COURT
REDMOND, OR 97756

Reference: Transfer Application T-13514

Enclosed is a copy of the Determination of Satisfactory Proof Final Order.

If you have any questions related to the completion of this Claim of Beneficial Use, you may contact Ann Reece, by telephone at (503) 979-3214 or by e-mail at Ann.L.Reece@water.oregon.gov.

Sincerely,

Nila Kamis
Water Rights Services Support
Transfers and Conservation Section

cc: Watermaster Dist. #11, Jeremy T. Giffin (via email)

Enclosure

**BEFORE THE WATER RESOURCES DEPARTMENT
FOR THE
STATE OF OREGON**

In the Matter of the Completion of a Change in Place of Use Under Transfer Application T-13514, Deschutes County	)))	DETERMINATION OF SATISFACTORY PROOF OF COMPLETION FOR A PERMANENT DISTRICT TRANSFER
--	-------------	---

Authority

Oregon Administrative Rule (OAR) 690-385-7400 describes the documentation the district must file with the Department in order to provide proof of use.

OAR 690-385-7600 provides in pertinent part that satisfactory proof shall be (a) a determination by the Department that application of water to beneficial use under the terms of the transfer final order was completed to the extent authorized, or (b) a determination by the Department that the application of water to a beneficial use under the terms of the transfer final order was completed to an extent less than authorized.

Oregon Revised Statute (ORS) 540.530(2)(a) and OAR 690-385-7600 authorize the Department to issue or modify a certificate of water right upon satisfactory proof of completion of the change or changes authorized by a final order approving a permanent district transfer.

Applicant

CENTRAL OREGON IRRIGATION DISTRICT
1055 SW LAKE COURT
REDMOND, OR 97756

Findings of Fact

1. On January 6, 2021, the Department signed a final order, which was mailed on January 8, 2021, recorded in Special Order Volume 118, Pages 319-325, approving Transfer Application T-13514 involving Certificates 94956 and 76714. The final order established October 1, 2022, as the date for completion of the authorized changes in place of use.

NOTICE OF RIGHT TO PETITION FOR RECONSIDERATION OR JUDICIAL REVIEW

This is an order in other than a contested case. This order is subject to judicial review under ORS 183.482. Any petition for judicial review must be filed within the 60-day time period specified by ORS 183.482. Pursuant to ORS 183.482, ORS 536.075 and OAR 137-003-0675, you may petition for judicial review and petition the Director for reconsideration of this order. A petition for reconsideration may be granted or denied by the Director, and if no action is taken within 60 days following the date the petition was filed, the petition shall be deemed denied.

2. On September 15, 2022, the Department received a Claim of Beneficial Use (CBU) and associated maps from the applicant for Transfer Application T-13514 satisfying the requirements for providing proof of use under OAR 690-385-7400.
3. The Department reviewed the CBU and map(s) submitted by the applicant for Transfer Application T-13514.
4. The CBU did not contain a map of the point of diversion from the source. However, since the transfer involved the transfer of places of use only within an irrigation district and did not involve a change in the point of diversion, the existing maps on file with the Department are sufficient to identify the point of diversion from the source.
5. The proposed place of use for Certificates 94956 for primary irrigation and 76714 for supplemental irrigation as approved the final order for Transfer Application T-13514, and as recorded in Special Order Volume 118, Pages 319-325, is shown in Table 1, below:

Table 1:

IRRIGATION									
Twp	Rng	Mer	Sec	Q-Q	Acres	Taxlot	Water User ¹	Notice	POD
14 S	13 E	WM	6	SE SE	0.40	400	MICHAEL/KAARIN FORESTER TRUSTEES	2020-013	11
14 S	13 E	WM	15	SW NW	0.35	2400	BOYNTON	2020-003	11
14 S	13 E	WM	22	NE SE	1.90	101	DAVIS	2020-007	11
14 S	13 E	WM	27	NW SW	3.00	300	JENNINGS	2020-022	11
14 S	14 E	WM	19	NE NW	0.60	201	HEMPHILL	2020-002	11
14 S	14 E	WM	19	NE SE	9.18	300	KASBERGER RANCH LLC	2020-018	11
14 S	14 E	WM	19	NW SE	0.95	300	KASBERGER RANCH LLC	2020-018	11
14 S	14 E	WM	19	SW SE	2.72	304	KASBERGER RANCH LLC	2020-018	11
14 S	14 E	WM	19	SE SE	2.25	304	KASBERGER RANCH LLC	2020-018	11
15 S	12 E	WM	25	NE NE	0.60	102	WIDMER	2020-005	11
15 S	13 E	WM	31	SE NW	0.09	702	ENDICOTT	2020-026	11
16 S	12 E	WM	11	NE NW	1.45	208	NAHLIK	2020-011	11
16 S	12 E	WM	26	NE NE	2.17	401	PARSONS	2020-015	11
16 S	12 E	WM	26	NW NE	1.00	401	PARSONS	2020-015	11
16 S	12 E	WM	35	NW SE	0.81	1000	SHAFFER	2020-008	11
17 S	12 E	WM	29	SE NW	0.15	101	RIVER'S EDGE COMMUNITY MASTER ASSOCIATION	2020-019	10
17 S	13 E	WM	19	SE NW	0.64	1000	LARSEN	2020-017	1
17 S	13 E	WM	30	NE NW	0.80	205	BOMKE	2020-001	1
17 S	13 E	WM	30	NE NW	0.25	300	BOMKE	2020-001	1
17 S	14 E	WM	13	SW SE	0.41	600	FORE	2020-012	1
17 S	14 E	WM	23	SE NW	0.75	800	9 MILE FARM LLC	2020-009	1
17 S	14 E	WM	27	NE SW	3.00	200	DYNES	2020-014	1
17 S	14 E	WM	27	NW SW	0.25	200	DYNES	2020-014	1
17 S	14 E	WM	28	NW NE	0.40	2301	FLORENCE JENO REV TRUST	2020-016	1

IRRIGATION									
Twp	Rng	Mer	Sec	Q-Q	Acres	Taxlot	Water User ¹	Notice	POD
17 S	14 E	WM	28	SW NE	0.10	2301	FLORENCE JENO REV TRUST	2020-016	1
18 S	13 E	WM	2	SW SE	0.03	500	NORWOOD	2020-010	1
18 S	13 E	WM	2	SE SE	0.37	500	NORWOOD	2020-010	1
18 S	13 E	WM	4	SW NE	0.45	600	RALSTON	2020-004	1
Total					35.07				

¹Water users listed in bold are different from the water user that was listed in the transfer final order. They have been updated here to reflect the changes as shown in the CBU.

- The reconfigured changes in place of use as documented in the CBU and associated maps are determined satisfactory because the reconfigured, completed uses are under the same water user, do not enlarge the rights and affect the same number of irrigated acres.
- Based on the review of evidence submitted by the applicant, the Department finds that the application of water to beneficial use under the terms of the transfer final order for T-13514 was completed to the extent authorized in the transfer as described in Table 1.


Conclusions of Law

- The Applicant has submitted proof of use pursuant to OAR 690-385-7400.
- Application of water to a beneficial use under the terms of the transfer final order has been made to the extent shown in Table 1, above.
- The applicant has demonstrated proof of completion under T-13514 to the satisfaction of the Department.
- The Department is authorized to issue or modify certificates of water rights involved in transfer T-13514 consistent with this determination of satisfactory proof of completion.

Now, therefore, it is ORDERED:

- Water right Certificates 94956 and 76714 are modified as shown in Table 1, above. The Department will issue superseding certificates describing these rights when it determines it is necessary for record keeping.

Signed at Salem, Oregon on MAR 21 2023

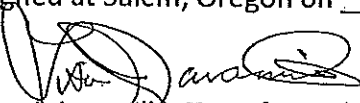

Lisa J. Jaramillo, Transfer and Conservation Section Manager for
Douglas E. Woodcock, Acting Director
Oregon Water Resources Department

Mailing Date: MAR 22 2023



September 15, 2022

Ann Reece
District Transfer Advisor
Oregon Water Resources Department
725 Summer St NE Ste A
Salem, OR 97301-1266

RE: FINAL PROOFS – Claim of Beneficial Use for T-13514

Dear Ann,

Central Oregon Irrigation District is submitting our claim of beneficial use for a permanent District transfer ("385").

Enclosed is a list of the authorized lands. Site reports are attached to each map and any specific details about the properties are contained in each site report.

Please Note: The below noted properties have had the following changes:

1. 17-12-29 SENW 101: Name Change
2. 17-14-23 SENW 800: Name Change
3. 17-14-27 NESW 200: Name Change
4. 17-14-27 NWSW 200: Name Change
5. 18-13-02 SESE 500: Name Change
6. 18-13-02 SWSE 500: Name Change

The District certifies that it has inspected the place of use and confirms the change in place of use has been completed consistent with the terms and conditions of the final order approving the transfer.



Craig Horrell

Date: 9.15.22

Managing Director, Central Oregon Irrigation District



Oregon Water Resources Department
725 Summer Street NE, Suite A
Salem, Oregon 97301-1266
(503) 986-0900
www.wrd.state.or.us

District Permanent
Water Right Transfer



Claim of Beneficial Use

1. APPLICANT INFORMATION

District: CENTRAL OREGON IRRIGATION DISTRICT

Contact Person: LESLIE CLARK

Phone: 541-548-6047

Mailing Address: 1055 SW LAKE COURT

City: REDMOND

State: OR

Zip: 97756

E-Mail address: lesliec@coid.org

Transfer Number: T - 13514

2. WATER RIGHT(S)

Pursuant to OAR Chapter 690, Division 385, the district is submitting to the Water Resources Department this claim of beneficial use, with the appropriate fee, for the following water right(s):

NOTE: Fees do not apply if the priority date is prior to July 9, 1987.

PERMIT NUMBER	CERTIFICATE NUMBER	DECREE (name, volume, and page)	PRIMARY (P) OR SUPP (S)
-	94956		☒ P ☐ S
-	76714		☐ P ☒ S
-			☐ P ☐ S
-			☐ P ☐ S

3. AUTHORIZED POINT(S) OF DIVERSION (POD) / APPROPRIATION (POA)

The authorized point(s) of diversion / appropriation for the water right modified by the transfer are as follows:

PERMIT NUMBER	DECREE or CERTIFICATE	POD / POA #	SOURCE	LOCATION – MEASURED DISTANCES
-	94956	1	DESCH	SW ¼ NE ¼ SEC. 13, T. 18 S., R. 11 E., W.M.; 1520' S. & 1535' W. FROM THE NE CORNER OF SEC. 13
-	94956	11	DESCH	SE ¼ NE ¼ SEC. 29, T. 17 S., R. 12 E., W.M.; 850' N. AND 630' W. FROM THE E ¼ CORNER OF SEC. 29
-	76714		C.P.	NE ¼ NE ¼ SECTION 17, T 21 S, R 8 E, W.M.

6. SIGNATURES



The district certifies that it has inspected the place of use listed in Table I, and confirms the change in place of use has been completed consistent with the terms and conditions of the final order approving the transfer.



Craig Horrell
Managing Director, Central Oregon Irrigation District



Date

Petition #	OWRD #	TOWNSHIP	RANGE	SECTION	QQ	Tax Lot	# Acres	Transferring Owner	Current Owner
P-2020-001	T-13514	14	13	06	SESE	00400	0.40	Forester, Michael/Kaarin Trustees	
		14	13	15	SWNW	02400	0.35	Boynton, Sharon	
		14	13	22	NESE	00101	1.90	Davis, Victoria	
		14	13	27	NWSW	00300	3.00	Jennings, Ryan	
		14	14	19	NENW	00201	0.60	Hemphill, Carl/Cynthia	
		14	14	19	NESE	00300	9.18	Kasberger Ranch, LLC	
		14	14	19	NWSE	00300	0.95	Kasberger Ranch, LLC	
		14	14	19	SESE	00304	2.25	Kasberger Ranch, LLC	
		14	14	19	SWSE	00304	2.72	Kasberger Ranch, LLC	
		15	12	25	NENE	00102	0.60	Widmer, Sidney/Melanie	
		15	13	31	SENW	00702	0.09	Endicott, George/Krisanna	
		16	12	11	NENW	00208	1.45	Nahlik, Stacy/Matthew	
		16	12	26	NENE	00401	2.17	Parsons, Leo D.	
		16	12	26	NWNE	00401	1.00	Parsons, Leo D.	
		16	12	35	NWSE	01000	0.81	Shaffer, Matthew	
		17	12	29	SENW	00101	0.15	River's Edge Investments	River's Edge Community Master Association
		17	13	19	SENW	01000	0.64	Larsen, Chris/Kit	
		17	13	30	NENW	00205	0.80	Bomke, Kurt/Jennifer	
		17	13	30	NENW	00300	0.25	Bomke, Kurt/Jennifer	
		17	14	13	SWSE	00600	0.41	Fore, Robert Jr./Erynne	
		17	14	23	SENW	00800	0.75	Middleton, Keith	9 Mile Farm, LLC
		17	14	27	NESW	00200	3.00	Mulcahy, Richard/Denise	Dynes, Luke
		17	14	27	NWSW	00200	0.25	Mulcahy, Richard/Denise	Dynes, Luke
		17	14	28	NWNE	02301	0.40	Jeno, Curt	
		17	14	28	SWNE	02301	0.10	Jeno, Curt	
		18	13	02	SESE	00500	0.36	Scott, Benjamin/O'Connell, Rebecca	Norwood, Ryan/Ali
		18	13	02	SWSE	00500	0.04	Scott, Benjamin/O'Connell, Rebecca	Norwood, Ryan/Ali
		18	13	04	SWNE	00600	0.45	Ralston, Jacob/Dayna	
							35.07		

DESCHUTES COUNTY SEC.06 T14S R13E



E-RECEIVED
09/15/2022
OWRD

SCALE - 1" = 400'



SE 1/4 OF THE SE 1/4

OWRD: T-13514

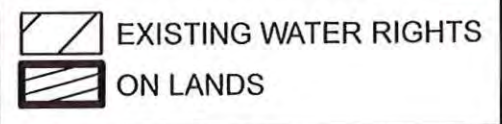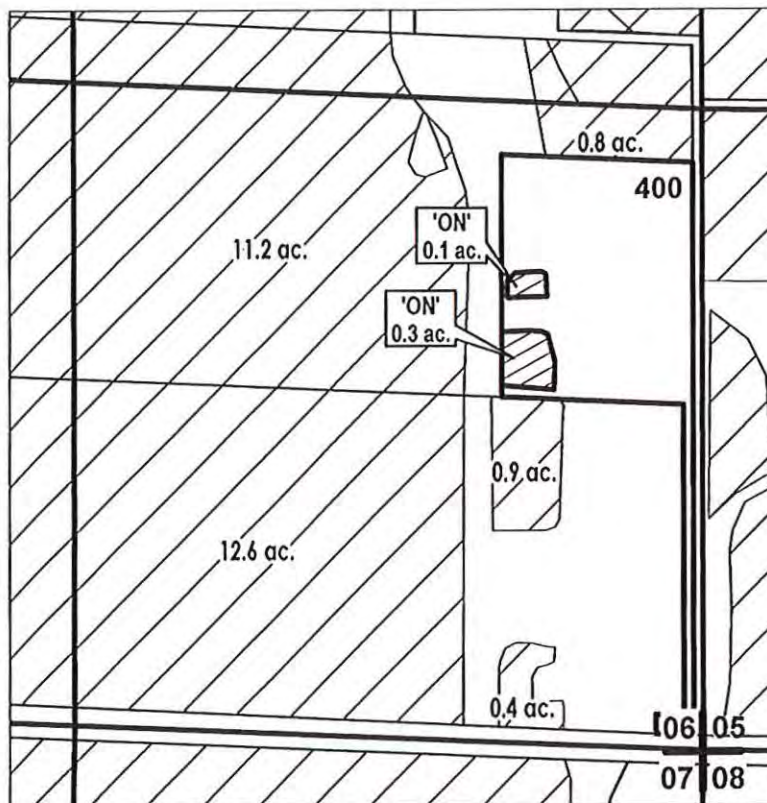

FINAL PROOF MAP

NAME: Forester, Michael.Kaarin Trustees

TAXLOT #: 400

0.4 ACRES

DATE: 9/1/2022

FINAL PROOF SITE REPORT

Claim of Beneficial Use



Property Owner (Applicant): Forester, Michael/Kaarin

Petition #: P-2020-001

Current Owner:

OWRD#: T-13514

Property Address: 3525 NW Ice Ave Terrebonne

Notice #: T-2020-013

POD	USE	HG	TWP	RNG	SEC	QQ	TAX LOT	ACRES
11	IRRIG	H-18-6	14	13	06	SESE	400	0.40

- ☐ Person interviewed (if any): Michael Forester
- ☐ Method of irrigation (pump, flood, etc): pump
- ☐ Use (crops produced): pasture for horses
- ☐ Method used to calculate area irrigated: Trimble GPS
- ☐ Is beneficial use achieved: Yes, 0.47 ac
- ☐ Dated photos of beneficial use: 7/1/21
- ☐ Are there any mapping changes: No → unmapped to mapped
- ☐ Submit map changes to mapping for updates to ARC. Date submitted: N/A
- ☐ Update QQ/TL changes in WWIN: N/A
- ☐ Enter use into WWIN: _____

IF INCOMPLETE:

- ☐ Failure to Prove up _____ acres of transferred water right
- ☐ Extension Filed: _____

NOTES:

1st Review:

Good growth, 3"-4". Rotating horses off pasture to allow better growth. full use of 0.47 ac.

2nd Review:

3rd Review (if not complete assess \$150 fee)

Final Inspection by: [Signature]

Date: 7/1/21

DESCHUTES COUNTY SEC.15 T14S R13E


E-RECEIVED
09/15/2022
OWRD

SCALE - 1" = 400'



SW 1/4 OF THE NW 1/4

OWRD #: T-13514

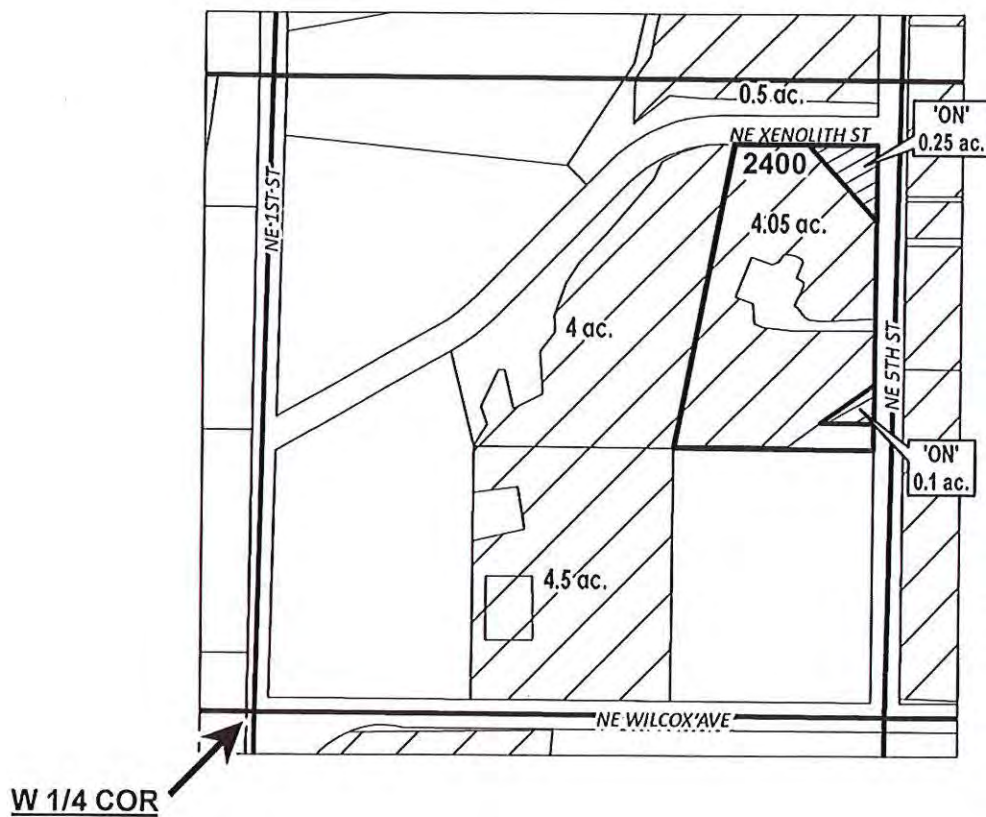

	EXISTING WATER RIGHTS
	ON LANDS

FINAL PROOF MAP

SHARON L. BOYNTON

TAXLOT #: 2400

0.35 ACRES



Date: 9/7/2021

FINAL PROOF SITE REPORT

Claim of Beneficial Use



Property Owner (Applicant): Boynton, Sharon

Petition #: P-2020-001

Current Owner:

OWRD#: T-13514

Property Address: 8955 NE 5th St Terrebonne

Notice #: T-2020-003

POD	USE	HG	TWP	RNG	SEC	QQ	TAX LOT	ACRES
11	IRRIG	H-8-2-1	14	13	15	SWNW	2400	0.35

- ☐ Person interviewed (if any): Sharon Boynton
- ☐ Method of irrigation (pump, flood, etc): pump - handline
- ☐ Use (crops produced): pasture
- ☐ Method used to calculate area irrigated: Trimble GPS
- ☐ Is beneficial use achieved: yes
- ☐ Dated photos of beneficial use: 7/1/21
- ☐ Are there any mapping changes: NO
- ☐ Submit map changes to mapping for updates to ARC. Date submitted: N/A
- ☐ Update QQ/TL changes in WWIN: N/A
- ☐ Enter use into WWIN: _____

IF INCOMPLETE:

- ☐ Failure to Prove up _____ acres of transferred water right
- ☐ Extension Filed: _____

NOTES:

1st Review:

Full BU achieved Corners are well established.
Pictures in collector.

2nd Review:

3rd Review (if not complete assess \$150 fee)

Final Inspection by:

[Signature]

Date:

7/1/21

DESCHUTES COUNTY SEC.22 T14S R13E


E-RECEIVED
09/15/2022
OWRD

SCALE - 1" = 400'



NE 1/4 OF THE SE 1/4

OWRD #: 13514

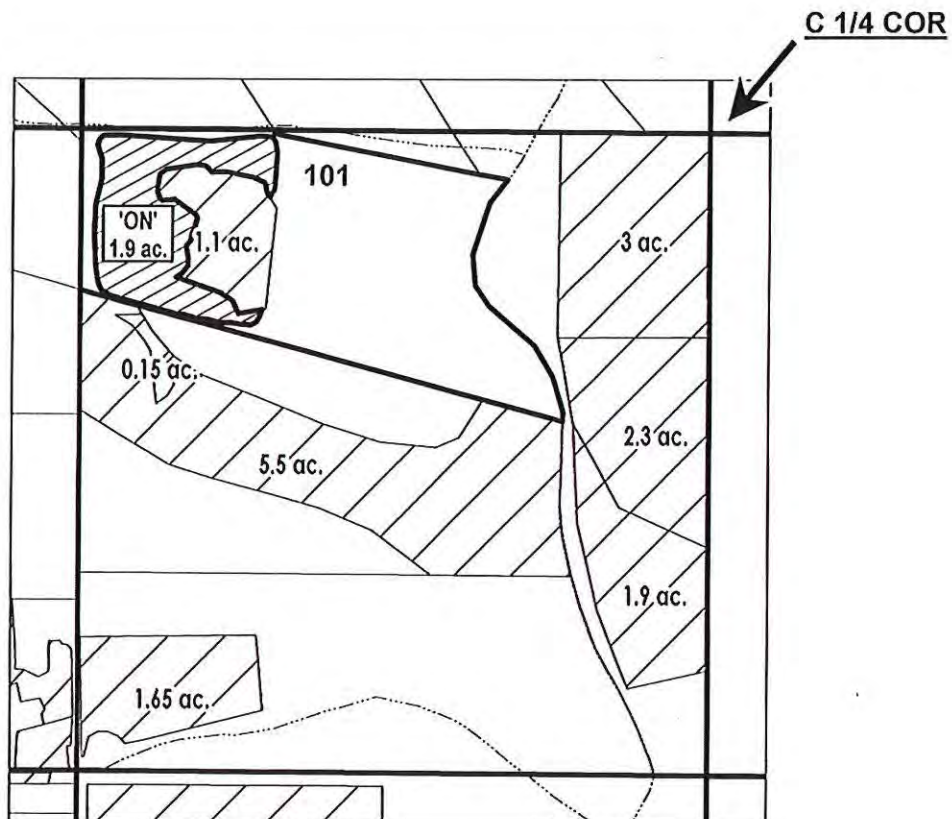

 EXISTING WATER RIGHTS
 ON LANDS



FINAL PROOF MAP

VICTORIA LEE DAVIS

TAXLOT #: 101

1.9 ACRES

Date: 9/7/2021

FINAL PROOF SITE REPORT

Claim of Beneficial Use



Property Owner (Applicant): Davis, Victoria

Petition #: P-2020-001

Current Owner:

OWRD#: T-13514

Property Address: 7234 NE Juniper Ridge Rd Redmond

Notice #: T-2020-007

POD	USE	HG	TWP	RNG	SEC	QQ	TAX LOT	ACRES
11	IRRIG	G-2-7	14	13	22	NESE	101	1.9

- ☒ Person interviewed (if any): Victoria Davis
- ☒ Method of irrigation (pump, flood, etc): pump
- ☒ Use (crops produced): Pasture
- ☒ Method used to calculate area irrigated: Timble
- ☒ Is beneficial use achieved: yes, full bu
- ☒ Dated photos of beneficial use: 7/1/21
- ☐ Are there any mapping changes: No
- ☐ Submit map changes to mapping for updates to ARC. Date submitted: N/A
 - ☐ Update QQ/TL changes in WWIN: N/A
- ☐ Enter use into WWIN: _____

IF INCOMPLETE:

- ☐ Failure to Prove up _____ acres of transferred water right
- ☐ Extension Filed: _____

NOTES:

1st Review:

Full BU. Tall pasture about knee high. Well established.

2nd Review:

3rd Review (if not complete assess \$150 fee)

Final Inspection by: [Signature]

Date: 7/1/21

DESCHUTES COUNTY SEC.27 T14S R13E


E-RECEIVED
09/15/2022
OWRD

SCALE - 1" = 400'



NW 1/4 OF THE SW 1/4

OWRD: T-13514

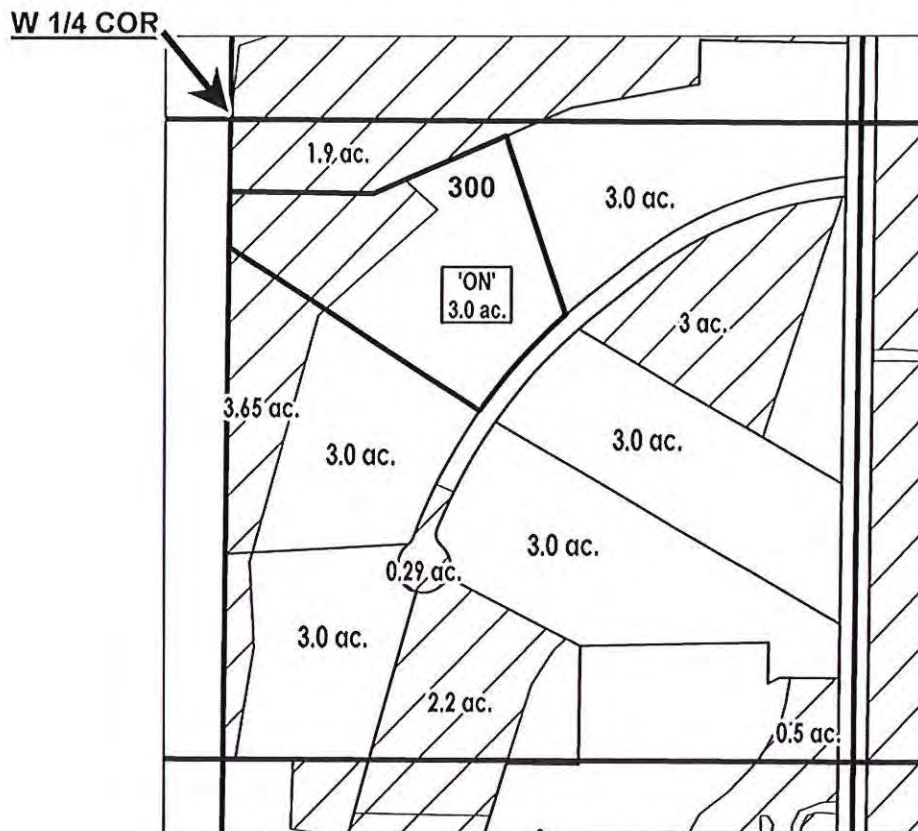

# ac.	'ON' LAND PARCELS
	EXISTING WATER RIGHTS
# ac.	PARCELS W/ WATER RIGHTS



FINAL PROOF MAP

NAME: Jennings, Ryan/Jill

TAXLOT #: 300

3.0 ACRES

DATE: 9/14/2022

FINAL PROOF SITE REPORT

Claim of Beneficial Use



Property Owner (Applicant): Jennings, Ryan

Petition #: P-2020-001

Current Owner:

OWRD#: T-13514

Property Address: 291 NE Frank Ln Redmond

Notice #: T-2020-022

POD	USE	HG	TWP	RNG	SEC	QQ	TAX LOT	ACRES
11	IRRIG	G-9-1	14	13	27	NWSW	300	3.0

- ☐ Person interviewed (if any): None
- ☐ Method of irrigation (pump, flood, etc): Sprinkle
- ☐ Use (crops produced): Pasture Mix
- ☐ Method used to calculate area irrigated: Trimble GPS and collector
- ☐ Is beneficial use achieved: Yes, 3ac
- ☐ Dated photos of beneficial use: 7-22-2021 and 5/3/22
- ☐ Are there any mapping changes: NO
- ☐ Submit map changes to mapping for updates to ARC. Date submitted: _____
- ☐ Update QQ/TL changes in WWIN: _____
- ☐ Enter use into WWIN: yes

IF INCOMPLETE:

- ☐ Failure to Prove up _____ acres of transferred water right
- ☐ Extension Filed: _____

NOTES:

1st Review:

7/22/21 2.5ac irrigated. Still needs 0.5ac BU crop
informed Ryan of BU.

2nd Review:

5/3/22 - Planted area behind shop. 3-4' of
thick grass. Downsized area of dry lot.
BU looks excellent

3rd Review (if not complete assess \$150 fee)

Final Inspection by:

[Signature]

Date:

5/3/22

CROOK COUNTY SEC.19 T14S R14E


E-RECEIVED
09/15/2022
OWRD

SCALE - 1" = 400'



NE 1/4 OF THE NW 1/4

OWRD: T-13514

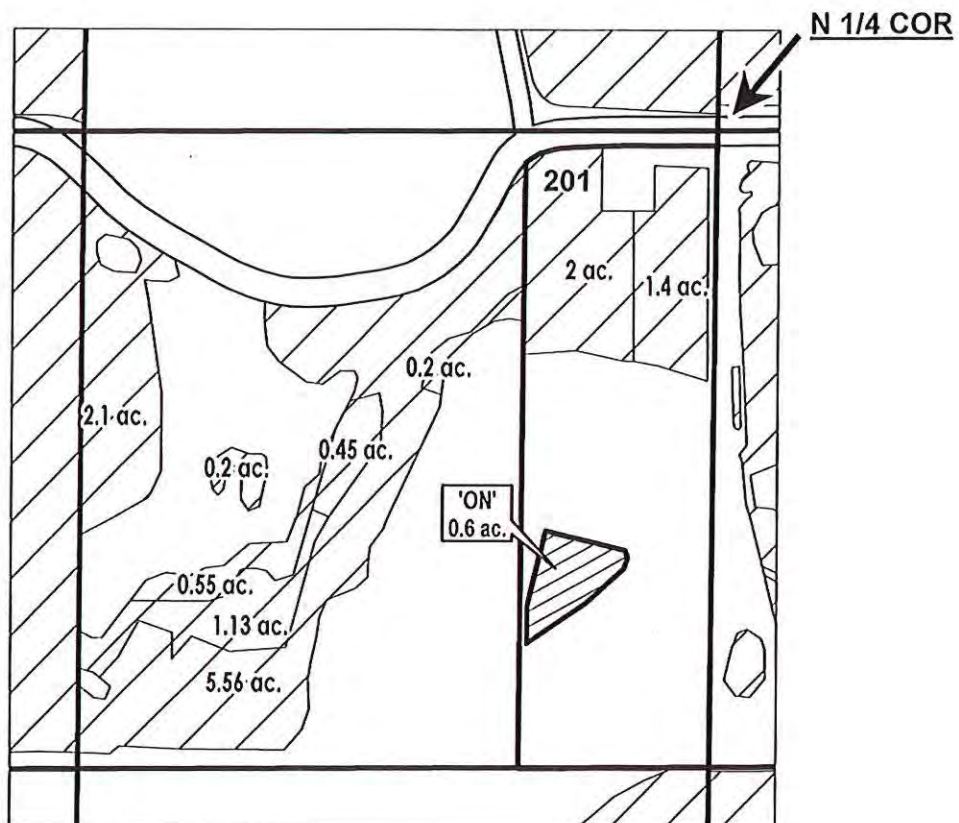

 EXISTING WATER RIGHTS
 ON LANDS

FINAL PROOF MAP

NAME: Hemphill, Carl/Cynthia

TAXLOT #: 201

0.6 ACRES



DATE: 9/1/2022

FINAL PROOF SITE REPORT

Claim of Beneficial Use

E-RECEIVED
09/15/2022
OWRD

Property Owner (Applicant): Hemphill, Carl/Cynthia

Petition #: P-2020-001

Current Owner:

OWRD#: T-13514

Property Address: 20140 NW Smith Rock Way

Notice #: T-2020-002

POD	USE	HG	TWP	RNG	SEC	QQ	TAX LOT	ACRES
11	IRRIG	L-1	14	14	19	NENW	201	0.60

- ☐ Person interviewed (if any): Cynthia Hemphill
- ☐ Method of irrigation (pump, flood, etc): flood
- ☐ Use (crops produced): Pasture
- ☐ Method used to calculate area irrigated: Trimble GPS
- ☐ Is beneficial use achieved: Yes, 0.60 ac.
- ☐ Dated photos of beneficial use: 7/1/21
- ☐ Are there any mapping changes: NO
- ☐ Submit map changes to mapping for updates to ARC. Date submitted: _____
- ☐ Update QQ/TL changes in WWIN: _____
- ☐ Enter use into WWIN: _____

IF INCOMPLETE:

- ☐ Failure to Prove up _____ acres of transferred water right
- ☐ Extension Filed: _____

NOTES:

1st Review:

Thick, tall pasture. Full bu achieved.

2nd Review:

3rd Review (if not complete assess \$150 fee)

Final Inspection by:

J. Talbot

Date:


7/1/21

CROOK COUNTY SEC.19 T14S R14E


E-RECEIVED
09/15/2022
OWRD

OWRD: T-13514

SCALE - 1" = 400'

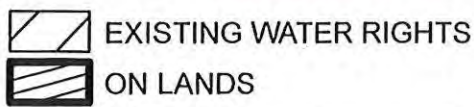

SE 1/4

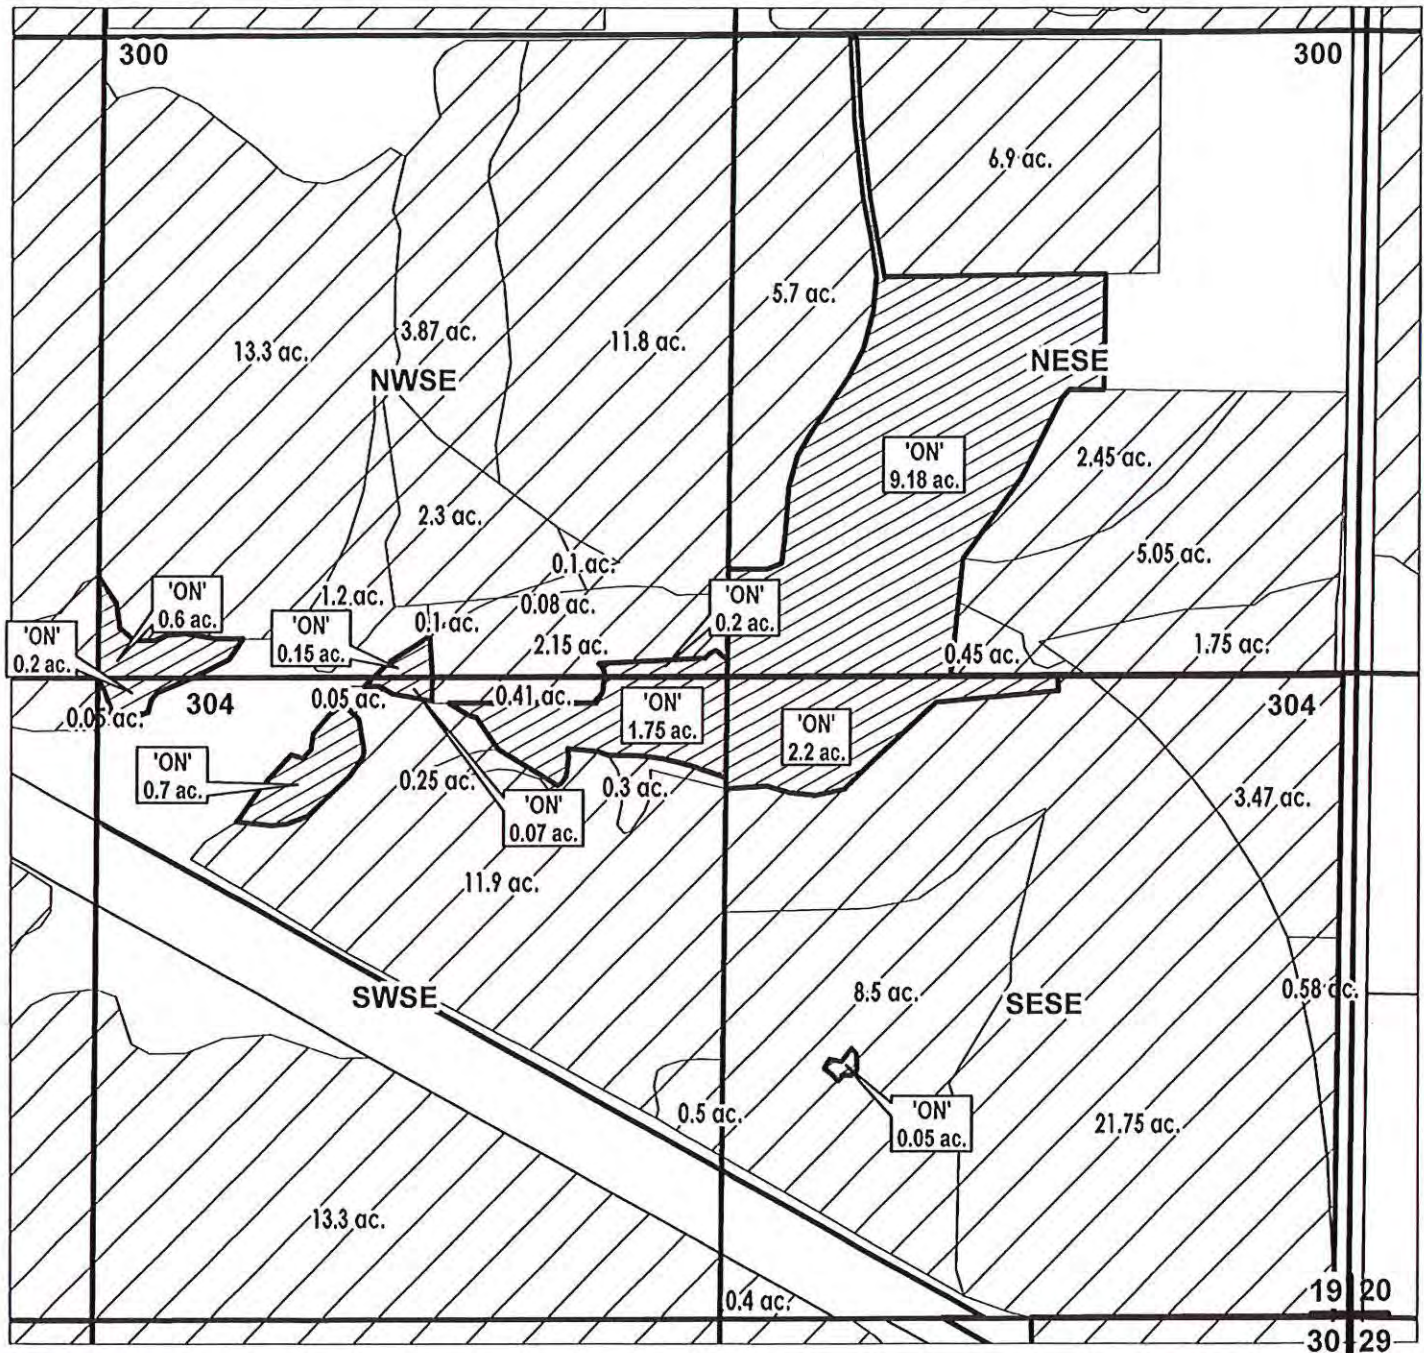

FINAL PROOF MAP

NAME: Kasberger Ranch, LLC

TAXLOT #: 300, 304

15.1 ACRES



DATE: 9/1/2022

FINAL PROOF SITE REPORT

Claim of Beneficial Use



Property Owner (Applicant): Kasberger Ranch LLC

Petition #: P-2020-001

Current Owner:

OWRD#: T-13514

Property Address: 4501 Lone Pine Rd

Notice #: T-2020-018

POD	USE	HG	TWP	RNG	SEC	QQ	TAX LOT	ACRES
11	IRRIG	L-1	14	14	19	NESE	300	9.18
11	IRRIG	L-1	14	14	19	NWSE	300	0.95
11	IRRIG	L-1	14	14	19	SESE	304	2.25
11	IRRIG	L-1	14	14	19	SWSE	304	2.72

- ☐ Person interviewed (if any): None
- ☐ Method of irrigation (pump, flood, etc): pump → pivots
- ☐ Use (crops produced): Grass Hay
- ☐ Method used to calculate area irrigated: Trimble GPS + Collector
- ☐ Is beneficial use achieved: Partial as of 7/13/21 Full use 7/12/22
- ☐ Dated photos of beneficial use: Partial 7/13/21 Full use 7/12/22
- ☐ Are there any mapping changes: NO
- ☐ Submit map changes to mapping for updates to ARC. Date submitted: _____
- ☐ Update QQ/TL changes in WWIN: _____
- ☐ Enter use into WWIN: 7/12/22

IF INCOMPLETE:

- ☐ Failure to Prove up _____ acres of transferred water right
- ☐ Extension Filed: _____

NOTES:

1st Review:

All proved up except 141419 NESE00300. mostly weeds, very little grass.

2nd Review:

7/12/22 full use. Established pasture mix. Weeds still present.

3rd Review (if not complete assess \$150 fee)

Final Inspection by: [Signature] Date: 7/12/22

DESCHUTES COUNTY SEC.25 T15S R12E


E-RECEIVED
09/15/2022
OWRD

SCALE - 1" = 400'



NE 1/4 OF THE NE 1/4

OWRD: T-13514

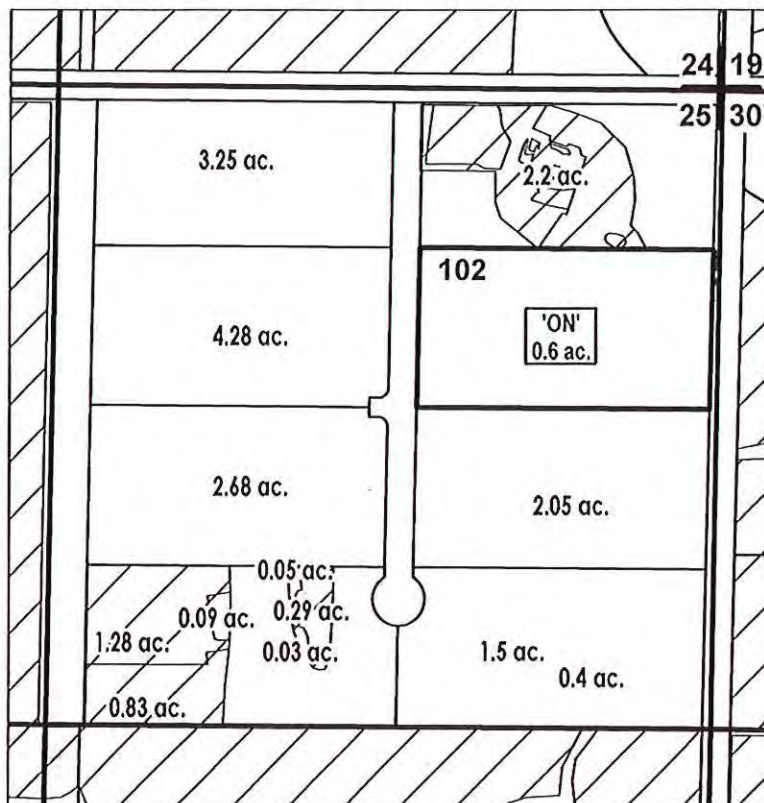

	EXISTING WATER RIGHTS
	'ON' LAND PARCELS
	PARCELS W/ WATER RIGHTS



FINAL PROOF MAP

NAME: Widmer, Sidney/Melanie

TAXLOT #: 102

0.6 ACRES

DATE: 9/1/2022

FINAL PROOF SITE REPORT

Claim of Beneficial Use



Property Owner (Applicant): Widmer, Sidney/Melanie

Petition #: P-2020-001

Current Owner:

OWRD#: T-13514

Property Address: 3150 SW 53rd Redmond

Notice #: T-2020-005

POD	USE	HG	TWP	RNG	SEC	QQ	TAX LOT	ACRES
11	IRRIG	B-2-4-3	15	12	25	NENE	102	0.60

- ☐ Person interviewed (if any): none
- ☐ Method of irrigation (pump, flood, etc): pump - Kline
- ☐ Use (crops produced): none-weeds 7/5/22 pasture mix + wild flowers
- ☐ Method used to calculate area irrigated: field maps
- ☐ Is beneficial use achieved: as of 7/22, NO. 5/5/22 NO 7/5/22 yes.
- ☐ Dated photos of beneficial use: 7/5/22
- ☐ Are there any mapping changes: NO
- ☐ Submit map changes to mapping for updates to ARC. Date submitted: _____
- ☐ Update QQ/TL changes in WWIN: _____
- ☐ Enter use into WWIN: 7/7/22

IF INCOMPLETE:

- ☐ Failure to Prove up _____ acres of transferred water right
- ☐ Extension Filed: _____

NOTES:

1st Review:

7/22/21 NO BU. weeds and wild flowers. Pictures in collector informed pation of BU.

2nd Review:

5/5/22 NO BU. freshly mowed. Brown dead weeds and some brown grass. Looks like they are preparing to turn on water

3rd Review (if not complete assess \$150 fee)

7/5/22 Full BU. Irrigated pasture mix with wild flowers. Weeds present.

Final Inspection by: [Signature]

Date: 7/5/22

DESCHUTES COUNTY SEC.31 T15S R13E


E-RECEIVED
09/15/2022
OWRD

SCALE - 1" = 400'



SE 1/4 OF THE NW 1/4

OWRD: T-13514

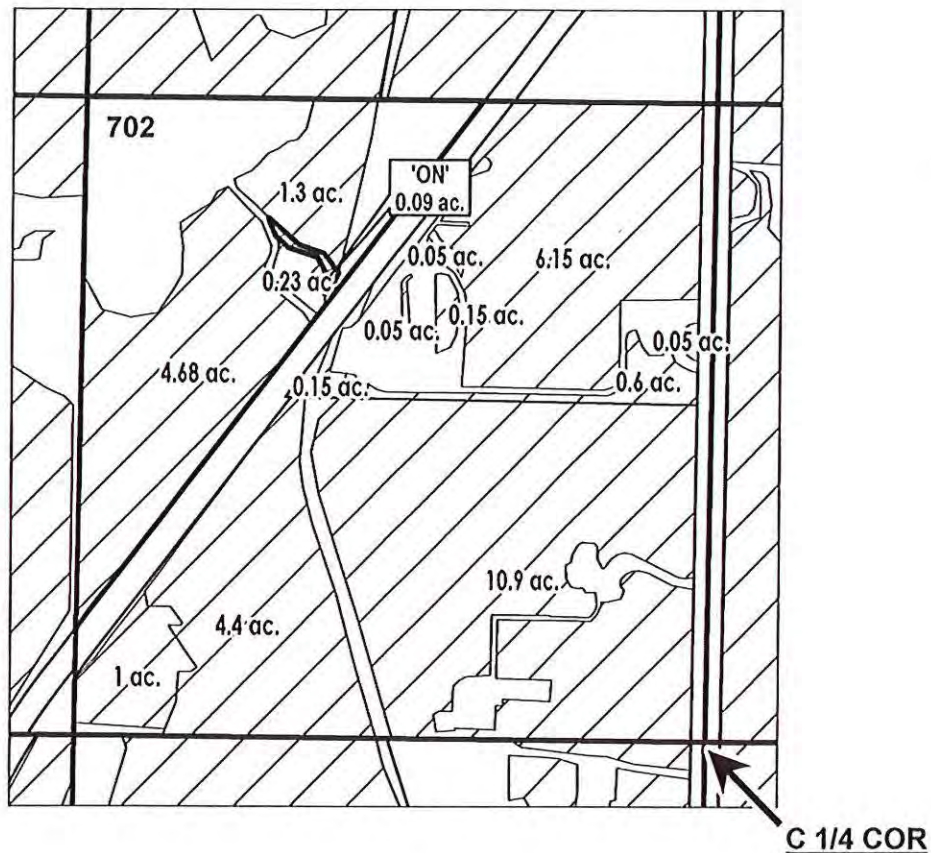

 EXISTING WATER RIGHTS
 ON LANDS

FINAL PROOF MAP

NAME: Endicott, George/Krisanna

TAXLOT #: 702

0.09 ACRES



DATE: 9/1/2022

FINAL PROOF SITE REPORT

Claim of Beneficial Use



Property Owner (Applicant): Endicott, George/Krisanna

Petition #: P-2020-001

Current Owner:

OWRD#: T-13514

Property Address: 5247 SW Canal Blvd Redmond

Notice #: T-2020-026

POD	USE	HG	TWP	RNG	SEC	QQ	TAX LOT	ACRES
11	IRRIG	B-2-5-1	15	13	31	SENW	702	0.09

- ☒ Person interviewed (if any): Yes, George
- ☐ Method of irrigation (pump, flood, etc): floods
- ☐ Use (crops produced): yes, pasture
- ☐ Method used to calculate area irrigated: field maps
- ☐ Is beneficial use achieved: No as of 7/22/21 or 5/5/22 Yes as of 7/5/22
- ☐ Dated photos of beneficial use: 5/5/22 7/5/22
- ☐ Are there any mapping changes: NO
- ☐ Submit map changes to mapping for updates to ARC. Date submitted: _____
- ☐ Update QQ/TL changes in WWIN: _____
- ☐ Enter use into WWIN: yes 7/7/22

IF INCOMPLETE:

- ☐ Failure to Prove up _____ acres of transferred water right
- ☐ Extension Filed: _____

NOTES:

1st Review:

Half done. New seed to the east. Seed to the west is dried up.
Pictures in collector.
Informed patron of BU.

2nd Review:

5/5/22 Not being irrigated. Shallow sandy area
with little grass. New photos in collector.

3rd Review (if not complete assess \$150 fee)

7/5/22 Full use. Reseeded and added top
soil to keep moisture.

Final Inspection by: [Signature]

Date: 7/5/22

DESCHUTES COUNTY SEC.11 T16S R12E



E-RECEIVED
09/15/2022
OWRD

SCALE - 1" = 400'



NE 1/4 OF THE NW 1/4

OWRD #: T-13514

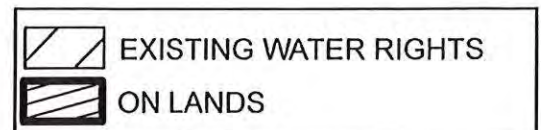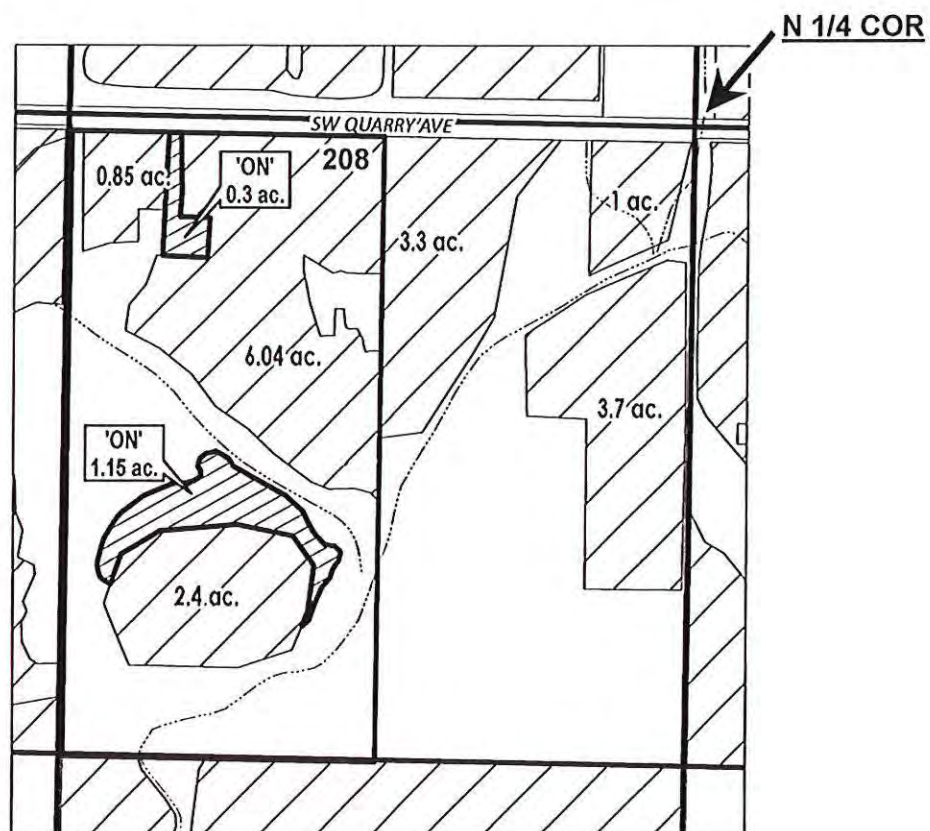

FINAL PROOF MAP

STACY AND MATTHEW NAHLIK

TAXLOT #: 208

1.45 ACRES

Date: 8/6/2021

FINAL PROOF SITE REPORT

Claim of Beneficial Use



Property Owner (Applicant): Nahlik, Stacy/Matthew

Petition #: P-2020-001

Current Owner:

OWRD#: T-13514

Property Address: 7000 SW Quarry Ave Redmond

Notice #: T-2020-011

POD	USE	HG	TWP	RNG	SEC	QQ	TAX LOT	ACRES
11	IRRIG	A-21-7-1	16	12	11	NENW	208	1.45

- ☐ Person interviewed (if any): Matthew
- ☐ Method of irrigation (pump, flood, etc): Pump/sprinkle
- ☐ Use (crops produced): pasture grass
- ☐ Method used to calculate area irrigated: _____

- ☐ Is beneficial use achieved: Yes

- ☐ Dated photos of beneficial use: 8-4-21

- ☐ Are there any mapping changes: Yes - slight polygon Adj.

○ Submit map changes to mapping for updates to ARC. Date submitted: _____

○ Update QQ/TL changes in WWIN: _____

- ☐ Enter use into WWIN: _____

IF INCOMPLETE:

- ☐ Failure to Prove up _____ acres of transferred water right

- ☐ Extension Filed: _____

NOTES:

1st Review:

Remap to area that he is actively irrigating.
About 4 inches tall pasture mix. Some areas
mixed with weeds.

2nd Review:

3rd Review (if not complete assess \$150 fee)

Final Inspection by: _____ Date: _____

DESCHUTES COUNTY SEC.26 T16S R12E


E-RECEIVED
09/15/2022
OWRD

SCALE - 1" = 400'



NW 1/4 OF THE NE 1/4; NE 1/4 OF THE NE 1/4

OWRD: T-13514

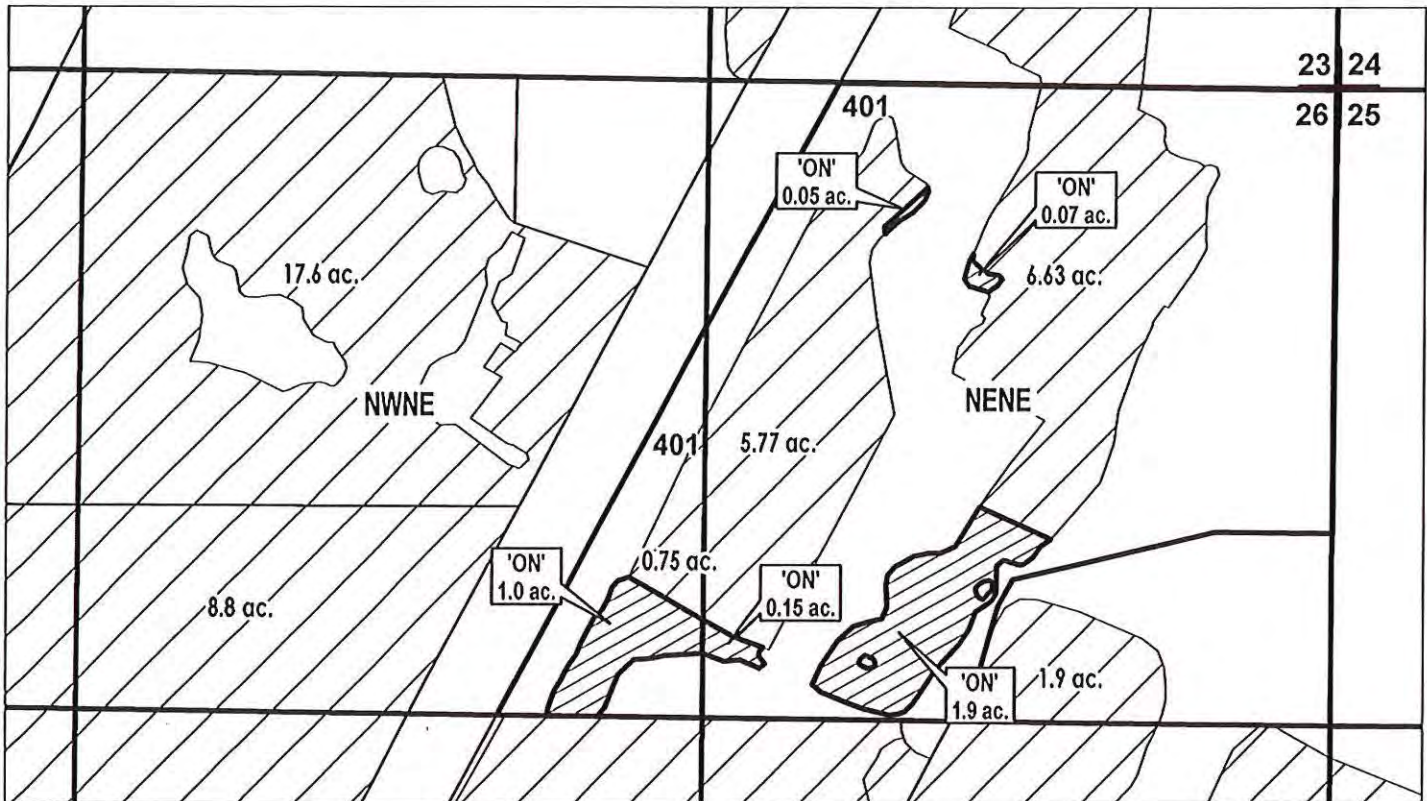

EXISTING WATER RIGHTS
ON LANDS

FINAL PROOF MAP

NAME: Parsons, Leo D.

TAXLOT #: 702

3.17 ACRES



DATE: 9/2/2022

FINAL PROOF SITE REPORT

Claim of Beneficial Use



Property Owner (Applicant): Parsons, Leo D.

Petition #: P-2020-001

Current Owner:

OWRD#: T-13514

Property Address: 21412 Morrill Rd Bend

Notice #: T-2020-015

POD	USE	HG	TWP	RNG	SEC	QQ	TAX LOT	ACRES
11	IRRIG	A-12-13	16	12	26	NENE	401	2.17
11	IRRIG	A-12-13	16	12	26	NWNE	401	1.0

- ☐ Person interviewed (if any): Ty (Leo's son)
- ☐ Method of irrigation (pump, flood, etc.): pump - wheel line
- ☐ Use (crops produced): Teff is planted with orchard mix
- ☐ Method used to calculate area irrigated: _____
- ☐ Is beneficial use achieved: Just planted as of 5/17/22 / Yes as of 8/11/22
- ☐ Dated photos of beneficial use: 8/11/22
- ☐ Are there any mapping changes: NO
- ☐ Submit map changes to mapping for updates to ARC. Date submitted: _____
- ☐ Update QQ/TL changes in WWIN: _____
- ☐ Enter use into WWIN: _____

IF INCOMPLETE:

- ☐ Failure to Prove up _____ acres of transferred water right
- ☐ Extension Filed: _____

NOTES:

1st Review:

5/17/22 Pasture is recently worked. Spoke w/ Ty Parsons and he said they just planted a Teff/orchard mix. Revisit mid-late June 2022

2nd Review:

8/11/22 Full BU of transferred w.r. 8" good growth. Some weeds due to new crop.

3rd Review (if not complete assess \$150 fee)

Final Inspection by: J. Talbot

Date: 8/11/22

DESCHUTES COUNTY SEC.35 T16S R12E

E-RECEIVED
09/15/2022
OWRD


SCALE - 1" = 400'




NW 1/4 OF THE SE 1/4

OWRD #: T-13514

C 1/4 COR

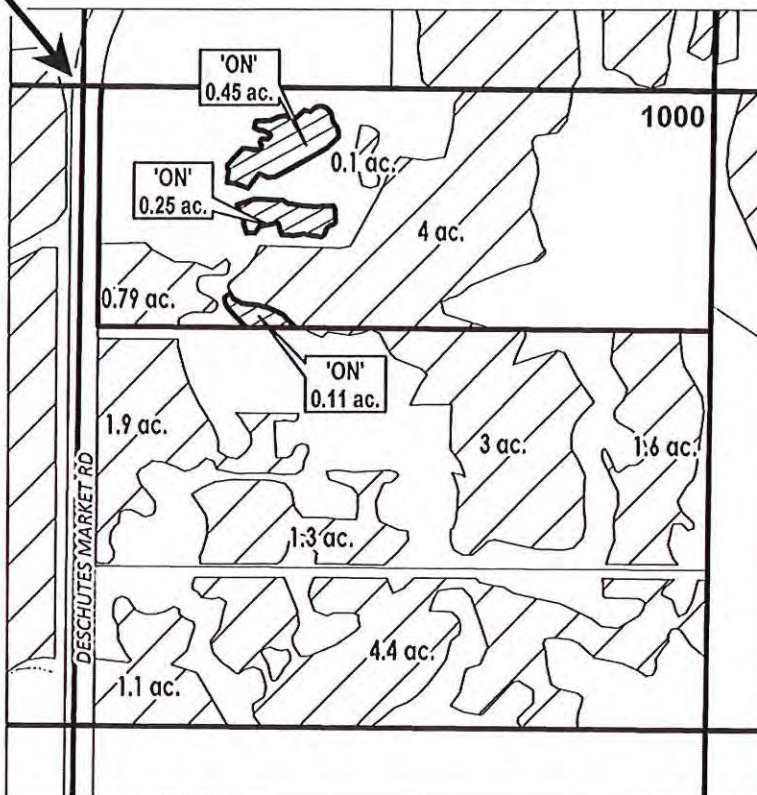

"ON" MAP

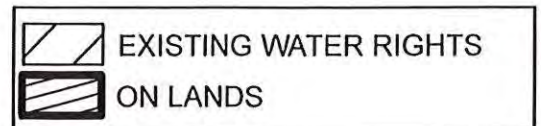

FINAL PROOF MAP

Matthew and Jessica Shaffer

TAXLOT #: 1000

0.81 ACRES



Date: 8/4/2021

FINAL PROOF SITE REPORT

Claim of Beneficial Use



Property Owner (Applicant): Shaffer, Matthew

Petition #: P-2020-001

Current Owner:

OWRD#: T-13514

Property Address: 64590 Deschutes Market Rd Bend

Notice #: T-2020-008

POD	USE	HG	TWP	RNG	SEC	QQ	TAX LOT	ACRES
11	IRRIG	A-12-2	16	12	35	NWSE	1000	0.81

- ☐ Person interviewed (if any): None
- ☐ Method of irrigation (pump, flood, etc): Pump/Hand Line
- ☐ Use (crops produced): Irrigation
- ☐ Method used to calculate area irrigated: _____
- ☐ Is beneficial use achieved: Yes
- ☐ Dated photos of beneficial use: 8-3-21
- ☐ Are there any mapping changes: Yes
- ☐ Submit map changes to mapping for updates to ARC. Date submitted: 8-4-21
- ☐ Update QQ/TL changes in WWIN: _____
- ☐ Enter use into WWIN: _____

IF INCOMPLETE:

- ☐ Failure to Prove up _____ acres of transferred water right
- ☐ Extension Filed: _____

NOTES:

1st Review:

8/3/21 Full use. Established
yard used as soccer field

2nd Review:

3rd Review (if not complete assess \$150 fee)

Final Inspection by: _____

Jalboth

Date: 8/3/21

DESCHUTES COUNTY SEC.29 T17S R12E

E-RECEIVED
09/15/2022
OWRD

SCALE - 1" = 400'



SE 1/4 OF THE NW 1/4

OWRD: T-13514



C 1/4 COR

 EXISTING WATER RIGHTS
 ON LANDS



FINAL PROOF MAP

NAME: River's Edge Community Master Association

TAXLOT #: 101

0.15 ACRES

DATE: 9/2/2022

FINAL PROOF SITE REPORT

Claim of Beneficial Use



Property Owner (Applicant): River's Edge Investments

Petition #: P-2020-001

Current Owner:

OWRD#: T-13514

Property Address: 5200 NW Mt Washington

Notice #: T-2020-019

POD	USE	HG	TWP	RNG	SEC	QQ	TAX LOT	ACRES
11	IRRIG	RV-10	17	12	29	SENW	101	0.15

- ☐ Person interviewed (if any): None
- ☐ Method of irrigation (pump, flood, etc): Sprinkle
- ☐ Use (crops produced): Landscape/Golf
- ☐ Method used to calculate area irrigated: _____

☐ Is beneficial use achieved: Yes

☐ Dated photos of beneficial use: 8-5-21

☐ Are there any mapping changes: No

○ Submit map changes to mapping for updates to ARC. Date submitted: _____

○ Update QQ/TL changes in WWIN: _____

☐ Enter use into WWIN: _____

IF INCOMPLETE:

☐ Failure to Prove up _____ acres of transferred water right

☐ Extension Filed: _____

NOTES:

1st Review:

BU achieved. Green grass for golf.

2nd Review:

3rd Review (if not complete assess \$150 fee)

Final Inspection by: _____

Date: _____

8-5-21

DESCHUTES COUNTY SEC.19 T17S R13E



E-RECEIVED
09/15/2022
OWRD

SCALE - 1" = 400'



SE 1/4 OF THE NW 1/4

OWRD #: T-13514

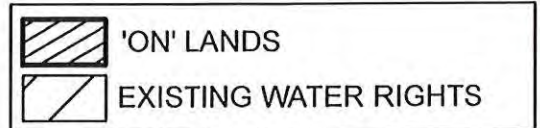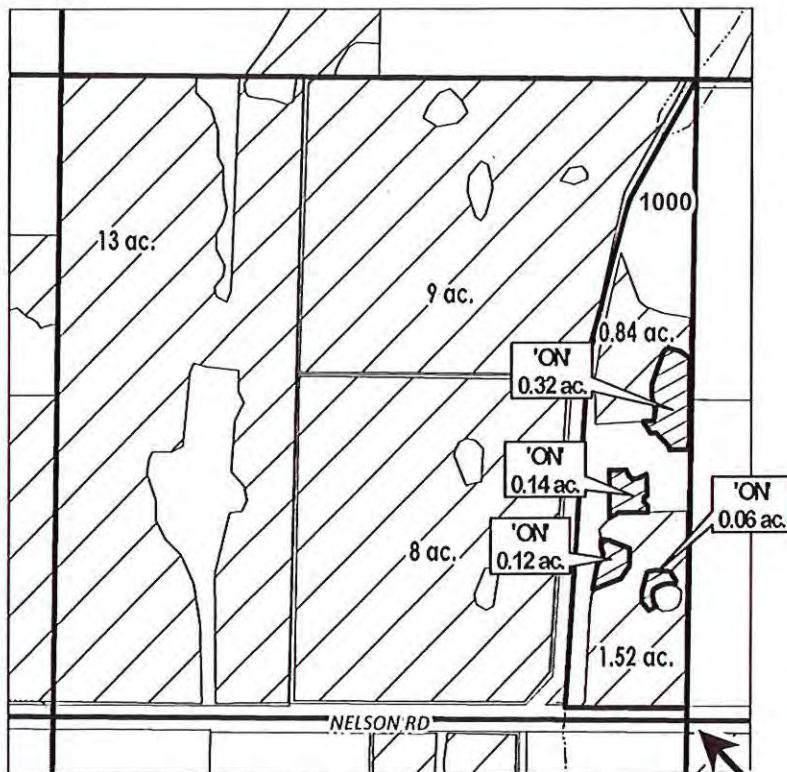

FINAL PROOF MAP

NAME: Christopher D and Kit A. Larsen

TAXLOT #: 1000

0.64 ACRES



Date: 9/7/2021

FINAL PROOF SITE REPORT

Claim of Beneficial Use



Property Owner (Applicant): Larsen, Chris/Kit

Petition #: P-2020-001

Current Owner:

OWRD#: T-13514

Property Address: 22180 Nelson Rd Bend

Notice #: T-2020-017

POD	USE	HG	TWP	RNG	SEC	QQ	TAX LOT	ACRES
1	IRRIG	B-29-3	17	13	19	SENW	1000	0.64

- ☐ Person interviewed (if any): None
- ☐ Method of irrigation (pump, flood, etc): Hand Line / Pump
- ☐ Use (crops produced): Pasture Grass / Irrigation
- ☐ Method used to calculate area irrigated: _____
- ☐ Is beneficial use achieved: Yes
- ☐ Dated photos of beneficial use: 8-3-21
- ☐ Are there any mapping changes: No
- ☐ Submit map changes to mapping for updates to ARC. Date submitted: _____
- ☐ Update QQ/TL changes in WWIN: _____
- ☐ Enter use into WWIN: _____

IF INCOMPLETE:

- ☐ Failure to Prove up _____ acres of transferred water right
- ☐ Extension Filed: _____

NOTES:

1st Review:

BU achieved. Some thin soil was green earlier in season. size less than 0.02 acres old dry spots

2nd Review:

3rd Review (if not complete assess \$150 fee)

Final Inspection by: SS

Date: 8-3-21

DESCHUTES COUNTY SEC.30 T17S R13E


E-RECEIVED
09/15/2022
OWRD

SCALE - 1" = 400'



NE 1/4 OF THE NW 1/4

OWRD: T-13514

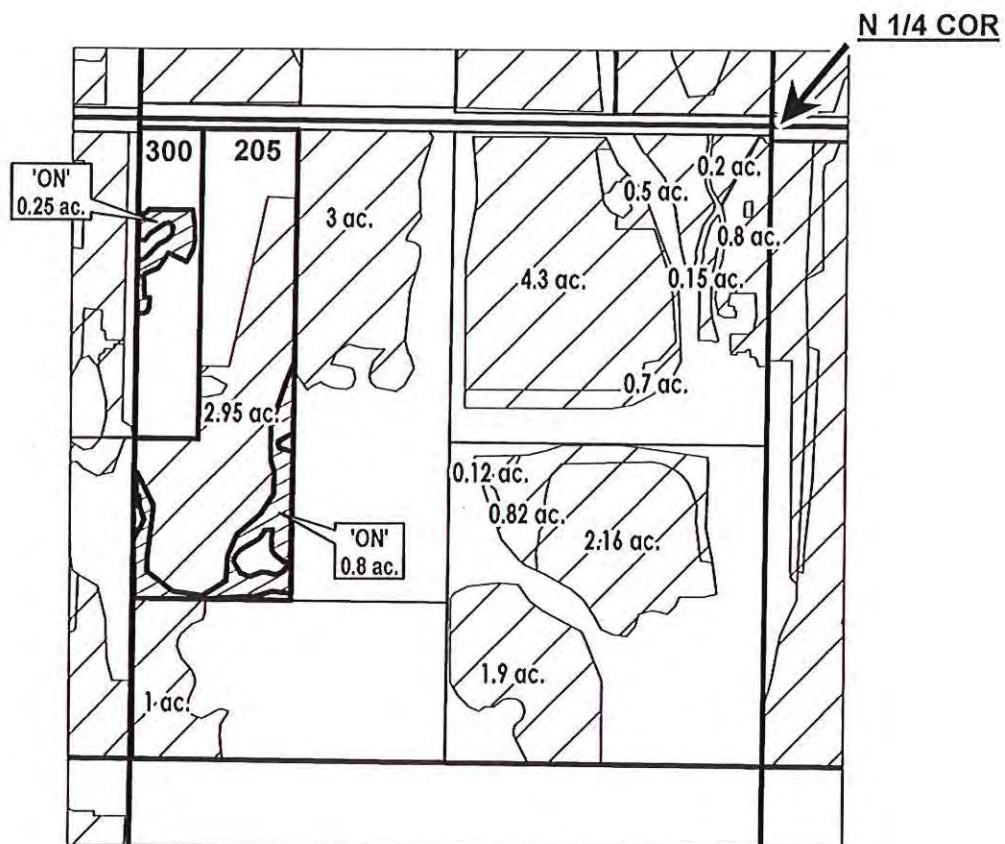

 EXISTING WATER RIGHTS
 ON LANDS

FINAL PROOF MAP

NAME: Bomke, Kurt/Jennifer

TAXLOT #: 205, 300

1.05 ACRES



DATE: 9/2/2022

FINAL PROOF SITE REPORT

Claim of Beneficial Use



Property Owner (Applicant): Bomke, Kurt/Jennifer

Petition #: P-2020-001

Current Owner:

OWRD#: T-13514

Property Address: 22105/22115 Erickson Rd

Notice #: T-2020-001

POD	USE	HG	TWP	RNG	SEC	QQ	TAX LOT	ACRES
1	IRRIG	B-20	17	13	30	NENW	205	0.80
1	IRRIG	B-20	17	13	30	NENW	300	0.25

- ☐ Person interviewed (if any): Jennifer Bomke
- ☐ Method of irrigation (pump, flood, etc): flood
- ☐ Use (crops produced): horse pasture
- ☐ Method used to calculate area irrigated: field maps
- ☐ Is beneficial use achieved: yes.
- ☐ Dated photos of beneficial use: 10/22/22
- ☐ Are there any mapping changes: No
- ☐ Submit map changes to mapping for updates to ARC. Date submitted: _____
- ☐ Update QQ/TL changes in WWIN: _____
- ☐ Enter use into WWIN: 10/23/22

IF INCOMPLETE:

- ☐ Failure to Prove up _____ acres of transferred water right
- ☐ Extension Filed: _____

NOTES:

1st Review:

Established horse / cow pasture.

central organ mix.

2nd Review:

lightly grazed by cows.

3rd Review (if not complete assess \$150 fee)

Final Inspection by:

[Signature]

Date:

11/22/22

DESCHUTES COUNTY SEC.13 T17S R14E


E-RECEIVED
09/15/2022
OWRD

SCALE - 1" = 400'



SW 1/4 OF THE SE 1/4

OWRD #: T-13514

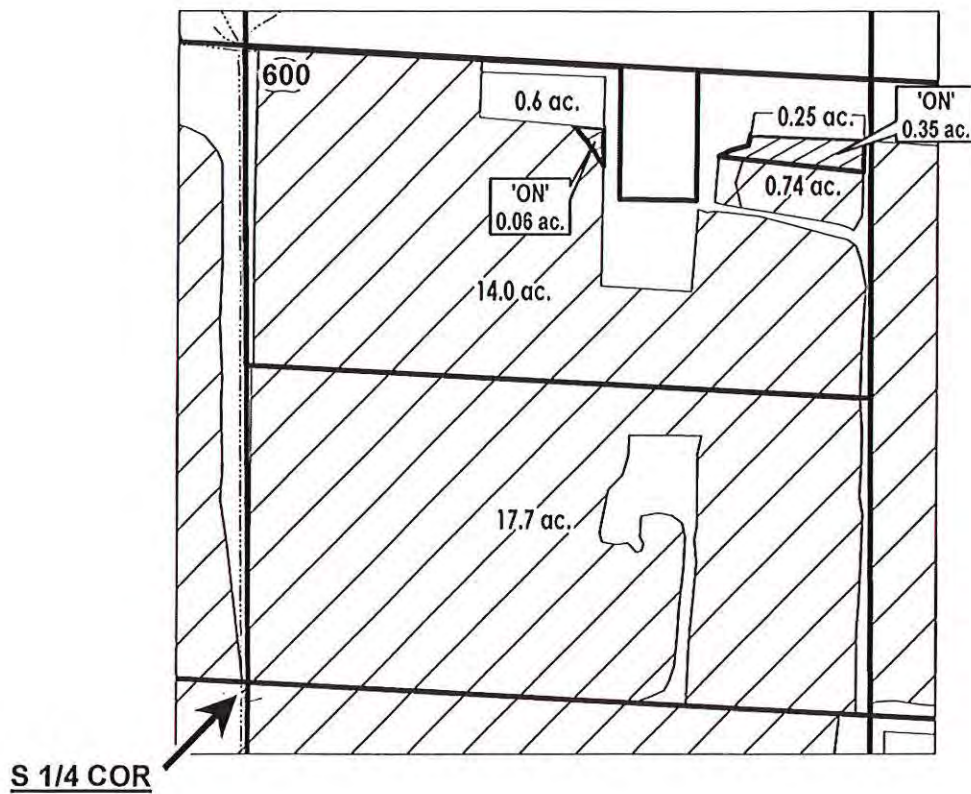

	NOTICE SUBMITTED
	EXISTING WATER RIGHTS
	ON LANDS

FINAL PROOF MAP

Robert E. Jr. and Erynne E. Fore

TAXLOT #: 600

0.41 ACRES



Date: 9/7/2021

FINAL PROOF SITE REPORT

Claim of Beneficial Use



Property Owner (Applicant): Fore, Robert Jr./Erynne

Petition #: P-2020-001

Current Owner:

OWRD#: T-13514

Property Address: 26630 Horsell Rd Bend

Notice #: T-2020-012

POD	USE	HG	TWP	RNG	SEC	QQ	TAX LOT	ACRES
1	IRRIG	I-27	17	14	13	SWSE	600	0.41

- ☐ Person interviewed (if any): None
- ☐ Method of irrigation (pump, flood, etc): K-Line
- ☐ Use (crops produced): Pasture
- ☐ Method used to calculate area irrigated: _____
- ☐ Is beneficial use achieved: Yes
- ☐ Dated photos of beneficial use: 8-3-21
- ☐ Are there any mapping changes: No
- ☐ Submit map changes to mapping for updates to ARC. Date submitted: _____
- ☐ Update QQ/TL changes in WWIN: _____
- ☐ Enter use into WWIN: _____

IF INCOMPLETE:

- ☐ Failure to Prove up _____ acres of transferred water right
- ☐ Extension Filed: _____

NOTES:

1st Review: BU achieved. Pasture gross in both areas

2nd Review: _____

3rd Review (if not complete assess \$150 fee) _____

Final Inspection by: [Signature] Date: 9/14/22

DESCHUTES COUNTY
SEC.23 T17S R14E


E-RECEIVED
09/15/2022
OWRD

SCALE - 1" = 400'



SE 1/4 OF THE NW 1/4

OWRD #: T-13514

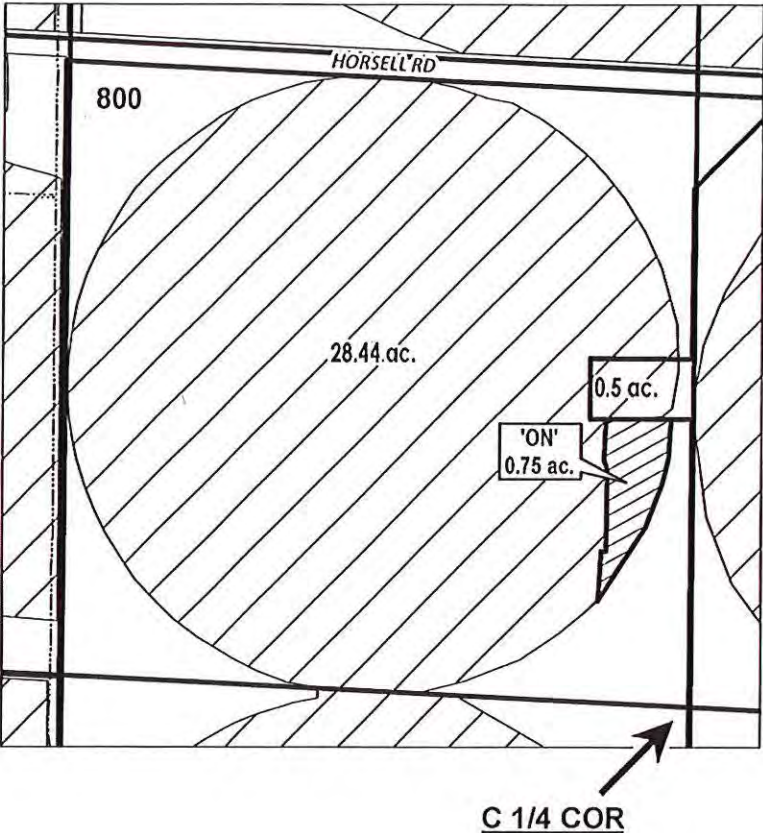

 EXISTING WATER RIGHTS
 ON LANDS

FINAL PROOF MAP

NAME: 9 Mile Farm, LLC

TAXLOT #: 800

0.75 ACRES



Date: 8/4/2021

FINAL PROOF SITE REPORT

Claim of Beneficial Use



Property Owner (Applicant): Middleton, Keith

Petition #: P-2020-001

Current Owner: 9 mile Farm, LLC

OWRD#: T-13514

Property Address: 26245 Horsell Rd Bend

Notice #: T-2020-009

POD	USE	HG	TWP	RNG	SEC	QQ	TAX LOT	ACRES
1	IRRIG	I-3-7	17	14	23	SENW	800	0.75

- ☐ Person interviewed (if any): Keith
- ☐ Method of irrigation (pump, flood, etc): Pivot
- ☐ Use (crops produced): ~~Pasture~~ Hay
- ☐ Method used to calculate area irrigated: _____
- ☐ Is beneficial use achieved: Yes
- ☐ Dated photos of beneficial use: 8-3-21
- ☐ Are there any mapping changes: _____
- ☐ Submit map changes to mapping for updates to ARC. Date submitted: _____
- ☐ Update QQ/TL changes in WWIN: _____
- ☐ Enter use into WWIN: _____

IF INCOMPLETE:

- ☐ Failure to Prove up _____ acres of transferred water right
- ☐ Extension Filed: _____

NOTES:

1st Review: 8-3-21 SR. Pivot going. Hay
5 inches thick crop Pasture grass 2nd Cutting

2nd Review: _____

3rd Review (if not complete assess \$150 fee) _____

Final Inspection by: [Signature]

Date: 8/3/21

DESCHUTES COUNTY
SEC.27 T17S R14E


E-RECEIVED
09/15/2022
OWRD

SCALE - 1" = 400'



NW 1/4 OF THE SW 1/4; NE 1/4 OF THE SW 1/4

OWRD: T-13514

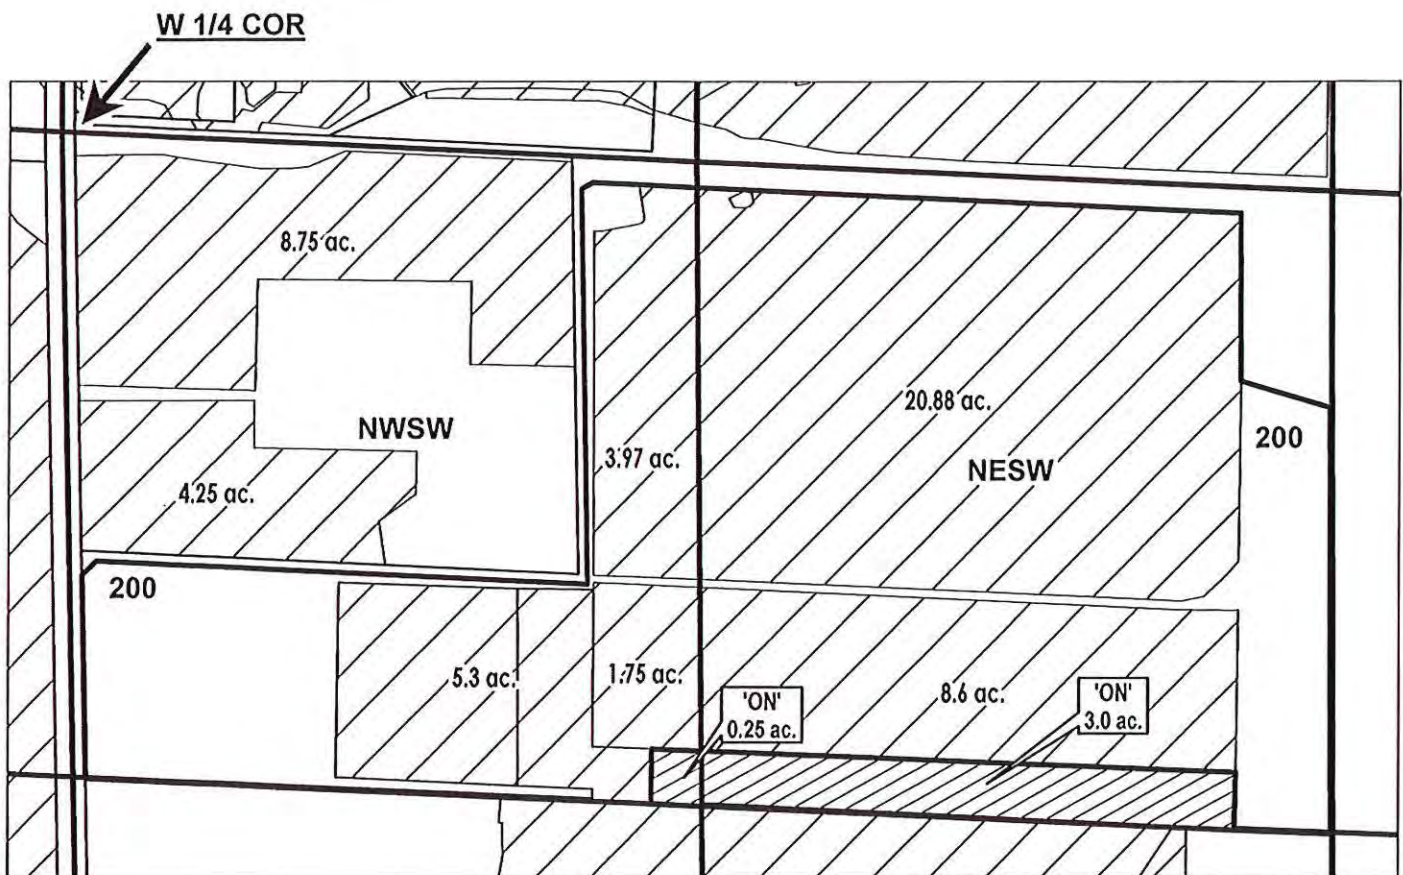

EXISTING WATER RIGHTS
ON LANDS



FINAL PROOF MAP

NAME: Luke Dynes

TAXLOT #: 200

3.25 ACRES

DATE: 9/2/2022

FINAL PROOF SITE REPORT

Claim of Beneficial Use

E-RECEIVED
09/15/2022
OWRD

Property Owner (Applicant): Mulcahy, Richard/Denise

Petition #: P-2020-001

Current Owner: Luke Dynes

OWRD#: T-13514

Property Address: 62550 Dodds Rd Bend

Notice #: T-2020-014

POD	USE	HG	TWP	RNG	SEC	QQ	TAX LOT	ACRES
1	IRRIG	H-20	17	14	27	NESW	200	3.0
1	IRRIG	H-20	17	14	27	NWSW	200	0.25

- ☐ Person interviewed (if any): None 6/22/22 Russell - Ranch Manager
- ☐ Method of irrigation (pump, flood, etc): Wheel Line
- ☐ Use (crops produced): Pasture mix
- ☐ Method used to calculate area irrigated: field maps

- ☐ Is beneficial use achieved: NO. Dry 7-30-21 (6/22/22 New seed)

- ☐ Dated photos of beneficial use: 6/22/22

- ☐ Are there any mapping changes: NO
- ☐ Submit map changes to mapping for updates to ARC. Date submitted: _____
- ☐ Update QQ/TL changes in WWIN: _____

- ☐ Enter use into WWIN: 6/23/22

IF INCOMPLETE:

- ☐ Failure to Prove up _____ acres of transferred water right
- ☐ Extension Filed: _____

NOTES:

1st Review:
7-30-21 No BU achieved. Completely Dry

2nd Review:
6/22/22 New seed. Being irrigated w/ wheel line. Improvement from 2021. Field was previously DM temp.

3rd Review (if not complete assess \$150 fee)

Final Inspection by: J. Talbot

Date: 6/28/22

DESCHUTES COUNTY
SEC.28 T17S R14E


E-RECEIVED
09/15/2022
OWRD

SCALE - 1" = 400'



NW 1/4 OF THE NE 1/4; SW 1/4 OF THE NE 1/4

OWRD #: T-13514

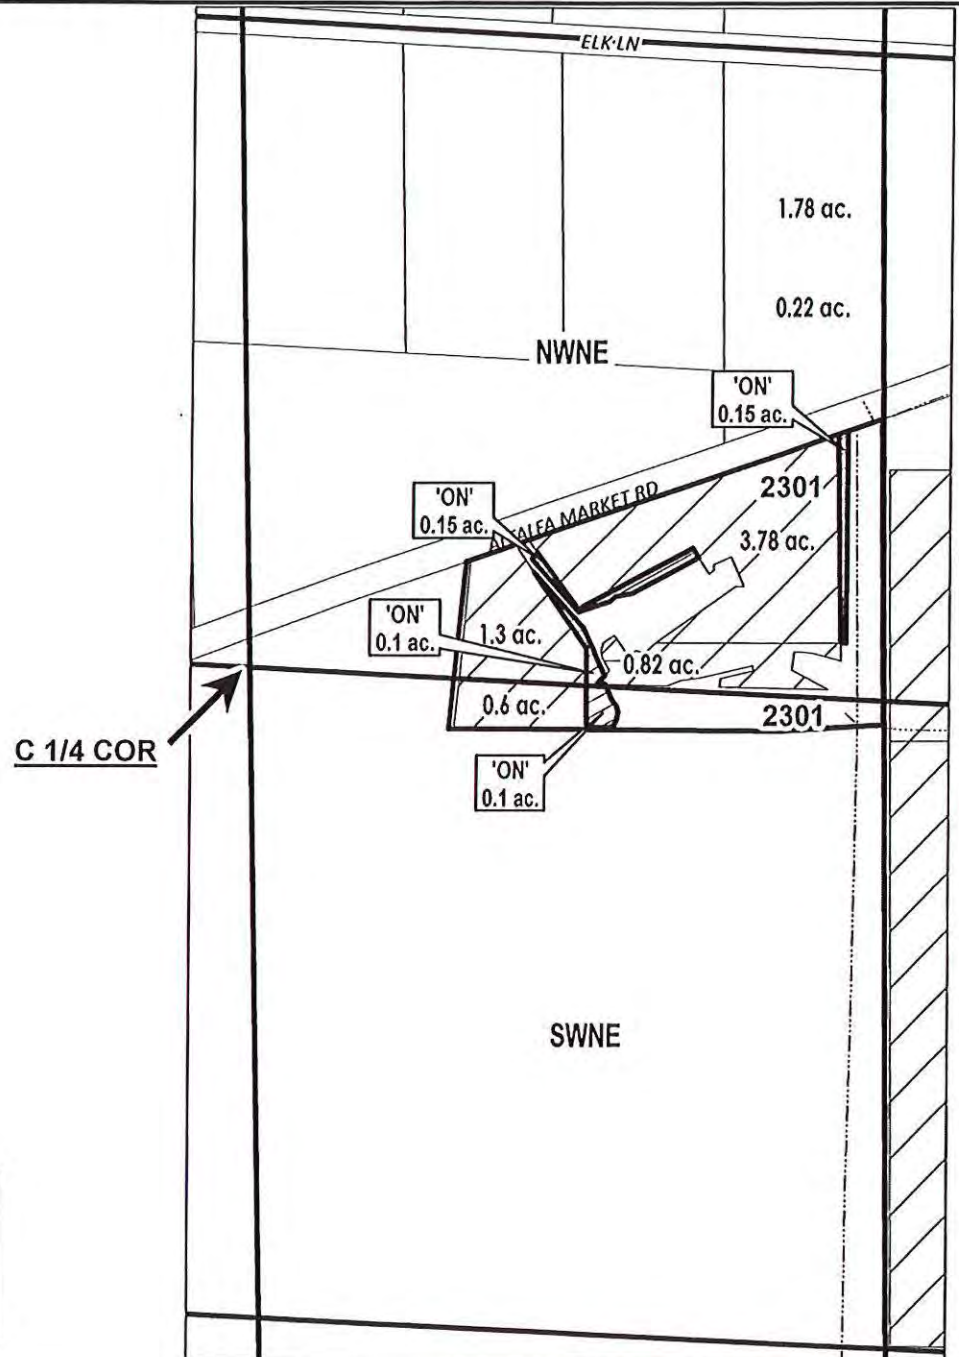

- 'ON' LANDS
- # ac. PARCELS W/ WATER RIGHTS
- EXISTING WATER RIGHTS

FINAL PROOF MAP

NAME: CURT G. JENO

TAXLOT #: 2301

0.5 ACRES



Date: 9/7/2021

FINAL PROOF SITE REPORT

Claim of Beneficial Use



Property Owner (Applicant): Jeno, Florence Revocable Trust

Petition #: P-2020-001

Current Owner: Jeno, Curt

OWRD#: T-13514

Property Address: 25451 Alfalfa Mkt Rd Bend

Notice #: T-2020-016

POD	USE	HG	TWP	RNG	SEC	QQ	TAX LOT	ACRES
1	IRRIG	H-15-3	17	14	28	NWNE	2301	0.40
1	IRRIG	H-15-3	17	14	28	SWNE	2301	0.10

- ☐ Person interviewed (if any): NDW
- ☐ Method of irrigation (pump, flood, etc): wheel line
- ☐ Use (crops produced): pasture gross
- ☐ Method used to calculate area irrigated: Collector/Trimble GPS

☐ Is beneficial use achieved: Yes

☐ Dated photos of beneficial use: 7-30-21

☐ Are there any mapping changes: No

o Submit map changes to mapping for updates to ARC. Date submitted: _____

o Update QQ/TL changes in WWIN: _____

☐ Enter use into WWIN: _____

IF INCOMPLETE:

☐ Failure to Prove up _____ acres of transferred water right

☐ Extension Filed: _____

NOTES:

1st Review: 7-30-21 Bu achieved. Active irrigation with wheel line

2nd Review: _____

3rd Review (if not complete assess \$150 fee) _____

Final Inspection by: [Signature] Date: 7-30-21

DESCHUTES COUNTY
SEC.02 T18S R13E


E-RECEIVED
09/15/2022
OWRD

SCALE - 1" = 400'



SW 1/4 OF THE SE 1/4; SE 1/4 OF THE SE 1/4

OWRD: T-13514

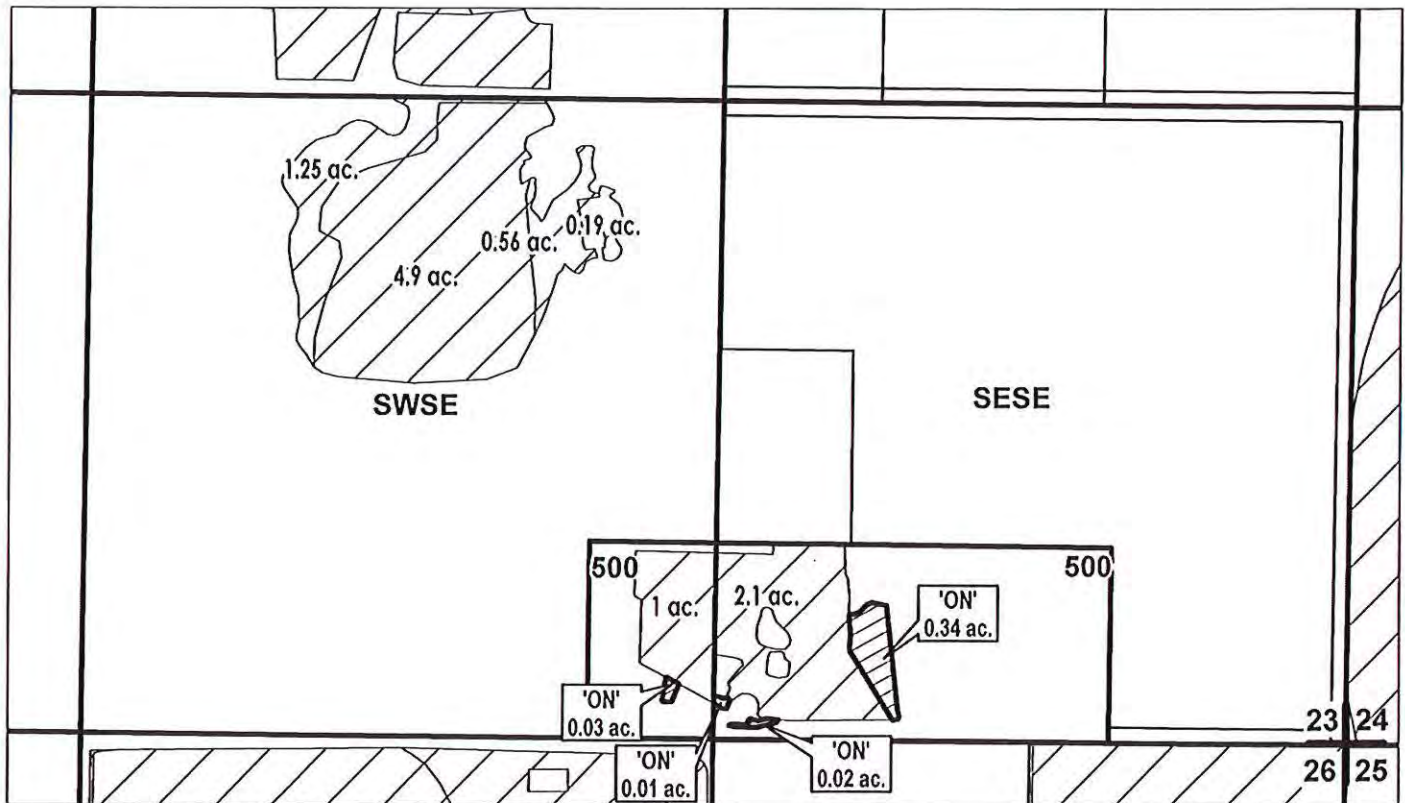

EXISTING WATER RIGHTS
ON LANDS



FINAL PROOF MAP

NAME: Norwood, Ryan/Ali

TAXLOT #: 500

0.4 ACRES

DATE: 9/2/2022

FINAL PROOF SITE REPORT

Claim of Beneficial Use



Property Owner (Applicant): Norwood, Ryan/Ali

Petition #: P-2020-001

Current Owner:

OWRD#: T-13514

Property Address: 23900 Skywagon Drive Bend

Notice #: T-2020-010

POD	USE	HG	TWP	RNG	SEC	QQ	TAX LOT	ACRES
1	IRRIG	E-2-*2	18	13	02	SESE	500	0.37
1	IRRIG	E-2-*2	18	13	02	SWSE	500	0.03

- ☐ Person interviewed (if any): Ryan
- ☐ Method of irrigation (pump, flood, etc): X-Line-Sprinkle
- ☐ Use (crops produced): Pasture grass
- ☐ Method used to calculate area irrigated: Collector
- ☐ Is beneficial use achieved: yes
- ☐ Dated photos of beneficial use: 7/30/21
- ☐ Are there any mapping changes: No
- ☐ Submit map changes to mapping for updates to ARC. Date submitted: _____
- ☐ Update QQ/TL changes in WWIN: _____
- ☐ Enter use into WWIN: _____

IF INCOMPLETE:

- ☐ Failure to Prove up _____ acres of transferred water right
- ☐ Extension Filed: _____

NOTES:

1st Review:

BU achieved 1" of grass currently feeding goats.

2nd Review:

3rd Review (if not complete assess \$150 fee)

Final Inspection by:

Talbot

Date:

7/30/21

DESCHUTES COUNTY SEC.04 T18S R13E


E-RECEIVED
09/15/2022
OWRD

SCALE - 1" = 400'



SW 1/4 OF THE NE 1/4

OWRD #: T-13514

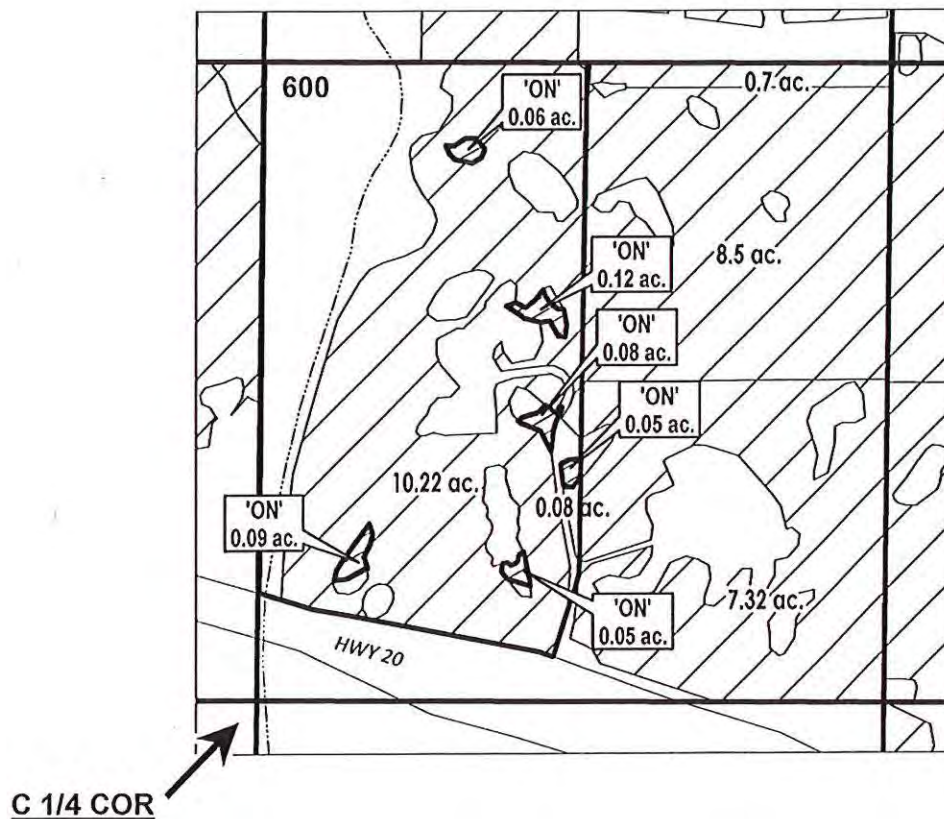

C 1/4 COR

	EXISTING WATER RIGHTS
	ON LANDS

FINAL PROOF MAP

Jacob Ralston and Dayna Ward Ralston

TAXLOT #: 600

0.45 ACRES



Date: 9/7/2021

FINAL PROOF SITE REPORT

Claim of Beneficial Use

E-RECEIVED
09/15/2022
OWRD

Property Owner (Applicant): Ralston, Jacob/Dayna

Petition #: P-2020-001

Current Owner:

OWRD#: T-13514

Property Address: 23040 HWY 20 Bend

Notice #: T-2020-004

POD	USE	HG	TWP	RNG	SEC	QQ	TAX LOT	ACRES
1	IRRIG	D-3-1	18	13	04	SWNE	600	0.45

- ☐ Person interviewed (if any): Jacob
- ☐ Method of irrigation (pump, flood, etc): sprinkle/pump
- ☐ Use (crops produced): Landscaping
- ☐ Method used to calculate area irrigated: collector
- ☐ Is beneficial use achieved: Yes, 0.45 ac
- ☐ Dated photos of beneficial use: 7-30-21
- ☐ Are there any mapping changes: NO
- ☐ Submit map changes to mapping for updates to ARC. Date submitted: _____
- ☐ Update QQ/TL changes in WWIN: _____
- ☐ Enter use into WWIN: _____

IF INCOMPLETE:


- ☐ Failure to Prove up _____ acres of transferred water right
- ☐ Extension Filed: _____

NOTES:

1st Review: 7-30-21 BU achieved in all areas. Thick 3 inch grass

2nd Review:

3rd Review (if not complete assess \$150 fee)

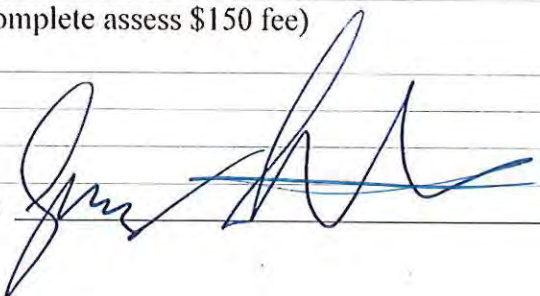Final Inspection by: 

Date: 7-30-21

DESCHUTES COUNTY SEC.15 T14S R13E

E-RECEIVED
10/13/2022
OWRD


SCALE - 1" = 400'



NW 1/4 OF THE NE 1/4; SW 1/4 OF THE NE 1/4

OWRD: T-13341

N 1/4 COR

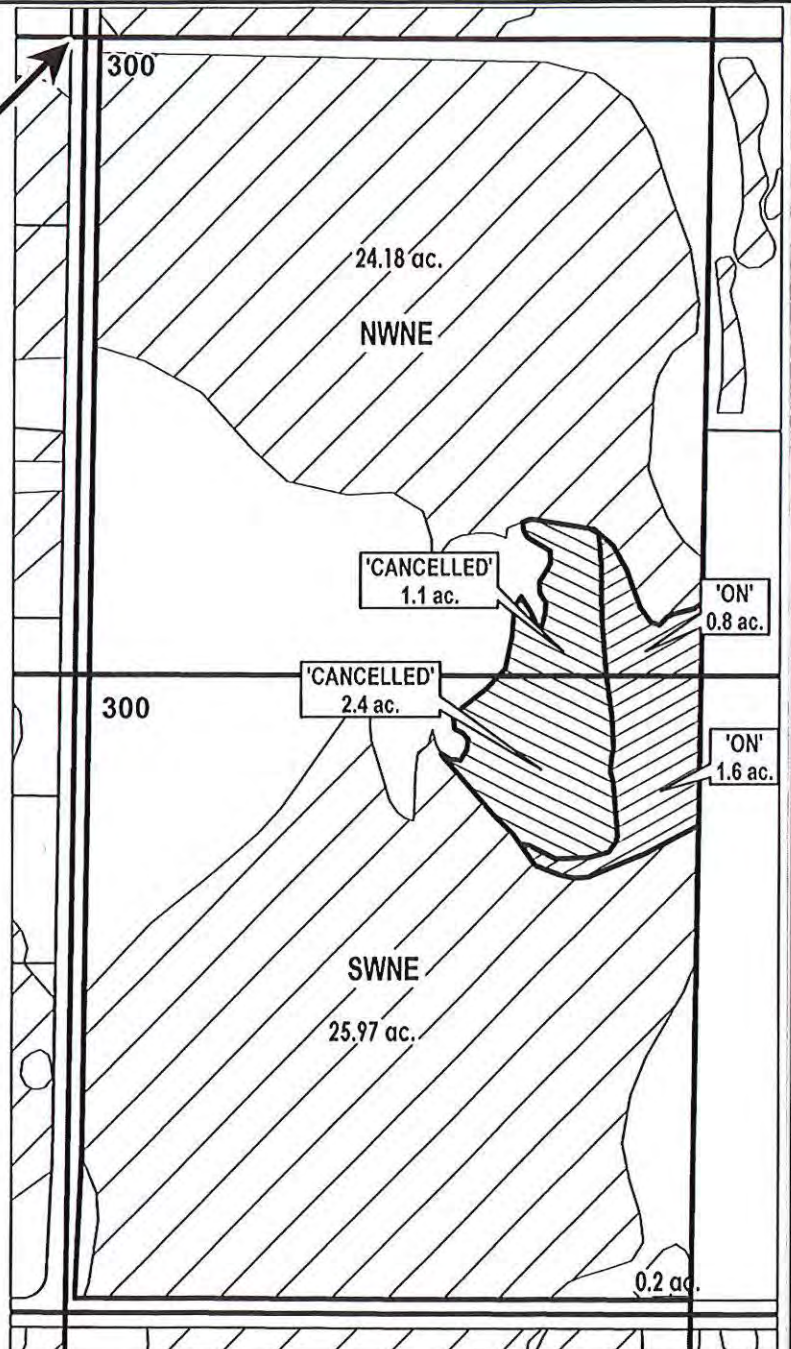

- ON LANDS
- CANCELLED LANDS
- EXISTING WATER RIGHTS



FINAL PROOF MAP

NAME: Dunn, James/Betty

TAXLOT #: 300

2.4 ACRES 'ON'

3.5 ACRES 'CANCELLED'

DATE: 9/7/2022

DESCHUTES COUNTY SEC.20 T14S R13E


E-RECEIVED
10/13/2022
OWRD

SCALE - 1" = 400'



NW 1/4 OF THE NW 1/4

OWRD: T-13341

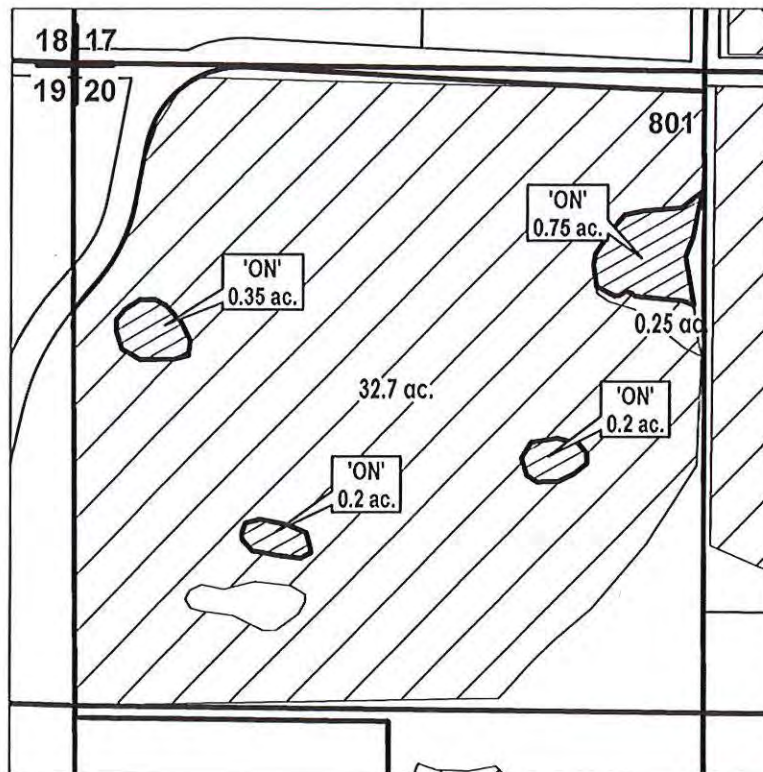

 ON LANDS
 EXISTING WATER RIGHTS



FINAL PROOF MAP

NAME: Aaby, Darrell/Sherry

TAXLOT #: 801

1.5 ACRES

DATE: 9/7/2022

DESCHUTES COUNTY SEC.24 T14S R13E


E-RECEIVED
10/13/2022
OWRD

SCALE - 1" = 400'



NW 1/4 OF THE SE 1/4

OWRD: T-13341

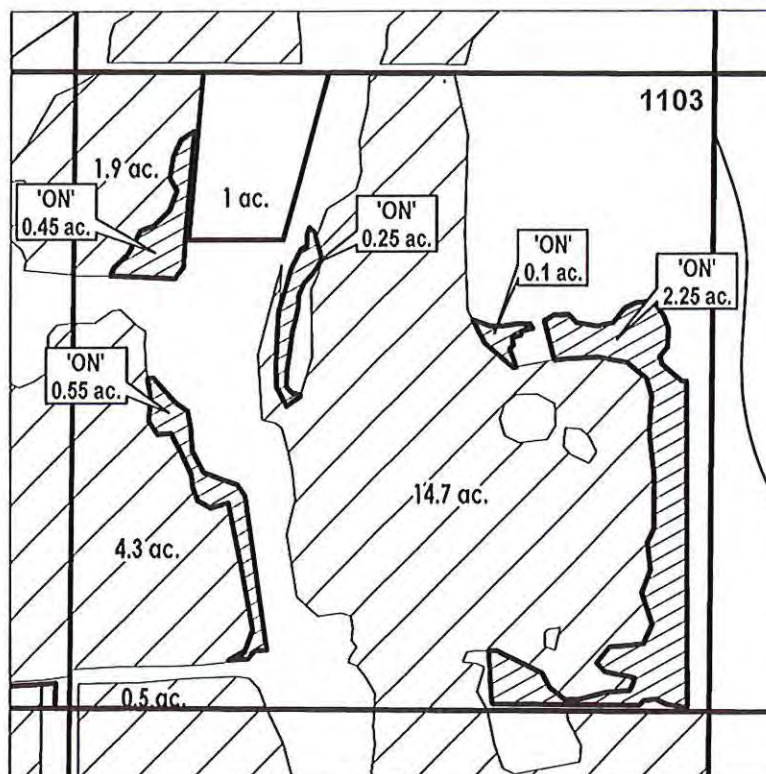

	EXISTING WATER RIGHTS
	ON LANDS
	PARCELS W/ WATER RIGHTS



FINAL PROOF MAP

NAME: Campbell, Cherie Carr

TAXLOT #: 1103

3.6 ACRES

DATE: 9/27/2022

DESCHUTES COUNTY
SEC.25 T14S R13E


E-RECEIVED
10/13/2022
OWRD

SCALE - 1" = 400'



SE 1/4 OF THE NW 1/4

OWRD: T-13341

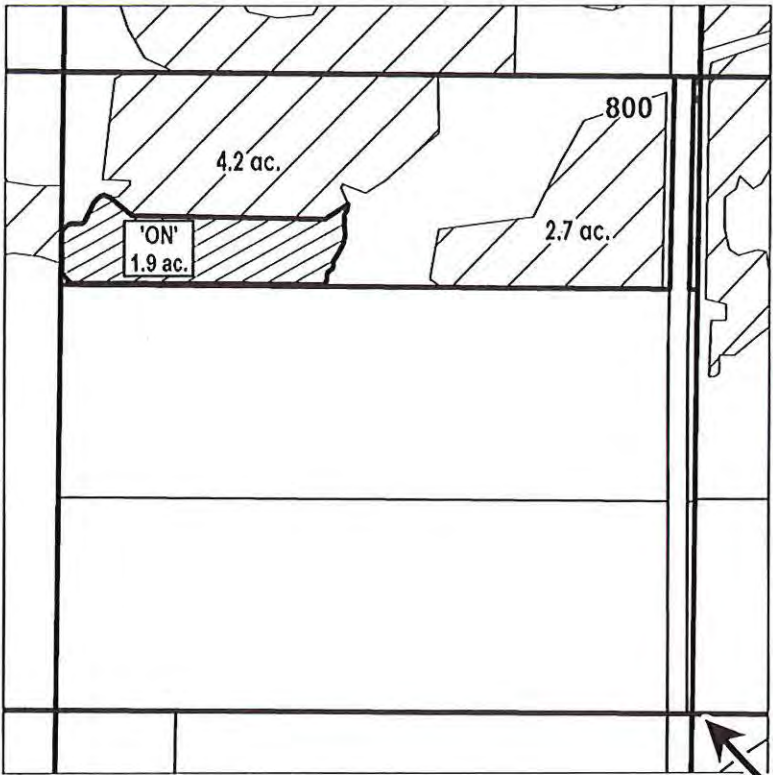

C 1/4 COR

	EXISTING WATER RIGHTS
	ON LANDS



FINAL PROOF MAP

NAME: Farnsworth, Lenard/Christine

TAXLOT #: 800

1.9 ACRES

DATE: 9/7/2022

DESCHUTES COUNTY SEC.34 T14S R13E


E-RECEIVED
10/13/2022
OWRD

SCALE - 1" = 400'



SW 1/4 OF THE NE 1/4

OWRD: T-13341

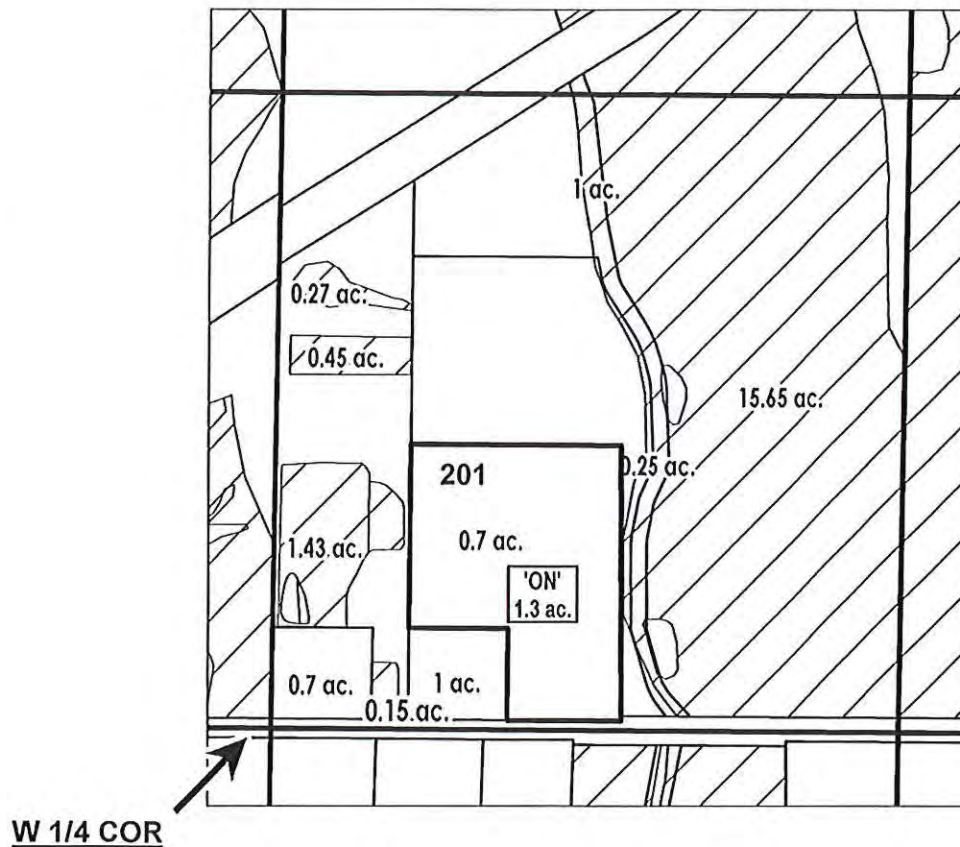

	EXISTING WATER RIGHTS
	ON LANDS
	PARCELS W/ WATER RIGHTS



FINAL PROOF MAP

NAME: Batty, James/Pamela

TAXLOT #: 201

1.3 ACRES

DATE: 9/7/2022

CROOK COUNTY SEC.16 T16S R14E



E-RECEIVED
10/13/2022
OWRD

OWRD: T-13341

SCALE - 1" = 400'



NW 1/4

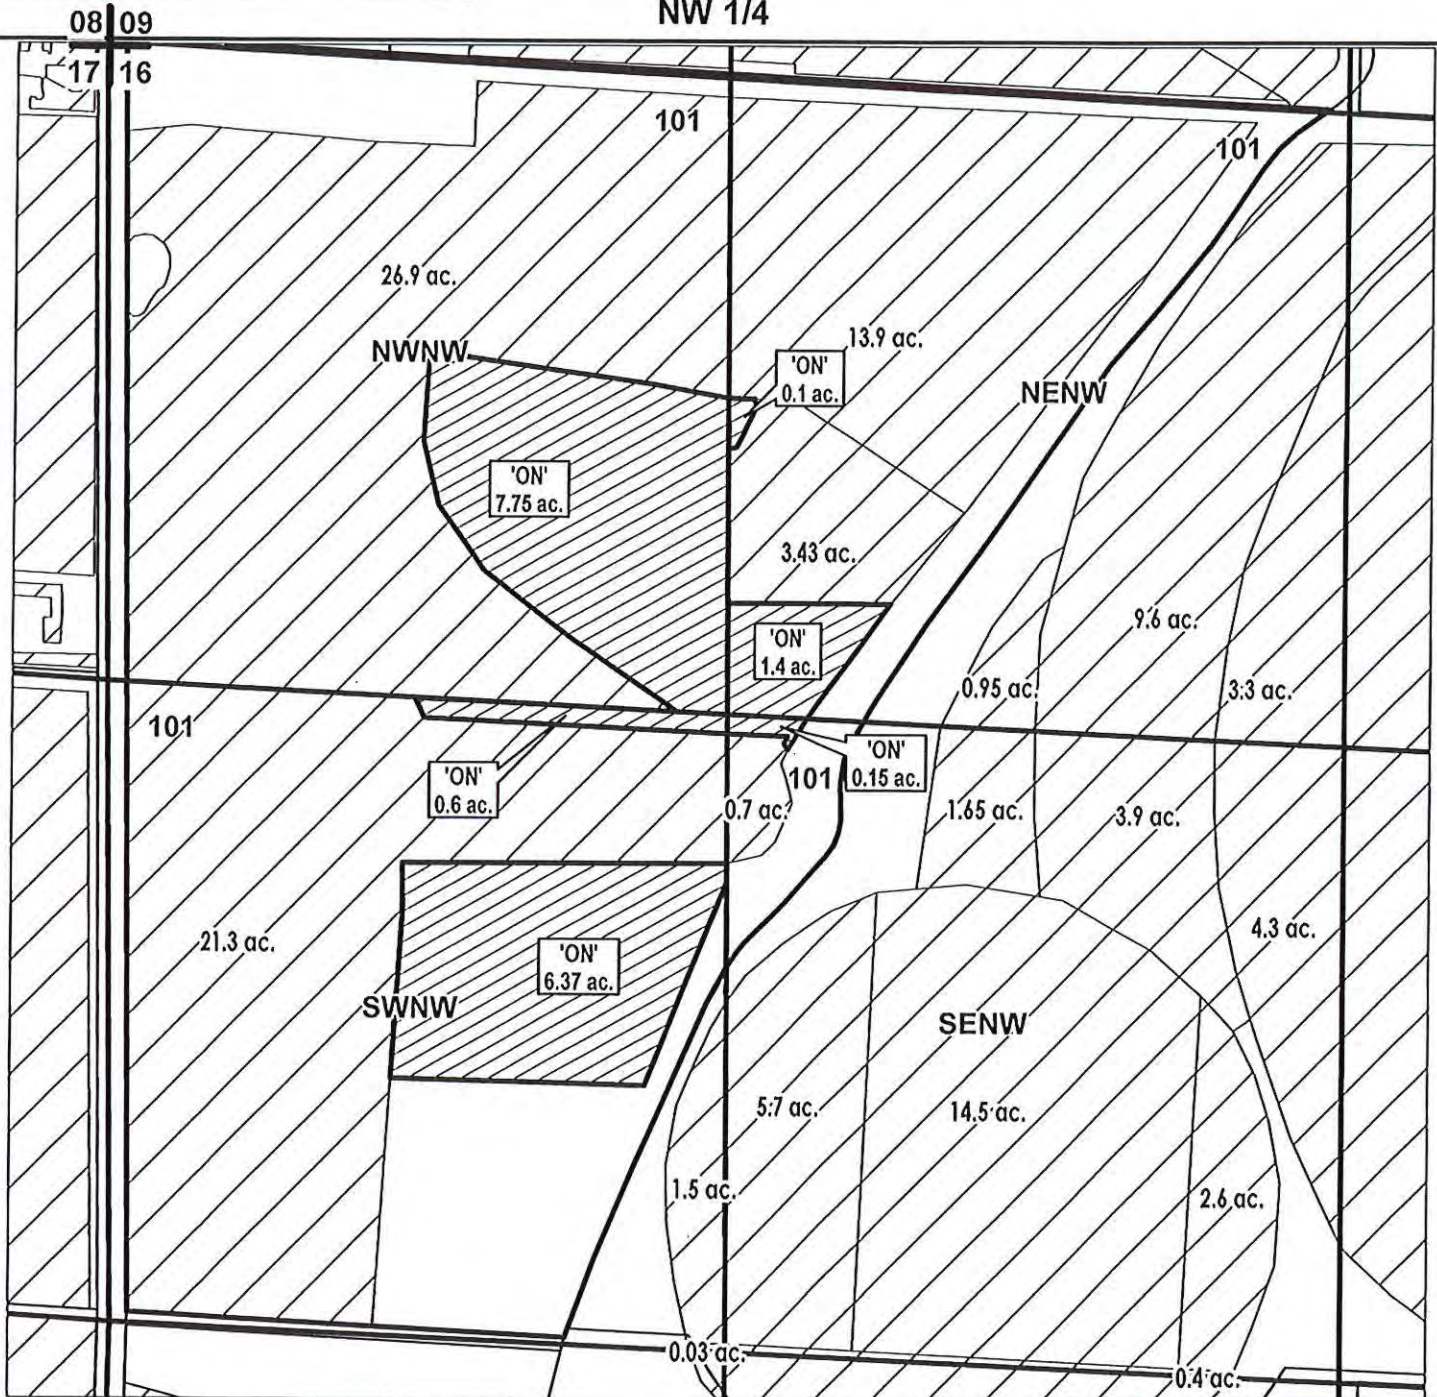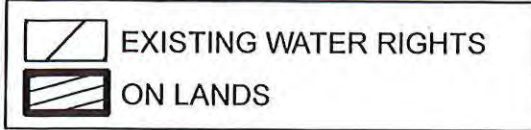

FINAL PROOF MAP

NAME: England, Jim/Jill

TAXLOT #: 101

16.37 ACRES

DATE: 9/7/2022

DESCHUTES COUNTY
SEC.08 T14S R13E



E-RECEIVED
10/13/2022
OWRD

SCALE - 1" = 400'



SW 1/4 OF THE NW 1/4

OWRD: T-13341

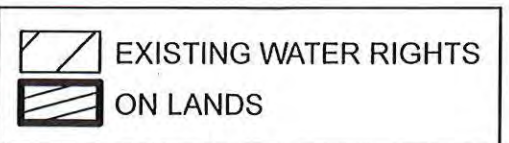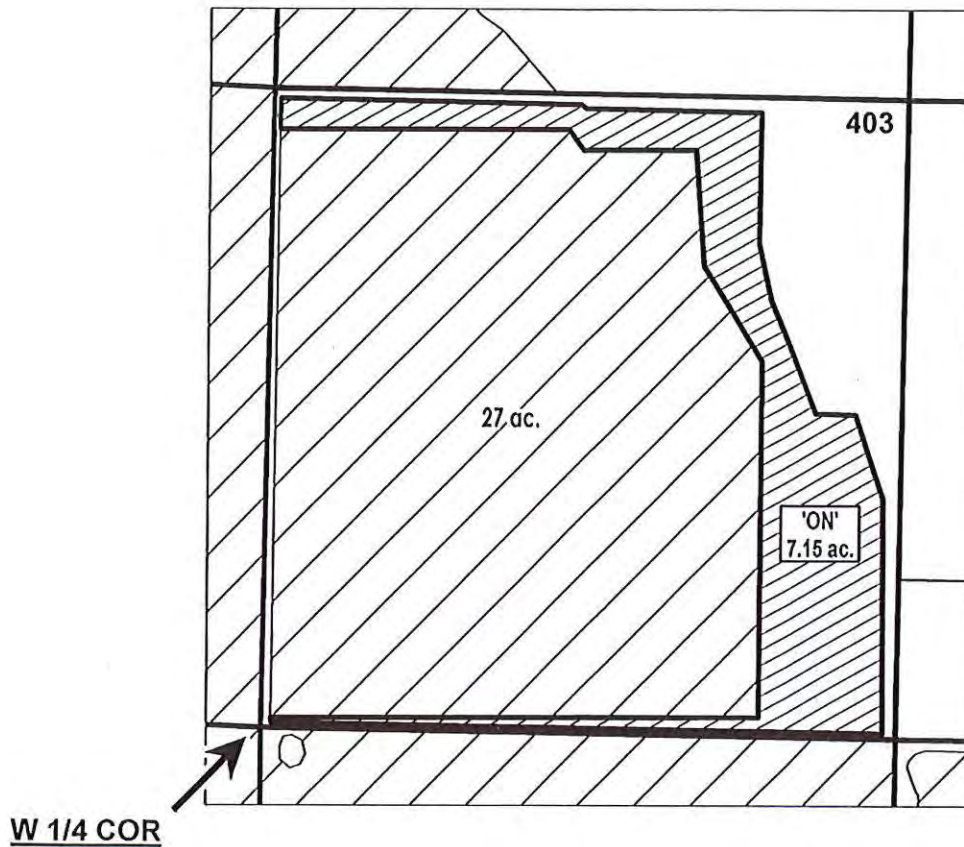

FINAL PROOF MAP

NAME: Butterfield, Patrick/Patricia

TAXLOT #: 403

7.15 ACRES



DATE: 9/7/2022

DESCHUTES COUNTY SEC.25 T15S R12E


E-RECEIVED
09/15/2022
OWRD

SCALE - 1" = 400'



NE 1/4 OF THE NE 1/4

OWRD: T-13514

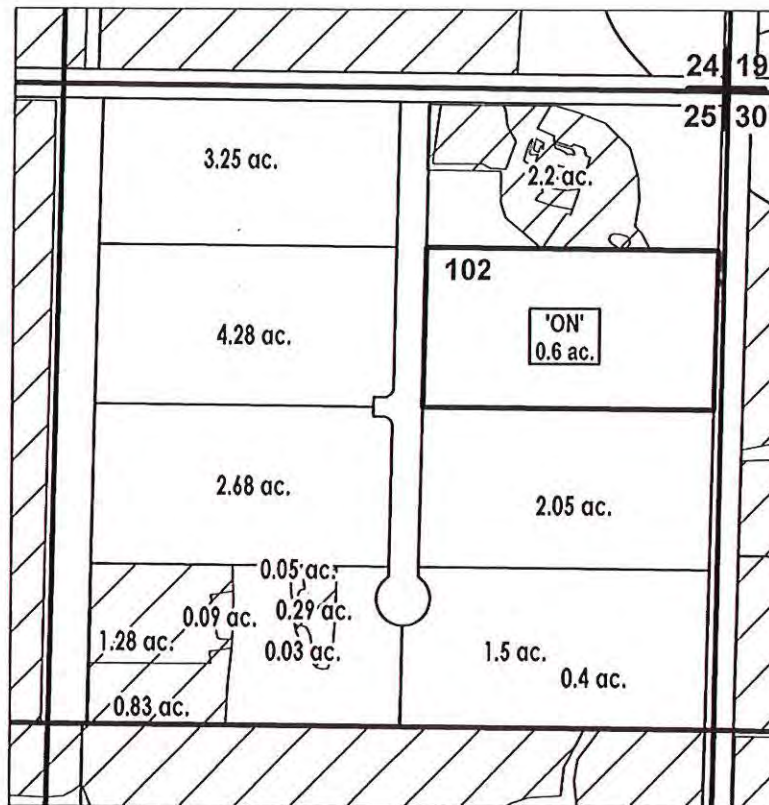

	EXISTING WATER RIGHTS
	'ON' LAND PARCELS
	PARCELS W/ WATER RIGHTS



FINAL PROOF MAP

NAME: Widmer, Sidney/Melanie

TAXLOT #: 102

0.6 ACRES

DATE: 9/1/2022

DESCHUTES COUNTY SEC.31 T15S R13E


E-RECEIVED
09/15/2022
OWRD

SCALE - 1" = 400'



SE 1/4 OF THE NW 1/4

OWRD: T-13514

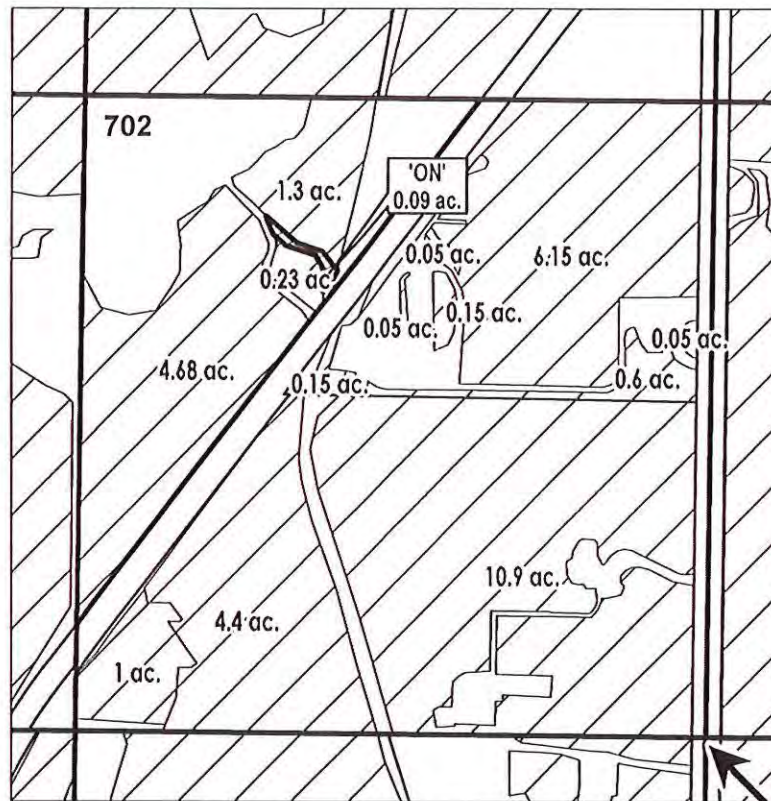

C 1/4 COR

	EXISTING WATER RIGHTS
	ON LANDS



FINAL PROOF MAP

NAME: Endicott, George/Krisanna

TAXLOT #: 702

0.09 ACRES

DATE: 9/1/2022

DESCHUTES COUNTY SEC.11 T16S R12E



E-RECEIVED
09/15/2022
OWRD

SCALE - 1" = 400'



NE 1/4 OF THE NW 1/4

OWRD #: T-13514

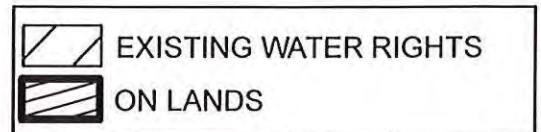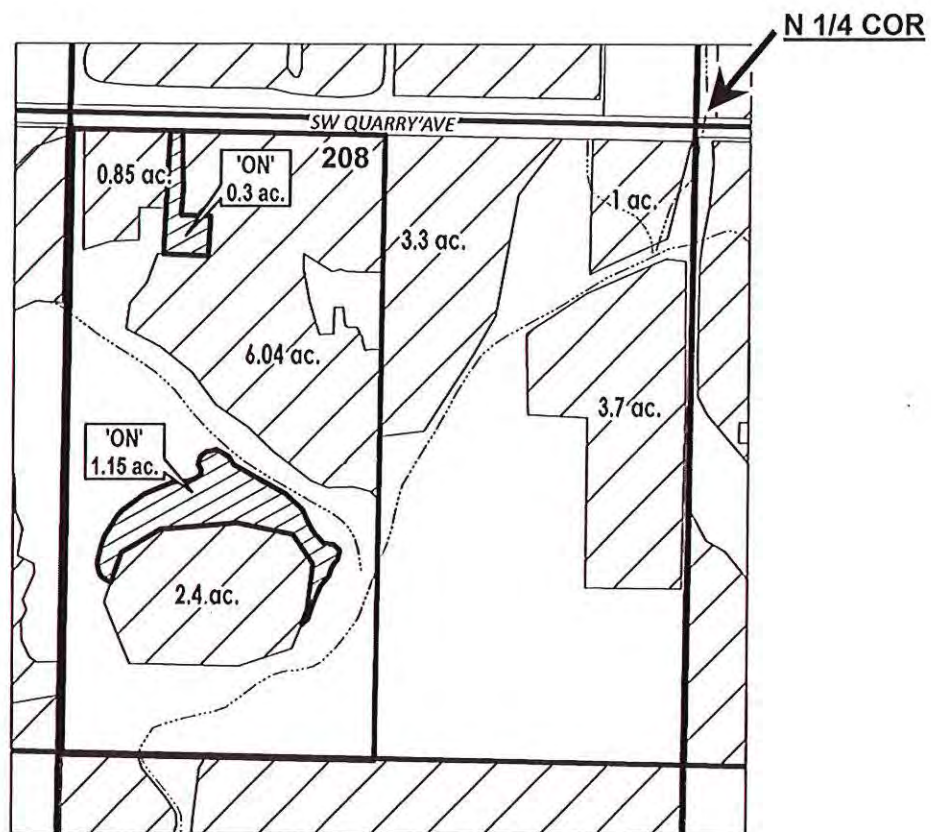

FINAL PROOF MAP

STACY AND MATTHEW NAHLIK

TAXLOT #: 208

1.45 ACRES

Date: 8/6/2021

DESCHUTES COUNTY SEC.26 T16S R12E



E-RECEIVED
09/15/2022
OWRD

SCALE - 1" = 400'



NW 1/4 OF THE NE 1/4; NE 1/4 OF THE NE 1/4

OWRD: T-13514

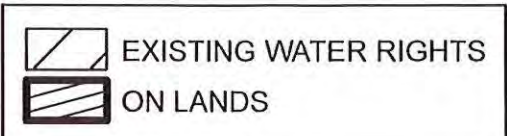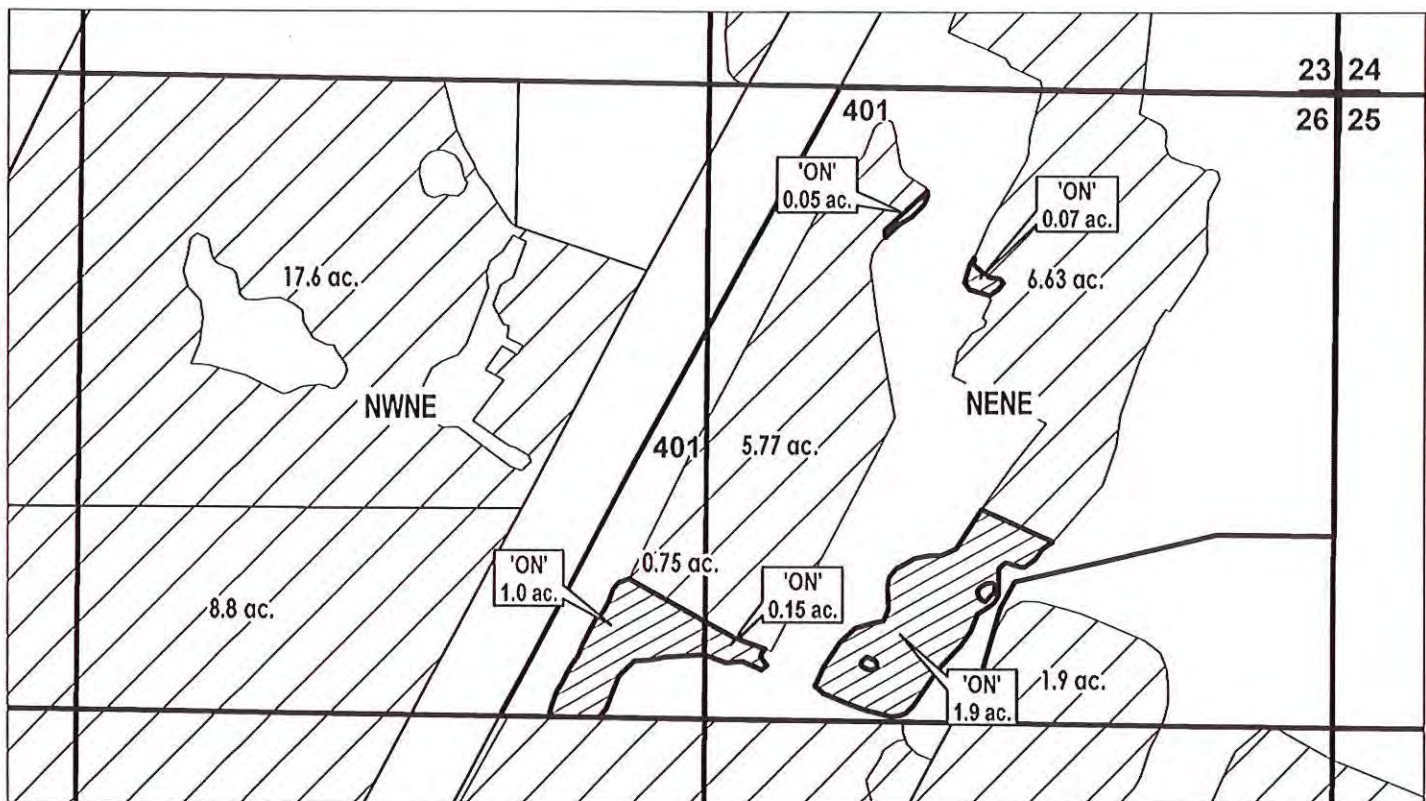

FINAL PROOF MAP

NAME: Parsons, Leo D.

TAXLOT #: 702

3.17 ACRES

DATE: 9/2/2022

DESCHUTES COUNTY SEC.35 T16S R12E

E-RECEIVED
09/15/2022
OWRD


SCALE - 1" = 400'




NW 1/4 OF THE SE 1/4

OWRD #: T-13514

C 1/4 COR

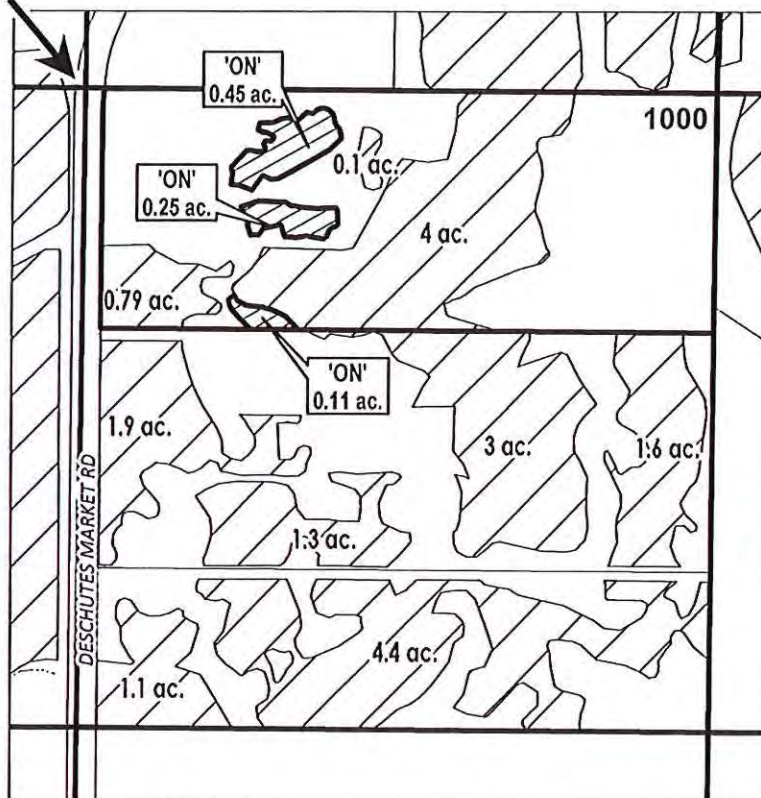

"ON" MAP

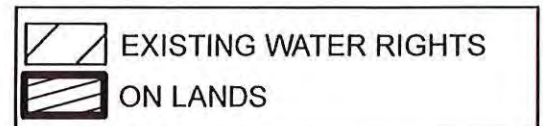

FINAL PROOF MAP

Matthew and Jessica Shaffer

TAXLOT #: 1000

0.81 ACRES



Date: 8/4/2021

DESCHUTES COUNTY SEC.29 T17S R12E

E-RECEIVED
09/15/2022
OWRD

SCALE - 1" = 400'



SE 1/4 OF THE NW 1/4

OWRD: T-13514



C 1/4 COR

 EXISTING WATER RIGHTS
 ON LANDS



FINAL PROOF MAP

NAME: River's Edge Community Master Association

TAXLOT #: 101

0.15 ACRES

DATE: 9/2/2022

DESCHUTES COUNTY SEC.19 T17S R13E



E-RECEIVED
09/15/2022
OWRD

SCALE - 1" = 400'



SE 1/4 OF THE NW 1/4

OWRD #: T-13514

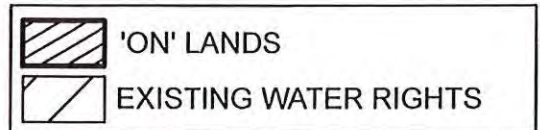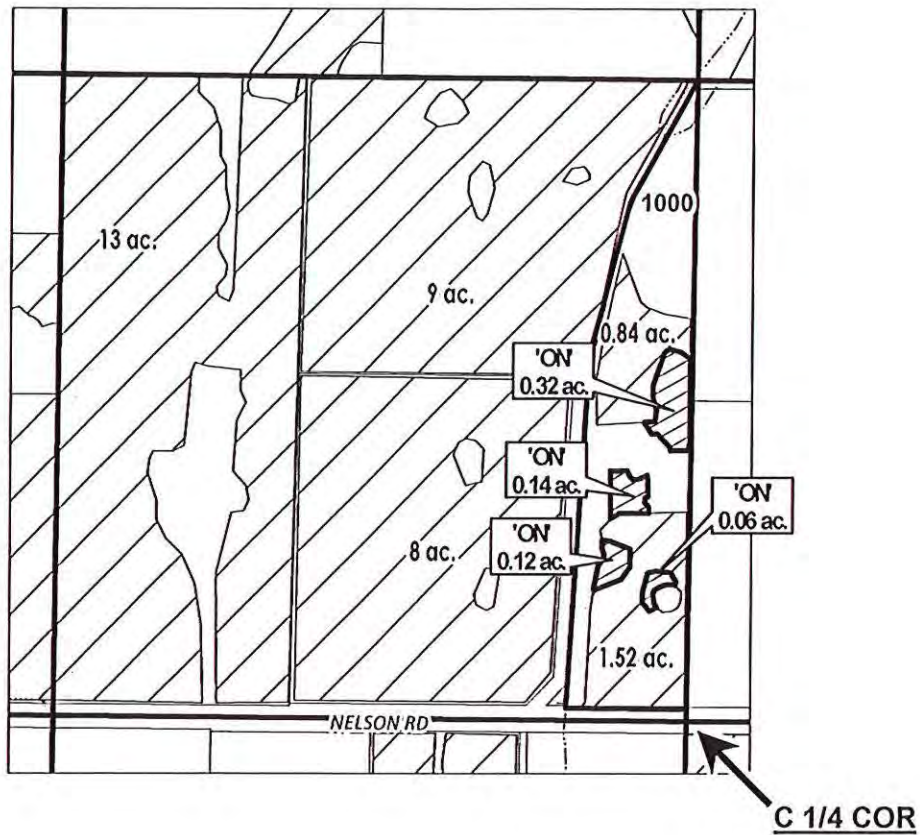

FINAL PROOF MAP

NAME: Christopher D and Kit A. Larsen

TAXLOT #: 1000

0.64 ACRES



Date: 9/7/2021

DESCHUTES COUNTY SEC.30 T17S R13E



E-RECEIVED
09/15/2022
OWRD

SCALE - 1" = 400'



NE 1/4 OF THE NW 1/4

OWRD: T-13514

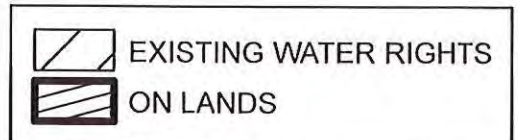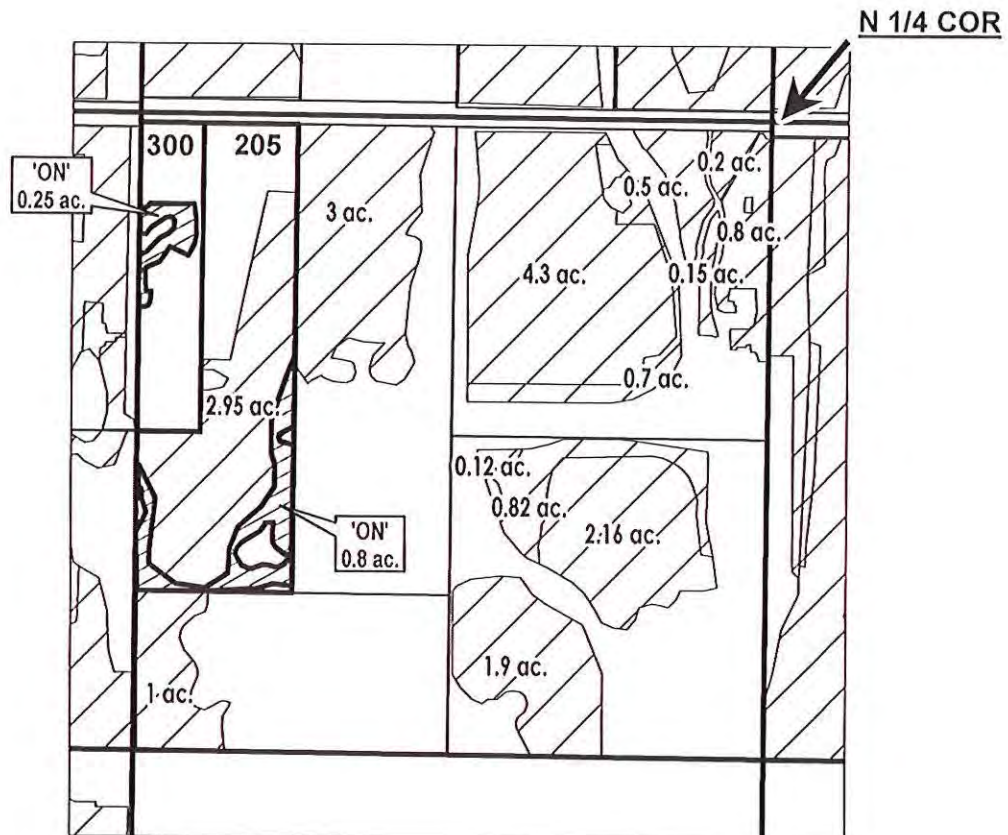

FINAL PROOF MAP

NAME: Bomke, Kurt/Jennifer

TAXLOT #: 205, 300

1.05 ACRES

DATE: 9/2/2022

DESCHUTES COUNTY SEC.13 T17S R14E


E-RECEIVED
09/15/2022
OWRD

SCALE - 1" = 400'



SW 1/4 OF THE SE 1/4

OWRD #: T-13514

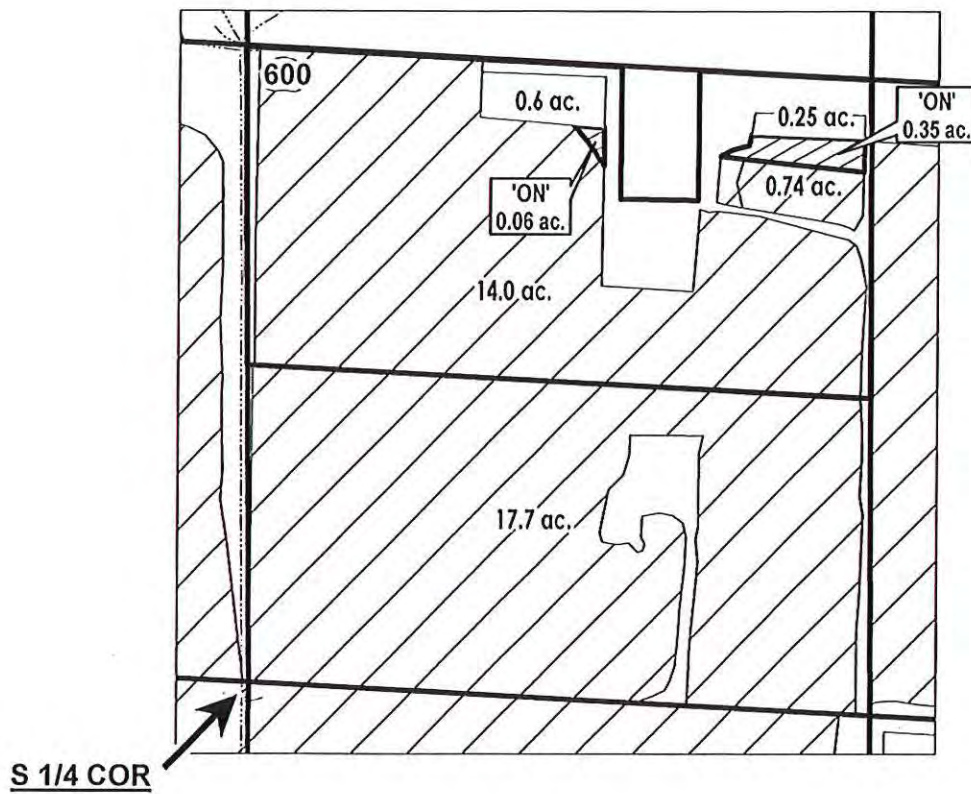

	NOTICE SUBMITTED
	EXISTING WATER RIGHTS
	ON LANDS

FINAL PROOF MAP

Robert E. Jr. and Erynne E. Fore

TAXLOT #: 600

0.41 ACRES



Date: 9/7/2021

DESCHUTES COUNTY SEC.23 T17S R14E



E-RECEIVED
09/15/2022
OWRD

SCALE - 1" = 400'



SE 1/4 OF THE NW 1/4

OWRD #: T-13514

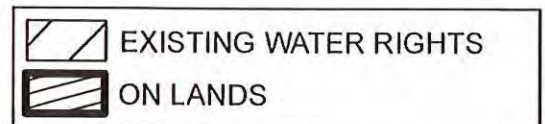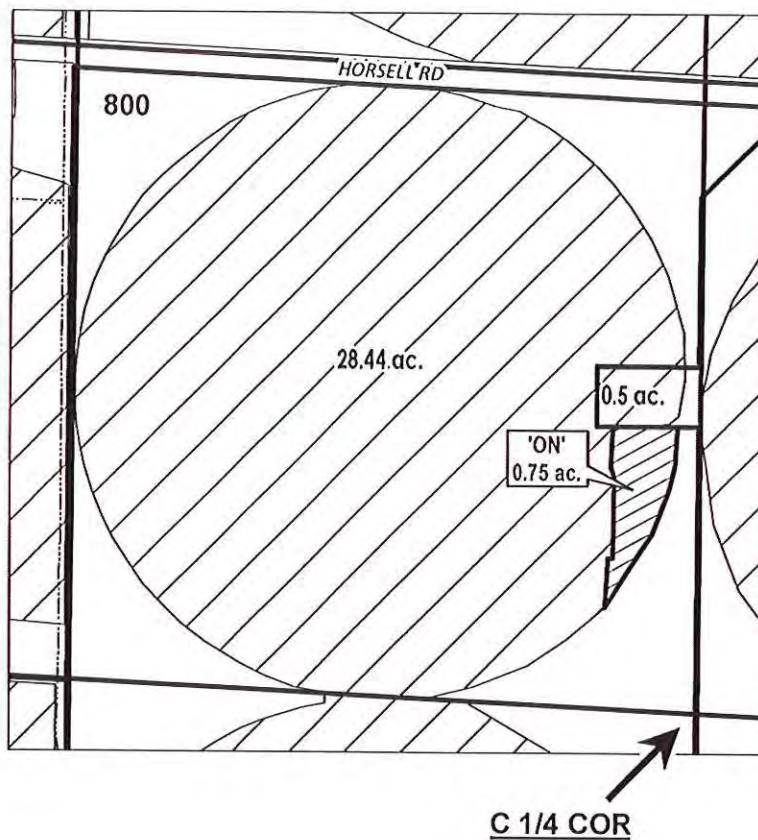

FINAL PROOF MAP

NAME: 9 Mile Farm, LLC

TAXLOT #: 800

0.75 ACRES

Date: 8/4/2021

DESCHUTES COUNTY SEC.27 T17S R14E


E-RECEIVED
09/15/2022
OWRD

SCALE - 1" = 400'



NW 1/4 OF THE SW 1/4; NE 1/4 OF THE SW 1/4

OWRD: T-13514

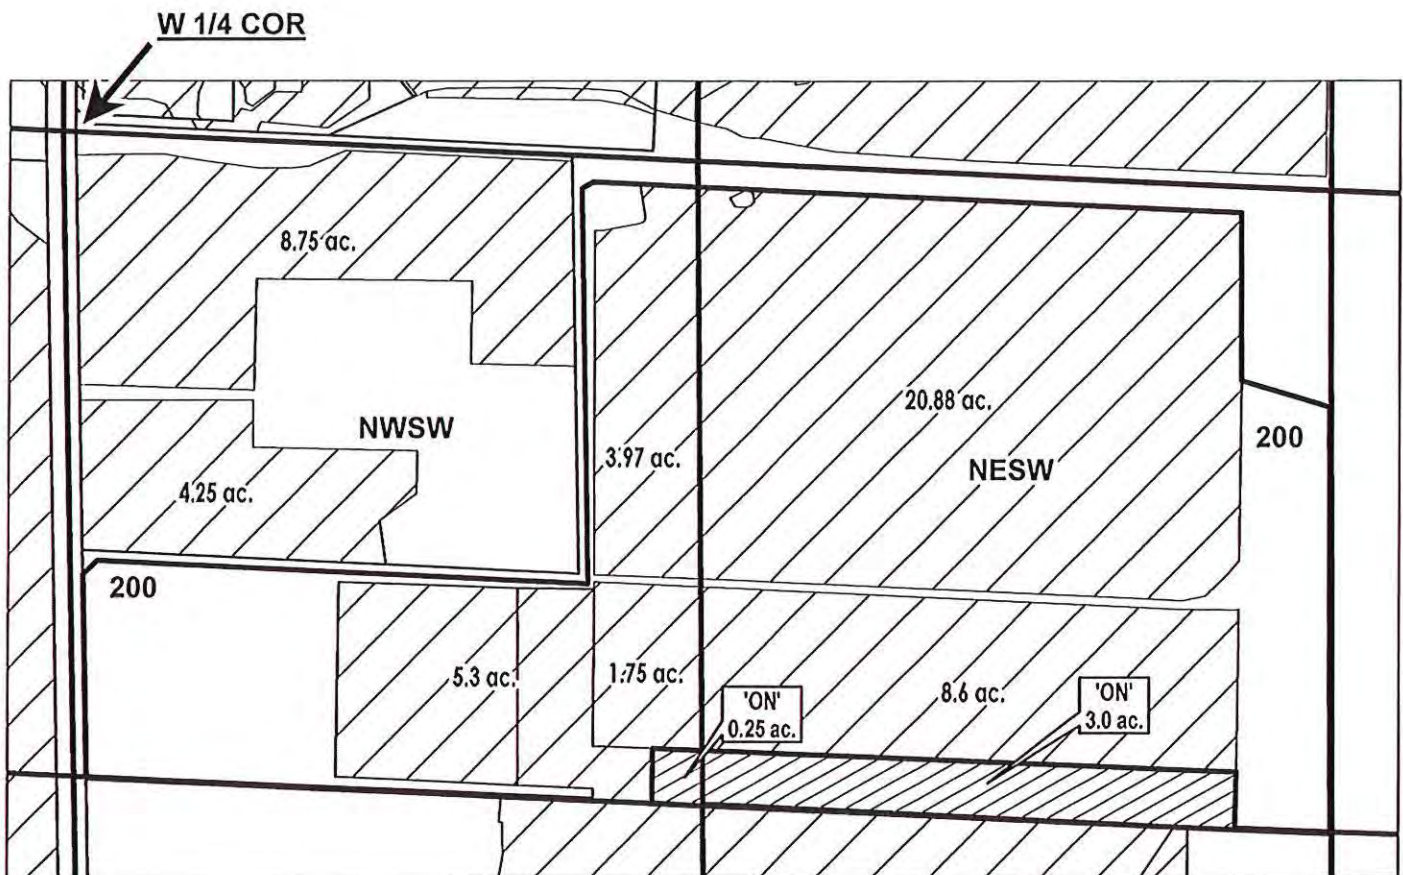

 EXISTING WATER RIGHTS
 ON LANDS



FINAL PROOF MAP

NAME: Luke Dynes

TAXLOT #: 200

3.25 ACRES

DATE: 9/2/2022

DESCHUTES COUNTY SEC.28 T17S R14E


E-RECEIVED
09/15/2022
OWRD

SCALE - 1" = 400'



NW 1/4 OF THE NE 1/4; SW 1/4 OF THE NE 1/4

OWRD #: T-13514

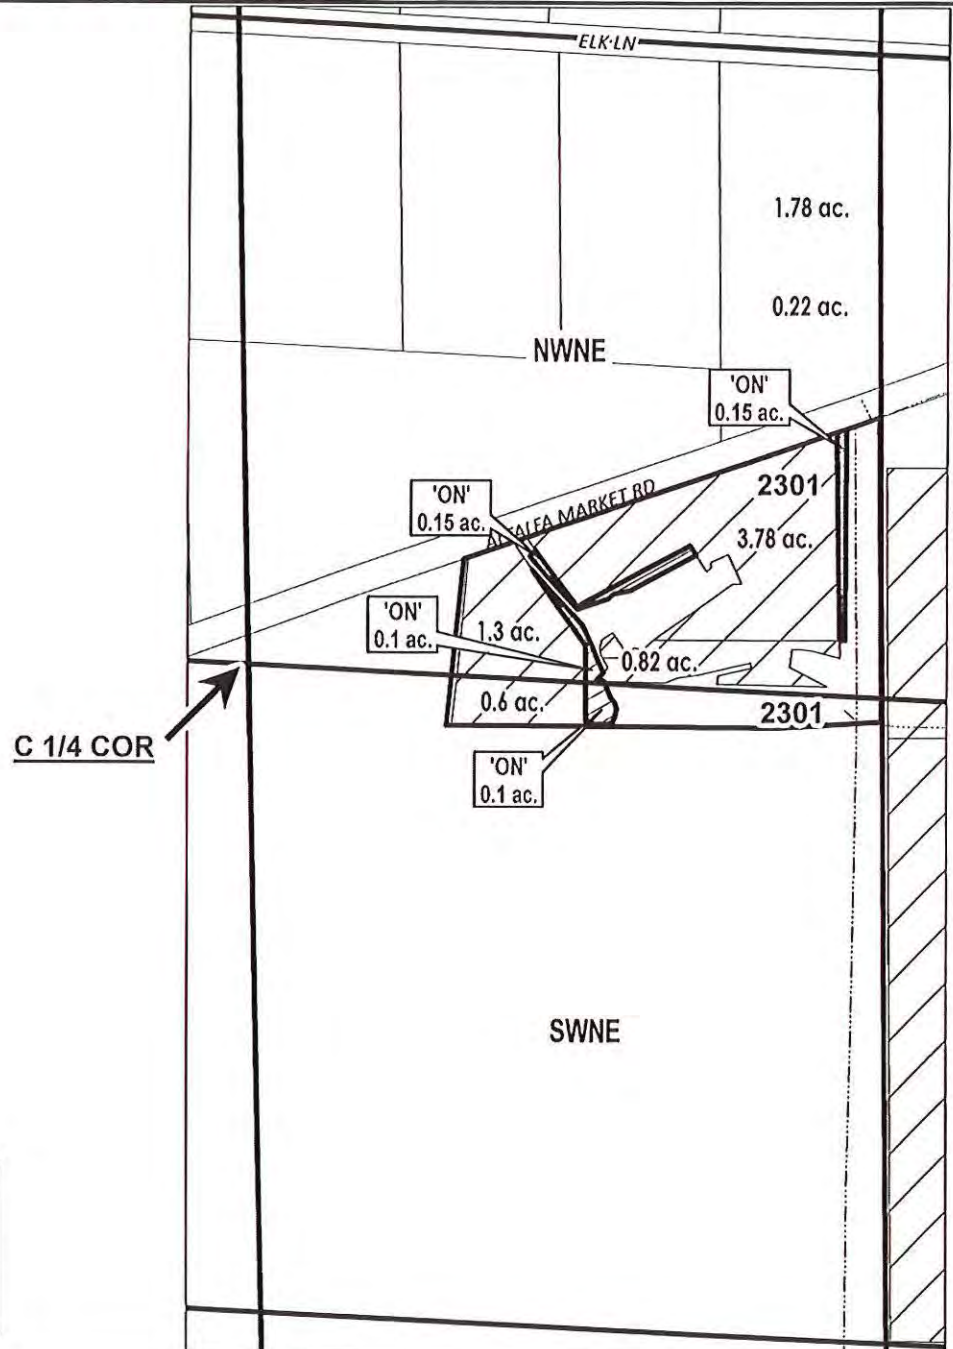

	'ON' LANDS
	# ac. PARCELS W/ WATER RIGHTS
	EXISTING WATER RIGHTS



FINAL PROOF MAP

NAME: CURT G. JENO

TAXLOT #: 2301

0.5 ACRES

Date: 9/7/2021

DESCHUTES COUNTY
SEC.02 T18S R13E


E-RECEIVED
09/15/2022
OWRD

SCALE - 1" = 400'



SW 1/4 OF THE SE 1/4; SE 1/4 OF THE SE 1/4

OWRD: T-13514

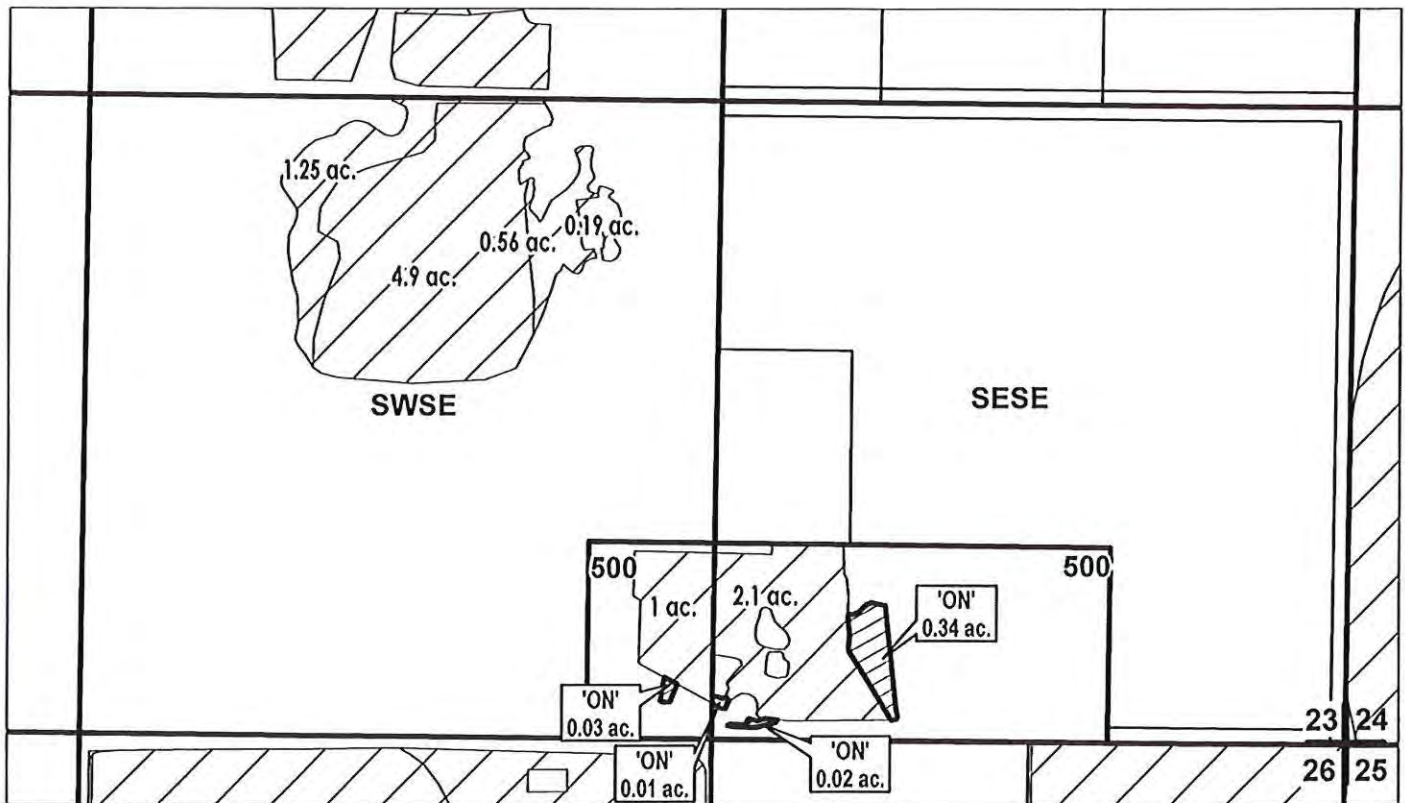

EXISTING WATER RIGHTS
ON LANDS



FINAL PROOF MAP

NAME: Norwood, Ryan/Ali

TAXLOT #: 500

0.4 ACRES

DATE: 9/2/2022

DESCHUTES COUNTY SEC.04 T18S R13E



E-RECEIVED
09/15/2022
OWRD

SCALE - 1" = 400'



SW 1/4 OF THE NE 1/4

OWRD #: T-13514

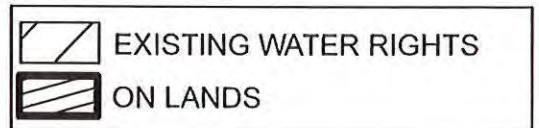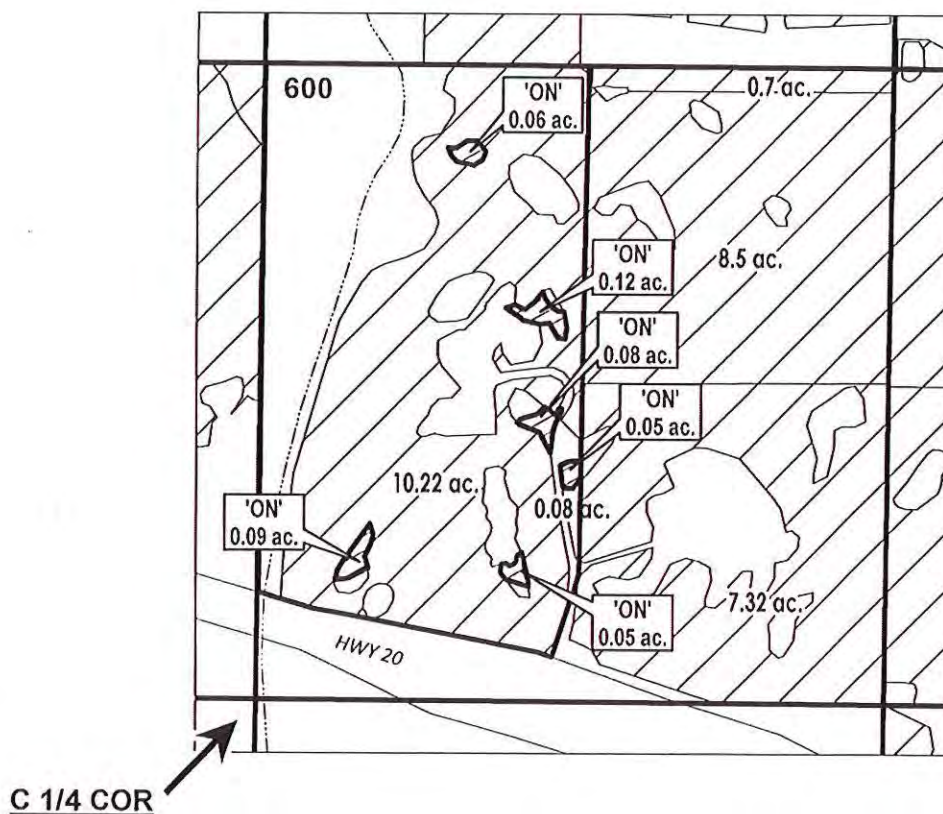

FINAL PROOF MAP

Jacob Ralston and Dayna Ward Ralston

TAXLOT #: 600

0.45 ACRES

Date: 9/7/2021

DESCHUTES COUNTY SEC.06 T14S R13E



E-RECEIVED
09/15/2022
OWRD

SCALE - 1" = 400'



SE 1/4 OF THE SE 1/4

OWRD: T-13514

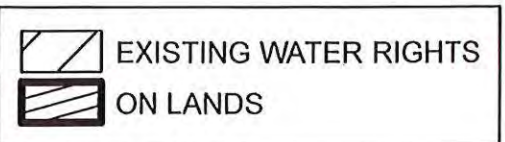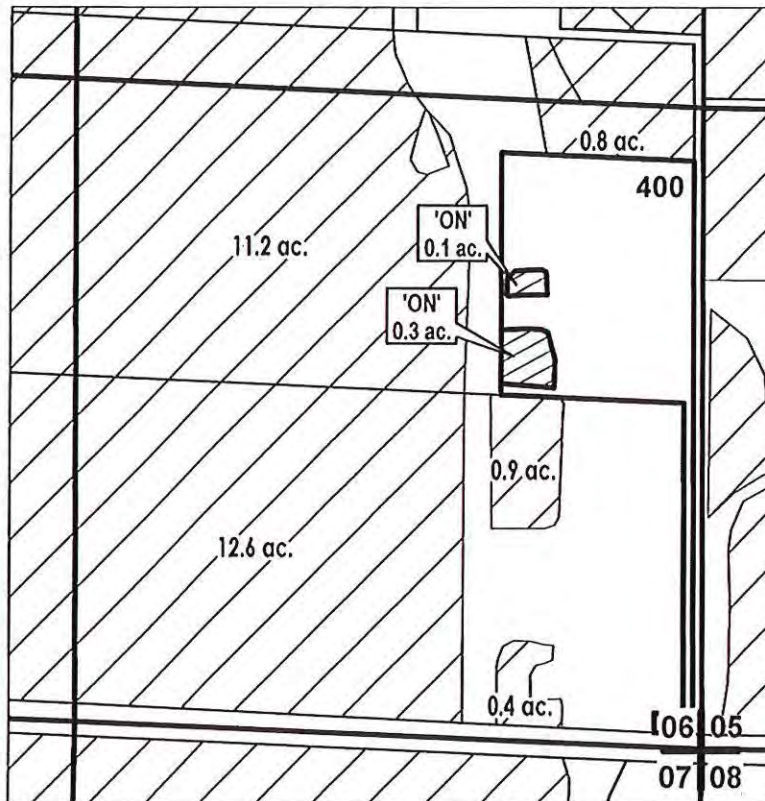

FINAL PROOF MAP

NAME: Forester, Michael.Kaarin Trustees

TAXLOT #: 400

0.4 ACRES



DATE: 9/1/2022

DESCHUTES COUNTY SEC.15 T14S R13E


E-RECEIVED
09/15/2022
OWRD

SCALE - 1" = 400'



SW 1/4 OF THE NW 1/4

OWRD #: T-13514

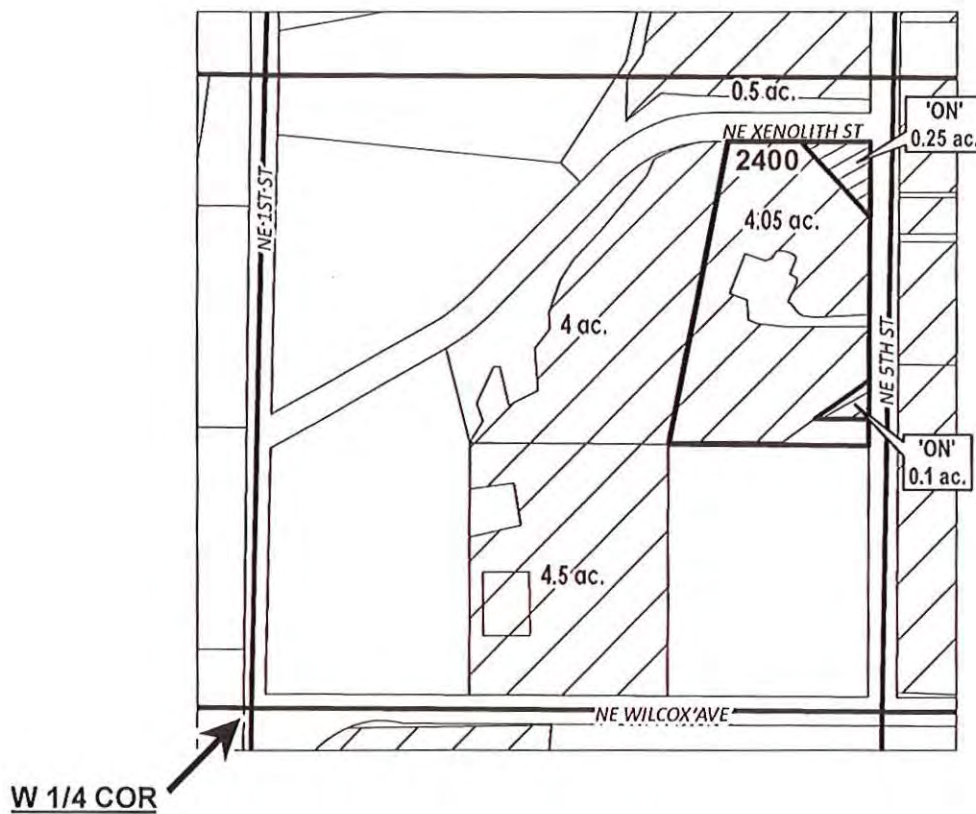

	EXISTING WATER RIGHTS
	ON LANDS



FINAL PROOF MAP

SHARON L. BOYNTON

TAXLOT #: 2400

0.35 ACRES

Date: 9/7/2021

DESCHUTES COUNTY SEC.22 T14S R13E


E-RECEIVED
09/15/2022
OWRD

SCALE - 1" = 400'



NE 1/4 OF THE SE 1/4

OWRD #: 13514

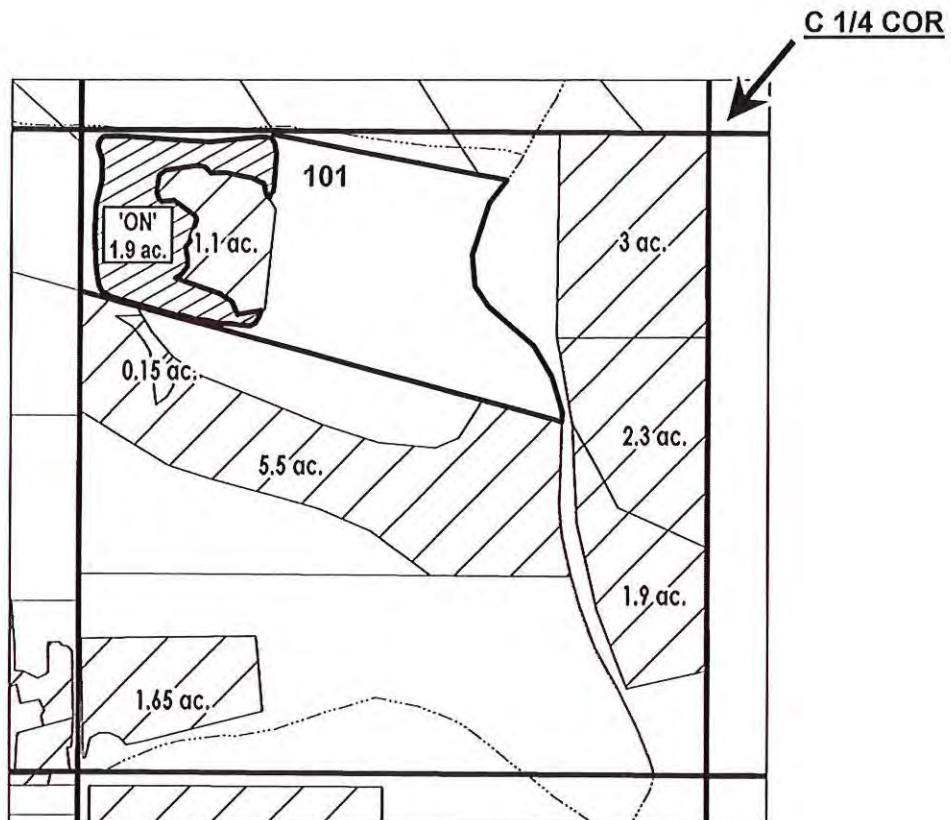

	EXISTING WATER RIGHTS
	ON LANDS

FINAL PROOF MAP

VICTORIA LEE DAVIS

TAXLOT #: 101

1.9 ACRES



Date: 9/7/2021

DESCHUTES COUNTY SEC.27 T14S R13E

E-RECEIVED
09/15/2022
OWRD


SCALE - 1" = 400'



NW 1/4 OF THE SW 1/4

OWRD: T-13514

W 1/4 COR

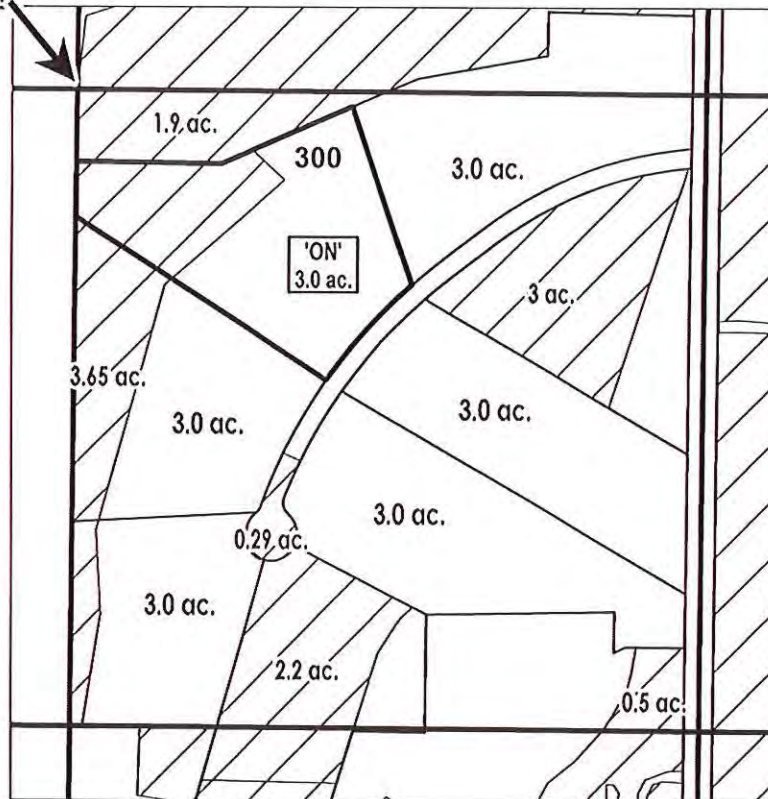

- # ac. 'ON' LAND PARCELS
-  EXISTING WATER RIGHTS
- # ac. PARCELS W/ WATER RIGHTS



FINAL PROOF MAP

NAME: Jennings, Ryan/Jill

TAXLOT #: 300

3.0 ACRES

DATE: 9/14/2022

**CROOK COUNTY
SEC.19 T14S R14E**


E-RECEIVED
09/15/2022
OWRD

SCALE - 1" = 400'



NE 1/4 OF THE NW 1/4

OWRD: T-13514

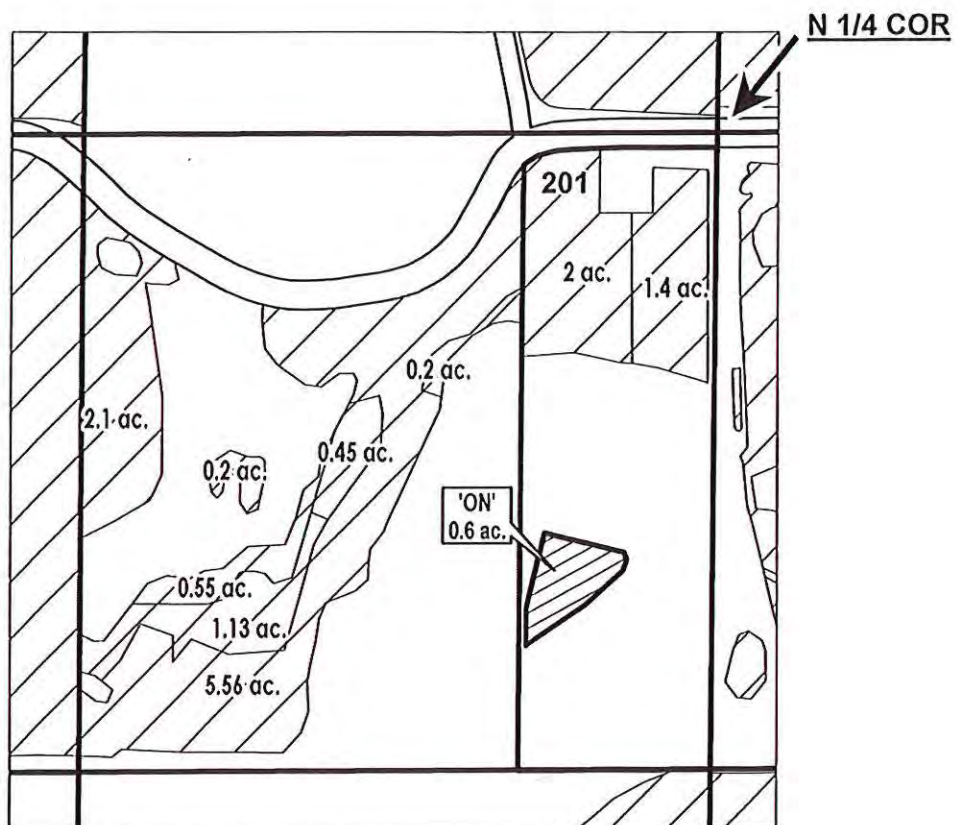

 EXISTING WATER RIGHTS
 ON LANDS

FINAL PROOF MAP

NAME: Hemphill, Carl/Cynthia

TAXLOT #: 201



0.6 ACRES



DATE: 9/1/2022

E-RECEIVED
09/15/2022
OWRD

SCALE - 1" = 400'

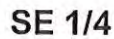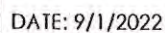[illegible]



Oregon
Kate Brown, Governor

Water Resources Department
725 Summer St NE, Suite A
Salem, OR 97301
(503) 986-0900
Fax (503) 986-0904

January 6, 2021

CENTRAL OREGON IRRIGATION DISTRICT
1055 SW LAKE COURT
REDMOND, OR 97756

REFERENCE: District Transfer T-13514

Enclosed is a copy of the final order approving your District Transfer.

The time allowed to complete the transfer is specified in the final order. You are required to submit a claim of beneficial use to this Department within one year of the date you complete the change(s) or within one year of the completion date authorized final order whichever comes first. If necessary, you may request more time by filing for transfer extension. All extensions are subject to approval.

To file a claim please include:

1. A CLAIM OF BENEFICIAL USE form
2. A CLAIM OF BENEFICIAL USE SITE REPORT
3. A Claim of Beneficial Use Map (this map does not need to be prepared by a Certified Water Rights Examiner (CWRE))

All forms needed to file a claim for a district transfer are available at
<https://www.oregon.gov/OWRD/programs/WaterRights/Transfers/DistTransfer/Pages/Forms.aspx>

If you have any questions related to the approval of this transfer, you may contact your caseworker Ann Reece by telephone at (503) 986-0858 or by e-mail at Ann.L.Reece@oregon.gov.

Sincerely,

Julie C. Baustian
Water Right Services Support
Transfers and Conservation Section

cc: Jeremy T. Giffin, Watermaster Dist. # 11 (via email)
Bureau of Reclamation

Enclosure

**BEFORE THE WATER RESOURCES DEPARTMENT
OF THE
STATE OF OREGON**

In the Matter of Transfer Application	)	FINAL ORDER APPROVING
T-13514, Deschutes and Crook Counties	)	A DISTRICT PERMANENT TRANSFER FOR
	)	PLACE OF USE

Authority

Oregon Revised Statutes (ORS) 540.570 to 540.580 establish the process in which a district may submit a request to transfer a water right within district boundaries. Oregon Administrative Rule (OAR) Chapter 690, Division 385 implements the statutes and provides the Department's procedures and criteria for evaluating district transfer applications.

Applicant

CENTRAL OREGON IRRIGATION DISTRICT
1055 SW LAKE CT.
REDMOND, OR 97756

Findings of Fact

1. On August 24, 2020, Central Oregon Irrigation District (COID) filed a district transfer application to permanently change the places of use under Certificates 94956 and 76714. The Department assigned the application number T-13514.
2. Notice of the District Permanent Transfer Application was published on September 9, 2020, pursuant to ORS 540.580 and OAR 690-385-4400. No comments were filed in response to the notice.
3. The U.S. Bureau of Reclamation was notified of the transfer application on September 9, 2020; no comments were received within 90 days of the notification.
4. The portion of the first right to be transferred is as follows:
Certificate: 94956 in the name of CENTRAL OREGON IRRIGATION DISTRICT (confirmed by decree of the Circuit Court of the State of Oregon for Deschutes County)
Use: IRRIGATION of 35.07 acres
Priority Dates: OCTOBER 31, 1900 and DECEMBER 2, 1907
Seasons of Use: Season 1: April 1 through April 30 & October 1 through October 31
Season 2: May 1 through May 14 & September 16 through September 30
Season 3: May 15 through September 15

This final order is subject to judicial review by the Court of Appeals under ORS 183.482. Any petition for judicial review must be filed within the 60-day time period specified by ORS 183.482(1). Pursuant to ORS 536.075 and OAR 137-003-0675, you may petition for judicial review or petition the Director for reconsideration of this order. A petition for reconsideration may be granted or denied by the Director, and if no action is taken within 60 days following the date the petition was filed, the petition shall be deemed denied.

Within 20 days after this final order is issued (i.e., mailing date), the district or any protestant may file with the commission exceptions to the final order. The commission shall issue an order granting or denying the exceptions within 30 days after receiving the exceptions. ORS 540.580(10).

Maximum Quantity (Rate) that can be applied to an acre:

Season 1: Limited to 1/80 cubic foot per second (cfs) per acre

Season 2: Limited to 1/60 cfs per acre

Season 3: Limited to 1/32.4 cfs per acre

Maximum Duty that can be applied to an acre:

Not to exceed 9.91 acre-feet (af) per acre per year.

The above listed rates and duty reflect allowance of a 45% transmission loss as determined by decree of the Circuit Court of Deschutes County, dated March 24, 1933. Those lands not served from the district main canal systems, but by direct pumping from the Deschutes River, are not allowed the 45% transmission loss.

Source: The DESCHUTES RIVER, tributary to the COLUMBIA RIVER

Authorized Points of Diversion:

POD	Twp	Rng	Mer	Sec	Q-Q	Measured Distances
1	18 S	11 E	WM	13	SW NE	CENTRAL OREGON CANAL: 1520 FEET SOUTH AND 1535 FEET WEST FROM THE NE CORNER OF SECTION 13
10	17 S	12 E	WM	29	SW NE	RIVERS EDGE GOLF CLUB: 1980 FEET SOUTH AND 1160 FEET EAST FROM THE N1/4 CORNER OF SECTION 29
11	17 S	12 E	WM	29	SE NE	COID NORTH CANAL: 850 FEET NORTH AND 630 FEET WEST FROM THE E1/4 CORNER OF SECTION 29

Authorized Place of Use:

IRRIGATION									
Twp	Rng	Mer	Sec	Q-Q	Acres	Taxlot	Water User	Notice	POD
14 S	13 E	WM	15	SW NW	0.10	2400	BOYNTON	2020-003	11
14 S	13 E	WM	15	SW NW	0.35	2400	BOYNTON	2020-009	11
14 S	13 E	WM	16	SW NE	2.50	103	COID/QUITCLAIM	2020-18	11
14 S	13 E	WM	22	NE SE	1.90	101	DAVIS	2020-007	11
14 S	13 E	WM	27	NW SW	4.61	801	COID/QUITCLAIM	2020-018	11
14 S	13 E	WM	27	NW SW	3.00	300	JENNINGS	2020-022	11
14 S	13 E	WM	27	SW SW	0.34	801	COID/QUITCLAIM	2020-011	11
14 S	13 E	WM	27	SW SW	0.40	801	COID/QUITCLAIM	2020-013	11
14 S	13 E	WM	33	SW SW	2.04	1003	COID/QUITCLAIM	2020-018	11
14 S	14 E	WM	19	NE NW	0.60	201	HEMPHILL	2020-002	11
14 S	14 E	WM	19	SW NW	0.95	300	KASBERGER RANCH LLC	2020-018	11
14 S	14 E	WM	19	SE NW	1.00	300	KASBERGER RANCH LLC	2020-018	11
14 S	14 E	WM	19	SE SW	0.35	300	KASBERGER RANCH LLC	2020-018	11
14 S	14 E	WM	19	NW SE	0.45	300	KASBERGER RANCH LLC	2020-018	11
14 S	14 E	WM	19	SW SE	0.60	304	KASBERGER RANCH LLC	2020-018	11
15 S	12 E	WM	25	NE NE	0.60	102	WIDMER	2020-005	11
15 S	13 E	WM	5	SE NE	2.50	300	COID/QUITCLAIM	2020-018	11
15 S	13 E	WM	31	SE NW	0.09	702	ENDICOTT	2020-026	11
16 S	12 E	WM	11	NE NW	1.11	208	NAHLIK	2020-011	11
16 S	12 E	WM	23	SE SE	0.32	600	PARSONS	2020-015	11
16 S	12 E	WM	26	NE NE	2.70	401	PARSONS	2020-015	11
16 S	12 E	WM	26	NW NE	0.15	401	PARSONS	2020-015	11
16 S	12 E	WM	35	NW SE	0.81	1000	SHAFFER	2020-008	11
16 S	14 E	WM	4	SE SW	3.25	603	SOLESBEE	2020-014	11

IRRIGATION									
Twp	Rng	Mer	Sec	Q-Q	Acres	Taxlot	Water User	Notice	POD
17 S	12 E	WM	29	NE NW	0.05	102	RIVER'S EDGE INVESTMENTS	2020-019	11
17 S	12 E	WM	29	NE NW	0.05	103	RIVER'S EDGE INVESTMENTS	2020-019	10
17 S	12 E	WM	29	SE NW	0.05	102	RIVER'S EDGE INVESTMENTS	2020-019	10
17 S	13 E	WM	19	SE NW	0.64	1000	LARSEN	2020-017	1
17 S	13 E	WM	30	NE NW	1.05	205	BOMKE	2020-001	1
17 S	14 E	WM	13	SW SE	0.41	600	FORE	2020-012	1
17 S	14 E	WM	23	SE NW	0.50	800	MIDDLETON	2020-009	1
17 S	14 E	WM	23	NE SW	0.25	800	MIDDLETON	2020-009	1
17 S	14 E	WM	28	NW NE	0.50	2301	FLORENCE JENO REVOCABLE TRUST	2020-016	1
18 S	13 E	WM	2	SW SE	0.30	500	SCOTT/O'CONNELL	2020-010	1
18 S	13 E	WM	2	SE SE	0.10	500	SCOTT/O'CONNELL	2020-010	1
18 S	13 E	WM	4	SW NE	0.45	600	RALSTON	2020-004	1
Total					35.07				

5. Transfer Application T-13514 proposes to change the place of use to:

Proposed Place of Use:

IRRIGATION									
Twp	Rng	Mer	Sec	Q-Q	Acres	Taxlot	Water User	Notice	POD
14 S	13 E	WM	6	SE SE	0.40	400	MICHAEL/KAARIN FORESTER TRUSTEES	2020-013	11
14 S	13 E	WM	15	SW NW	0.35	2400	BOYNTON	2020-003	11
14 S	13 E	WM	22	NE SE	1.90	101	DAVIS	2020-007	11
14 S	13 E	WM	27	NW SW	3.00	300	JENNINGS	2020-022	11
14 S	14 E	WM	19	NE NW	0.60	201	HEMPHILL	2020-002	11
14 S	14 E	WM	19	NE SE	9.18	300	KASBERGER RANCH LLC	2020-018	11
14 S	14 E	WM	19	NW SE	0.95	300	KASBERGER RANCH LLC	2020-018	11
14 S	14 E	WM	19	SW SE	2.72	304	KASBERGR RANCH LLC	2020-018	11
14 S	14 E	WM	19	SE SE	2.25	304	KASBERGER RANCH LLC	2020-018	11
15 S	12 E	WM	25	NE NE	0.60	102	WIDMER	2020-005	11
15 S	13 E	WM	31	SE NW	0.09	702	ENDICOTT	2020-026	11
16 S	12 E	WM	11	NE NW	1.45	208	NAHLIK	2020-011	11
16 S	12 E	WM	26	NE NE	2.17	401	PARSONS	2020-015	11
16 S	12 E	WM	26	NW NE	1.00	401	PARSONS	2020-015	11
16 S	12 E	WM	35	NW SE	0.81	1000	SHAFFER	2020-008	11
17 S	12 E	WM	29	SE NW	0.15	101	RIVER'S EDGE INVESTMENTS	2020-019	10
17 S	13 E	WM	19	SE NW	0.64	1000	LARSEN	2020-017	1
17 S	13 E	WM	30	NE NW	0.80	205	BOMKE	2020-001	1
17 S	13 E	WM	30	NE NW	0.25	300	BOMKE	2020-001	1
17 S	14 E	WM	13	SW SE	0.41	600	FORE	2020-012	1
17 S	14 E	WM	23	SE NW	0.75	800	MIDDLETON	2020-009	1
17 S	14 E	WM	27	NE SW	3.00	200	MULCAHY	2020-014	1
17 S	14 E	WM	27	NW SW	0.25	200	MULCAHY	2020-014	1
17 S	14 E	WM	28	NW NE	0.40	2301	FLORENCE JENO REVOCABLE TRUST	2020-016	1
17 S	14 E	WM	28	SW NE	0.10	2301	FLORENCE JENO REVOCABLE TRUST	2020-016	1
18 S	13 E	WM	2	SW SE	0.03	500	SCOTT/O'CONNELL	2020-010	1

IRRIGATION									
Twp	Rng	Mer	Sec	Q-Q	Acres	Taxlot	Water User	Notice	POD
18 S	13 E	WM	2	SE SE	0.37	500	SCOTT/O'CONNELL	2020-010	1
18 S	13 E	WM	4	SW NE	0.45	600	RALSTON	2020-004	1
Total					35.07				

6. The portion of the second right to be transferred is as follows:

Certificate: 76714 in the name of CENTRAL OREGON IRRIGATION DISTRICT (perfected under Permit S-23256)

Use: SUPPLEMENTAL IRRIGATION of 35.07 acres

Priority Date: FEBRUARY 28, 1913

Limit/Duty: Limited to 50,000 acre-feet of stored water only. The appropriation shall be limited to the duty of water as set out in the modified supplemental decree of the circuit court dated March 24, 1933 in the matter of the determination of the relative rights to the use of the waters of the Deschutes River and its tributaries; provided further that the amount of water allowed herein, together with the amount secured under any other right existing for the same lands shall not exceed the limitation allowed herein, and shall be further limited to the terms of an inter-district contract dated January 4, 1938.

Source: CRANE PRAIRIE RESERVOIR, constructed under Permit R-1687, a tributary of the DESCHUTES RIVER

Authorized Point of Diversion:

Twp	Rng	Mer	Sec	Q-Q	POD Name
21 S	8 E	WM	17	NE NE	CRANE PRAIRIE RESERVOIR DAM

Authorized Place of Use:

SUPPLEMENTAL IRRIGATION								
Twp	Rng	Mer	Sec	Q-Q	Acres	Taxlot	Water User	Notice
14 S	13 E	WM	15	SW NW	0.10	2400	BOYNTON	2020-003
14 S	13 E	WM	15	SW NW	0.35	2400	BOYNTON	2020-009
14 S	13 E	WM	16	SW NE	2.50	103	COID/QUITCLAIM	2020-18
14 S	13 E	WM	22	NE SE	1.90	101	DAVIS	2020-007
14 S	13 E	WM	27	NW SW	4.61	801	COID/QUITCLAIM	2020-018
14 S	13 E	WM	27	NW SW	3.00	300	JENNINGS	2020-022
14 S	13 E	WM	27	SW SW	0.34	801	COID/QUITCLAIM	2020-011
14 S	13 E	WM	27	SW SW	0.40	801	COID/QUITCLAIM	2020-013
14 S	13 E	WM	33	SW SW	2.04	1003	COID/QUITCLAIM	2020-018
14 S	14 E	WM	19	NE NW	0.60	201	HEMPHILL	2020-002
14 S	14 E	WM	19	SW NW	0.95	300	KASBERGER RANCH LLC	2020-018
14 S	14 E	WM	19	SE NW	1.00	300	KASBERGER RANCH LLC	2020-018
14 S	14 E	WM	19	SE SW	0.35	300	KASBERGER RANCH LLC	2020-018
14 S	14 E	WM	19	NW SE	0.45	300	KASBERGER RANCH LLC	2020-018
14 S	14 E	WM	19	SW SE	0.60	304	KASBERGER RANCH LLC	2020-018
15 S	12 E	WM	25	NE NE	0.60	102	WIDMER	2020-005
15 S	13 E	WM	5	SE NE	2.50	300	COID/QUITCLAIM	2020-018
15 S	13 E	WM	31	SE NW	0.09	702	ENDICOTT	2020-026
16 S	12 E	WM	11	NE NW	1.11	208	NAHLIK	2020-011

SUPPLEMENTAL IRRIGATION								
Twsp	Rng	Mer	Sec	Q-Q	Acres	Taxlot	Water User	Notice
16 S	12 E	WM	23	SE SE	0.32	600	PARSONS	2020-015
16 S	12 E	WM	26	NE NE	2.70	401	PARSONS	2020-015
16 S	12 E	WM	26	NW NE	0.15	401	PARSONS	2020-015
16 S	12 E	WM	35	NW SE	0.81	1000	SHAFFER	2020-008
16 S	14 E	WM	4	SE SW	3.25	603	SOLESBEE	2020-014
17 S	12 E	WM	29	NE NW	0.05	102	RIVER'S EDGE INVESTMENTS	2020-019
17 S	12 E	WM	29	NE NW	0.05	103	RIVER'S EDGE INVESTMENTS	2020-019
17 S	12 E	WM	29	SE NW	0.05	102	RIVER'S EDGE INVESTMENTS	2020-019
17 S	13 E	WM	19	SE NW	0.64	1000	LARSEN	2020-017
17 S	13 E	WM	30	NE NW	1.05	205	BOMKE	2020-001
17 S	14 E	WM	13	SW SE	0.41	600	FORE	2020-012
17 S	14 E	WM	23	SE NW	0.50	800	MIDDLETON	2020-009
17 S	14 E	WM	23	NE SW	0.25	800	MIDDLETON	2020-009
17 S	14 E	WM	28	NW NE	0.50	2301	FLORENCE JENO REVOCABLE TRUST	2020-016
18 S	13 E	WM	2	SW SE	0.30	500	SCOTT/O'CONNELL	2020-010
18 S	13 E	WM	2	SE SE	0.10	500	SCOTT/O'CONNELL	2020-010
18 S	13 E	WM	4	SW NE	0.45	600	RALSTON	2020-004
Total					35.07			

7. Transfer Application T-13514 proposes to change the place of use to:

Proposed Place of Use:

SUPPLEMENTAL IRRIGATION								
Twsp	Rng	Mer	Sec	Q-Q	Acres	Taxlot	Water User	Notice
14 S	13 E	WM	6	SE SE	0.40	400	MICHAEL/KAARIN FORESTER TRUSTEES	2020-013
14 S	13 E	WM	15	SW NW	0.35	2400	BOYNTON	2020-003
14 S	13 E	WM	22	NE SE	1.90	101	DAVIS	2020-007
14 S	13 E	WM	27	NW SW	3.00	300	JENNINGS	2020-022
14 S	14 E	WM	19	NE NW	0.60	201	HEMPHILL	2020-002
14 S	14 E	WM	19	NE SE	9.18	300	KASBERGER RANCH LLC	2020-018
14 S	14 E	WM	19	NW SE	0.95	300	KASBERGER RANCH LLC	2020-018
14 S	14 E	WM	19	SW SE	2.72	304	KASBERGR RANCH LLC	2020-018
14 S	14 E	WM	19	SE SE	2.25	304	KASBERGER RANCH LLC	2020-018
15 S	12 E	WM	25	NE NE	0.60	102	WIDMER	2020-005
15 S	13 E	WM	31	SE NW	0.09	702	ENDICOTT	2020-026
16 S	12 E	WM	11	NE NW	1.45	208	NAHLIK	2020-011
16 S	12 E	WM	26	NE NE	2.17	401	PARSONS	2020-015
16 S	12 E	WM	26	NW NE	1.00	401	PARSONS	2020-015
16 S	12 E	WM	35	NW SE	0.81	1000	SHAFFER	2020-008
17 S	12 E	WM	29	SE NW	0.15	101	RIVER'S EDGE INVESTMENTS	2020-019
17 S	13 E	WM	19	SE NW	0.64	1000	LARSEN	2020-017
17 S	13 E	WM	30	NE NW	0.80	205	BOMKE	2020-001
17 S	13 E	WM	30	NE NW	0.25	300	BOMKE	2020-001
17 S	14 E	WM	13	SW SE	0.41	600	FORE	2020-012
17 S	14 E	WM	23	SE NW	0.75	800	MIDDLETON	2020-009

SUPPLEMENTAL IRRIGATION								
Twp	Rng	Mer	Sec	Q-Q	Acres	Taxlot	Water User	Notice
17 S	14 E	WM	27	NE SW	3.00	200	MULCAHY	2020-014
17 S	14 E	WM	27	NW SW	0.25	200	MULCAHY	2020-014
17 S	14 E	WM	28	NW NE	0.40	2301	FLORENCE JENO REVOCABLE TRUST	2020-016
17 S	14 E	WM	28	SW NE	0.10	2301	FLORENCE JENO REVOCABLE TRUST	2020-016
18 S	13 E	WM	2	SW SE	0.03	500	SCOTT/O'CONNELL	2020-010
18 S	13 E	WM	2	SE SE	0.37	500	SCOTT/O'CONNELL	2020-010
18 S	13 E	WM	4	SW NE	0.45	600	RALSTON	2020-004
Total					35.07			

8. The Department finds that the district permanent transfer application was submitted according to ORS 540.580 and OAR 690-385-4000, contains the information required under OARs 690-385-4200 and 690-385-2000, and includes maps meeting the requirements of OARs 690-385-4300 and 690-385-2200.
9. The Department finds that the proposed district permanent transfer meets all the criteria set forth in ORS 540.580 and OAR 690-385-4000.
10. The proposed change in places of use will not result in enlargement of the right as defined in OAR 690-385-0100(4).
11. The proposed change in places of use will not result in injury to other water rights as defined in OAR 690-385-0100(6).
12. Any other applicable requirements for district permanent water right transfers are met as required in OAR 690-385-4500.

Conclusions of Law


The proposed change in places of use as proposed in Transfer Application T-13514 comply with and satisfy the requirements of ORS 540.580 and OAR 690-385-4500.

Now, therefore, it is ORDERED:

1. The proposed change in places of use to the water rights evidenced by Certificates 94956 and 76714 are approved.
2. The right to the use of the water is restricted to beneficial use at the places of use not modified by this order and is subject to all other conditions and limitations contained in Certificates 94956 and 76714 and any related decree.
3. The places of use from which the water right is removed by T-13514 shall no longer be irrigated under the transferred right.
4. The district shall maintain and operate the existing measurement device and shall make such improvements as may be required by the Department.

5. Full beneficial use of the water shall be made, consistent with the terms of this order, on or before **October 1, 2022**. A Claim of Beneficial Use shall be submitted by COLD to the Department within one year after the deadline for completion of the changes and full beneficial use of the water.
6. Water right Certificates 94956 and 76714 are modified. After satisfactory proof of completion has been determined by the Department, superseding confirming-remaining water right certificates will be issued when the Department determines it is necessary for record keeping.

Dated in Salem, Oregon on JAN 08 2021

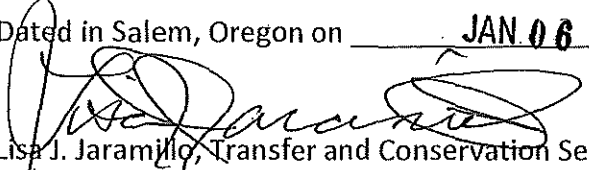
Lisa J. Jaramillo, Transfer and Conservation Section Manager for
THOMAS M. BYLER, DIRECTOR
Oregon Water Resources Department

Mailing Date: JAN 08 2021

WATER RIGHT TRANSFER COVER SHEET

Transfer: T- 13514

Transfer Specialist:

Transfer Type: District Permanent Transfer

Applicant: CENTRAL OREGON IRRIGATION DISTRICT 1055 SW LAKE COURT REDMOND, OR 97756 Email: _____ Phone: _____		Agent: ☐ N/A UNAVAILABLE Email: _____ Phone: _____	
Irrigation District: ☐ N/A Email: _____		CWRE: ☐ N/A Email: _____	
Affected Local Gov'ts: ☐ N/A Gail McGarry-BOR Email: _____		Affected Tribal Gov't: ☐ N/A UNAVAILABLE Email: _____	
Current Landowner if other than Applicant: ☐ N/A Email: _____		Receiving Landowner: ☐ N/A Email: _____	

Water Rights Affected

File Marked	App. File # or Decree Name	Permit	Certificate	RR/CR Needed	RR/CR Nos.
☐	DECREE	DESCHUTES	94956	☐ Yes ☐ No	
☐	S-13180	S-23256	76714	☐ Yes ☐ No	
☐				☐ Yes ☐ No	

Key Dates & Initial Actions:

Rec'd: September 2, 2020	Proposed Action(s): PLACE OF USE	
Fees Pd: 1680.00	WM District: 11	ODFW District:
Initial Public Notice: September 8, 2020	WM Review sent:	ODFW Review sent:
Acknowledgement Letter Sent ☒		GW Review sent: ☐ N/A
County sent cc: of Ack Letter ☐	BOR notified (date): ☐ N/A	
Newspaper quote requested:	Request for news \$ sent:	News \$ received:
Request to publish sent:	Affidavit of publication received:	Last day of publication:

Document	Drafted	Peer Review	Changes Made	Coordinator	Changes Made	Signature Bin	Signature Date
DPD	Date: _____ Initials: _____	Date: _____ Initials: _____	Date: _____ Initials: _____	Date: _____ Initials: _____	Date: _____ Initials: _____	CW Sent: _____	N/A
PD	Date: _____ Initials: _____	Date: _____ Initials: _____	Date: _____ Initials: _____	Date: _____ Initials: _____	Date: _____ Initials: _____	Date: _____	Date: _____
FO	Date: _____ Initials: _____	Date: _____ Initials: _____	Date: _____ Initials: _____	Date: _____ Initials: _____	Date: _____ Initials: _____	Date: _____	Date: _____

Special Issues: Fix the completion date before the New Year!

Special Order Volume: Vol. 118 Pages 319

Then GTG
😊

Watermaster Review Form: Water Right Transfer



Oregon Water Resources Department
725 Summer St NE, Suite A
Salem, Oregon 97301-1266
(503) 986-0900
www.oregon.gov/OWRD

Transfer Application: T-13514

Review Due Date: 10/02/2020

Applicant Name: COLD

Proposed Changes: ☒ POU ☐ POD ☐ POA ☐ USE ☐ OTHER

Reviewer(s): Giffin

Date of Review: 09/04/2020

1. Do you have evidence that the right has not been used in the last 5 years and that the presumption of forfeiture would not likely be rebuttable? ☐ Yes ☒ No If "Yes", attach evidence (e.g. dated aerial photo showing pavement or building on the land for >5 yrs.)
2. Is there a history of regulation on the source that serves this (or these) right(s) that has involved the transferred right(s) and downstream water rights? ☒ Yes ☐ No Generally characterize the frequency of any regulation or explain why regulation has not occurred:
We regulate the Deschutes River every day of the year for instream and out of stream water rights.
3. Have headgate notices been issued for the source that serves the transferred right(s)?
☐ Yes ☒ No ☐ Records not available.
4. In your estimation, after the proposed change, would distribution of water for the right(s) result in regulation of other water rights that would not have occurred if use under the original right(s) was/were maximized? ☐ Yes ☒ No If "Yes", explain:
5. In your estimation, if the proposed change is approved, are there upstream water rights that would be affected? ☐ Yes ☒ No If "Yes", describe how the rights would be affected and list the rights most affected:

6. Check here ☐ if it appears that downstream water rights benefit from return flows resulting from the current use of the transferred right(s)? If you check the box, generally characterize the locations where the return flows likely occur and list the water rights that benefit most:

☐ N/A

7. For POD changes and instream transfers, check here if there are channel losses between the old and new PODs or within the proposed instream reach? If you check the box, describe and, if possible, estimate the losses:

☒ N/A

8. For instream transfers that propose protection of a reach beyond the mouth of the source stream:

☒ N/A Would the quantity be measureable into the receiving stream consistent with OAR 690-077-0015(8)? ☐ Yes ☐ No

9. For POU changes: ☐ N/A Is it likely the original place of use would continue to receive water from the same source? ☐ Yes ☒ No If "Yes", explain:

10. For POU or USE changes: ☐ N/A In your best judgment, would use of the existing right at "full face value," result in the diversion of more water than can be used beneficially and without waste?

☐ Yes ☒ No If "Yes", explain:

11. For POU changes that involve micro-irrigation: ☒ N/A

- a. Has the applicant made changes (absent a transfer) to convert to micro-irrigation within the current place of use boundary of the water right proposed for transfer, and previously demonstrated to the Department through monitoring and site inspections by the Watermaster that the proposed transfer will not result in injury or enlargement?

☐ Yes ☐ No If "Yes", explain:

- b. Has a temporary transfer of this nature been previously filed and approved on the same lands (or portions thereof) as those lands involved in this transfer?

☐ Yes ☒ No If "Yes", answer the following:

- i. Were there any problems with more acres being irrigated (or wetted) than were authorized under the temporary transfer? ☐ Yes ☐ No If "Yes", explain:
- ii. Did the designated areas that were to remain dry (or not wetted) under the temporary transfer actually remain dry? ☐ Yes ☐ No If "No", explain:
- iii. Did the applicant comply with and meet all of the conditions of the temporary transfer? ☐ Yes ☐ No If "No", explain:
- iv. Do you have any other observations regarding the temporary transfer? ☐ Yes ☐ No If "Yes", describe:
- v. Did the applicant demonstrate to the Department through monitoring and site inspections by the Watermaster that neither injury nor enlargement occurred as a result of the temporary transfer? ☐ Yes ☐ No If "No", explain:

- c. To the best of your knowledge, if this transfer is approved, does it appear that:

- i. "Injury" will occur to other water rights that share the same source?

☐ Yes ☒ No If "Yes", explain:

- ii. "Enlargement" of the water right being transferred will occur?

☐ Yes ☒ No If "Yes", explain:

12. Are there other issues not identified through the above questions that should be considered in determining whether the change "can be effected without injury to other rights"?

☒ Yes ☐ No If "Yes", explain:

I walked the 1.9 acres on 14 13 22 TL 101 and could not see any use, past use or way to apply water to this parcel. We may want more information on how this was beneficially used in the past

13. What alternatives may be available for addressing any issues identified above:

14. Do conditions need to be included in the transfer order to avoid enlargement of the right or injury to other rights? ☒ No ☐ Yes, as checked and provided below:

☐ For POU changes that involve micro-irrigation, provide the monitoring and reporting conditions necessary to prevent injury/enlargement:

☐ A Headgate should be required prior to diverting water.

☐ Measurement Devices for POD or POA: (if this condition is selected, also fill in the top sections of Page 4)

*a. Before water use may begin under this order, the water user shall install a **totalizing flow meter***, or, with prior approval of the Director, another suitable measuring device, ☐ at each point of diversion/appropriation (new and existing) **OR** at each new point of diversion/appropriation ☐ with the exception that water rights issued to the Bureau of Reclamation or an irrigation district (or similar entity) are not subject to this condition.*

b. The water user shall maintain the meters or measuring devices in good working order.

c. The water user shall allow the Watermaster access to the meters or measuring devices; provided however, where the meters or measuring devices are located within a private structure, the Watermaster shall request access upon reasonable notice.

☐ Reservoir water use measurement: (if this condition is selected, also fill in the top sections of Page 4)

*a. Before water use may begin under this order, the water user shall install **staff gages***, or, with prior approval of the Director, other suitable measuring devices, that measure the entire range and stage between empty and full in each reservoir. Staff gages shall be United States Geological Survey style.*

b. Before water use may begin under this order, if the reservoir is located in channel, weirs or other suitable measuring devices must be installed upstream and downstream of the reservoir, and, an adjustable outlet valve must be installed. The water user shall maintain such devices in good working order. A written waiver may be obtained, if in the judgment of the Director, the installation of weirs or other suitable measuring devices, or the adjustable outlet valve, will provide no public benefit.

* The following alternative device(s) should be substituted for the bold, underlined device in the above selected condition:

☐ Weir	☐ Submerged Orifice
☐ Parshall Flume	☐ Flow Restrictor
☐ Other: _____	

Oregon Water Resources Department
Measurement Condition Information for the Applicant
(To be sent with the Draft Preliminary Determination or Final Order)

Transfer #: T-

☐ In order to avoid enlargement of the right or injury to other rights, a _____ will
 be required to be installed **prior to diversion of water**, as a condition of this transfer:
 ☐ at each point of diversion/appropriation (new and existing) **OR**
 ☐ at each new point of diversion/appropriation.

For additional information, or to obtain approval of a different type of measurement device, the applicant should contact the area Watermaster:

Watermaster name:

District:

Address:

City/State/Zip:

Phone:

Email:

Note: If a device other than the one specified in the Preliminary Determination or Final Order is approved by the Watermaster, fill out and mail the form below to the Salem office.

Approval of an Alternate Measurement Device T-
(to be filled out after consultation with the applicant, or after a site visit)

On behalf of the Director, I authorize use of the following suitable alternate measurement device:

 Watermaster signature

 District

 Date

If this form is used for approval of an alternative measurement device, it must be mailed to:

Oregon Water Resources Department
 725 Summer Street NE, Suite A
 Salem, OR 97301-1266



Oregon
Kate Brown, Governor

Water Resources Department

725 Summer St NE, Suite A

Salem, OR 97301

(503) 986-0900

Fax (503) 986-0904

September 2, 2020

CENTRAL OREGON IRRIGATION DISTRICT
1055 SW LAKE COURT
REDMOND OR 97756

Reference: District Permanent Transfer T-13514

On 08/24/2020 we received your district transfer application requesting change. The application was accompanied by \$1680.00. Your receipt number 133309 is enclosed.

By copy of this letter, we are asking the Watermaster for their report regarding the potential for injury to existing water rights which may be caused by the change.

This application will be published on the Department's weekly notice dated UNAVAILABLE viewable at http://apps.wrd.state.or.us/apps/misc/wrd_notice_view/?notice_id=21. A copy of the application can be assessed through this public notice link. Pursuant to Oregon administrative rules, the Department is requesting public comments on the recently filed district transfer application listed above. Comments may be submitted by any interested persons within 30 days of the weekly notice publication date. Comments must be received by the Department on or before October 8, 2020. For details on how to file comments please refer to the Department's weekly notice. Details for filing protests, if applicable, are also noted on the weekly notice.

If you have any questions, please call the Transfer Section, (503) 986-0815.

cc: Watermaster # (via email)
Bureau of Reclamation
File

enclosure



RECEIVED

AUG 24 2020

OWRD

August 18, 2020

Ann Reece
Oregon Water Resources Department
725 Summer Street, NE Ste "A"
Salem, OR 97301-1271

RE: District Transfer – P-2020-001

Dear Ann,

Please find enclosed our District Petition Number 2020-001. Also enclosed is our check for \$1,680.00 (#23017) as payment of the transfer fee. Petition includes District transfer notice numbers: T-2020-001, 002, 003, 004, 005, 007, 008, 009, 010, 011, 013, 014, 015, 016, 017, 018, 019, 022, and 026.

Sincerely,

A handwritten signature in blue ink, appearing to read "Leslie Clark".

Leslie Clark
Director of Water Rights

Encl.

8/7/2020

TABLE 2. - PROPOSED PLACE OF USE

P-2020-001

RECEIVED

AUG 24 2020

Cert/Decree	Cert/Perm	TRANSFER NBR	POD	USE	TWP	RNG	SEC	QQ	LOT	ACRES	USER NAME
PRIMARY	SUPP										
94956	76714	T-2020-012	#1	IRRIG	17	14	13	SWSE	00600	0.410	Fore, Robert Jr./Erynne
94956	76714	T-2020-009	#1	IRRIG	17	14	23	SENW	00800		Middleton, Keith
94956	76714	T-2020-009	#1	IRRIG	17	14	23	SENW	00800	0.750	Middleton, Keith
94956	76714	T-2020-014	#1	IRRIG	17	14	27	NESW	00200	3.000	Mulcahy, Richard/Denise
94956	76714	T-2020-014	#1	IRRIG	17	14	27	NWSW	00200	0.250	Mulcahy, Richard/Denise
94956	76714	T-2020-016	#1	IRRIG	17	14	28	NWNE	02301	0.400	Jeno, Florence Revocable Trust
94956	76714	T-2020-016	#1	IRRIG	17	14	28	SWNE	02301	0.100	Jeno, Florence Revocable Trust
94956	76714	T-2020-010	#1	IRRIG	18	13	02	SESE	00500		Scott, Benjamin/O'Connell, Rebecca
94956	76714	T-2020-010	#1	IRRIG	18	13	02	SESE	00500	0.370	Scott, Benjamin/O'Connell, Rebecca
94956	76714	T-2020-010	#1	IRRIG	18	13	02	SWSE	00500	0.030	Scott, Benjamin/O'Connell, Rebecca
94956	76714	T-2020-004	#1	IRRIG	18	13	04	SWNE	00600	0.450	Ralston, Jacob/Dayna
										<u>35.070</u>	

OWRD

13514

8/7/2020

TABLE 1. - AUTHORIZED PLACE OF USE

P-2020-001

RECEIVED

AUG 24 2020

OWRD

Cert/Decree	Cert/Perm										
PRIMARY	SUPP	TRANSFER NBR	POD	USE	TWP	RNG	SEC	QQ	LOT	ACRES	USER NAME
94956	76714	T-2020-003	#11	IRRIG	14	13	15	SWNW	02400	0.100	Boynton, Sharon
94956	76714	T-2020-018	#11	IRRIG	14	13	15	SWNW	02400	0.350	Boynton, Sharon
94956	76714	T-2020-018	#11	IRRIG	14	13	16	SWNE	00103		COID/Quitclaim
94956	76714	T-2020-018	#11	IRRIG	14	13	16	SWNE	00103	2.500	COID/Quitclaim
94956	76714	T-2020-007	#11	IRRIG	14	13	22	NESE	00101	1.900	Davis, Victoria
94956	76714	T-2020-018	#11	IRRIG	14	13	27	NWSW	00801	4.610	COID/Quitclaim
94956	76714	T-2020-022	#11	IRRIG	14	13	27	NWSW	00300	3.000	Jennings, Ryan
94956	76714	T-2020-011	#11	IRRIG	14	13	27	SWSW	00801	0.340	COID/Quitclaim
94956	76714	T-2020-013	#11	IRRIG	14	13	27	SWSW	00801	0.400	COID/Quitclaim
94956	76714	T-2020-018	#11	IRRIG	14	13	33	SWSW	01003	2.040	COID/Quitclaim
94956	76714	T-2020-002	#11	IRRIG	14	14	19	NENW	00201	0.600	Hemphill, Carl/Cynthia
94956	76714	T-2020-018	#11	IRRIG	14	14	19	NWSE	00300	0.450	Kasberger Ranch, LLC
94956	76714	T-2020-018	#11	IRRIG	14	14	19	SENW	00300		Kasberger Ranch, LLC
94956	76714	T-2020-018	#11	IRRIG	14	14	19	SENW	00300	1.000	Kasberger Ranch, LLC
94956	76714	T-2020-018	#11	IRRIG	14	14	19	SESW	00300	0.350	Kasberger Ranch, LLC
94956	76714	T-2020-018	#11	IRRIG	14	14	19	SWNW	00300	0.950	Kasberger Ranch, LLC
94956	76714	T-2020-018	#11	IRRIG	14	14	19	SWSE	00304		Kasberger Ranch, LLC
94956	76714	T-2020-018	#11	IRRIG	14	14	19	SWSE	00304	0.600	Kasberger Ranch, LLC
94956	76714	T-2020-005	#11	IRRIG	15	12	25	NENE	00102	0.600	Widmer, Sidney/Melanie
94956	76714	T-2020-018	#11	IRRIG	15	13	05	SENE	00300	2.500	COID/Quitclaim
94956	76714	T-2020-026	#11	IRRIG	15	13	31	SENW	00702	0.090	Endicott, George/Krisanna
94956	76714	T-2020-011	#11	IRRIG	16	12	11	NENW	00208	1.110	Nahlik, Stacy/Matthew
94956	76714	T-2020-015	#11	IRRIG	16	12	23	SESE	00600	0.320	Parsons, Leo D.
94956	76714	T-2020-015	#11	IRRIG	16	12	26	NENE	00401		Parsons, Leo D.
94956	76714	T-2020-015	#11	IRRIG	16	12	26	NENE	00401		Parsons, Leo D.
94956	76714	T-2020-015	#11	IRRIG	16	12	26	NENE	00401	2.700	Parsons, Leo D.
94956	76714	T-2020-015	#11	IRRIG	16	12	26	NWNE	00401		Parsons, Leo D.
94956	76714	T-2020-015	#11	IRRIG	16	12	26	NWNE	00401	0.150	Parsons, Leo D.
94956	76714	T-2020-008	#11	IRRIG	16	12	35	NWSE	01000	0.810	Shaffer, Matthew
94956	76714	T-2020-014	#1	IRRIG	16	14	04	SESW	00603		Solesbee, Justin/Hannah
94956	76714	T-2020-014	#1	IRRIG	16	14	04	SESW	00603	3.250	Solesbee, Justin/Hannah
94956	76714	T-2020-019	#10	IRRIG	17	12	29	NENW	00103	0.050	River's Edge Investments
94956	76714	T-2020-019	#10	IRRIG	17	12	29	NENW	00102	0.050	River's Edge Investments
94956	76714	T-2020-019	#10	IRRIG	17	12	29	SENW	00102	0.050	River's Edge Investments
94956	76714	T-2020-017	#1	IRRIG	17	13	19	SENW	01000	0.640	Larsen, Chris/Kit

8/7/2020

TABLE 1. - AUTHORIZED PLACE OF USE

P-2020-001

RECEIVED

AUG 24 2020

OWRD

Cert/Decree PRIMARY	Cert/Perm SUPP	TRANSFER NBR	POD	USE	TWP	RNG	SEC	QQ	LOT	ACRES	USER NAME
94956	76714	T-2020-001	#1	IRRIG	17	13	30	NENW	00205		Bomke, Kurt/Jennifer
94956	76714	T-2020-001	#1	IRRIG	17	13	30	NENW	00205	1.050	Bomke, Kurt/Jennifer
94956	76714	T-2020-012	#1	IRRIG	17	14	13	SWSE	00600	0.410	Fore, Robert Jr./Erynne
94956	76714	T-2020-009	#1	IRRIG	17	14	23	NESW	00800	0.250	Middleton, Keith
94956	76714	T-2020-009	#1	IRRIG	17	14	23	SESW	00800	0.500	Middleton, Keith
94956	76714	T-2020-016	#1	IRRIG	17	14	28	NWNE	02301		Jeno, Florence Revocable Trust
94956	76714	T-2020-016	#1	IRRIG	17	14	28	NWNE	02301	0.500	Jeno, Florence Revocable Trust
94956	76714	T-2020-010	#1	IRRIG	18	13	02	SESE	00500		Scott, Benjamin/O'Connell, Rebecca
94956	76714	T-2020-010	#1	IRRIG	18	13	02	SESE	00500	0.100	Scott, Benjamin/O'Connell, Rebecca
94956	76714	T-2020-010	#1	IRRIG	18	13	02	SWSE	00500	0.300	Scott, Benjamin/O'Connell, Rebecca
94956	76714	T-2020-004	#1	IRRIG	18	13	04	SWNE	00600	0.450	Ralston, Jacob/Dayna
										<u>35.070</u>	

13514

8/7/2020

TABLE 2. - PROPOSED PLACE OF USE

P-2020-001

RECEIVED

AUG 24 2020

OWRD

Cert/Decree	Cert/Perm										
PRIMARY	SUPP	TRANSFER NBR	POD	USE	TWP	RNG	SEC	QQ	LOT	ACRES	USER NAME
94956	76714	T-2020-013	#11	IRRIG	14	13	06	SESE	00400	0.400	Forester, Michael/Kaarin Trustees
94956	76714	T-2020-003	#11	IRRIG	14	13	15	SWNW	02400	0.350	Boynnton, Sharon
94956	76714	T-2020-007	#11	IRRIG	14	13	22	NESE	00101	1.900	Davis, Victoria
94956	76714	T-2020-022	#11	IRRIG	14	13	27	NWSW	00300	3.000	Jennings, Ryan
94956	76714	T-2020-002	#11	IRRIG	14	14	19	NENW	00201	0.600	Hemphill, Carl/Cynthia
94956	76714	T-2020-018	#11	IRRIG	14	14	19	NESE	00300		Kasberger Ranch, LLC
94956	76714	T-2020-018	#11	IRRIG	14	14	19	NESE	00300		Kasberger Ranch, LLC
94956	76714	T-2020-018	#11	IRRIG	14	14	19	NESE	00300	9.180	Kasberger Ranch, LLC
94956	76714	T-2020-018	#11	IRRIG	14	14	19	NWSE	00300		Kasberger Ranch, LLC
94956	76714	T-2020-018	#11	IRRIG	14	14	19	NWSE	00300		Kasberger Ranch, LLC
94956	76714	T-2020-018	#11	IRRIG	14	14	19	NWSE	00300		Kasberger Ranch, LLC
94956	76714	T-2020-018	#11	IRRIG	14	14	19	NWSE	00300	0.950	Kasberger Ranch, LLC
94956	76714	T-2020-018	#11	IRRIG	14	14	19	SESE	00304		Kasberger Ranch, LLC
94956	76714	T-2020-018	#11	IRRIG	14	14	19	SESE	00304		Kasberger Ranch, LLC
94956	76714	T-2020-018	#11	IRRIG	14	14	19	SESE	00304	2.250	Kasberger Ranch, LLC
94956	76714	T-2020-018	#11	IRRIG	14	14	19	SWSE	00304		Kasberger Ranch, LLC
94956	76714	T-2020-018	#11	IRRIG	14	14	19	SWSE	00304		Kasberger Ranch, LLC
94956	76714	T-2020-018	#11	IRRIG	14	14	19	SWSE	00304	2.720	Kasberger Ranch, LLC
94956	76714	T-2020-005	#11	IRRIG	15	12	25	NENE	00102	0.600	Widmer, Sidney/Melanie
94956	76714	T-2020-026	#11	IRRIG	15	13	31	SESW	00702	0.090	Endicott, George/Krisanna
94956	76714	T-2020-011	#11	IRRIG	16	12	11	NENW	00208		Nahlik, Stacy/Matthew
94956	76714	T-2020-011	#11	IRRIG	16	12	11	NENW	00208	1.450	Nahlik, Stacy/Matthew
94956	76714	T-2020-015	#11	IRRIG	16	12	26	NENE	00401		Parsons, Leo D.
94956	76714	T-2020-015	#11	IRRIG	16	12	26	NENE	00401	2.170	Parsons, Leo D.
94956	76714	T-2020-015	#11	IRRIG	16	12	26	NWNE	00401		Parsons, Leo D.
94956	76714	T-2020-015	#11	IRRIG	16	12	26	NWNE	00401		Parsons, Leo D.
94956	76714	T-2020-015	#11	IRRIG	16	12	26	NWNE	00401		Parsons, Leo D.
94956	76714	T-2020-015	#11	IRRIG	16	12	26	NWNE	00401	1.000	Parsons, Leo D.
94956	76714	T-2020-008	#11	IRRIG	16	12	35	NWSE	01000	0.810	Shaffer, Matthew
94956	76714	T-2020-019	#10	IRRIG	17	12	29	SESW	00101		River's Edge Investments
94956	76714	T-2020-019	#10	IRRIG	17	12	29	SESW	00101		River's Edge Investments
94956	76714	T-2020-019	#10	IRRIG	17	12	29	SESW	00101	0.150	River's Edge Investments
94956	76714	T-2020-017	#1	IRRIG	17	13	19	SESW	01000	0.640	Larsen, Chris/Kit
94956	76714	T-2020-001	#1	IRRIG	17	13	30	NENW	00205	0.800	Bomke, Kurt/Jennifer
94956	76714	T-2020-001	#1	IRRIG	17	13	30	NENW	00300	0.250	Bomke, Kurt/Jennifer

13514

**STATE OF OREGON
WATER RESOURCES DEPARTMENT**

725 Summer St. N.E. Ste. A
SALEM, OR 97301-4172
(503) 986-0900 / (503) 986-0904 (fax)

RECEIPT # **133309**

INVOICE # _____

RECEIVED FROM:

Central Oregon Irrigation District

BY: _____

APPLICATION

PERMIT

TRANSFER

T-13514

CASH:

CHECK: #

OTHER: (IDENTIFY)

☐
☒

2301

☐

TOTAL REC'D

\$ 1,680.00

1083 TREASURY 4170 WRD MISC CASH ACCT

0407 COPIES

\$

OTHER: (IDENTIFY)

\$

0243 I/S Lease

0244 Muni Water Mgmt. Plan

0245 Cons. Water

4270 WRD OPERATING ACCT

MISCELLANEOUS

46110

0407 COPY & TAPE FEES

\$

0410 RESEARCH FEES

\$

0408 MISC REVENUE: (IDENTIFY)

\$

TC162 DEPOSIT LIAB. (IDENTIFY)

\$

0240 EXTENSION OF TIME

\$

WATER RIGHTS:

EXAM FEE

RECORD FEE

0201 SURFACE WATER

\$

0202

\$

0203 GROUND WATER

\$

0204

\$

0205 TRANSFER

\$ 1,680.00

WELL CONSTRUCTION

EXAM FEE

LICENSE FEE

0218 WELL DRILL CONSTRUCTOR

\$

0219

\$

LANDOWNER'S PERMIT

0220

\$

OTHER (IDENTIFY)

0536 TREASURY 0437 WELL CONST. START FEE

0211 WELL CONST START FEE

\$

CARD #

0210 MONITORING WELLS

\$

CARD #

OTHER (IDENTIFY)

0607 TREASURY 0467 HYDRO ACTIVITY LIC NUMBER

0233 POWER LICENSE FEE (FW/WRD)

\$

0231 HYDRO LICENSE FEE (FW/WRD)

\$

HYDRO APPLICATION

\$

TREASURY OTHER / RDX

FUND _____ TITLE _____

OBJ. CODE _____ VENDOR # _____

DESCRIPTION _____

\$

RECEIPT: **133309**

DATED: *8-24-2020*

BY: *[Signature]*

Distribution - White Copy - Customer, Yellow Copy - Fiscal, Blue Copy - File, Buff Copy - Fiscal



Oregon Water Resources Department
725 Summer Street NE, Suite A
Salem Oregon 97301-1266
(503) 986-0900
www.wrd.state.or.us

RECEIVED
AUG 24 2020
OWRD

Application for District Permanent Water Right Transfer

Please type or print legibly in dark ink. If your application is incomplete or inaccurate, we will return it to you. If any requested information does not apply to your application, insert "N/A" to indicate "Not Applicable." As you complete this form, please refer to notes and guidance included on the application. A summary of review criteria and procedures that are generally applicable to the application is available at www.wrd.state.or.us/OWRD/PUBS/forms.shtml#app_criteria_review.

Change in Place of Use Only

1A. APPLICANT INFORMATION

IRRIGATION DISTRICT CENTRAL OREGON IRRIGATION DISTRICT			PHONE NO. 541-548-6047	ADDITIONAL CONTACT NO. LESLIE CLARK
ADDRESS 1055 SW LAKE COURT			COUNTY DESCHUTES	
CITY REDMOND	STATE OR	ZIP 97756	E-MAIL lesliec@coid.org	
BY PROVIDING AN E-MAIL ADDRESS, CONSENT IS GIVEN TO RECEIVE ALL CORRESPONDENCE FROM THE DEPARTMENT ELECTRONICALLY. COPIES OF THE FINAL ORDER DOCUMENTS WILL ALSO BE MAILED.				

1B. AGENT INFORMATION

AGENT/BUSINESS NAME			PHONE NO.	ADDITIONAL CONTACT NO.
ADDRESS			FAX NO.	
CITY	STATE	ZIP	E-MAIL	
BY PROVIDING AN E-MAIL ADDRESS, CONSENT IS GIVEN TO RECEIVE ALL CORRESPONDENCE FROM THE DEPARTMENT ELECTRONICALLY. COPIES OF THE FINAL ORDER DOCUMENTS WILL ALSO BE MAILED.				

2. PROPOSED CHANGE(S) TO WATER RIGHT(S)

- List **all** water rights to be affected by this transfer. Indicate the certificate, permit, decree or other identifying number(s) in the table below: (Attach additional pages as necessary.)

	Certificate	Permit / Previous Transfer	Decree
1.	94956	-	PRIMARY
2.	76714	-	SUPPLEMENTAL
3.		-	
4.		-	
5.		-	
6.		-	

13514

RECEIVED

AUG 24 2020

OWRD

3. ATTACHMENTS

Check each of the following **attachments** included with this application. The application will be returned if all required attachments are not included.

Supplemental Form A – Description of Proposed Change(s) to a Water Right ☐ A <u>separate</u> Supplemental Form A is enclosed for <u>each</u> water right to be affected by this transfer. Map ☒ Permanent Transfer A map meeting the requirements of OAR 690-385-3300 must be included but need not be prepared by a Certified Water Right Examiner (CWRE).	Fees: ☐ Amount enclosed: \$ _____ See the Department's Fee Schedule at www.wrd.state.or.us or call (503) 986-0900. Land Use Compatibility Statement ☒ The Land Use Information Form is <u>not</u> required if water is to be diverted, conveyed and/or used only on federal lands or if <u>ALL</u> of the following apply: a) a change in place of use only, b) a change that does not involve the placement or modification of structures, c) the use of water is for irrigation only and d) the use is located within an irrigation district or an exclusive farm use zone.
---	--

4. SIGNATURES

The district certifies the following:

- (1) The water rights proposed for transfer are water rights subject to transfer and are not subject to forfeiture for nonuse under ORS 540.610;
- (2) Each user affected by the proposed transfer has provided written authorization for the transfer and such authorization is on file with the district;
- (3) For lands which are no longer irrigated or susceptible of irrigation that are included in this transfer under the authority of ORS 540.572 and OAR 690-385-5000, notices as required under ORS.572 and OAR 690-385-5100 have been given to the user and any security interest holder of record of intent to transfer the right and the user was provided an opportunity to resolve the matter in the manner described by ORS 540.572 and OAR 690-385-5400 and 690-385-5600.
- (4) On behalf of the district, I affirm to the best of my knowledge the information contained in this application is true and accurate.


District Manager signature

Craig Horrel
name (print)

8.7.20
date

OR

Authorized District Representative signature

name (print)

date

Before submitting your application to the Department, be sure you have:

- Answered each question completely.
- Included all the required attachments.
- Included a check payable to the Oregon Water Resources Department for the appropriate amount.



District Permanent Water Right Transfer Application

Supplemental Form A

RECEIVED

AUG 24 2020

OWRD

DESCRIPTION OF PROPOSED CHANGE(S) TO A WATER RIGHT

List only one water right per page. A separate Supplemental Form A must be completed for each certificate, permit, decree, or other right involved in the proposed transfer.

Attach additional copies of Supplemental Form A as needed to describe other certificates, permits, decrees or other rights involved in this transfer.

1. CURRENT WATER RIGHT INFORMATION

Water Right Subject to Transfer (check and complete one of the following):

☒ Certificated Right	94956	
	Certificate Number	
☐ Adjudicated, Non-certificated Right	Name of Decree	Page Number
☐ Permit for which Proof has been Approved	-	
	Permit Number	Date Claim of Beneficial Use Submitted
☐ Transferred Right for which Proof has been Filed	-	
	Previous Transfer Number	Date Claim of Beneficial Use Submitted
☐ Permit for Supplemental Irrigation	-	
	Permit Number	

- Name on Permit, Certificate, or Decree: CENTRAL OREGON IRRIGATION DISTRICT
- Priority Date(s): OCTOBER 31, 1900 & DECEMBER 2, 1907

If there are **multiple Priority Dates** identified on the water right, any information provided in Supplemental Form A of this application must identify which priority date is associated with each of the authorized points of diversion or appropriation and places of use.

Source(s) of Water to be Affected by Transfer: DESCHUTES RIVER

Tributary to: COLUMBIA RIVER

- Are there **other water rights**, Permits or Ground Water Registrations associated with this land?
☒ Yes ☐ No

If "Yes", what are the Permit, Registration or Certificate Numbers? 76714

Any “layered” water use or a right that is supplemental to a primary right proposed for transfer **must be included in the transfer or be cancelled.**

RECEIVED

AUG 24 2020

OWRD

▪ Certificate Number or other identifying number: 94956

The following information must be provided only for those points of diversion or appropriation that are involved in the transfer.

If a point of diversion or appropriation is not numbered on the decree or water right certificate or permit, assign it a unique number in the following table (e.g. POD #1 or POA(well) #1). Use the number to refer to the point of diversion or appropriation serving the place of use described in Tables I and II. Note: Permanent district transfers do not allow for a change in point of diversion or appropriation to serve the proposed place of use.

Government lot and donation land claim numbers must be included in the table below **only** if the information is reflected on the existing water right.

Location of Existing Authorized Point(s) of Diversion (POD) or Appropriation (POA):

(i.e., the allowed point(s) of diversion or appropriation listed on the water right for the "FROM" or "OFF" lands)

AUTHORIZED POINT(S) of DIVERSION (POD) or APPROPRIATION (POA)							
POD# or POA#	TWP	RNG	SEC	QQ	DLC	GOV'T LOT	MEASURED DISTANCES
1	18 S	11 E	13	SW			CENTRAL OREGON CANAL: 1520' SOUTH AND 1535' WEST FROM THE NE CORNER OF SECTION 13
11	17 S	12 E	29	SE NE			NORTH CANAL: 850' NORTH AND 630' WEST FROM THE E 1/4 CORNER OF SECTION 29

13514

RECEIVED

AUG 24 2020

OWRD



District Permanent Water Right Transfer Application
Supplemental Form A

RECEIVED

AUG 24 2020

OWRD

DESCRIPTION OF PROPOSED CHANGE(S) TO A WATER RIGHT

List only one water right per page. A separate Supplemental Form A must be completed for each certificate, permit, decree, or other right involved in the proposed transfer.

Attach additional copies of Supplemental Form A as needed to describe other certificates, permits, decrees or other rights involved in this transfer.

1. CURRENT WATER RIGHT INFORMATION

Water Right Subject to Transfer (check and complete one of the following):

☒ Certificated Right	76714	
	Certificate Number	
☐ Adjudicated, Non-certificated Right		
	Name of Decree	Page Number
☐ Permit for which Proof has been Approved	-	
	Permit Number	Date Claim of Beneficial Use Submitted
☐ Transferred Right for which Proof has been Filed	-	
	Previous Transfer Number	Date Claim of Beneficial Use Submitted
☐ Permit for Supplemental Irrigation	-	
	Permit Number	

- Name on Permit, Certificate, or Decree: CENTRAL OREGON IRRIGATION DISTRICT
- Priority Date(s): FEBRUARY 28, 1913

If there are **multiple Priority Dates** identified on the water right, any information provided in Supplemental Form A of this application must identify which priority date is associated with each of the authorized points of diversion or appropriation and places of use.

Source(s) of Water to be Affected by Transfer: CRANE PRAIRIE RESERVOIR

Tributary to: DESCHUTES RIVER

- Are there **other water rights**, Permits or Ground Water Registrations associated with this land?
☒ Yes ☐ No

If "Yes", what are the Permit, Registration or Certificate Numbers? 94956

Any "layered" water use or a right that is supplemental to a primary right proposed for transfer **must be included in the transfer or be cancelled.**

RECEIVED

AUG 24 2020

OWRD

- Certificate Number or other identifying number: 76714

The following information must be provided only for those points of diversion or appropriation that are involved in the transfer.

If a point of diversion or appropriation is not numbered on the decree or water right certificate or permit, assign it a unique number in the following table (e.g. POD #1 or POA(well) #1). Use the number to refer to the point of diversion or appropriation serving the place of use described in Tables I and II. Note: Permanent district transfers do not allow for a change in point of diversion or appropriation to serve the proposed place of use.

Government lot and donation land claim numbers must be included in the table below **only** if the information is reflected on the existing water right.

Location of Existing Authorized Point(s) of Diversion (POD) or Appropriation (POA):

(i.e., the allowed point(s) of diversion or appropriation listed on the water right for the "FROM" or "OFF" lands)

AUTHORIZED POINT(S) of DIVERSION (POD) or APPROPRIATION (POA)							
POD# or POA#	TWP	RNG	SEC	QQ	DLC	GOV'T LOT	MEASURED DISTANCES
	21 S	8 E	17	NE NE			CRANE PRAIRIE RESERVOIR DAM

13514

RECEIVED
AUG 24 2020
OWRD

DESCHUTES COUNTY
SEC.06 T14S R13E

SCALE - 1" = 400'




SE 1/4 OF THE SE 1/4

RECEIVED

AUG 24 2020

OWRD

DISTRICT INTERNAL
NOTICE #: T-2020-013

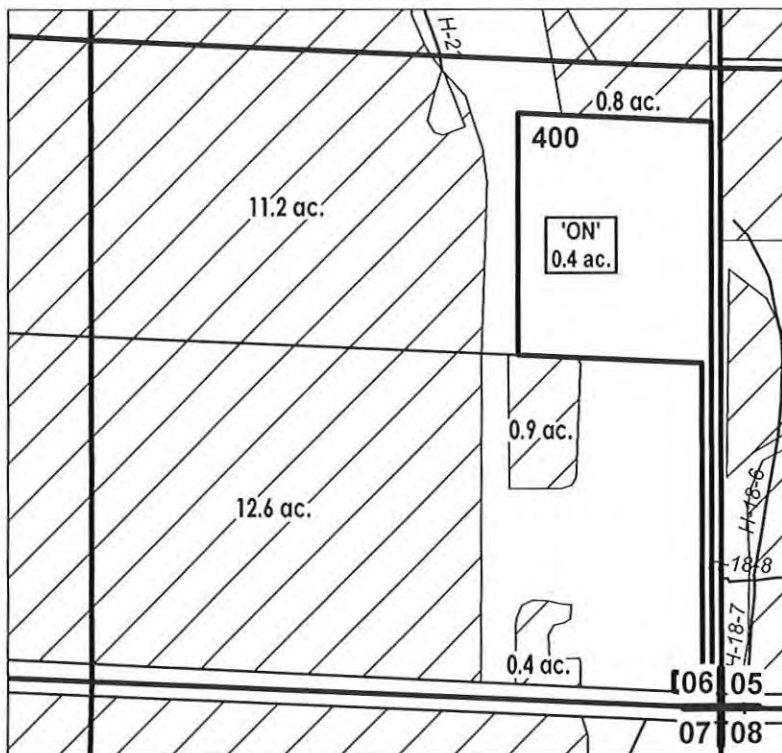

'ON' MAP

# ac.	'ON' LAND PARCELS
	EXISTING WATER RIGHTS



APPLICATION FOR WATER RIGHTS TRANSFER

NAME: Forester, Michael

TAXLOT #: 400

0.4 ACRES 14

Date: 04/28/2020

DESCHUTES COUNTY SEC.15 T14S R13E

SCALE - 1" = 400'




SW 1/4 OF THE NW 1/4

RECEIVED

AUG 24 2020

OWRD

DISTRICT INTERNAL
NOTICE #: T-2020-003

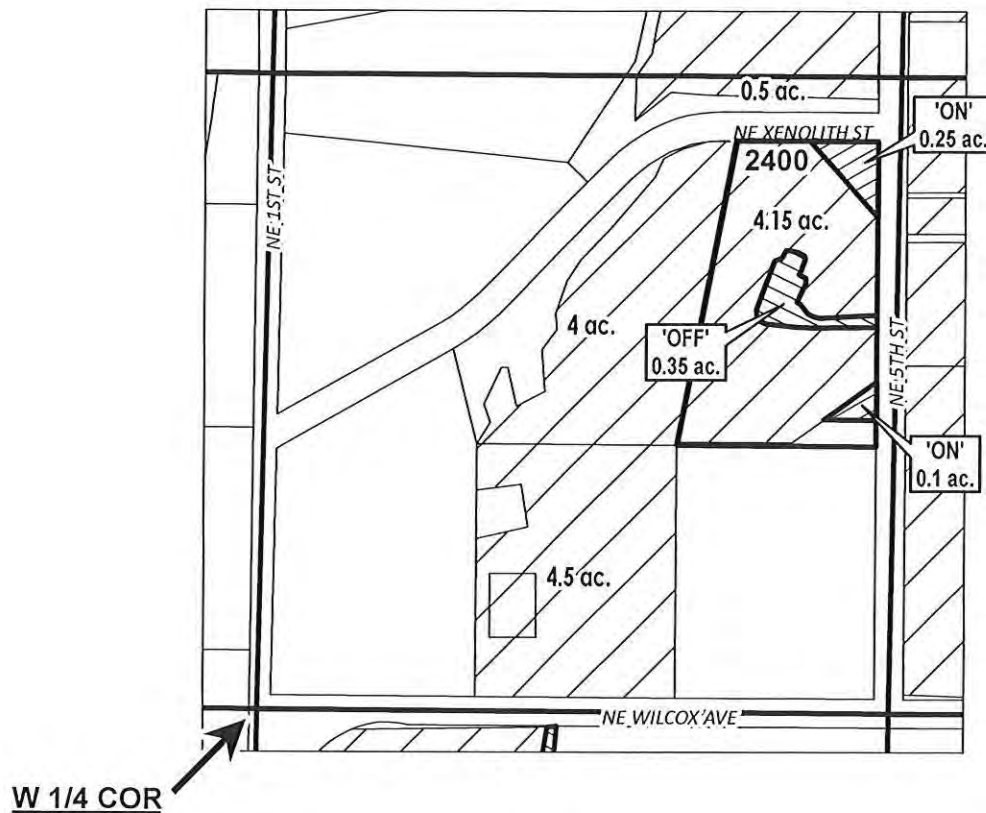

"OFF/ON" MAP



APPLICATION FOR WATER RIGHTS TRANSFER

SHARON L. BOYNTON

TAXLOT #: 2400

13514
0.35 ACRES

Date: 03/06/2020

DESCHUTES COUNTY SEC.22 T14S R13E

SCALE - 1" = 400'




NE 1/4 OF THE SE 1/4

RECEIVED

AUG 24 2020

OWRD

DISTRICT INTERNAL
NOTICE #: T-2020-007

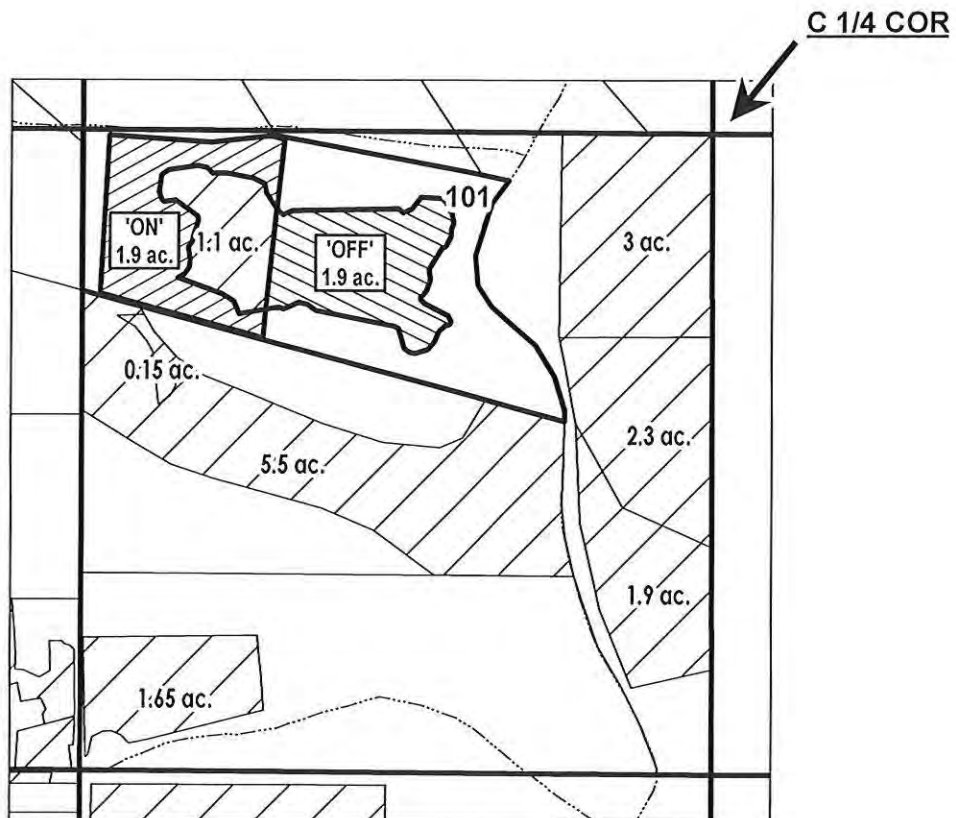

"OFF/ON" MAP

	EXISTING WATER RIGHTS
	OFF LANDS
	ON LANDS



APPLICATION FOR WATER RIGHTS TRANSFER

VICTORIA LEE DAVIS AND HARRY COOPER DAVIS

TAXLOT #: 101

1.9 ACRES 13 5 14

Date: 02/27/2020

FILE: I:\TRANSFER\WRTRANS17\CONFISCATION\141311_NESE

DESCHUTES COUNTY SEC.27 T14 R13E

SCALE - 1" = 400'



NW 1/4 OF THE SW 1/4


RECEIVED

AUG 24 2020


OWRD

DISTRICT INTERNAL
NOTICE #: T-2020-022

W 1/4 COR

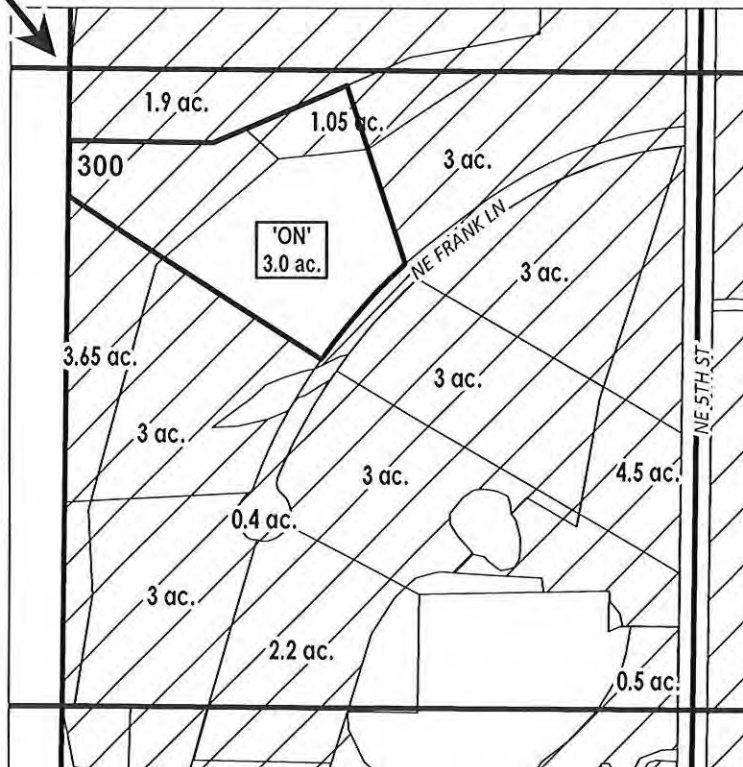

"ON" MAP

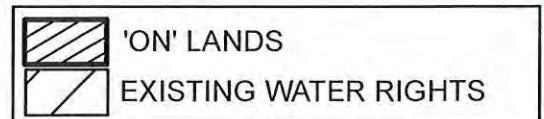

APPLICATION FOR WATER RIGHTS TRANSFER

NAME: RYAN C. JENNINGS

TAXLOT #: 300

3.0 ACRES

13514

Date: 7/6/2020

FILE: I:\TRANSFER\WRTRANS17\CONFISCATION\141311 NESE

RECEIVED

AUG 24 2020

OWRD

CROOK COUNTY SEC.19 T14S R14E

SCALE - 1" = 400'




SE 1/4

"OFF/ON" MAP

	EXISTING WATER RIGHTS
	OFF LANDS
	ON LANDS

DISTRICT INTERNAL
NOTICE #: T-2020-018

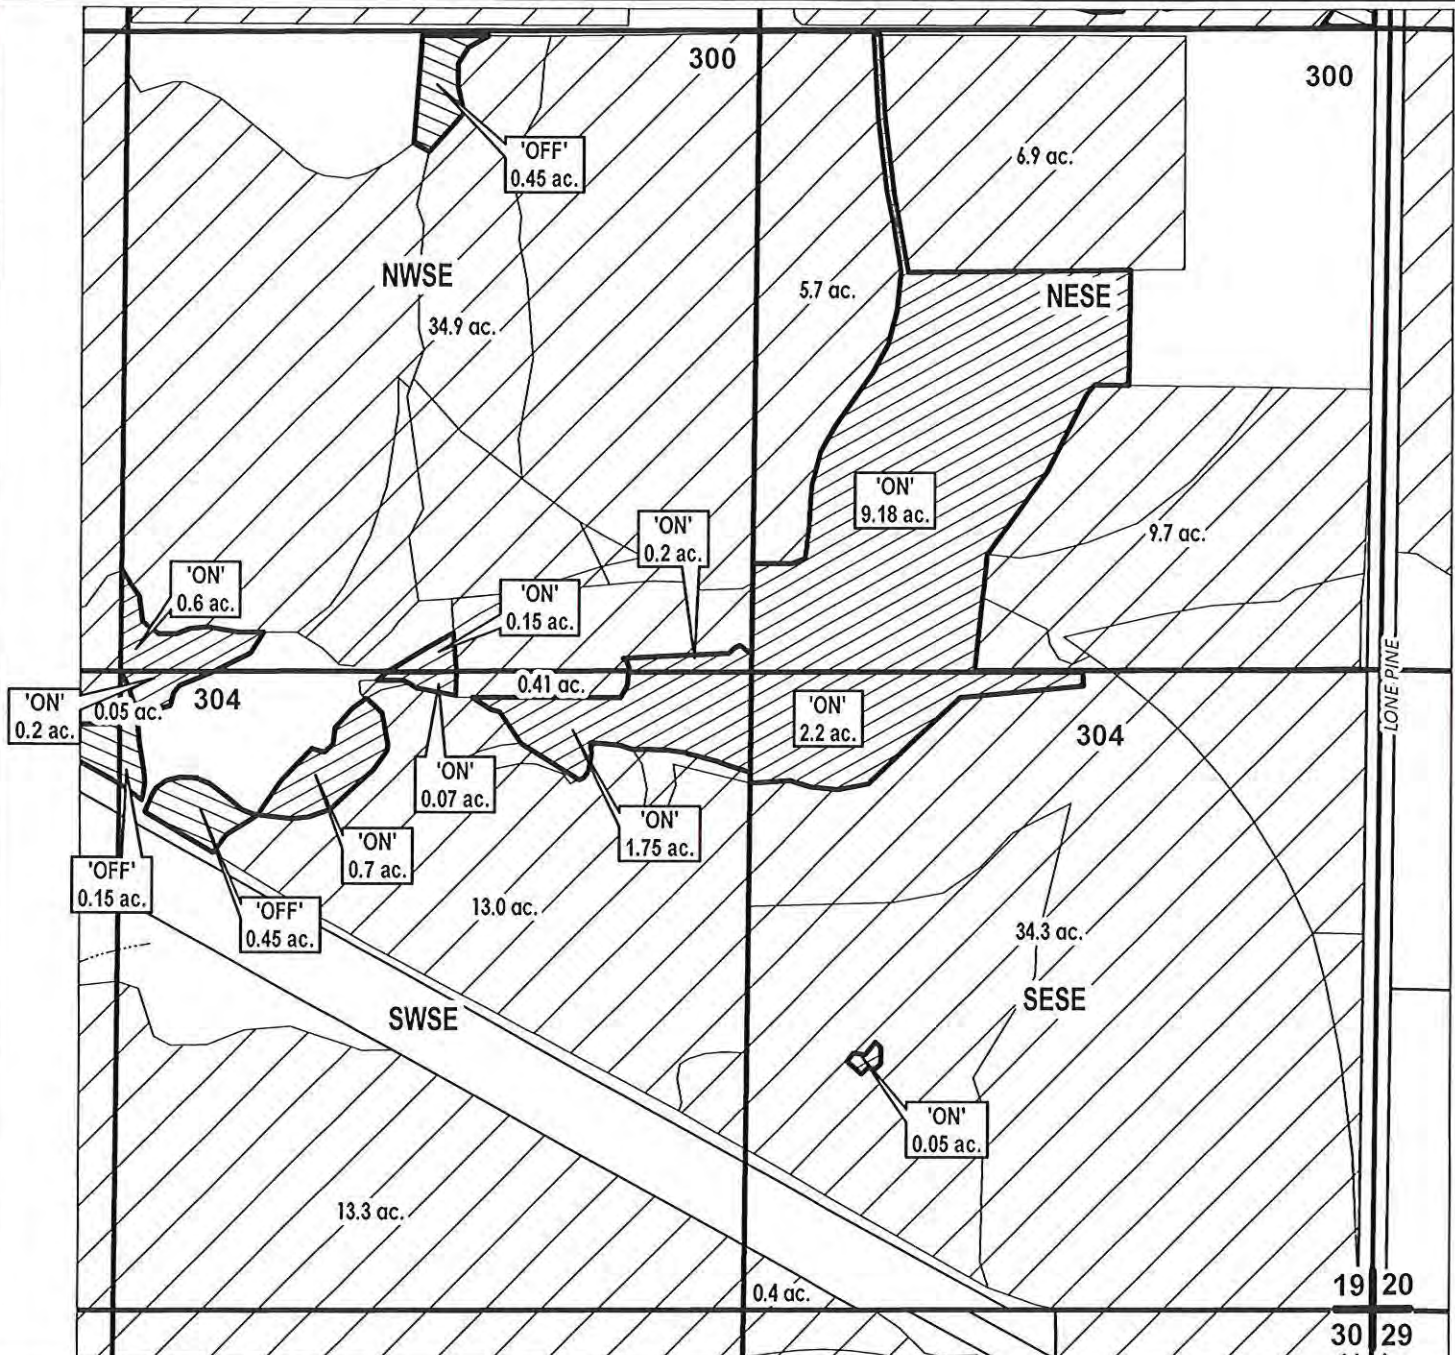

APPLICATION FOR TEMPORARY WATER RIGHTS TRANSFER

NAME: KASBERGER RANCH LLC

TAXLOT #: 300, 304

1.05 ACRES OFF
15.1 ACRES ON

DATE: 6/22/2020

DESCHUTES COUNTY SEC.25 T15S R12E

SCALE - 1" = 400'




NE 1/4 OF THE NE 1/4

RECEIVED

AUG 24 2020

OWRD

DISTRICT INTERNAL
NOTICE #: T-2020-005

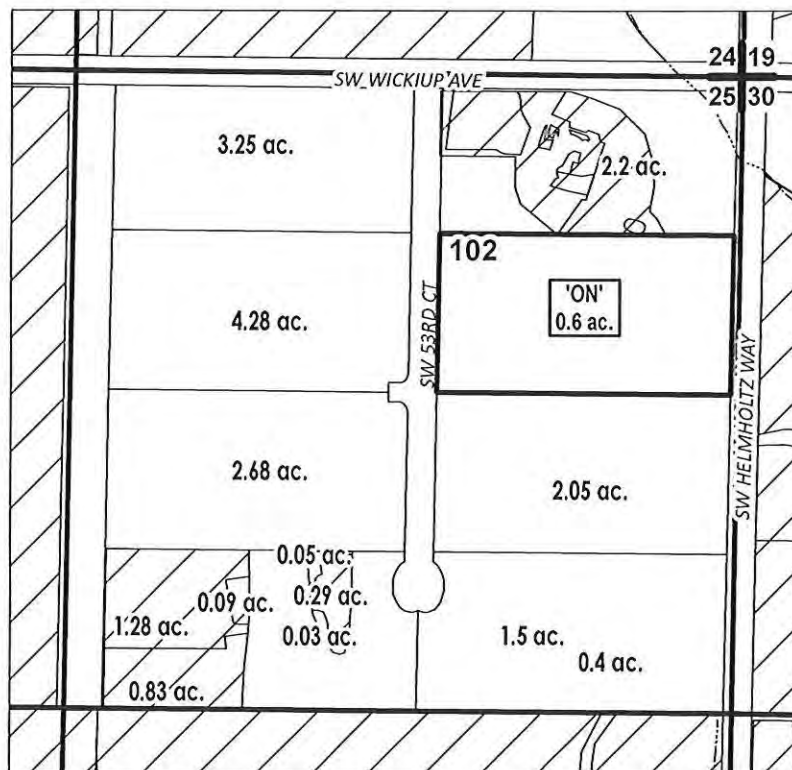

"ON" MAP

	'ON' LANDS
	# ac. PARCELS W/ WATER RIGHTS
	EXISTING WATER RIGHTS



APPLICATION FOR WATER RIGHTS TRANSFER

NAME: SIDNEY & MELANIE WIDMER

TAXLOT #: 102

0.6 ACRES 13514

Date: 6/15/2020

DESCHUTES COUNTY SEC.31 T15 R13E

SCALE - 1" = 400'




SE1/4 OF THE NW 1/4

RECEIVED

AUG 24 2020

OWRD

DISTRICT INTERNAL
NOTICE #: T-2020-026

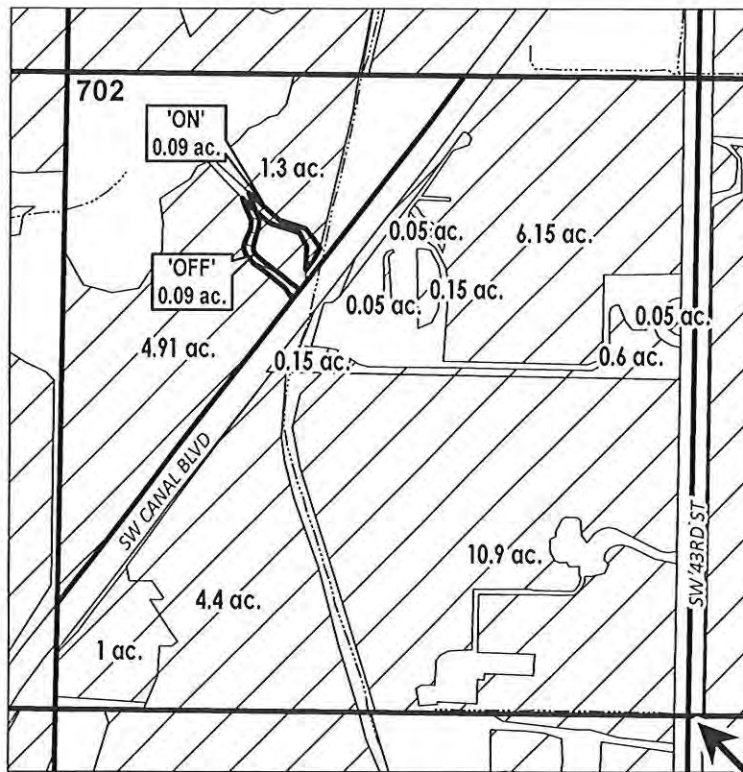

C 1/4 COR

	'ON' LANDS
	OFF LANDS
	EXISTING WATER RIGHTS

"OFF/ON" MAP



APPLICATION FOR WATER RIGHTS TRANSFER

NAME: GEORGE W ENDICOTT AND KRISANNA H. CLARK-ENDICOTT

TAXLOT #: 702

0.09 ACRES 13 5 14

Date: 7/6/2020

DESCHUTES COUNTY SEC.11 T16S R12E

SCALE - 1" = 400'




NE 1/4 OF THE NW 1/4

RECEIVED


AUG 24 2020

OWRD

DISTRICT INTERNAL
NOTICE #: T-2020-011

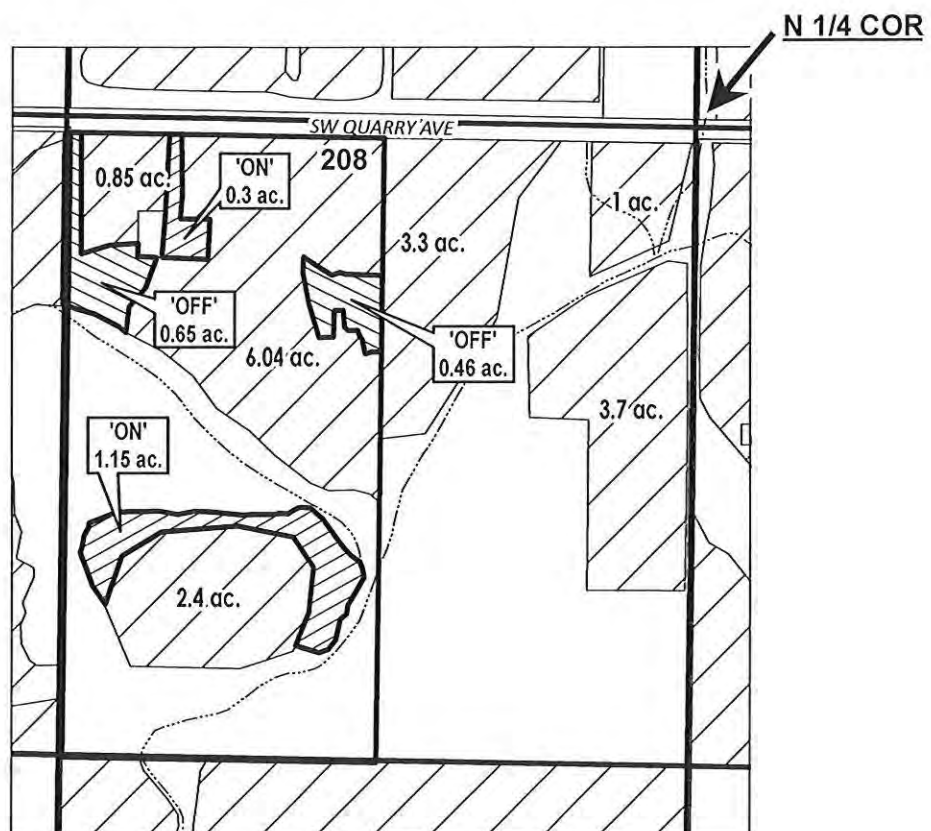

"OFF/ON" MAP

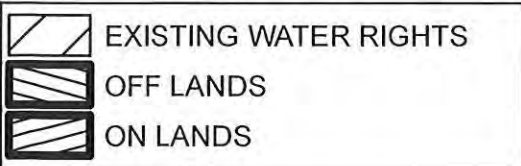

APPLICATION FOR WATER RIGHTS TRANSFER

STACY AND MATTHEW NAHLIK

TAXLOT #: 208

1.11 ACRES OFF
1.45 ACRES 'ON'

Date: 03/31/2020

DESCHUTES COUNTY SEC.26 T16S R12E

RECEIVED

AUG 24 2020


OWRD

SCALE - 1" = 400'




NW 1/4 OF THE NE 1/4; NE 1/4 OF THE NE 1/4

DISTRICT INTERNAL
NOTICE #: T-2020-015

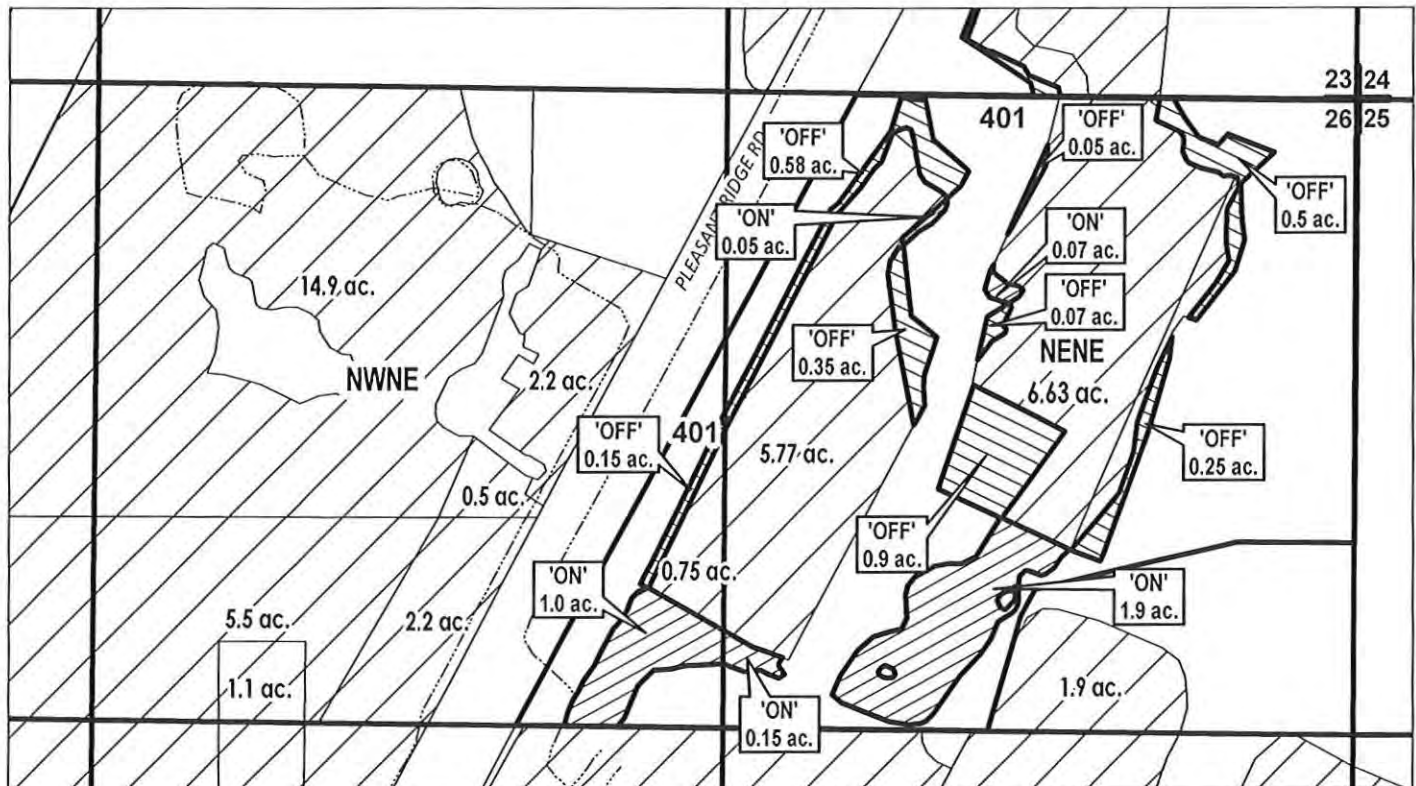

"OFF/ON" MAP

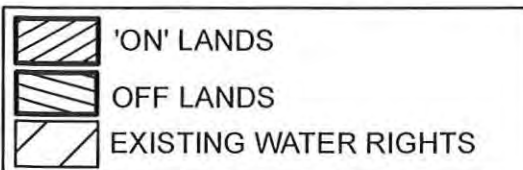

APPLICATION FOR WATER RIGHTS TRANSFER

NAME: LEO D. JUDY PARSONS 13514

TAXLOT #: 401

2.85 ACRES 'OFF'
3.17 ACRES 'ON'



Date: 04/15/2020

DESCHUTES COUNTY SEC.35 T16S R12E

SCALE - 1" = 400'




NW 1/4 OF THE SE 1/4

RECEIVED

AUG 24 2020

OWRD

DISTRICT INTERNAL
NOTICE #: T-2020-008

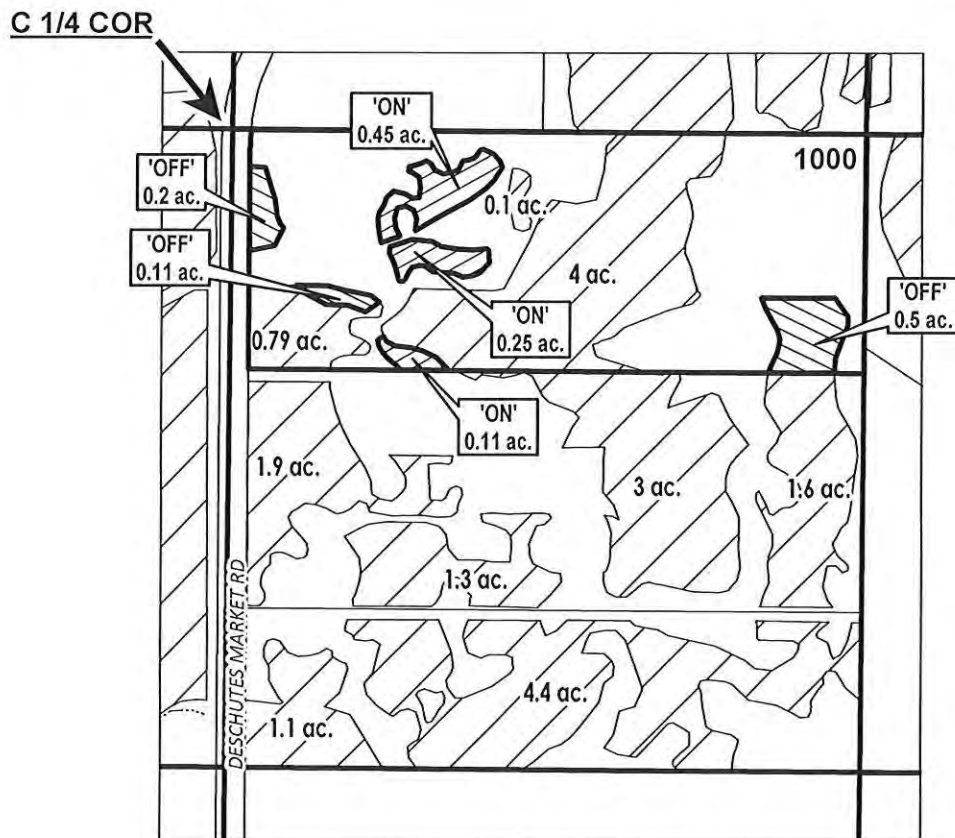

	EXISTING WATER RIGHTS
	OFF LANDS
	ON LANDS

"OFF/ON" MAP



APPLICATION FOR WATER RIGHTS TRANSFER

Matthew and Jessica Shaffer 13514

TAXLOT #: 1000

0.81 ACRES

Date: 03/31/2020

DESCHUTES COUNTY SEC.29 T17S R12E

RECEIVED

AUG 24 2020


SCALE - 1" = 400'

OWRD




NE 1/4 OF THE NW 1/4; SE 1/4 OF THE NW 1/4

DISTRICT INTERNAL
NOTICE #: T-2020-019

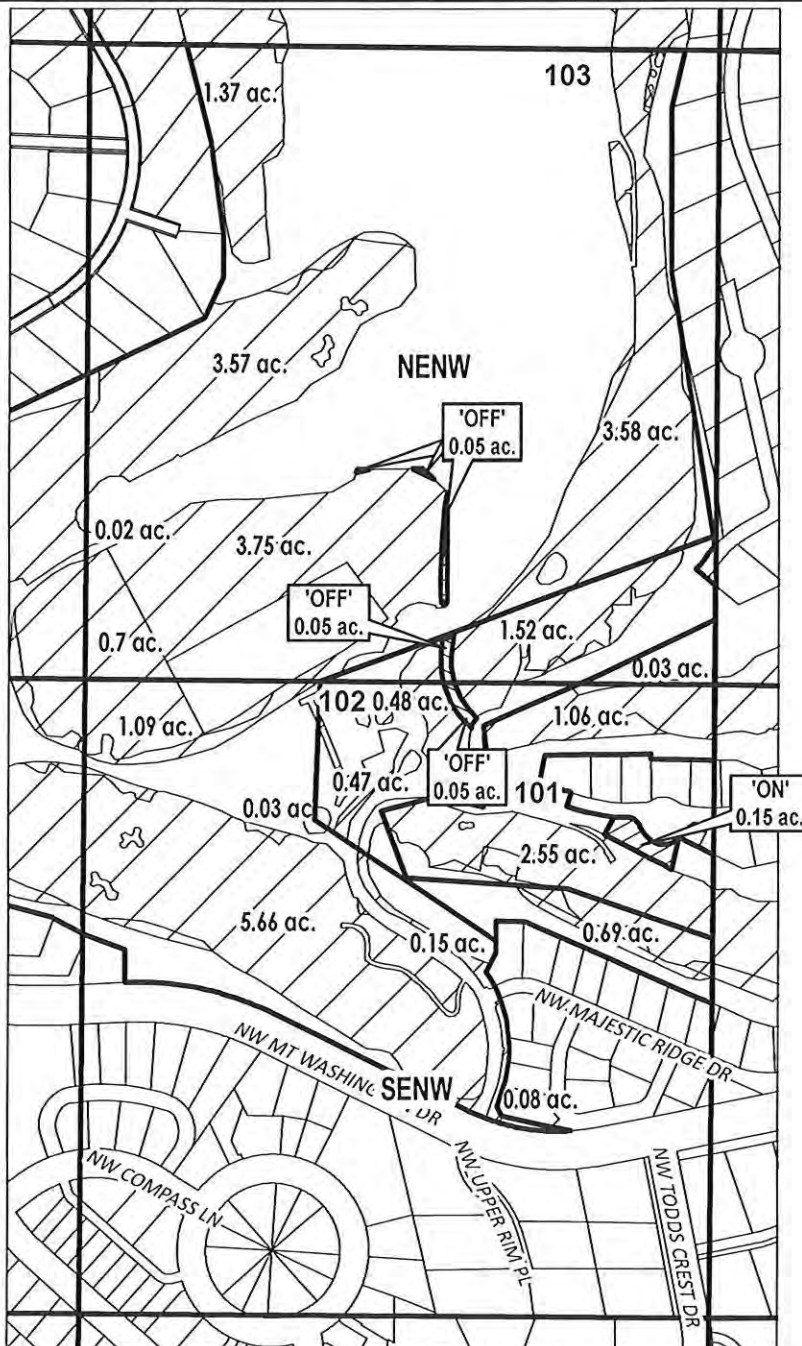

"OFF/ON" MAP

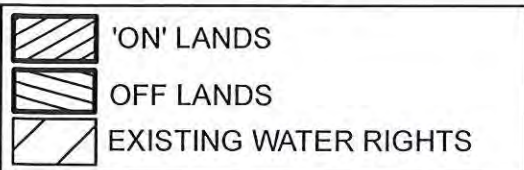

APPLICATION FOR WATER RIGHTS TRANSFER

NAME: RIVER'S EDGE INVESTMENTS, LLC

TAXLOT #: 101, 102, 103

0.15 ACRES **13514**

Date: 04/15/2020

DESCHUTES COUNTY SEC.19 T17S R13E

RECEIVED

AUG 24 2020


OWRD

SCALE - 1" = 400'



SE 1/4 OF THE NW 1/4

DISTRICT INTERNAL
NOTICE #: T-2020-017

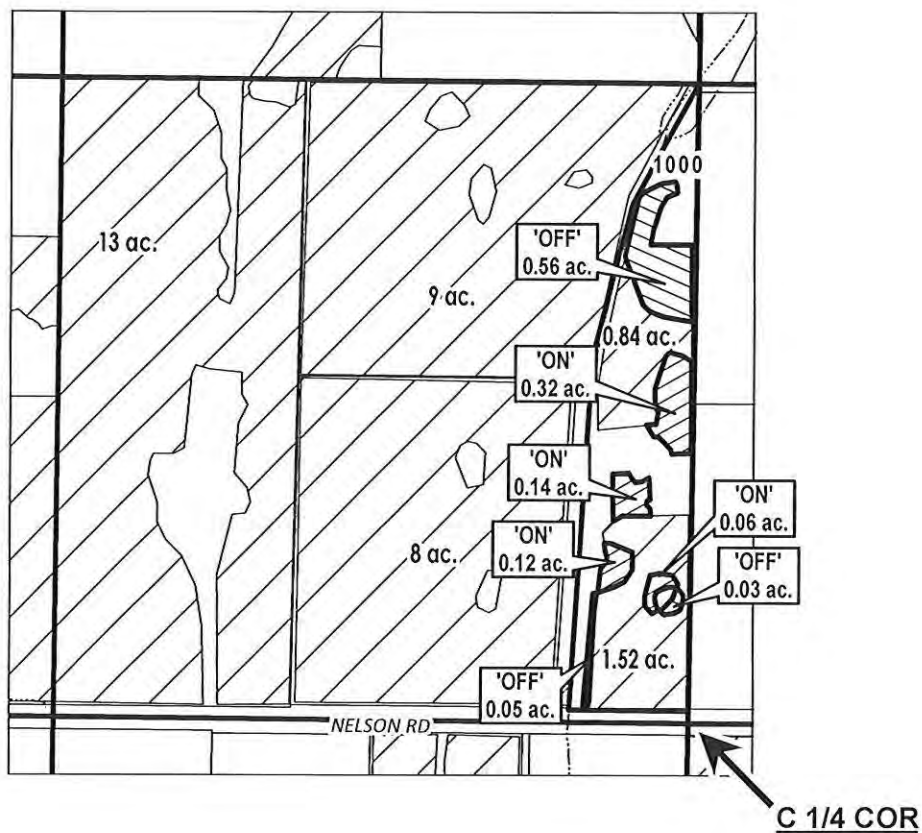

	'ON' LANDS
	OFF LANDS
	EXISTING WATER RIGHTS

"OFF/ON" MAP



APPLICATION FOR WATER RIGHTS TRANSFER

NAME: Christopher D and Kit A. Larsen

TAXLOT #: 1000

0.64 ACRES 13514

Date: 05/05/2020

DESCHUTES COUNTY SEC.30 T17S R13E

RECEIVED

AUG 24 2020


OWRD

SCALE - 1" = 400'



NE 1/4 OF THE NW 1/4

DISTRICT INTERNAL
NOTICE #: T-2020-001

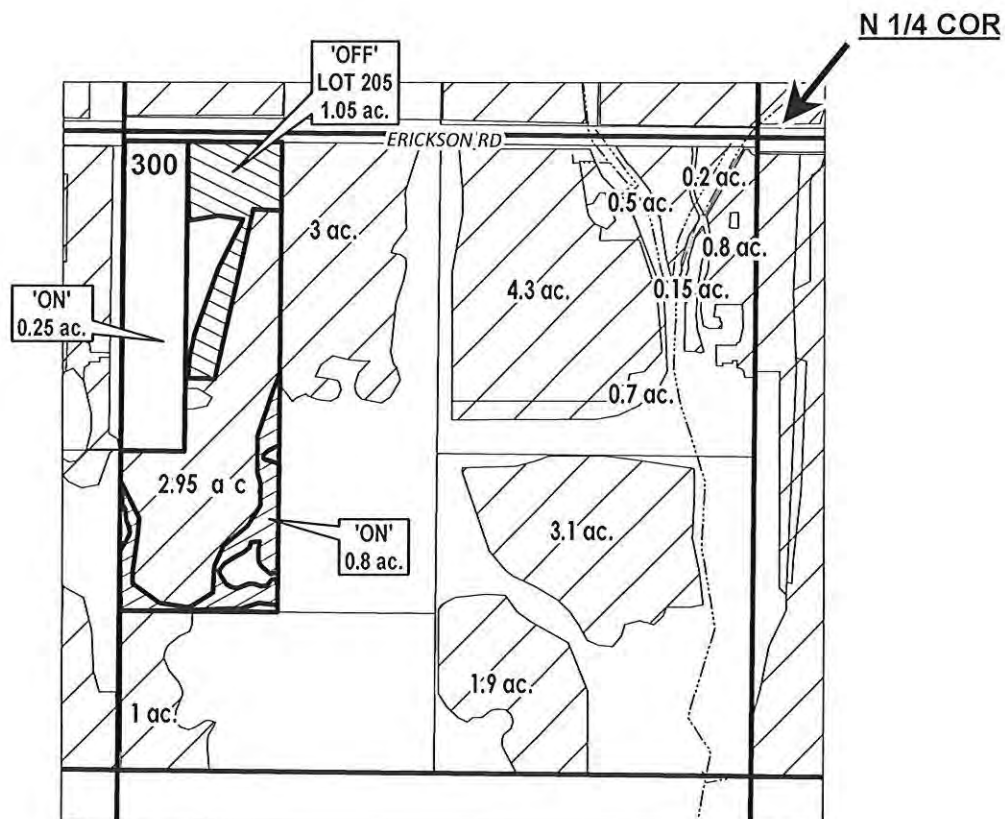

"OFF/ON" MAP

# ac.	'ON' LAND PARCELS
	EXISTING WATER RIGHTS
	OFF LANDS
	ON LANDS



APPLICATION FOR WATER RIGHTS TRANSFER

KURT M. AND JENNIFER J. BOMKE

TAXLOT #: 205, 300

1.05 ACRES 13514

Date: 03/04/2020

DESCHUTES COUNTY SEC.13 T17S R14E

RECEIVED

AUG 24 2020


OWRD

SCALE - 1" = 400'



SW 1/4 OF THE SE 1/4

DISTRICT INTERNAL
NOTICE #: T-2020-012

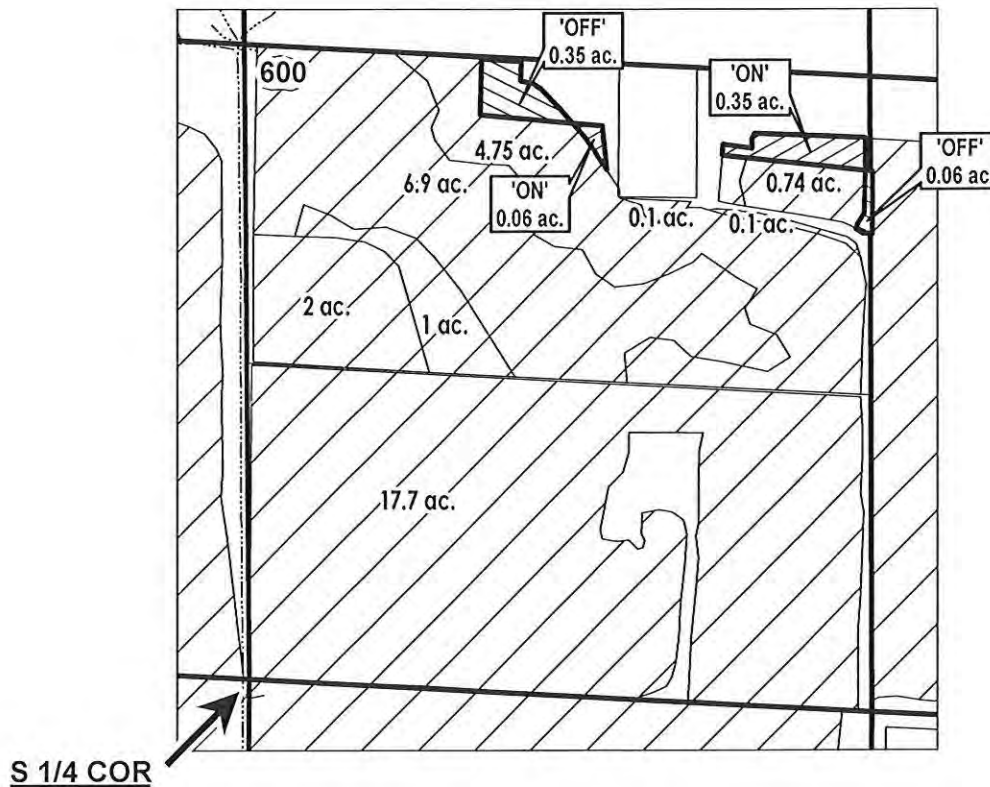

"OFF/ON" MAP



APPLICATION FOR WATER RIGHTS TRANSFER

Robert E. Jr. and Erynne E. Fore

TAXLOT #: 600

0.41 ACRES **13514**

Date: 03/17/2020

DESCHUTES COUNTY
SEC.23 T17S R14E

RECEIVED

AUG 24 2020


OWRD

SCALE - 1" = 400'



SE 1/4 OF THE NW 1/4; NE 1/4 OF THE SW 1/4

DISTRICT INTERNAL
NOTICE #: T-2020-009

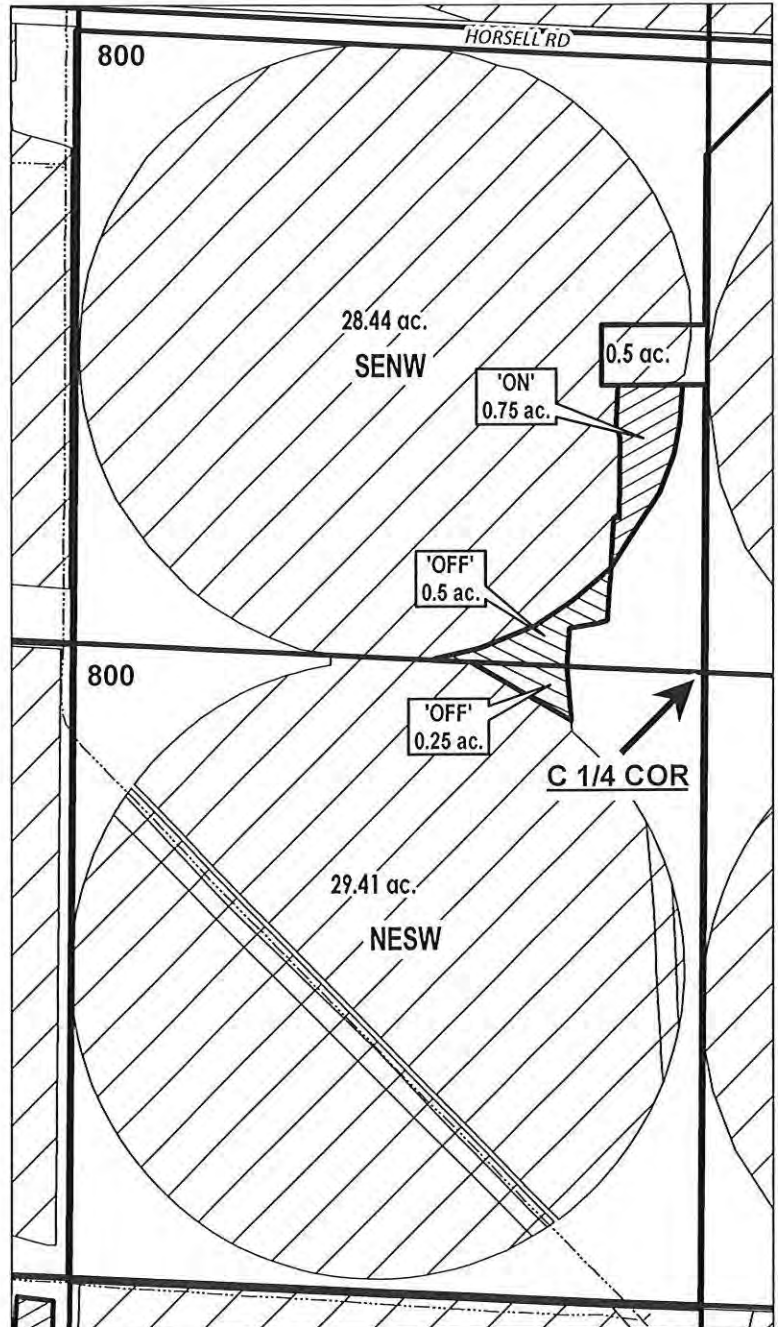

"OFF/ON" MAP

- EXISTING WATER RIGHTS
- OFF LANDS
- ON LANDS



APPLICATION FOR WATER RIGHTS TRANSFER

Keith Middleton

TAXLOT #: 800

0.75 ACRES 13514

Date: 03/17/2020

DESCHUTES COUNTY
SEC.27 T17S R14E

SCALE - 1" = 400'




RECEIVED
AUG 24 2020
OWRD


NW 1/4 OF THE SW 1/4; NE 1/4 OF THE SW 1/4

DISTRICT INTERNAL
NOTICE #: T-2020-014

W 1/4 COR

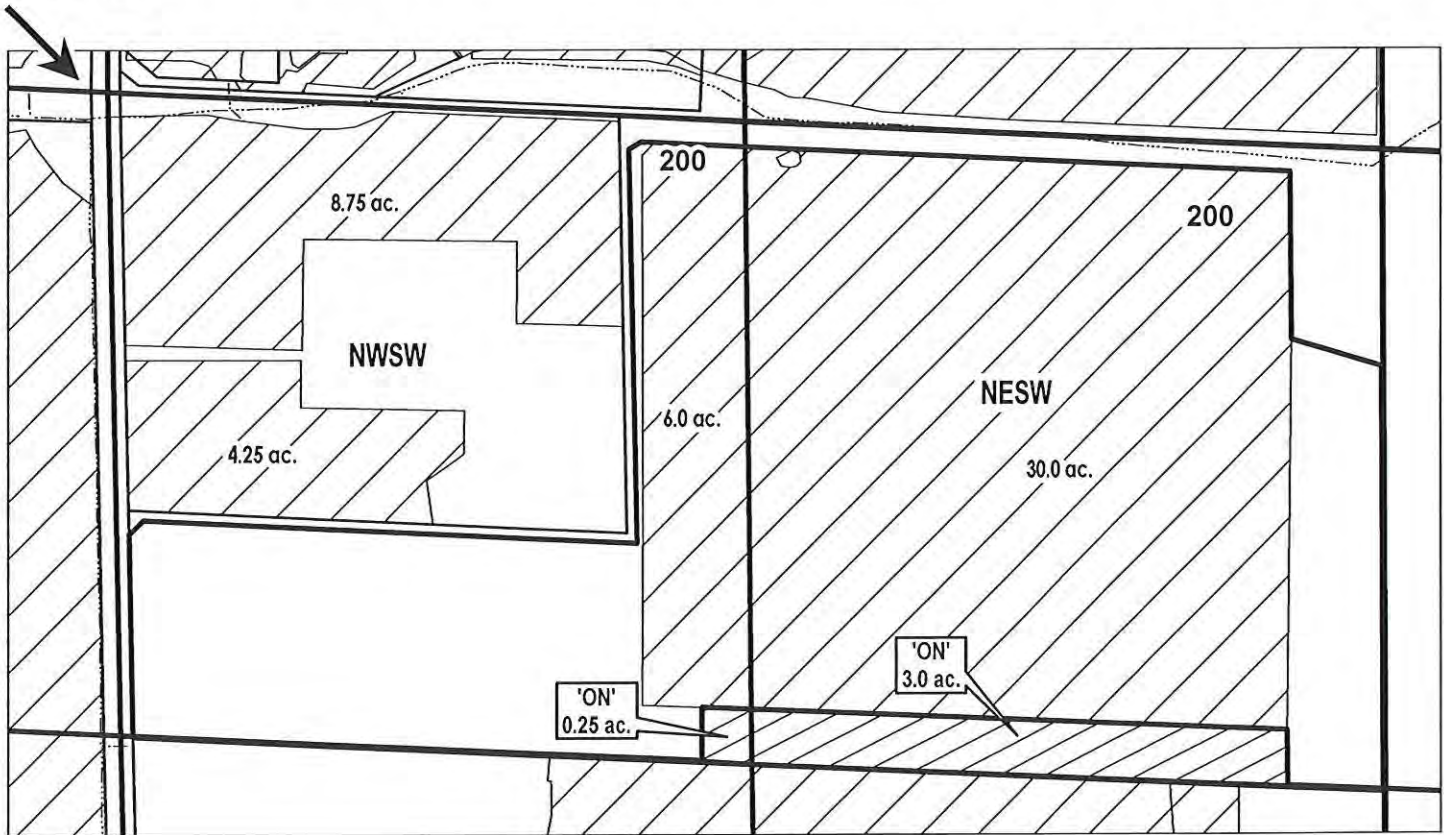

"ON" MAP

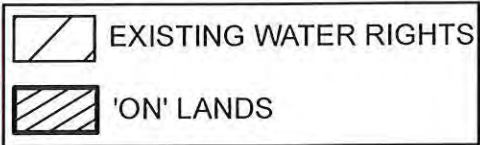

APPLICATION FOR WATER RIGHTS TRANSFER

NAME: Mulcahy, Richard & Denise

TAXLOT #: 200

3.25 ACRES

13514

DATE: 03/26/2020

DESCHUTES COUNTY
SEC.28 T17S R14E

SCALE - 1" = 400'




RECEIVED

AUG 24 2020

OWRD

NW 1/4 OF THE NE 1/4; SW 1/4 OF THE NE 1/4

DISTRICT INTERNAL
NOTICE #: T-2020-016

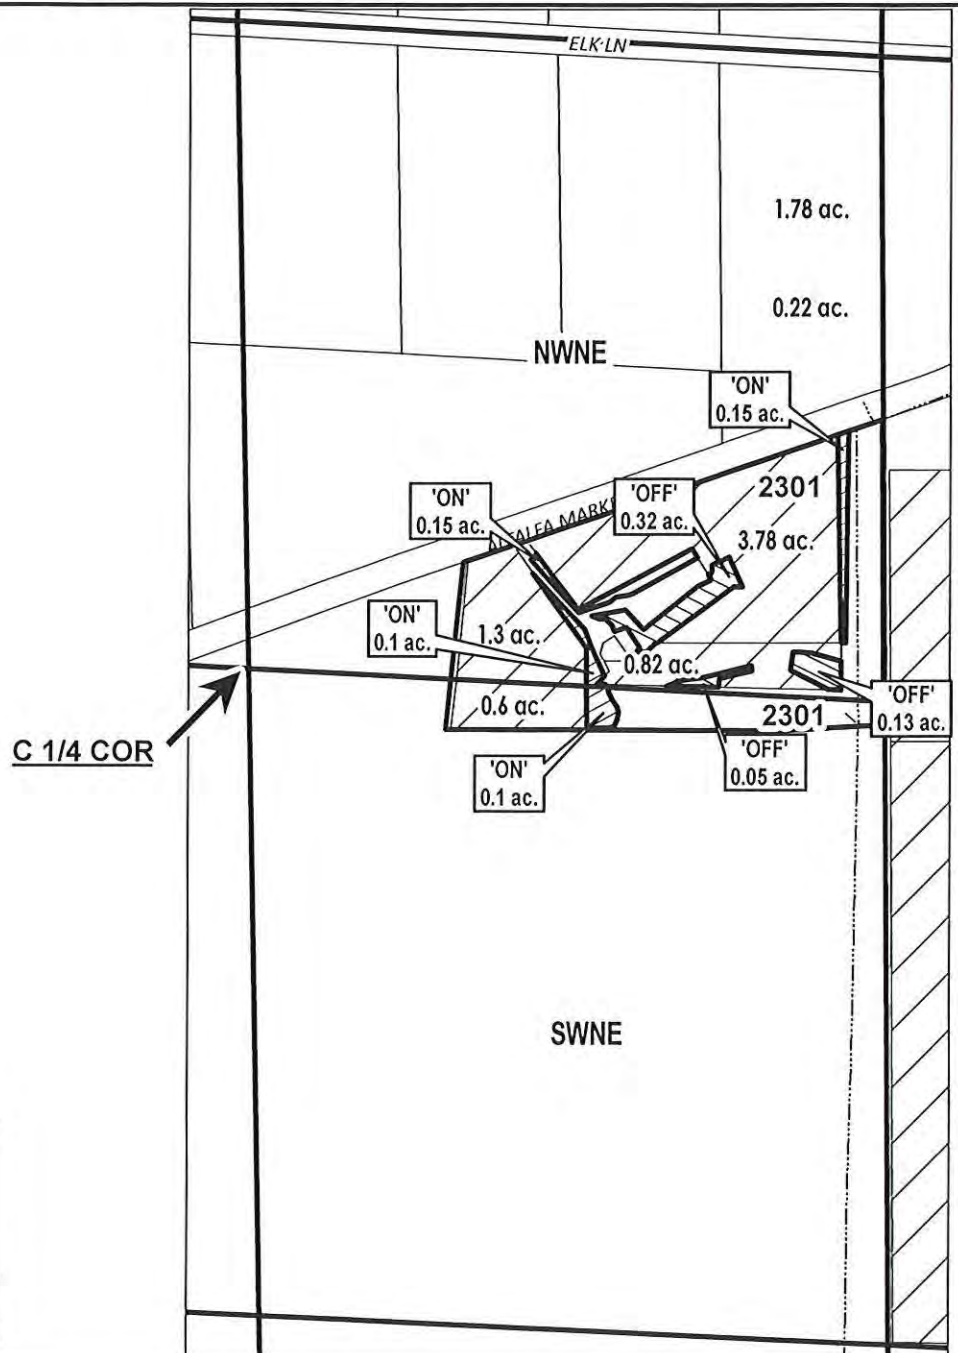

"OFF/ON" MAP

	'ON' LANDS
	OFF LANDS
	# ac. PARCELS W/ WATER RIGHTS
	EXISTING WATER RIGHTS



APPLICATION FOR WATER RIGHTS TRANSFER

NAME: CURT G. JENO

TAXLOT #: 2301

0.5 ACRES 13514

Date: 04/15/2020

DESCHUTES COUNTY
SEC.02 T18S R13E

RECEIVED

AUG 24 2020


SCALE - 1" = 400'

OWRD



SW 1/4 OF THE SE 1/4; SE 1/4 OF THE SE 1/4

DISTRICT INTERNAL
NOTICE #: T-2020-010

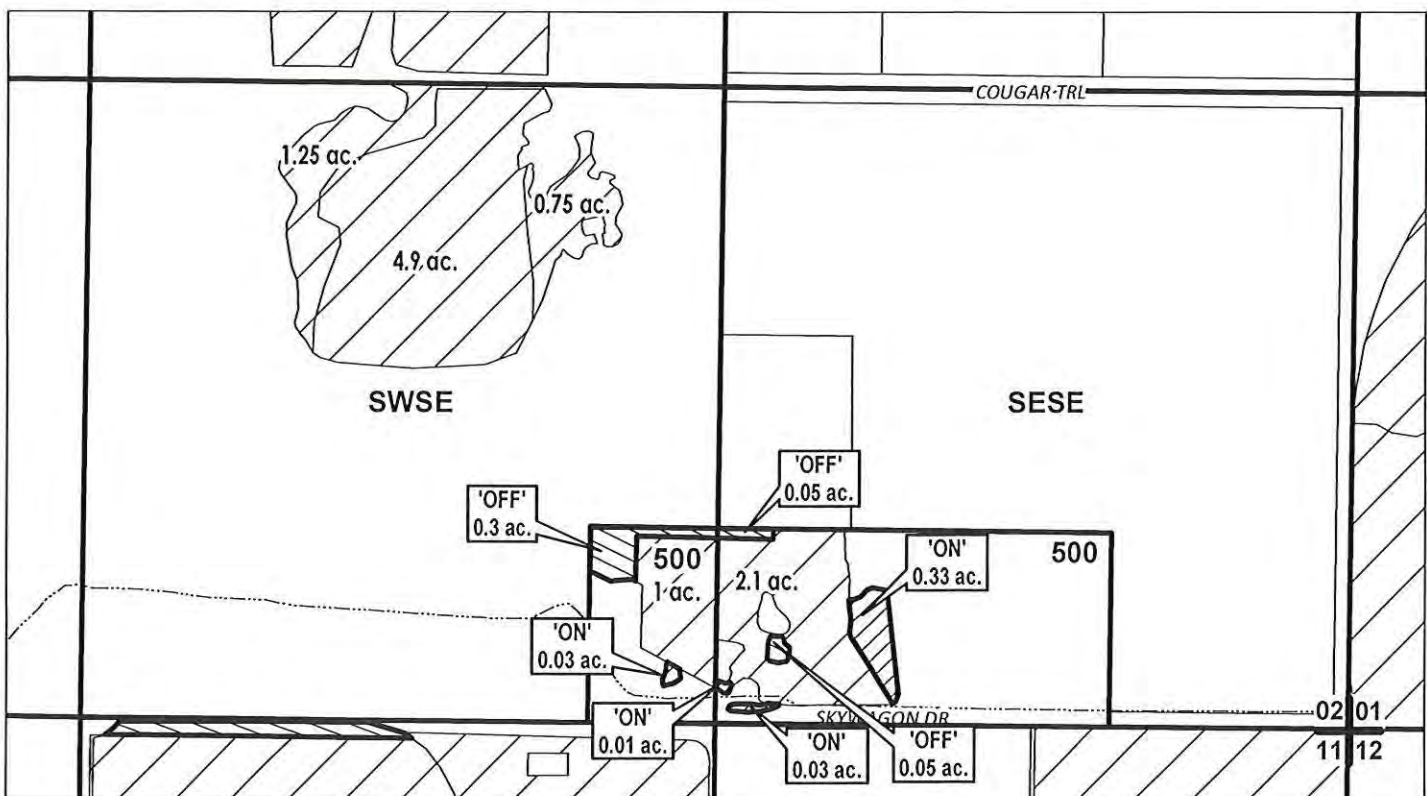

"OFF/ON" MAP

	EXISTING WATER RIGHTS
	ON LANDS
	OFF LANDS



APPLICATION FOR WATER RIGHTS TRANSFER

NAME: Benjamin C. Scott and Rebecca Rose O'Connell

TAXLOT #: 500

0.4 ACRES **13514**

Date: 6/3/2020

DESCHUTES COUNTY SEC.04 T18S R13E

SCALE - 1" = 400'




SW 1/4 OF THE NE 1/4

RECEIVED

AUG 24 2020

OWRD

DISTRICT INTERNAL
NOTICE #: T-2020-006

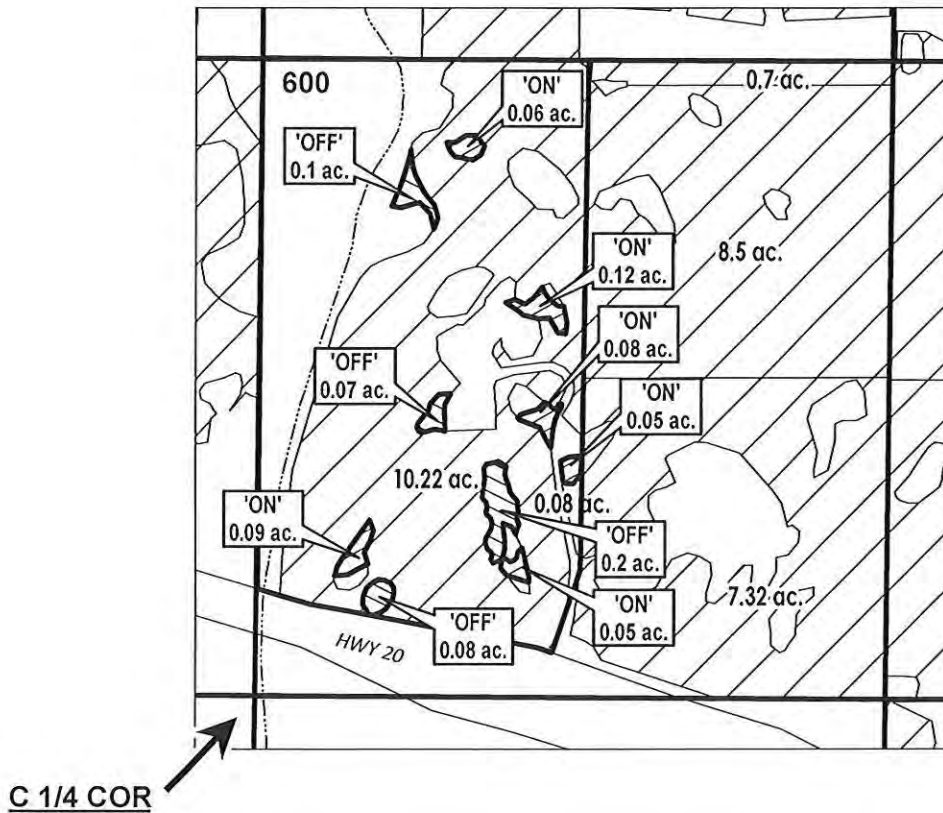

"OFF/ON" MAP



APPLICATION FOR WATER RIGHTS TRANSFER

Jacob Ralston and Dayna Ward Ralston

TAXLOT #: 600

0.45 ACRES 18514

Date: 04/24/2020

DESCHUTES COUNTY SEC.15 T14S R13E

SCALE - 1" = 400'




SW 1/4 OF THE NW 1/4

RECEIVED

AUG 24 2020

OWRD

DISTRICT INTERNAL
NOTICE #: T-2020-003

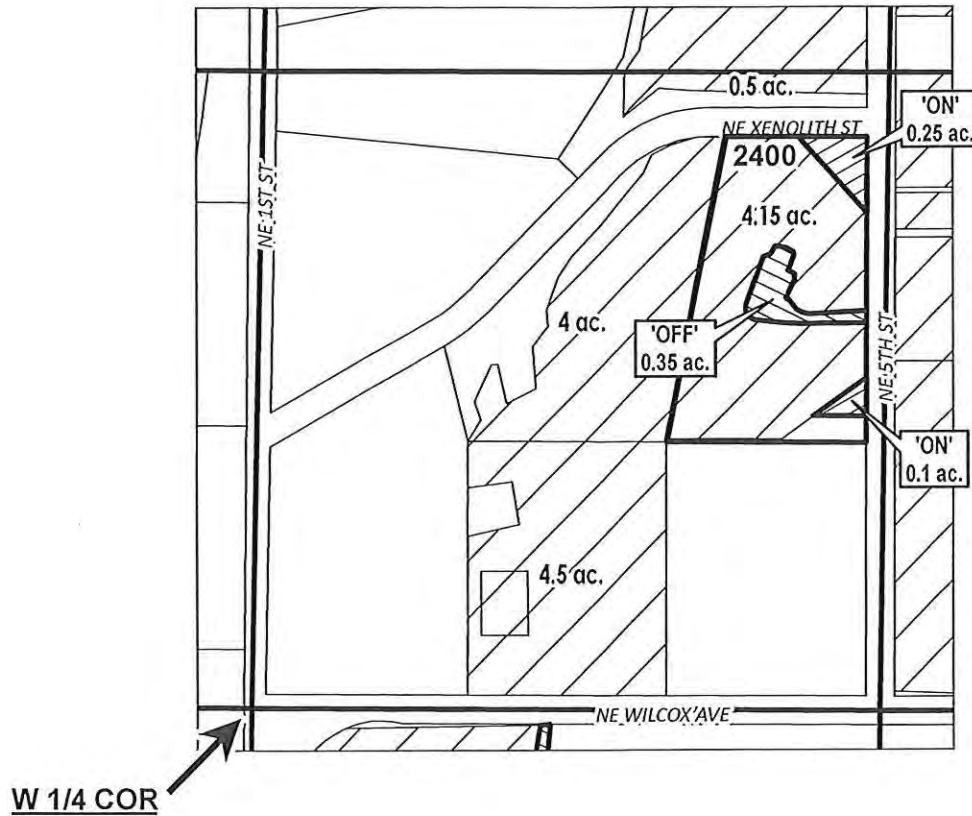

"OFF/ON" MAP

	EXISTING WATER RIGHTS
	OFF LANDS
	ON LANDS



APPLICATION FOR WATER RIGHTS TRANSFER

SHARON L. BOYNTON

TAXLOT #: 2400

0.35 ACRES

13514

Date: 03/06/2020

DESCHUTES COUNTY
SEC.15 T14S R13E

SCALE - 1" = 400'




SW 1/4 OF THE NW 1/4

RECEIVED


AUG 24 2020

OWRD

DISTRICT INTERNAL
NOTICE #: T-2020-018

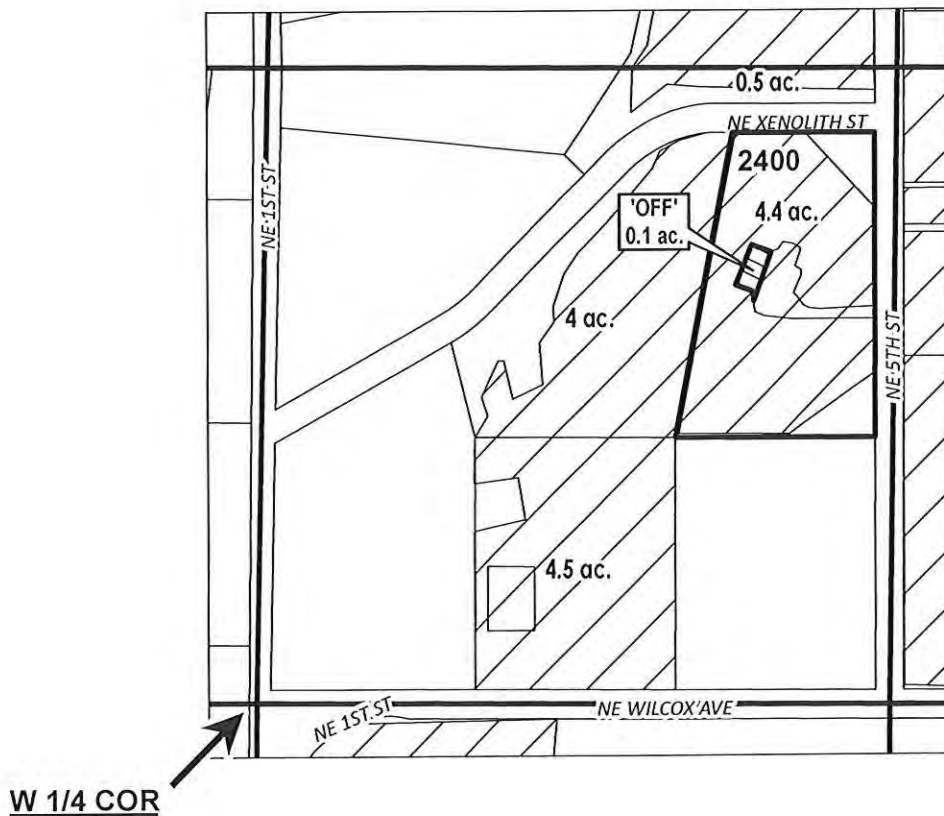

"OFF" MAP

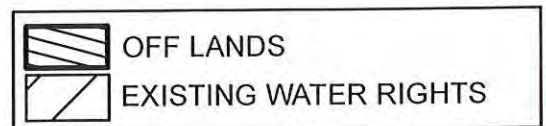

APPLICATION FOR WATER RIGHTS TRANSFER

NAME: Sharon L. Boynton

TAXLOT #: 2400

13514
0.1 ACRES

Date: 6/22/2020

DESCHUTES COUNTY SEC.16 T14S R13E

SCALE - 1" = 400'




SW 1/4 OF THE NE 1/4

RECEIVED

AUG 24 2020

OWRD

DISTRICT INTERNAL
NOTICE #: T-2020-018

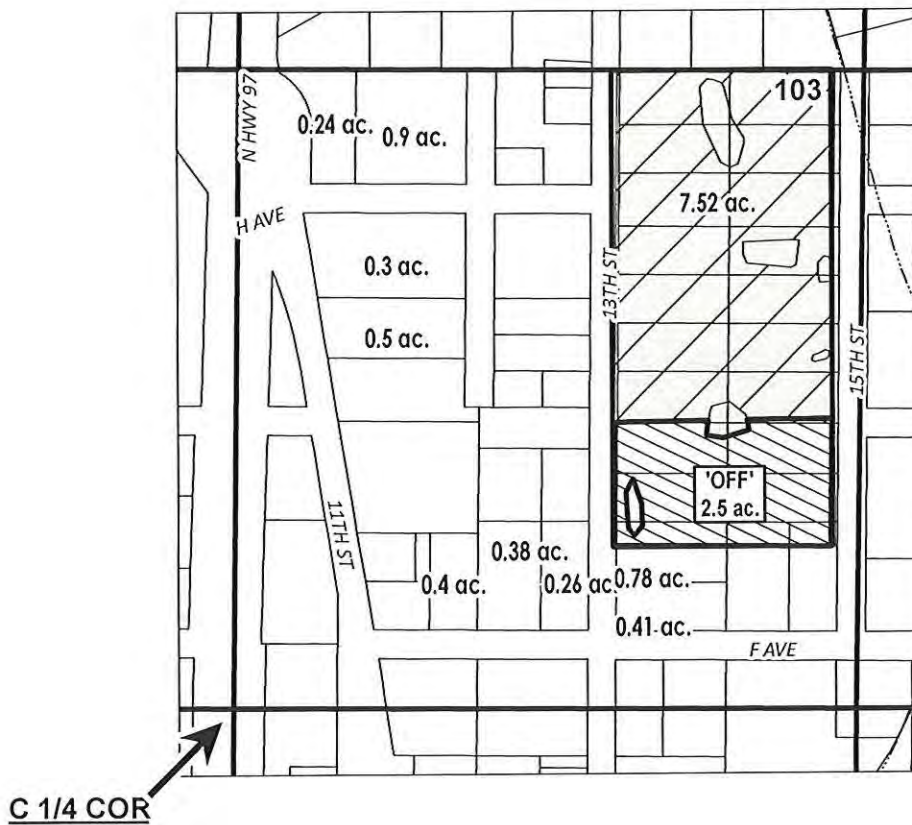

"OFF" MAP

# ac.	PARCELS W/ WATER RIGHTS
	OFF LANDS
	EXISTING WATER RIGHTS



APPLICATION FOR WATER RIGHTS TRANSFER

NAME: COID QUITCLAIM

TAXLOT #: 103

2.5 ACRES 13514

Date: 6/22/2020

DESCHUTES COUNTY SEC.22 T14S R13E

SCALE - 1" = 400'




NE 1/4 OF THE SE 1/4

RECEIVED

AUG 24 2020

OWRD

DISTRICT INTERNAL
NOTICE #: T-2020-007

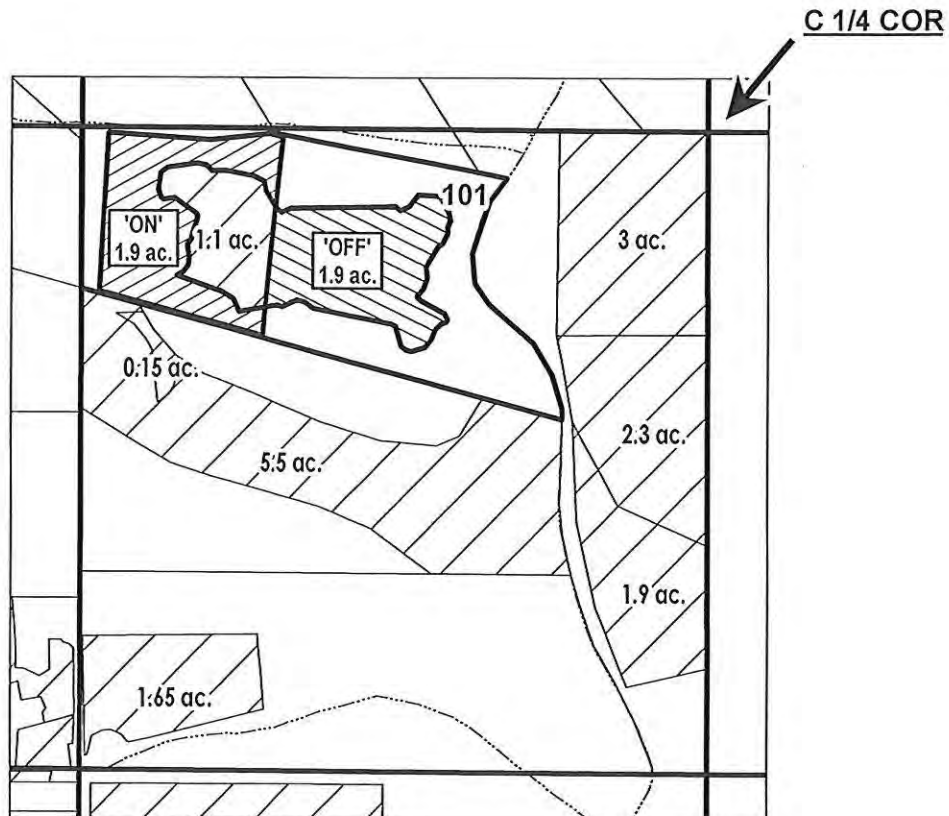

"OFF/ON" MAP

	EXISTING WATER RIGHTS
	OFF LANDS
	ON LANDS



APPLICATION FOR WATER RIGHTS TRANSFER

VICTORIA LEE DAVIS AND HARRY COOPER DAVIS

TAXLOT #: 101

1.9 ACRES

13514

Date: 02/27/2020

FILE: I:\TRANSFER\WRTRANS17\CONFISCATION\141311_NESE

DESCHUTES COUNTY SEC.27 T14 R13E

SCALE - 1" = 400'



NW 1/4 OF THE SW 1/4


RECEIVED

AUG 24 2020


OWRD

DISTRICT INTERNAL
NOTICE #: T-2020-022

W 1/4 COR

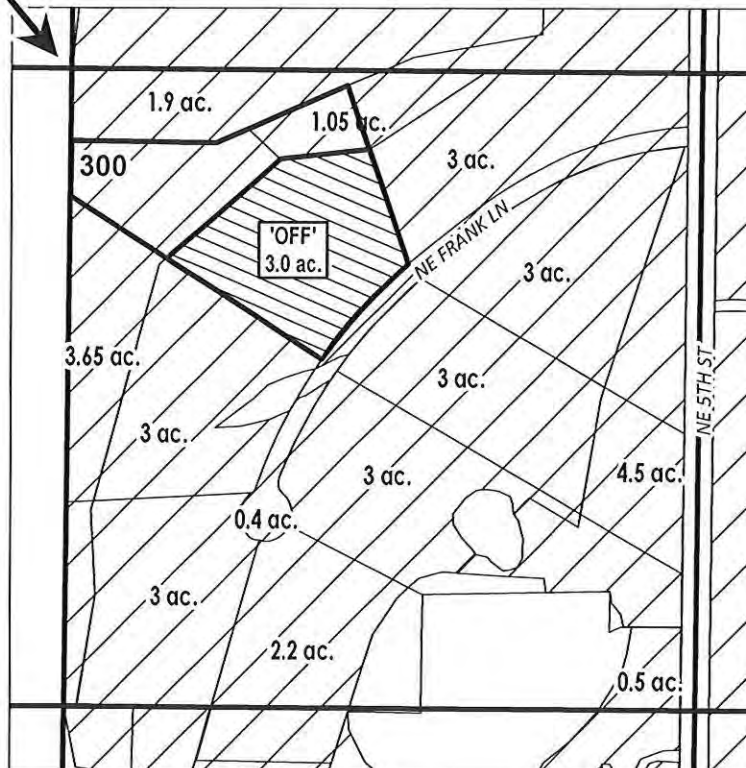

"OFF" MAP

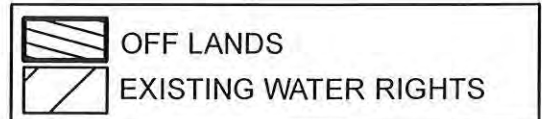

APPLICATION FOR WATER RIGHTS TRANSFER

NAME: RYAN C. JENNINGS

TAXLOT #: 300

3.0 ACRES 139 14

Date: 7/6/2020

DESCHUTES COUNTY SEC.27 T14S R13E

SCALE - 1" = 400'




SW 1/4 OF THE SW 1/4

RECEIVED

AUG 24 2020

OWRD

DISTRICT INTERNAL
NOTICE #: T-2020-011

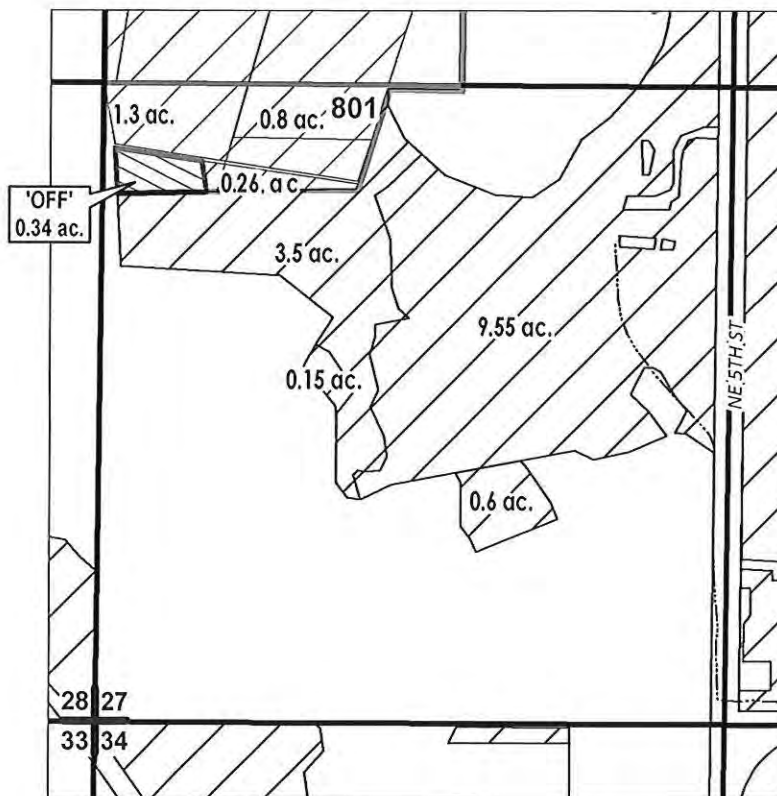

"OFF" MAP

	EXISTING WATER RIGHTS
	OFF LANDS



APPLICATION FOR WATER RIGHTS TRANSFER

COID QUITCLAIM

TAXLOT #: 801

0.34 ACRES
13514

Date: 03/31/2020

DESCHUTES COUNTY
SEC.27 T14S R13E

RECEIVED

AUG 24 2020


OWRD

SCALE - 1" = 400'




SW 1/4 OF THE SW 1/4

DISTRICT INTERNAL
NOTICE #: T-2020-013

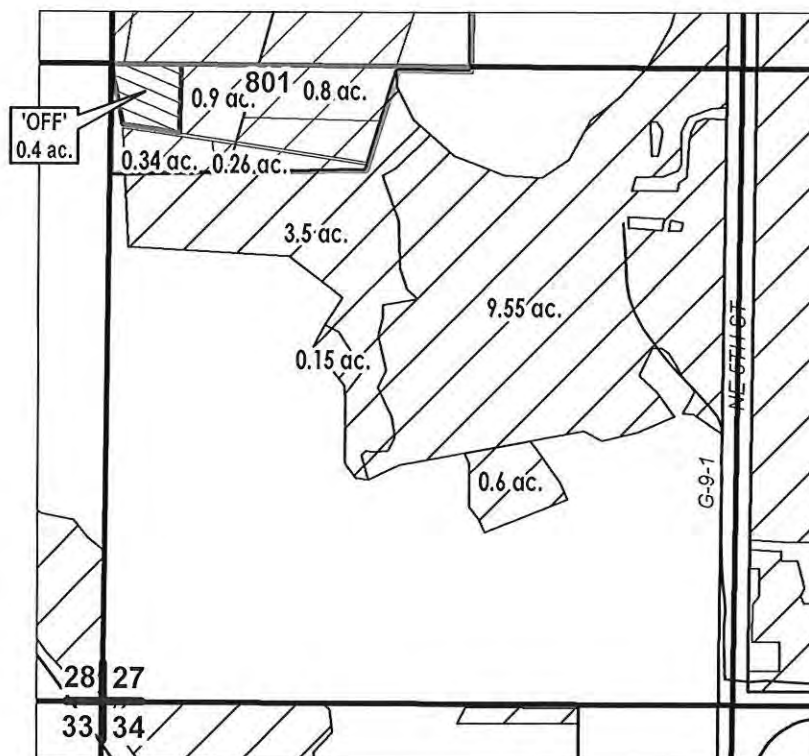

'OFF' MAP

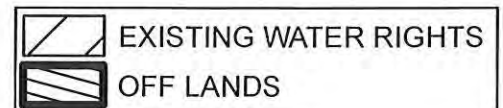

APPLICATION FOR WATER RIGHTS TRANSFER

NAME: COID QUITCLAIM

TAXLOT #: 801

0.4 ACRES
13514

Date: 04/28/2020

DESCHUTES COUNTY SEC.33 T14S R13E

SCALE - 1" = 400'




SW 1/4 OF THE SW 1/4

RECEIVED


AUG 24 2020

OWRD

DISTRICT INTERNAL
NOTICE #: T-2020-018

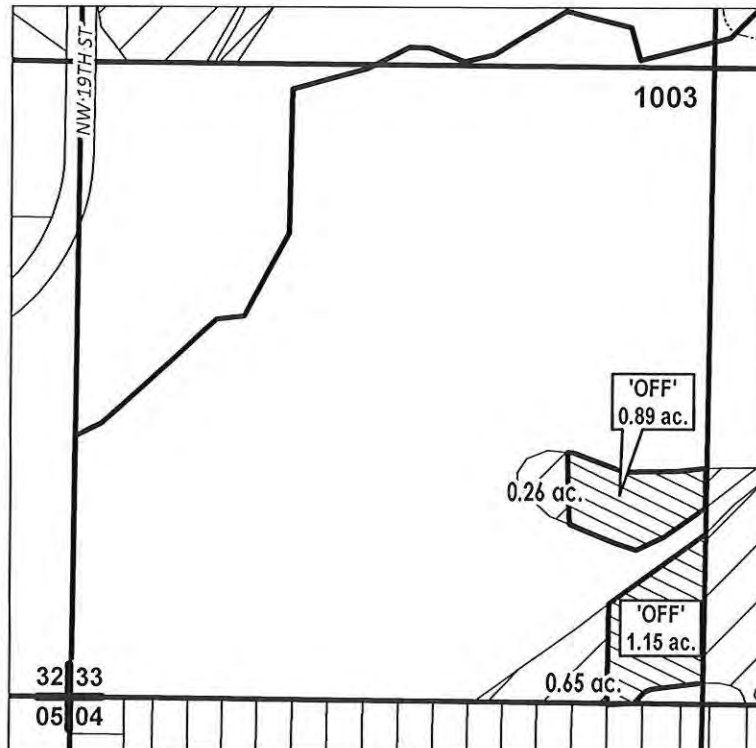

"OFF" MAP

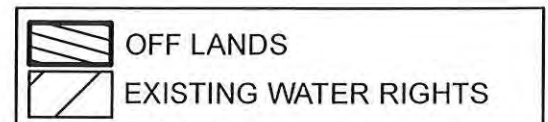

APPLICATION FOR WATER RIGHTS TRANSFER

NAME: COID QUITCLAIM

TAXLOT #: 1003

2.04 ACRES
19514

Date: 6/22/2020

CROOK COUNTY
SEC.19 T14S R14E

SCALE - 1" = 400'




NE 1/4 OF THE NW 1/4

RECEIVED

AUG 24 2020

OWRD

DISTRICT INTERNAL
NOTICE #: T-2020-002

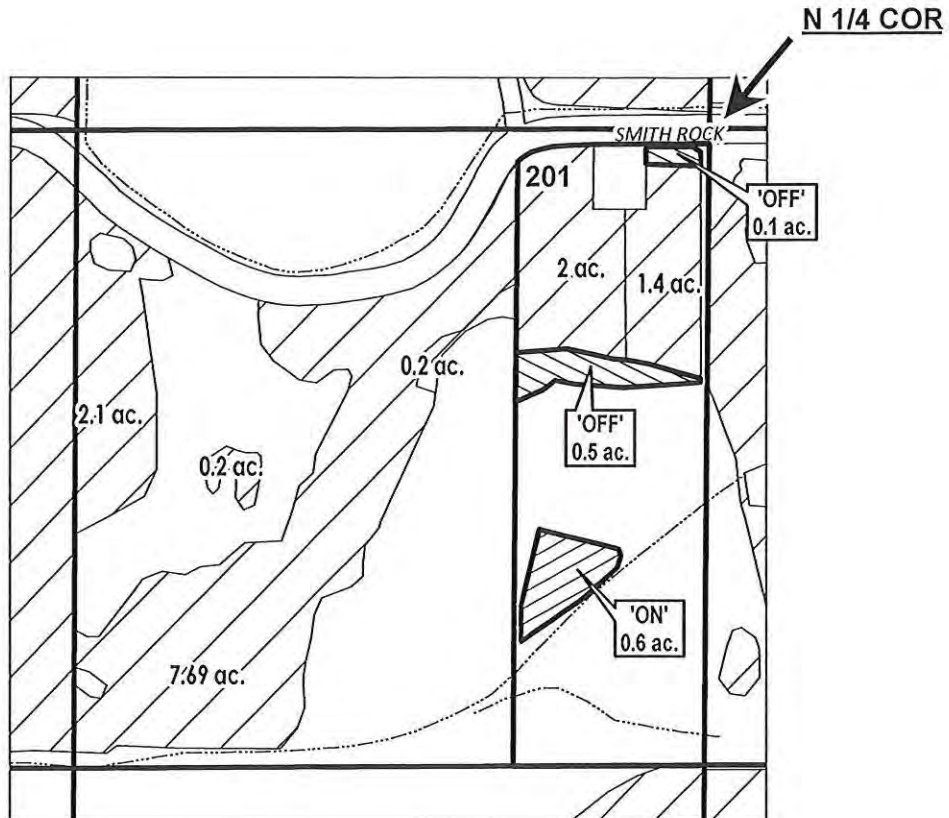

"OFF/ON" MAP

	EXISTING WATER RIGHTS
	OFF LANDS
	ON LANDS



APPLICATION FOR WATER RIGHTS TRANSFER

CARL E. AND CYNTHIA M. HEMPHILL

TAXLOT #: 201

0.6 ACRES

13514

Date: 02/17/2020

FILE: I:\TRANSFER\WRTRANS17\CONFISCATION\141311_NESE

CROOK COUNTY SEC.19 T14S R14E


RECEIVED

AUG 24 2020

SCALE - 1" = 400'

"OFF/ON" MAP

DISTRICT INTERNAL
NOTICE #: T-2020-018

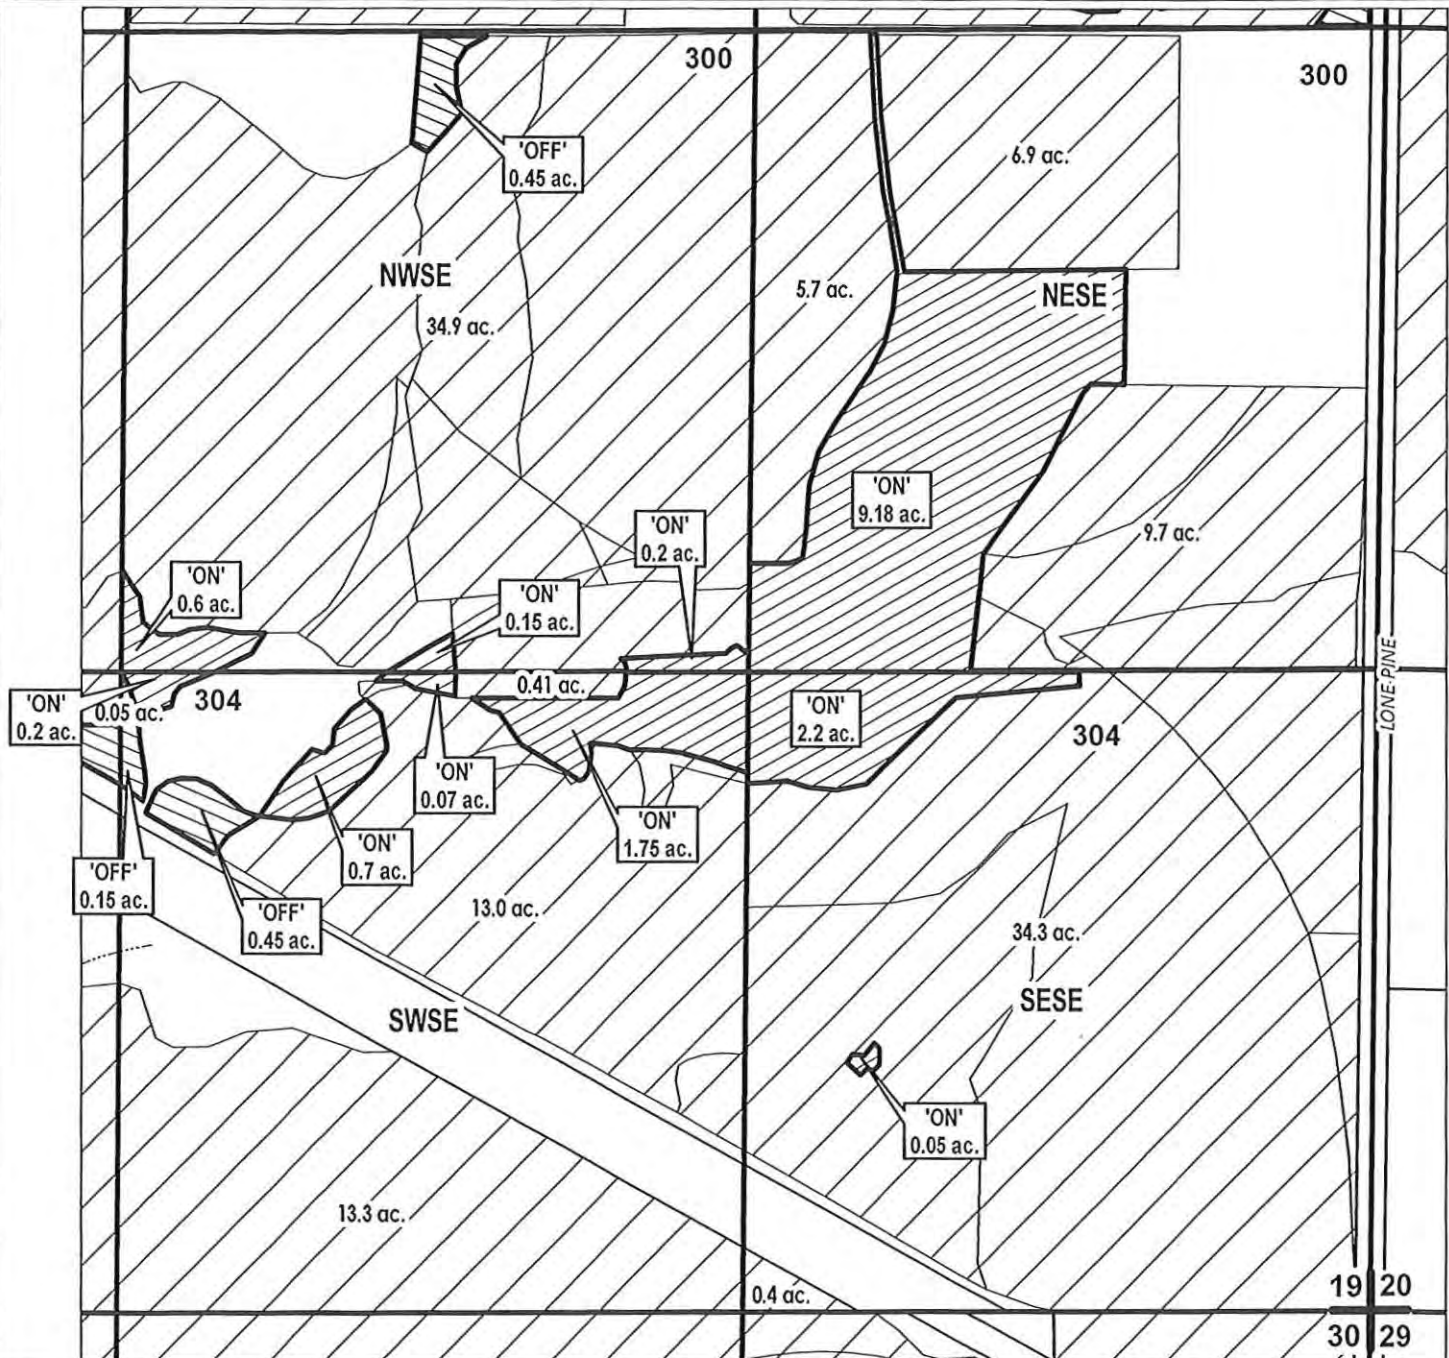

APPLICATION FOR TEMPORARY WATER RIGHTS TRANSFER

NAME: KASBERGER RANCH LLC

TAXLOT #: 300, 304

1.05 ACRES OFF
15.1 ACRES ON

DATE: 6/22/2020

13514

CROOK COUNTY SEC.19 T14S R14E

SCALE - 1" = 400'




RECEIVED

AUG 24 2020


SW 1/4 OF THE NW 1/4; SE 1/4 OF THE NW 1/4

OWRD

DISTRICT INTERNAL
NOTICE #: T-2020-018

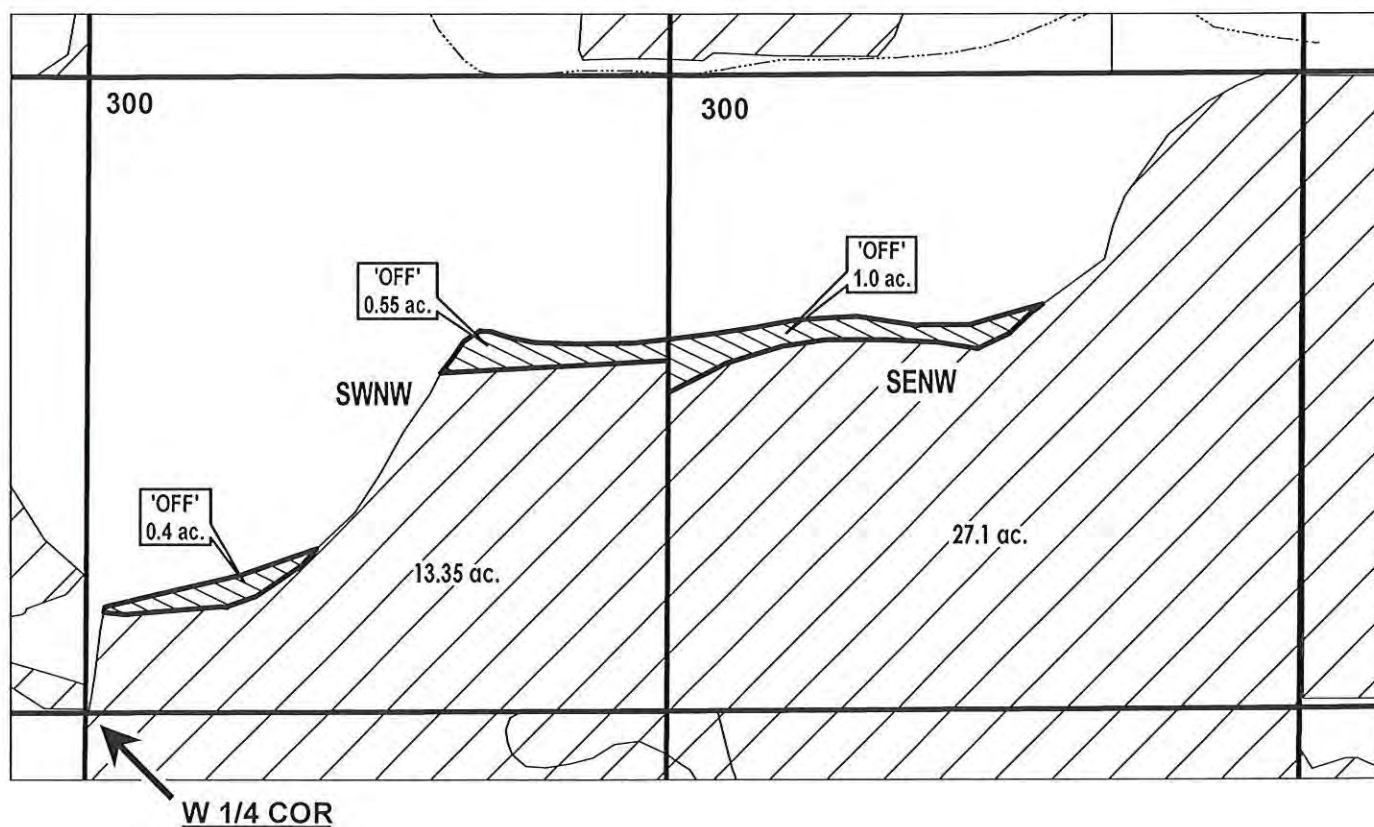

"OFF" MAP

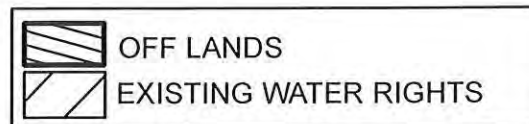

APPLICATION FOR WATER RIGHTS TRANSFER

NAME: KASBERGER RANCH, LLC

TAXLOT #: 300

1.95 ACRES
18514

Date: 6/22/2020

**CROOK COUNTY
SEC.19 T14S R14E**

SCALE - 1" = 400'




SE 1/4 OF THE SW 1/4

RECEIVED


AUG 24 2020

OWRD

DISTRICT INTERNAL
NOTICE #: T-2020-018

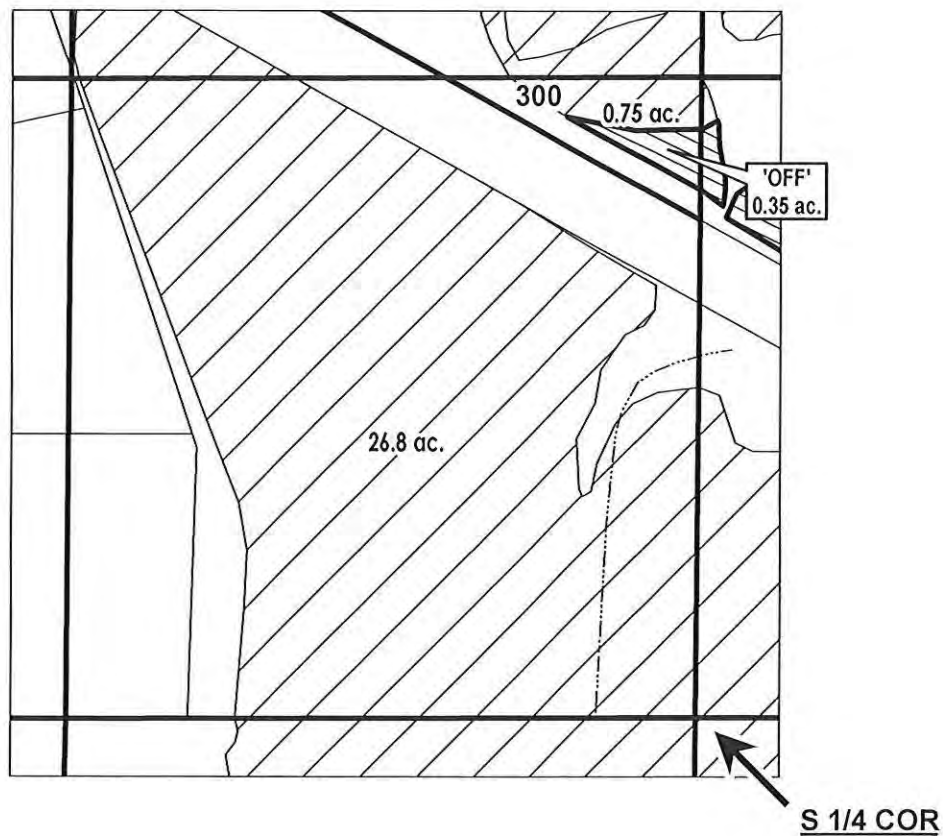

"OFF" MAP

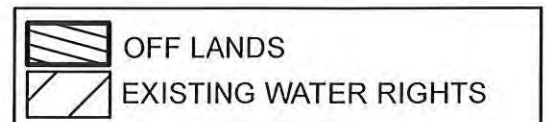

APPLICATION FOR WATER RIGHTS TRANSFER

NAME: KASBERGER RANCH, LLC

TAXLOT #: 300

0.35 ACRES
13514

Date: 6/22/2020

DESCHUTES COUNTY SEC.25 T15S R12E

SCALE - 1" = 400'




NE 1/4 OF THE NE 1/4

RECEIVED

AUG 24 2020

OWRD

DISTRICT INTERNAL
NOTICE #: T-2020-005

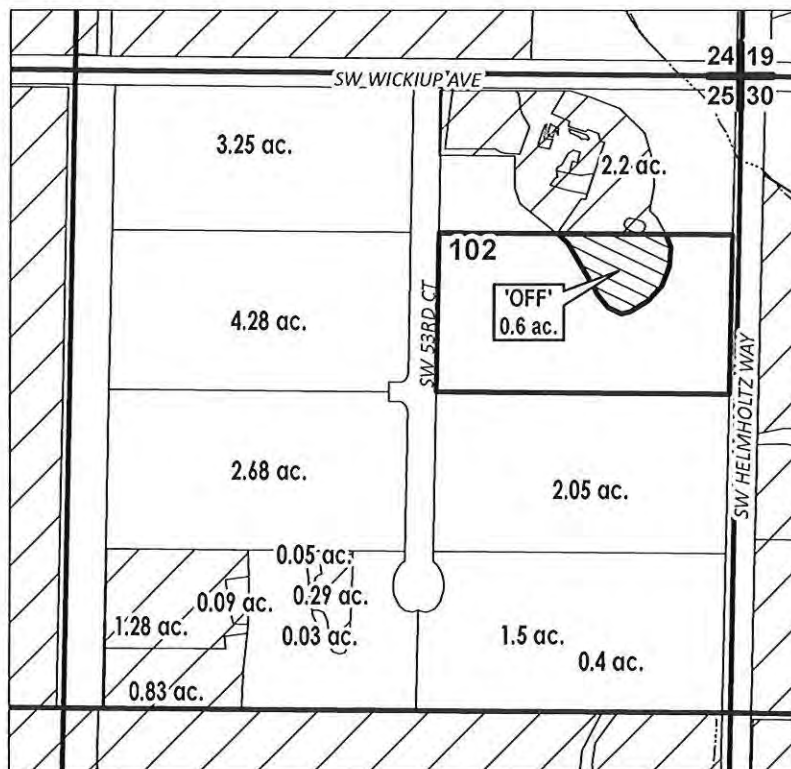

"OFF" MAP

	OFF LANDS
	PARCELS W/ WATER RIGHTS
	EXISTING WATER RIGHTS



APPLICATION FOR WATER RIGHTS TRANSFER

NAME: SIDNEY & MELANIE WIDMER

TAXLOT #: 102

0.6 ACRES **13514**

Date: 6/15/2020

DESCHUTES COUNTY SEC.05 T15S R13E

SCALE - 1" = 400'




SE 1/4 OF THE NE 1/4

RECEIVED


AUG 24 2020

OWRD

DISTRICT INTERNAL
NOTICE #: T-2020-018

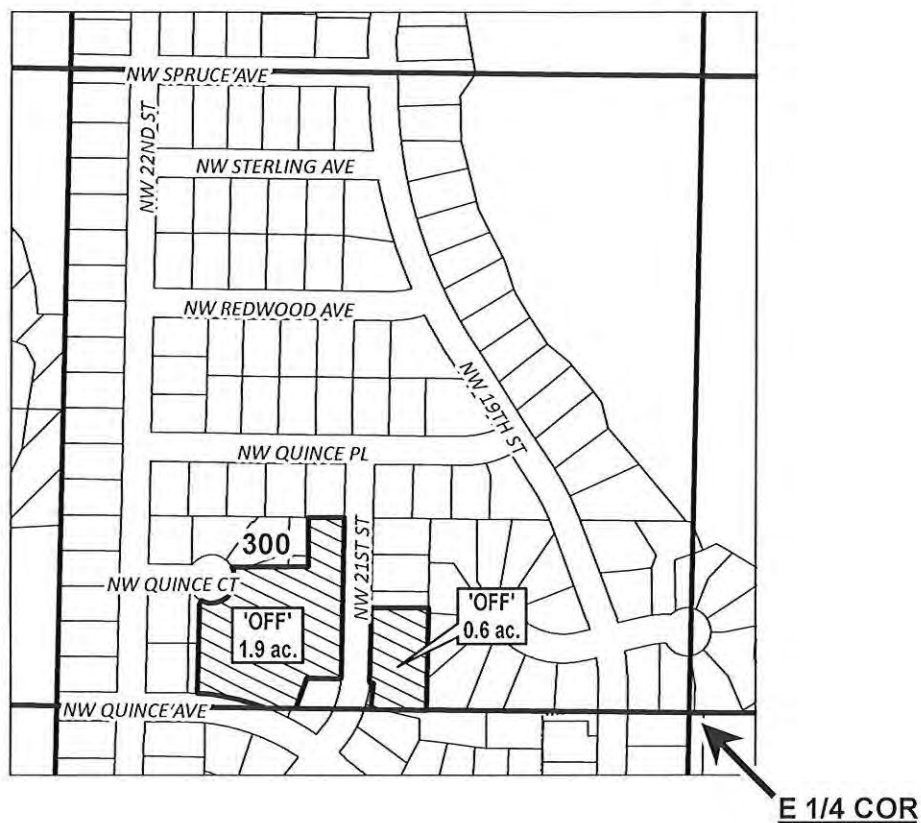

"OFF" MAP

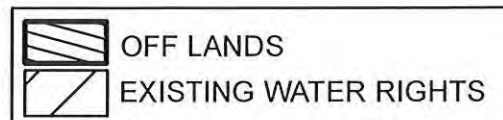

APPLICATION FOR WATER RIGHTS TRANSFER

NAME: COID QUITCLAIM

TAXLOT #: 300

2.5 ACRES

Date: 6/22/2020

DESCHUTES COUNTY SEC.31 T15 R13E

SCALE - 1" = 400'




SE1/4 OF THE NW 1/4

RECEIVED

AUG 24 2020

OWRD

DISTRICT INTERNAL
NOTICE #: T-2020-026

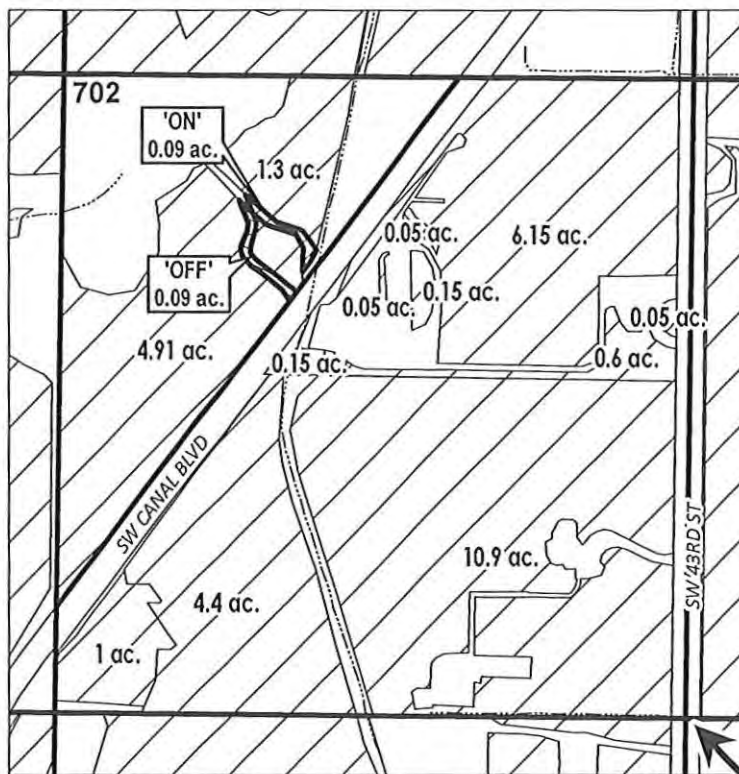

C 1/4 COR

	'ON' LANDS
	OFF LANDS
	EXISTING WATER RIGHTS

"OFF/ON" MAP



APPLICATION FOR WATER RIGHTS TRANSFER

NAME: GEORGE W ENDICOTT AND KRISANNA H. CLARK-ENDICOTT

TAXLOT #: 702

0.09 ACRES

13514

Date: 7/6/2020

DESCHUTES COUNTY
SEC.11 T16S R12E

SCALE - 1" = 400'




NE 1/4 OF THE NW 1/4

RECEIVED

AUG 24 2020

OWRD

DISTRICT INTERNAL
NOTICE #: T-2020-011

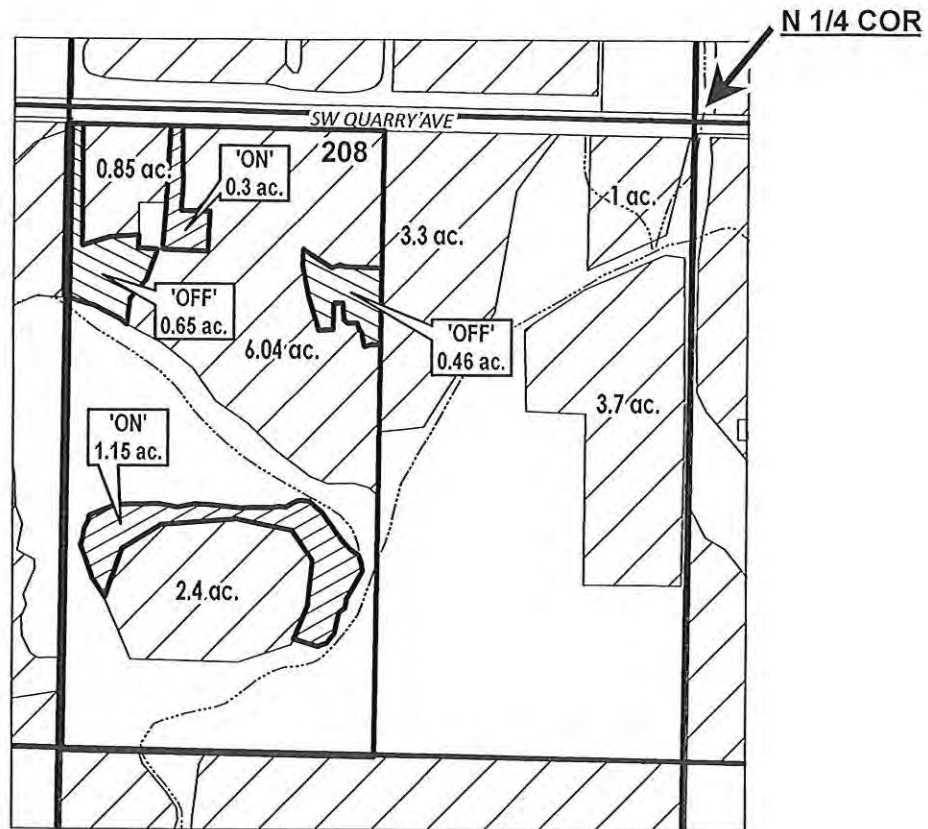

"OFF/ON" MAP

- EXISTING WATER RIGHTS
- OFF LANDS
- ON LANDS



APPLICATION FOR WATER RIGHTS TRANSFER

STACY AND MATTHEW NAHLIK

TAXLOT #: 208

1.11 ACRES 'OFF'
1.45 ACRES 'ON'

Date: 03/31/2020

DESCHUTES COUNTY SEC.23 T16S R12E

SCALE - 1" = 400'




SE 1/4 OF THE SE 1/4

RECEIVED


AUG 24 2020

OWRD

DISTRICT INTERNAL
NOTICE #: T-2020-015

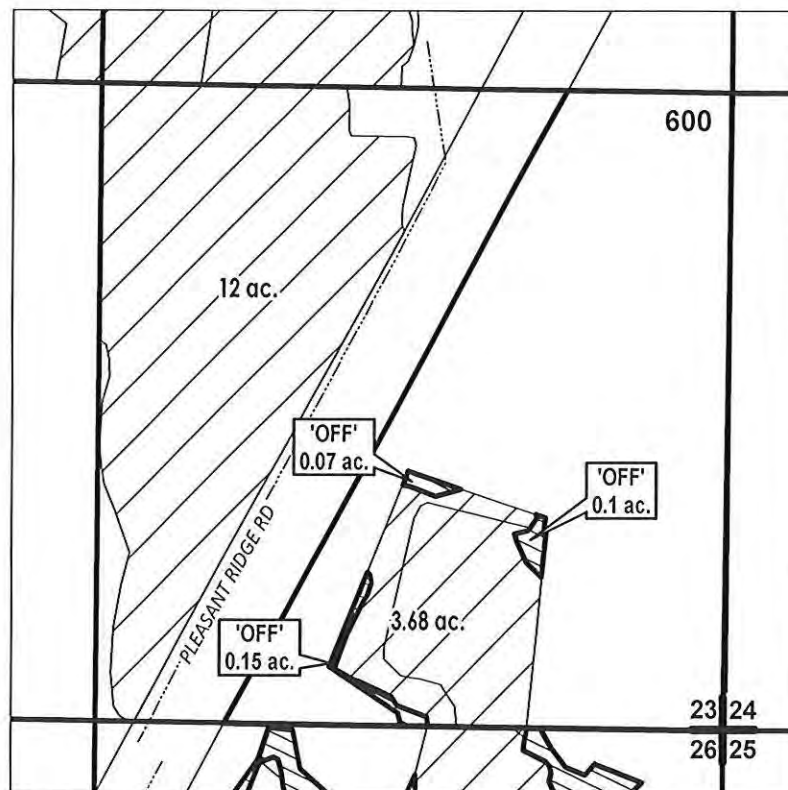

"OFF" MAP

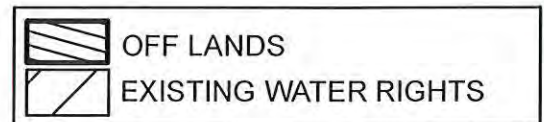

APPLICATION FOR WATER RIGHTS TRANSFER

NAME: LEO D. JUDY PARSONS

TAXLOT #: 600

0.32 ACRES 'OFF'

Date: 04/15/2020

DESCHUTES COUNTY
SEC.26 T16S R12E

RECEIVED

AUG 24 2020


SCALE - 1" = 400'




OWRD

NW 1/4 OF THE NE 1/4; NE 1/4 OF THE NE 1/4

DISTRICT INTERNAL
NOTICE #: T-2020-015

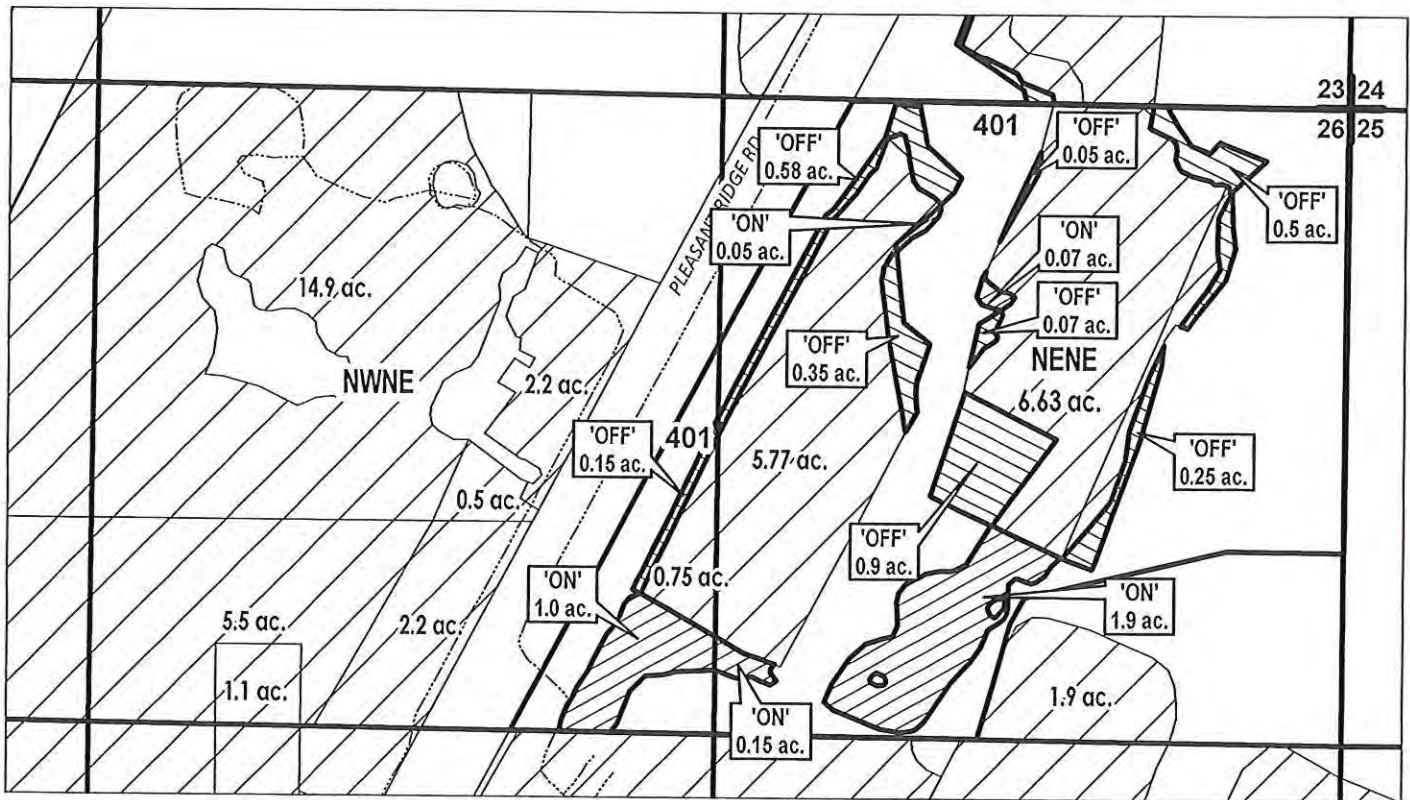

"OFF/ON" MAP

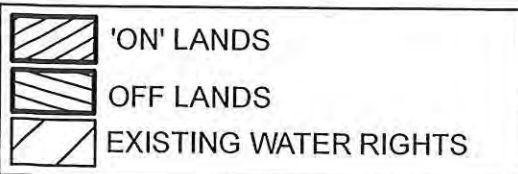

APPLICATION FOR WATER RIGHTS TRANSFER

NAME: LEO D. JUDY PARSONS 13514

TAXLOT #: 401

2.85 ACRES 'OFF'
3.17 ACRES 'ON'

Date: 04/15/2020

DESCHUTES COUNTY SEC.35 T16S R12E

SCALE - 1" = 400'




NW 1/4 OF THE SE 1/4

RECEIVED

AUG 24 2020

OWRD

DISTRICT INTERNAL
NOTICE #: T-2020-008

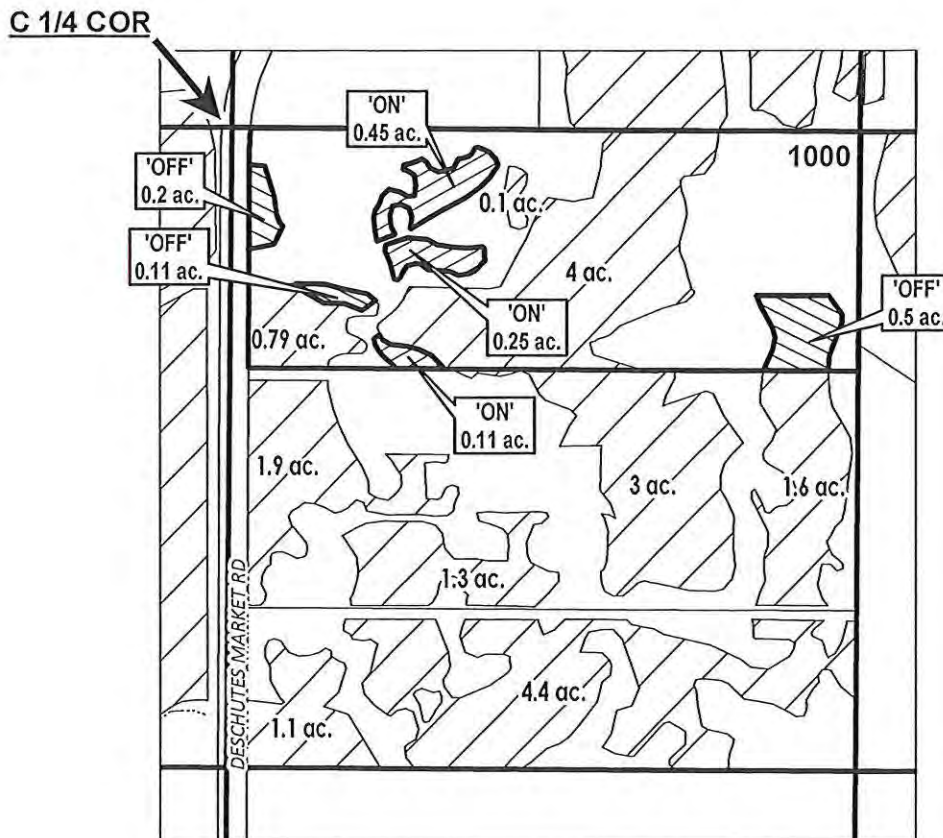

"OFF/ON" MAP

	EXISTING WATER RIGHTS
	OFF LANDS
	ON LANDS



APPLICATION FOR WATER RIGHTS TRANSFER

Matthew and Jessica Shaffer

TAXLOT #: 1000

0.81 ACRES **13514**

Date: 03/31/2020

CROOK COUNTY SEC.04 T16S R14E

SCALE - 1" = 400'




SE 1/4 OF THE SW 1/4

RECEIVED


AUG 24 2020

OWRD

DISTRICT INTERNAL
NOTICE #: T-2020-014

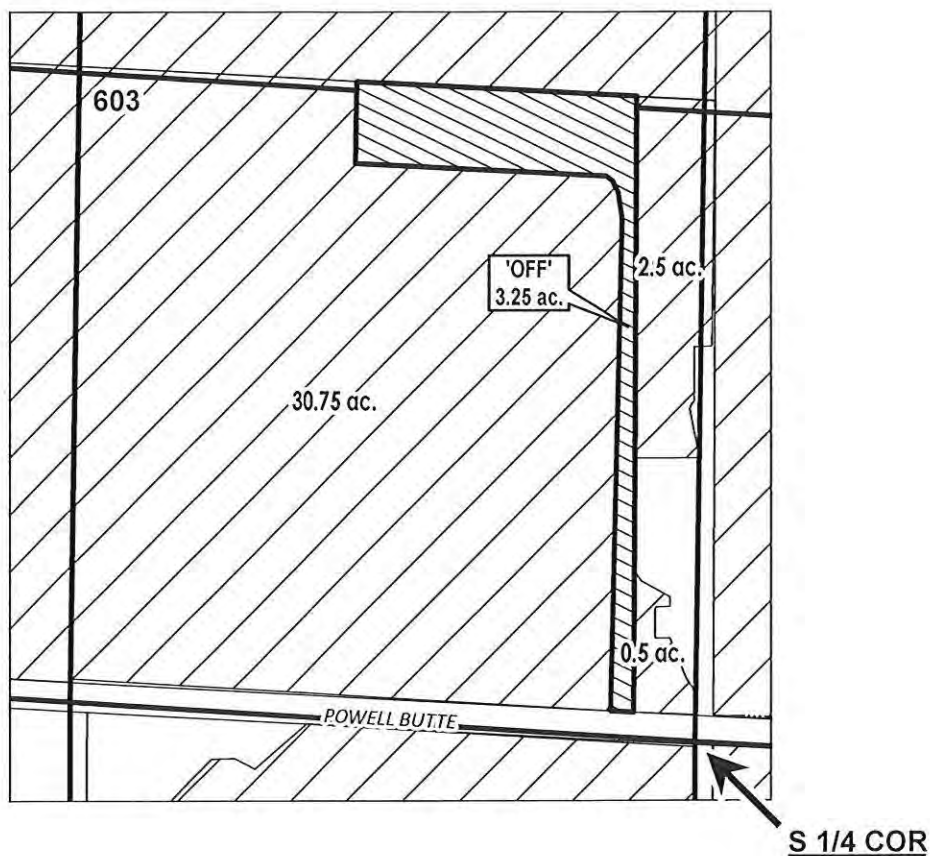

"OFF" MAP

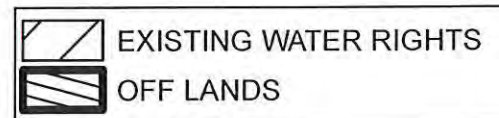

APPLICATION FOR WATER RIGHTS TRANSFER

NAME: JUSTIN A. & HANNAH SOLESBEE **13514**

TAXLOT #: 603

3.25 ACRES

Date: 03/26/2020

DESCHUTES COUNTY SEC.29 T17S R12E

RECEIVED

AUG 24 2020


SCALE - 1" = 400'



OWRD

NE 1/4 OF THE NW 1/4; SE 1/4 OF THE NW 1/4

DISTRICT INTERNAL
NOTICE #: T-2020-019

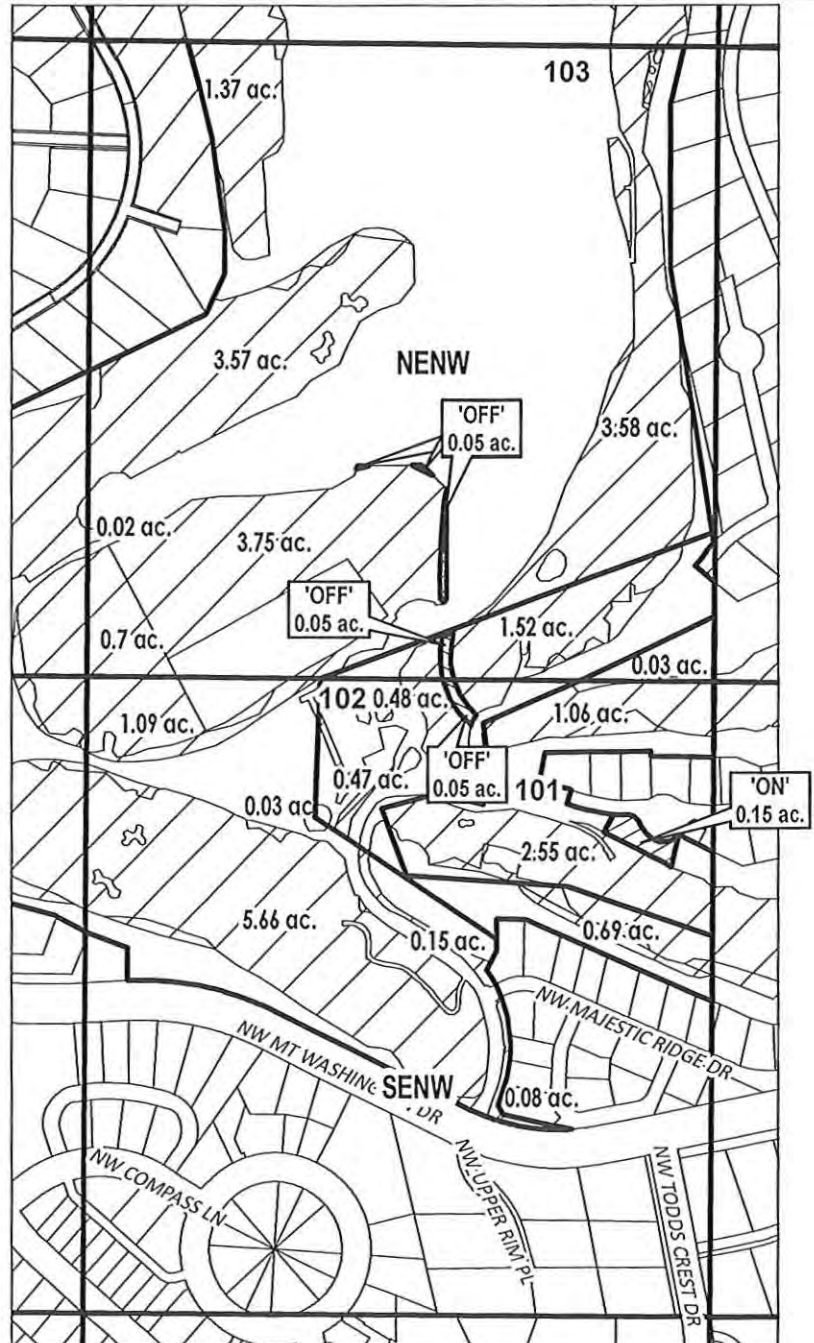

"OFF/ON" MAP

- 'ON' LANDS
- OFF LANDS
- EXISTING WATER RIGHTS



APPLICATION FOR WATER RIGHTS TRANSFER

NAME: RIVER'S EDGE INVESTMENTS, LLC

TAXLOT #: 101, 102, 103

0.15 ACRES **13514**

Date: 04/15/2020

DESCHUTES COUNTY SEC.19 T17S R13E

SCALE - 1" = 400'




SE 1/4 OF THE NW 1/4

RECEIVED

AUG 24 2020

OWRD

DISTRICT INTERNAL
NOTICE #: T-2020-017

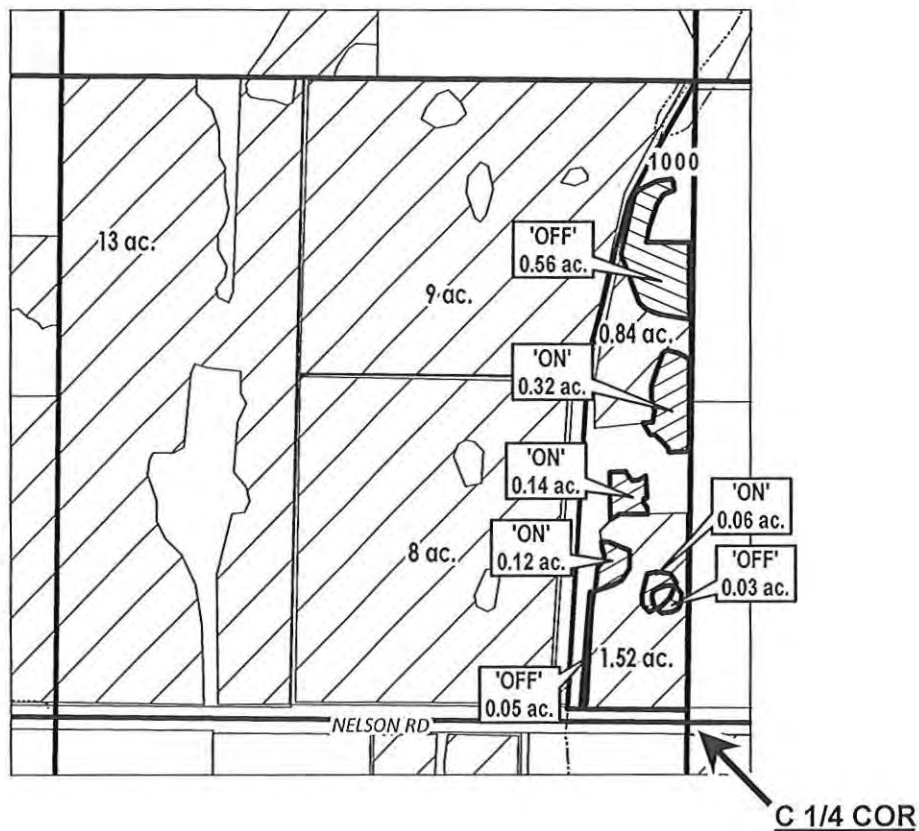

	'ON' LANDS
	OFF LANDS
	EXISTING WATER RIGHTS

"OFF/ON" MAP



APPLICATION FOR WATER RIGHTS TRANSFER

NAME: Christopher D and Kit A. Larsen

TAXLOT #: 1000

0.64 ACRES

13514

Date: 05/05/2020

DESCHUTES COUNTY SEC.30 T17S R13E

SCALE - 1" = 400'




NE 1/4 OF THE NW 1/4

RECEIVED

AUG 24 2020

OWRD

DISTRICT INTERNAL
NOTICE #: T-2020-001

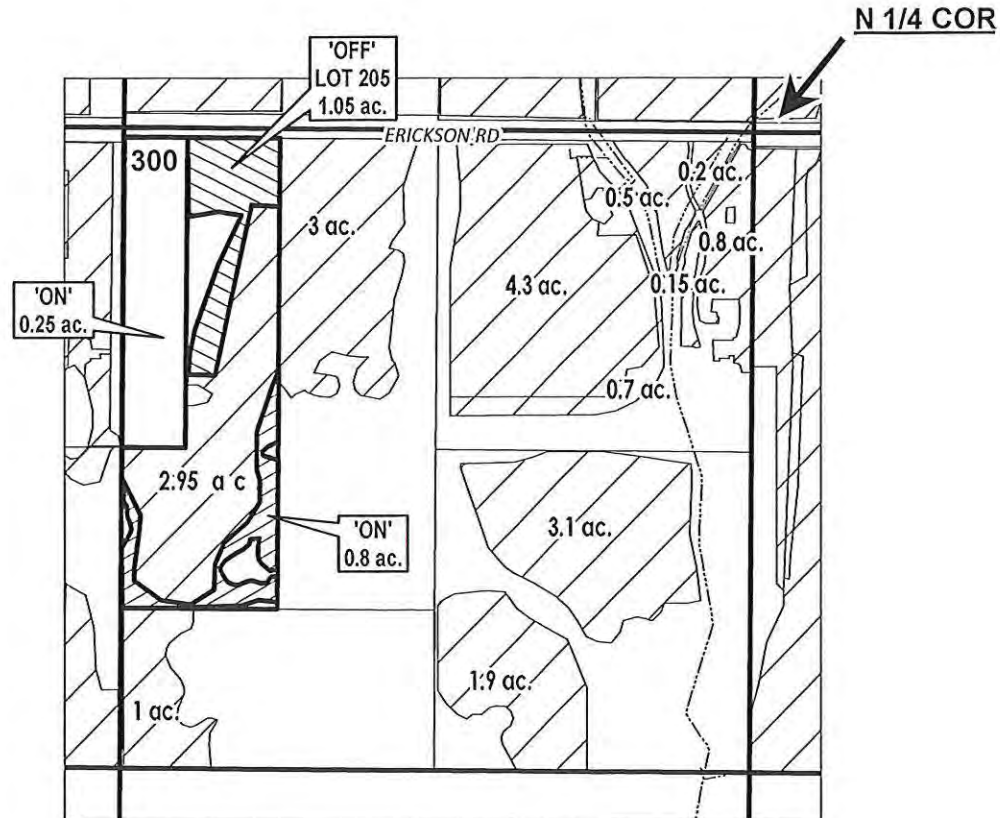

"OFF/ON" MAP

# ac.	'ON' LAND PARCELS
	EXISTING WATER RIGHTS
	OFF LANDS
	ON LANDS



APPLICATION FOR WATER RIGHTS TRANSFER

KURT M. AND JENNIFER J. BOMKE 13514

TAXLOT #: 205, 300

1.05 ACRES

Date: 03/04/2020

DESCHUTES COUNTY
SEC.13 T17S R14E

SCALE - 1" = 400'




SW 1/4 OF THE SE 1/4

RECEIVED

AUG 24 2020

OWRD

DISTRICT INTERNAL
NOTICE #: T-2020-012

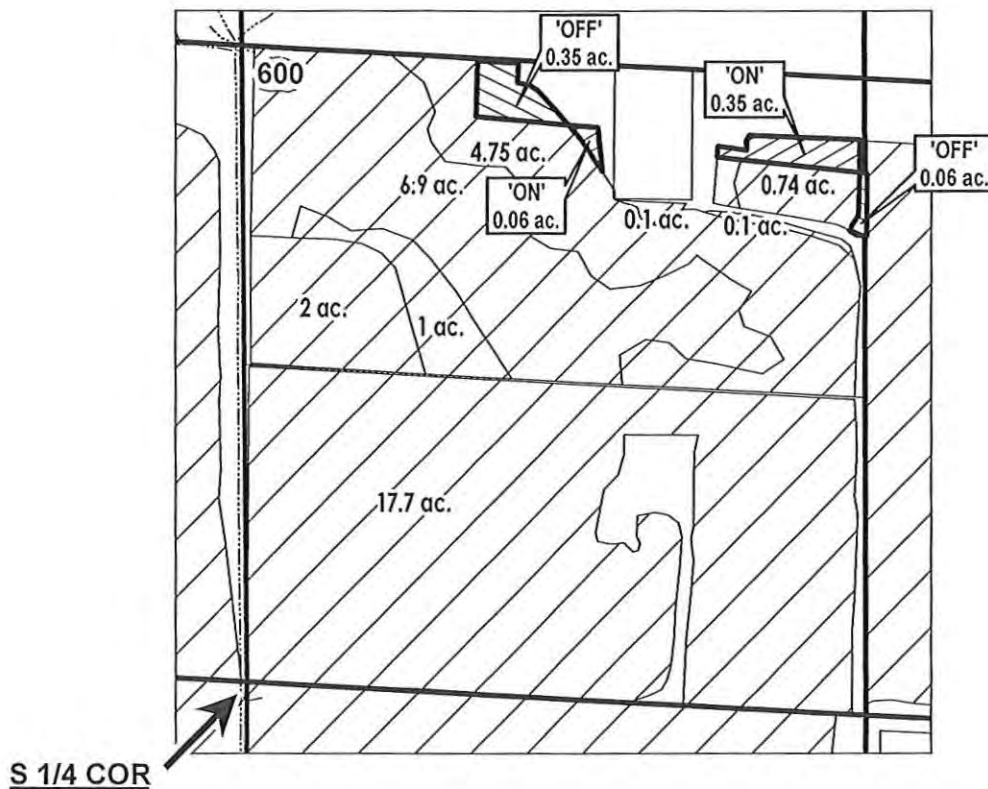

"OFF/ON" MAP

	EXISTING WATER RIGHTS
	OFF LANDS
	ON LANDS



APPLICATION FOR WATER RIGHTS TRANSFER

Robert E. Jr. and Erynne E. Fore

13514

TAXLOT #: 600

0.41 ACRES

Date: 03/17/2020

DESCHUTES COUNTY SEC.23 T17S R14E

SCALE - 1" = 400'




RECEIVED

AUG 24 2020

OWRD

SE 1/4 OF THE NW 1/4; NE 1/4 OF THE SW 1/4

DISTRICT INTERNAL
NOTICE #: T-2020-009

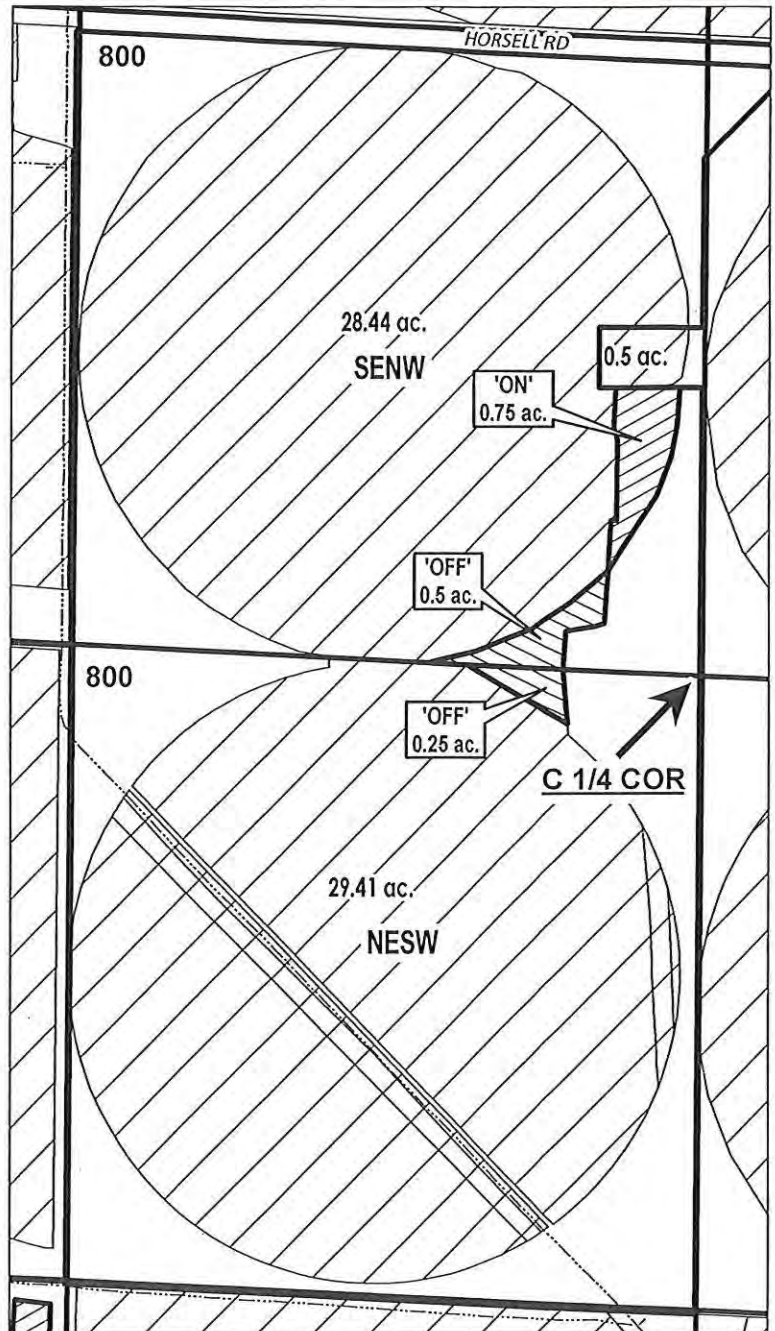

"OFF/ON" MAP

-  EXISTING WATER RIGHTS
-  OFF LANDS
-  ON LANDS



APPLICATION FOR WATER RIGHTS TRANSFER

Keith Middleton

13514

TAXLOT #: 800

0.75 ACRES

Date: 03/17/2020

DESCHUTES COUNTY
SEC.28 T17S R14E

SCALE - 1" = 400'




RECEIVED

AUG 24 2020

OWRD

NW 1/4 OF THE NE 1/4; SW 1/4 OF THE NE 1/4

DISTRICT INTERNAL
NOTICE #: T-2020-016

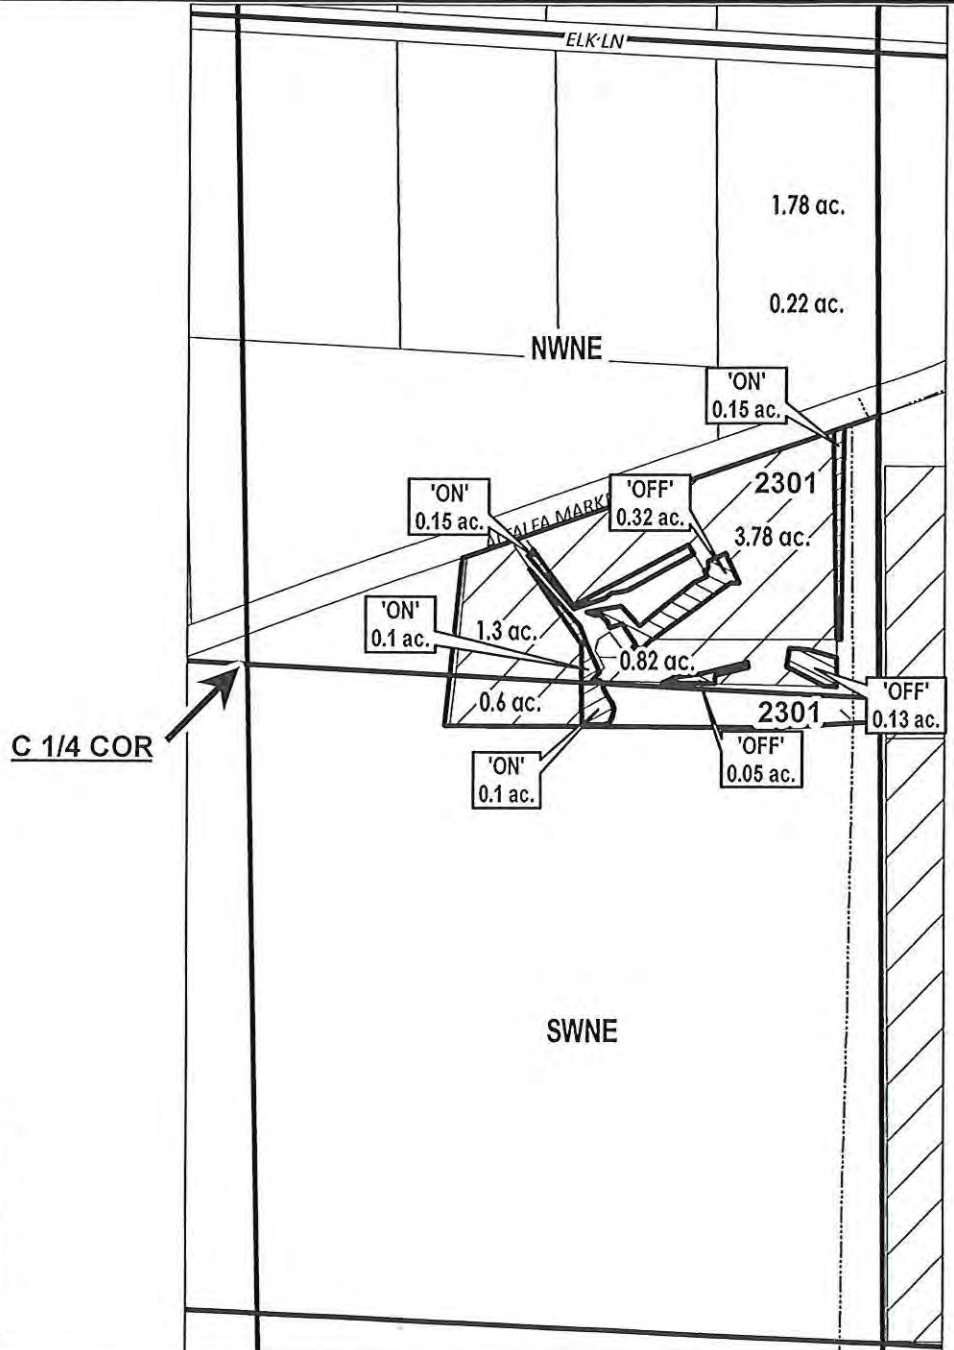

"OFF/ON" MAP

	'ON' LANDS
	OFF LANDS
	PARCELS W/ WATER RIGHTS
	EXISTING WATER RIGHTS

APPLICATION FOR WATER RIGHTS TRANSFER

NAME: CURT G. JENO

TAXLOT #: 2301

0.5 ACRES 13514



Date: 04/15/2020

DESCHUTES COUNTY SEC.02 T18S R13E

SCALE - 1" = 400'




RECEIVED

AUG 24 2020

OWRD

SW 1/4 OF THE SE 1/4; SE 1/4 OF THE SE 1/4

DISTRICT INTERNAL
NOTICE #: T-2020-010

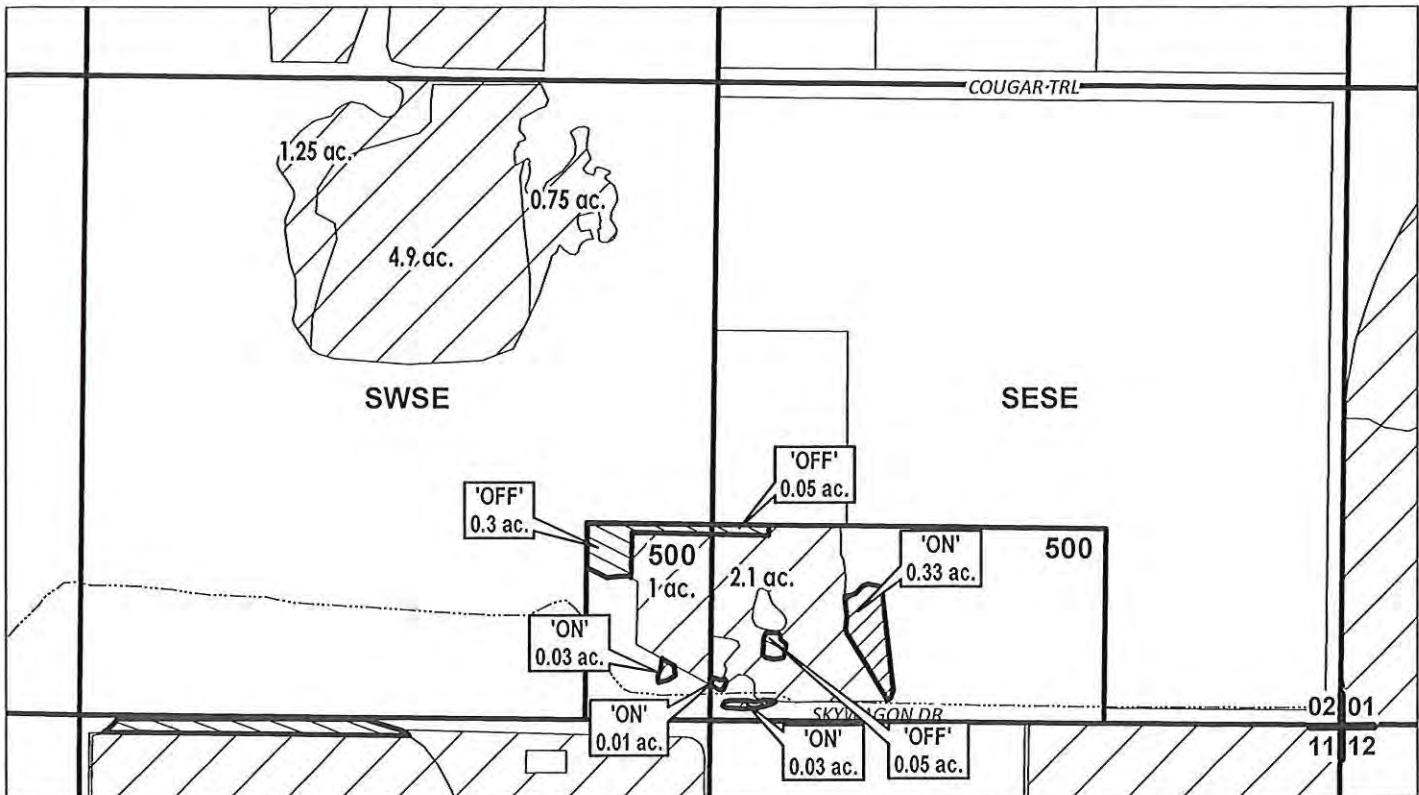

"OFF/ON" MAP

	EXISTING WATER RIGHTS
	ON LANDS
	OFF LANDS



APPLICATION FOR WATER RIGHTS TRANSFER

NAME: Benjamin C. Scott and Rebecca Rose O'Connell

TAXLOT #: 500

0.4 ACRES 13514

Date: 6/3/2020

DESCHUTES COUNTY
SEC.04 T18S R13E

SCALE - 1" = 400'




SW 1/4 OF THE NE 1/4

RECEIVED

AUG 24 2020

OWRD

DISTRICT INTERNAL
NOTICE #: T-2020-006

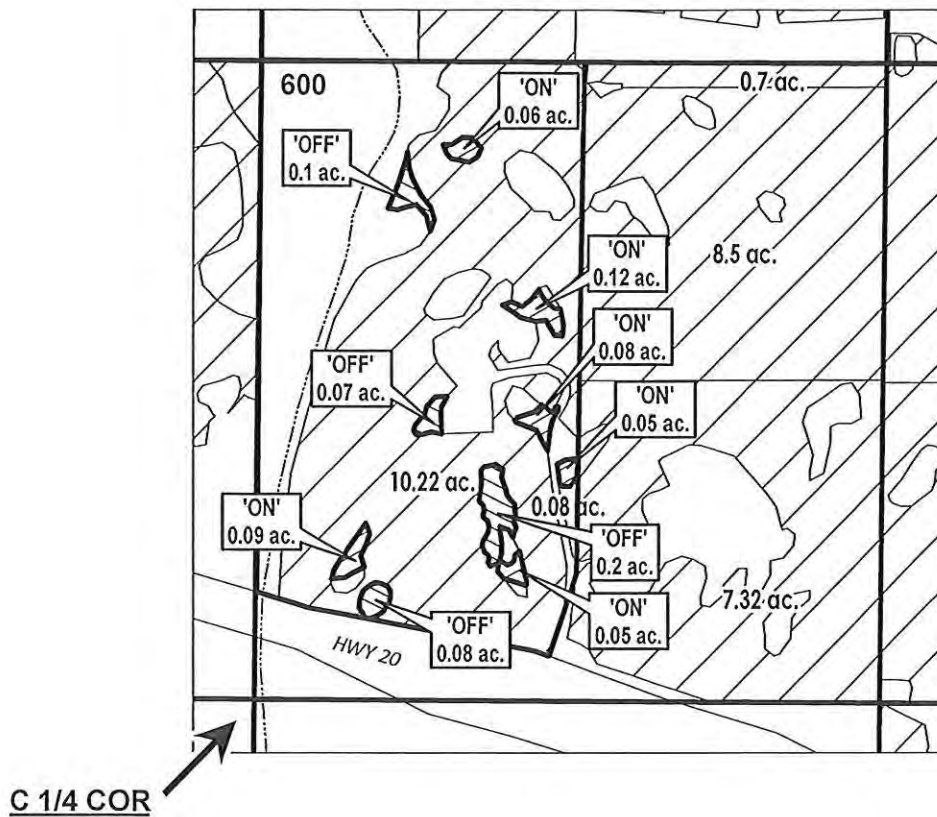

"OFF/ON" MAP



APPLICATION FOR WATER RIGHTS TRANSFER

Jacob Ralston and Dayna Ward Ralston 13514

TAXLOT #: 600

0.45 ACRES

Date: 04/24/2020

Checklist for District Transfer Intake – Division 385

Permanent or Non-Use district transfers are for POU *ONLY*.

Temporary district transfers can include changes in POD/POA (to facilitate a change in POU) and are limited to a single year.

Please assure a “Supplemental Form A” is included for each water right involved, and that all required attachments are completed and included.

Note: Generally speaking, we prefer not to return district applications for deficiencies; if it is questionable, please check with the District Transfer Program advisor before returning the application.



Identify the type of district transfer application. (Note: a “District Notice” is **not** an application, but at the after the end of the irrigation season, District Permanent Applications may include copies of prior District Notices.)

Sometimes districts inadvertently use parts of two different types of transfer forms when filing. If not sure if a district is submitting a Transfer Notice or a District Transfer, or if not sure if a district is submitting a District Temporary or District Permanent Transfer, or not sure if a district is submitting a regular transfer or a District Transfer, **please contact Ann or Joan.**



Is the use proposed for transfer irrigation or supp'l irrigation? **If not please contact Ann or Joan.**

OK

These items need to be included in the district transfer application:



Transfer Application communicating rights affected and includes signature.



POU listing – both “authorized/from” and “proposed/to”. Multiple formats accepted.



POD/POA listing – if temporary – both “authorized/from” and proposed/to”



Land Use Information Form – Not required if (a) for place of use change only (b) existing and proposed water use is located entirely w/in EFU or w/in an irrigation district (c) The change does not involve the placement or modification of structures, including but no limited to water diversions, impoundments, distribution facilities , water wells and well houses and (d) application involves irrigation water uses **ONLY**.



Maps - – both “authorized/from” and “proposed/to” (From and to can be on same map.)

NOTE- districts are authorized to submit the maps in multiple digital formats and often submit maps via email. If maps are not submitted, please contact Ann or Joan.



Appropriate Fees

7-13514