

RECEIVED

CLAIM OF BENEFICIAL USE AND SITE REPORT

SEP 10 1999

INFORMATION: BILL BOTELHO
P.O. BOX 45
SMITH, NV 89430
TRANSFER No. 8241

WATER RESOURCES DEPT.
SALEM, OREGON

SOURCE: One well

DIVERSION POINT: SE 1/4 NW 1/4 Section 31, T38S R20E, WM.
By survey tie well is located S58°37'39"E
2892.18' from the NW Section Corner Section
31, T38S R20E. Well log is attached.

MOTOR: High Thrust US Electrical, 125 HP

PUMP: Ingersoll Dressor, Model No. 14M160

USE: Primary & Supplemental irrigation

LIFT: Mean elevation difference between water level
of the source and place of use is 20'.

CALCULATIONS: Primary Max Q = $\frac{102.60}{80} = 1.28$ CFS

Supplemental Max Q = $\frac{337.50}{80} = 4.22$ CFS


SURVEY TIE: Physical tie with Nikon NTD4. 1/2" Iron pin
located at the NW Section Corner, Section 31

The final proof survey and inspection of the use as found to be completed under the terms and conditions of Transfer #8241 was completed by me in July 1999, and the facts contained in this report and accompanying final proof map are correct to the best of my knowledge.

RECEIVED

SEP 10 1999

WATER RESOURCES DEPT.
SALEM, OREGON

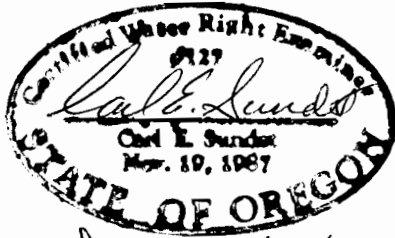

Renaus 6/30/00

I, Bill Botelho, agree to the findings of the CWRE and do submit this site report and map as my Claim of Beneficial Use of the water as provided in Transfer #8241 and hereby request the issuance of a Certificate of Water Right.

A handwritten signature in cursive script that reads "Bill Botelho". The signature is written over a horizontal line.

Bill Botelho