STATE OF OREGON

COUNTY OF UMATILLA

CERTIFICATE OF WATER RIGHT

This Is to Certify, That DON MILLS

of Route 1, Box 58, Stanfield , State of Oregon , has made proof to the satisfaction of the STATE ENGINEER of Oregon, of a right to the use of the waters of a well

a tributary of Stanfield Drain (Umatilla River) supplemental irrigation of 205.8 acres

for the purpose of

under Permit No. G-3566 of the State Engineer, and that said right to the use of said waters has been perfected in accordance with the laws of Oregon; that the priority of the right hereby confirmed dates from January 18, 1967

that the amount of water to which such right is entitled and hereby confirmed, for the purposes aforesaid, is limited to an amount actually beneficially used for said purposes, and shall not exceed 2.57 cubic feet per second

or its equivalent in case of rotation, measured at the point of diversion from the stream. The point of diversion is located in the NEX NWM, Section 27, T. 4 N., R. 29 E., W. M. Well located: 1570 feet North and 50 feet West from Center, Section 27.

The amount of water used for irrigation, together with the amount secured under any other right existing for the same lands, shall be limited to one-eightleth of one cubic foot per second per acre, or its equivalent for each acre irrigated and shall be further limited to a diversion of not to exceed 3 acre feet per acre for each acre irrigated during the irrigation season of each year; provided further that the right allowed herein shall be limited to any deficiency in the available supply of any prior right existing for the same land and shall not exceed the limitation allowed herein.

and shall

conform to such reasonable rotation system as may be ordered by the proper state officer.

A description of the place of use under the right hereby confirmed, and to which such right is appurtenant, is as follows:

5.0 acres NEM NW/4
14.5 acres SW/4 NW/4
36.5 acres SEM NW/4
35.6 acres NEM SW/4
38.8 acres NW/4 SW/4
39.4 acres SW/4 SW/4
36.0 acres SEM SW/4
Section 27
T. 4 N., R. 29 E., W. M.

The right to the use of the water for the purposes aforesaid is restricted to the lands or place of use herein described.

WITNESS the signature of the State Engineer, affixed

this date. December 14, 1972

CHRIS L. WHEELER

State Engineer

STATE OF OREGON

COUNTY OF UMATILLA

CERTIFICATE OF WATER RIGHT

This Is to Certify, That DON MILLS

of Route 1, Box 58, Stanfield , State of Oregon , has made proof to the satisfaction of the STATE ENGINEER of Oregon, of a right to the use of the waters of a well

a tributary of Stanfield Drain (Umatilla River) supplemental irrigation of 56.0 acres

for the purpose of

under Permit No. G-4668 of the State Engineer, and that said right to the use of said waters has been perfected in accordance with the laws of Oregon; that the priority of the right hereby confirmed dates from July 24, 1969

that the amount of water to which such right is entitled and hereby confirmed, for the purposes aforesaid, is limited to an amount actually beneficially used for said purposes, and shall not exceed 0.70 cubic foot per second

or its equivalent in case of rotation, measured at the point of diversion from the stream. The point of diversion is located in the SEM NWM, Section 27, T. 4 N., R. 29 E., W. M. Well located: 680 feet North and 50 feet West from Center, Section 27.

The amount of water used for irrigation, together with the amount secured under any other right existing for the same lands, shall be limited to one-eightieth of one cubic foot per second per acre, or its equivalent for each acre irrigated and shall be further limited to a diversion of not to exceed 3 acre feet per acre for each acre irrigated during the irrigation season of each year; and shall be further limited to appropriation of water only to the extent that it does not impair or substantially interfere with existing surface water rights of others, provided further that the right allowed herein shall be limited to any deficiency in the available supply of any prior right existing for the same land and shall not exceed the limitation allowed herein,

and shall conform to such reasonable rotation system as may be ordered by the proper state officer.

A description of the place of use under the right hereby confirmed, and to which such right is appurtenant, is as follows:

5.0 acres NE% NW% 14.5 acres SW% NW% 36.5 acres SE% NW% Section 27 T. 4 N., R. 29 E., W. M.

The right to the use of the water for the purposes aforesaid is restricted to the lands or place of use herein described.

WITNESS the signature of the State Engineer, affixed


this date. December 14, 1972

CHRIS L. WHEELER

State Engineer

G-4468 38733 38734

T. 4 N. R. 2 9 E. W. M.

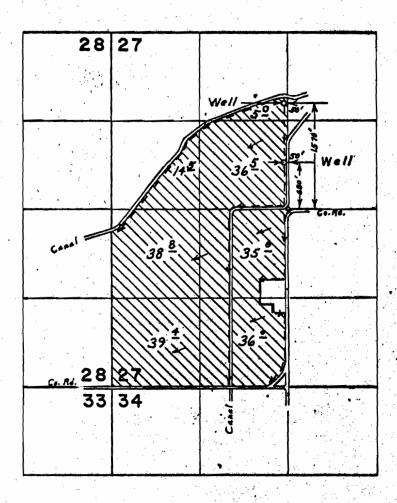

FINAL PROOF SURVEY

Application No. G-378 Application No. G-4946 Permit No. IN NAME OF	G-3566 G-4668
DON MILLS	

Surveyed Aug. 27, 1971, by L. E. Gould.

HZ-3F-14 61917-U