



Oregon Water Resources Department
 725 Summer Street NE, Suite A
 Salem Oregon 97301-1266
 (503) 986-0900
 www.wrd.state.or.us

Request for Assignment

If for multiple rights, a separate form and fee for each right will be required.

I, Dennis C Dice Sara S. Dice
 (Name of Applicant / Permit / Transfer Holder)

P.O. Box 5983 Bend, OR 97708 541-3829187
 (Mailing address) (City) (State) (Zip) (Phone #)

...hereby assign all my interest in and to application/permit/transfer;

...hereby assign all my interest in and to a portion of application/permit/transfer;

(You must include a map showing the portion of the application/permit to be assigned.)

(All Millck Water Rts Cert. # 51178 & # 588; 14.8 ac. Ochoco Ck Water Rt Cert. # 55564)

...hereby assign a portion of my interest in and to the entire application/permit/transfer;

Application # _____, Permit # _____; Transfer # T 7509

-OR-

GR Statement # _____, GR Certificate of Registration # _____

as filed in the office of the Water Resources Director, to:

Mill Creek Land LLC
 (Name of New Owner)

7900 NE Millck Rd, Prineville OR 97754 541-447-7363
 (Mailing address) (City) (State) (Zip) (Phone #)

NOTE: If there are other owners of the property described in this Application, Permit, Transfer or Certificate of Ground Water Registration, you must provide a list of all other owners' names and mailing addresses and attach it to this form.

I hereby certify that I have notified all other owners of the property described in this Application, Permit or Certificate of Registration of this request for assignment.

Witness my hand this 29 day of MARCH, 2007.

Applicant/Permit holder _____

Applicant/Permit holder _____

DO NOT WRITE IN THIS BOX

- This certifies assignment and record change at Oregon Water Resources Department effective 8:00a.m. on date of receipt at Salem, Oregon.
- Fee receipt # 86946
- For Director by Jerry Sauter, Program Analyst in Water Rights Division *Jerry Sauter*

The completed "Request for Assignment" form must be submitted to the Department along with the appropriate recording fees:

- \$25 for the first page, and
 - \$5 for each additional page.
- [as required by ORS 536.050(1)(d)]

RECEIVED

APR 03 2007

WATER RESOURCES DEPT
 SALEM, OREGON
 WR

O.K. ASSIGN
 PARTIAL 4/3/2007
[Signature]

T7509 Mill Creek Water Rts

WATER RIGHT


MILL CREEK W

SECTIONS 2
CRC

ORIGINAL CER
SUPERSEDED
PRIORITY DA1

ORIGINAL P.O.
FROM THE SC

P.O.D. FROM MILL CREEK
1122 FT. NORTH AND
340 FT. WEST OF
THE NORTHWEST CORNER
OF SECTION 26

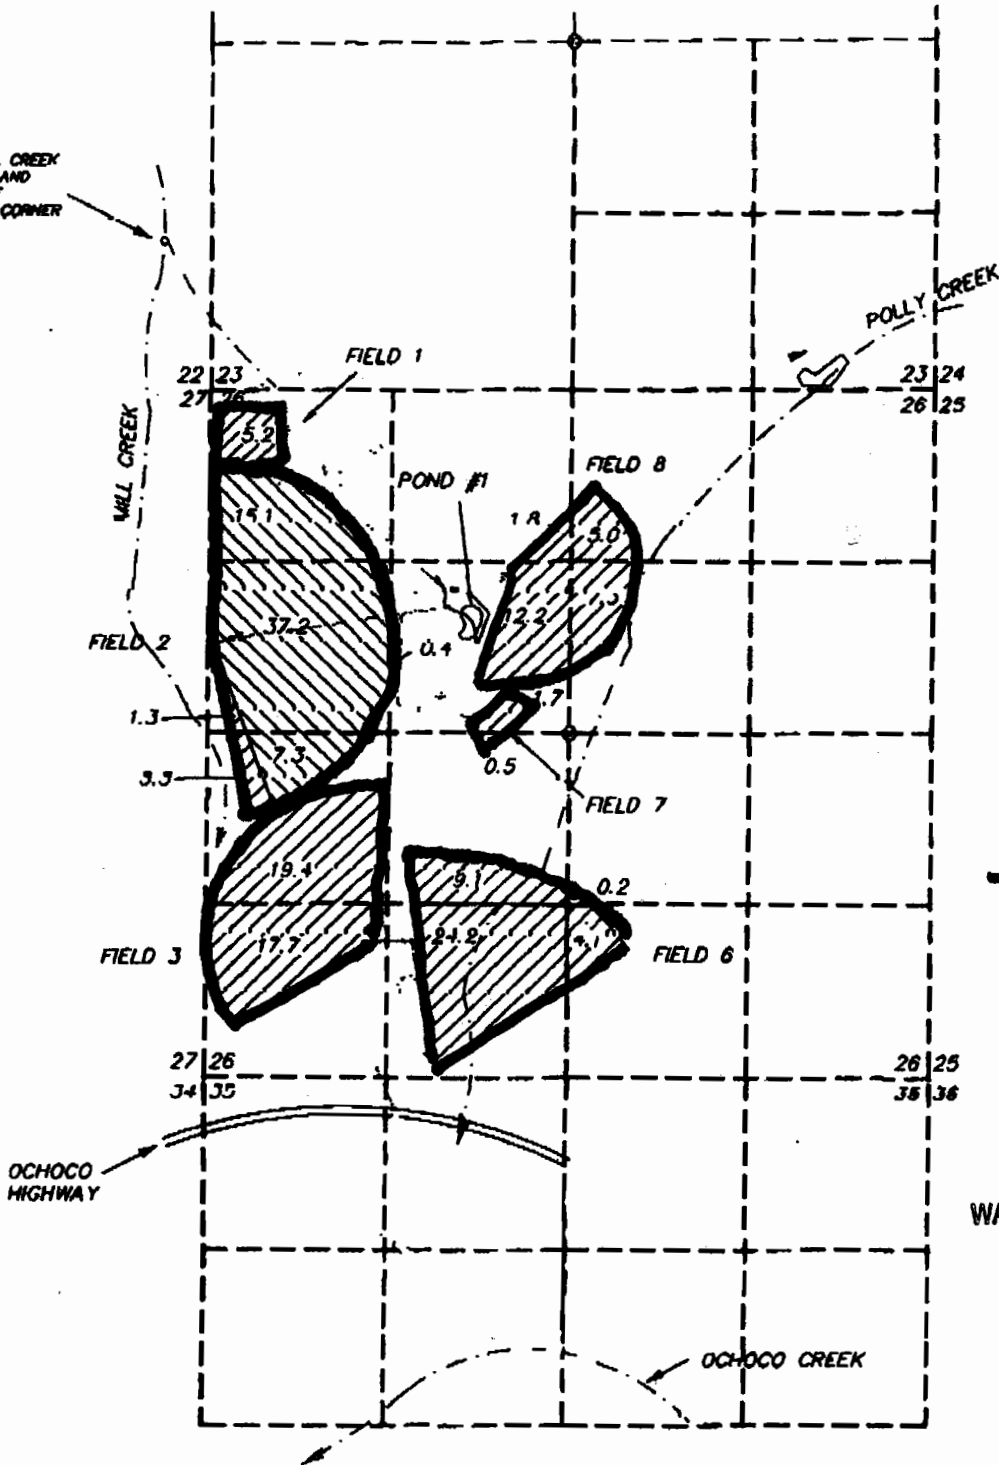

= MILL CREEK
11.30 AC
Cert #51178

= MILL CREEK
60.0 AC
Cert #588

— All Mill Creek
Water Rts are
being transferred

RECEIVED

APR 03 2007

WATER RESOURCES DEPT
SALEM, OREGON

BY ROBERT E. BAXTER, CER
IN THE STATE OF OREGON,
WATER RIGHT SURVEY MAP

THE PREPARATION OF THIS
OF IDENTIFYING THE LOCATION
ONLY AND HAS NO INTENT
LOCATIONS OF PROPERTY

PREPARED BY
BAXTER LAND SURVEYING, INC.
20370 EMPIRE AVE. SUITE C3

CLAIM OF BENEFICIAL
FOR
MARK COPELAND


T7509
Ochocho Ck Water Rts.

WATER RIGHT CLAIM OF BENEFICIAL

OCHOCO CREEK WATER RIGHT TRANSFER

LOCATED IN
SECTION 35, T. 14 S., R. 17 E., W.M.
CROOK COUNTY, OREGON

ORIGINAL CERTIFICATE NO. 602
SUPERSEDED BY CERTIFICATE NO. 55564
ORIGINAL P.O.D. SOUTH 450 FT. AND WEST 870 FT.
FROM THE N.E. CORNER OF THE SE 1/4, NW 1/4.

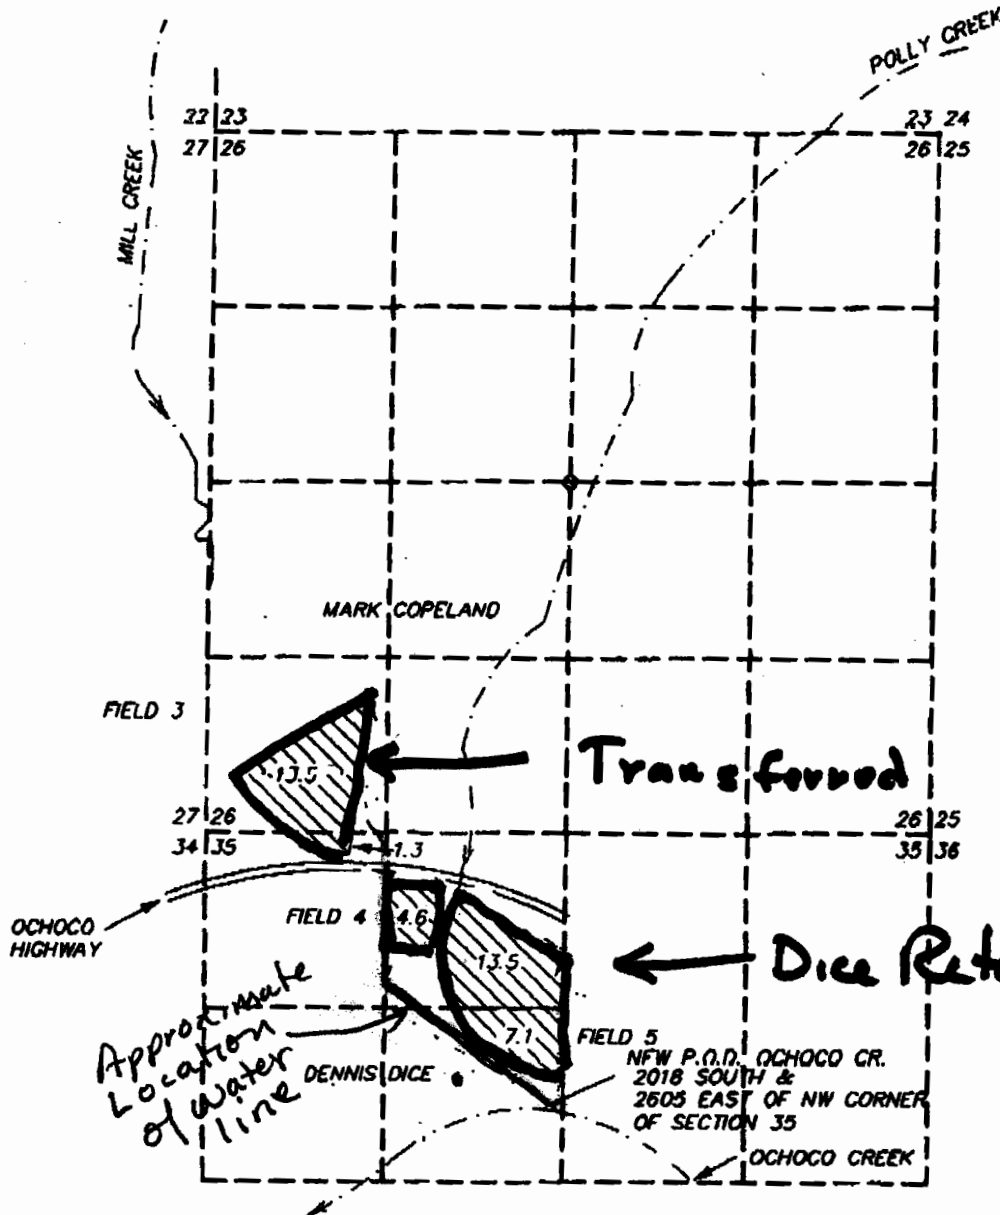

= OCHOCO CREEK WATER RIGHT FINAL LOCATION

MARK COPELAND = 14.8 AC.
 DENNIS DICE = 25.2 AC.

RECEIVED

APR 03 2007

WATER RESOURCES DEPT
SALEM, OREGON

I, ROBERT E. BAXTER, CERTIFIED WATER RIGHT ENGINEER IN THE STATE OF OREGON, HEREBY CERTIFY THAT THE WATER RIGHT SURVEY MAP WAS PREPARED BY

THE PREPARATION OF THIS MAP IS FOR THE PURPOSE OF IDENTIFYING THE LOCATION OF THE WATER RIGHT ONLY AND HAS NO INTENT TO PROVIDE DIMENSIONAL LOCATIONS OF PROPERTY OWNERSHIP LINES.

PREPARED BY
R LAND SURVEYING, INC.
1 EMPIRE AVE. SUITE C3
RE. 97701 (541) 382-1962

CLAIM OF BENEFICIAL USE MAP
FOR
MARK COPELAND & DENNIS DICE