

STATE OF OREGON

COUNTY OF UMATILLA

CERTIFICATE OF WATER RIGHT

This is to certify, That DON MILLS

of Route 1, Box 58, Stanfield, State of Oregon 97875, has made proof to the satisfaction of the Water Resources Director, of a right to the use of the waters of Mills Well No. 2

a tributary of Umatilla River for the purpose of supplemental irrigation of 100.1 acres

under Permit No. G-5753 and that said right to the use of said waters has been perfected in accordance with the laws of Oregon; that the priority of the right hereby confirmed dates from August 13, 1973 that the amount of water to which such right is entitled and hereby confirmed, for the purposes aforesaid, is limited to an amount actually beneficially used for said purposes, and shall not exceed 0.96 cubic foot per second

or its equivalent in case of rotation, measured at the point of diversion from the well. The well is located in the NE 1/4 SW 1/4, Section 27, T4N, R29E, WM; 1510 feet North and 2350 feet East from SW Corner, Section 27.

The amount of water used for irrigation, together with the amount secured under any other right existing for the same lands, shall be limited to one-eightieth of one cubic foot per second per acre, or its equivalent for each acre irrigated and shall be further limited to a diversion of not to exceed 3 acre-feet per acre for each acre irrigated during the irrigation season of each year

and shall conform to such reasonable rotation system as may be ordered by the proper state officer.

A description of the place of use under the right hereby confirmed, and to which such right is appurtenant, is as follows:

- 19.8 acres NE 1/4 SW 1/4
- 7.5 acres NW 1/4 SW 1/4
- 38.6 acres SW 1/4 SW 1/4
- 34.2 acres SE 1/4 SW 1/4
- Section 27
- Township 4 North, Range 29 East, WM

he water for the purposes aforesaid is restricted to the lands or place of use herein

WITNESS the signature of the Water Resources Director, affixed


this date. October 28, 1985

/s/ William H. Young Water Resources Director

PORTIONS of THESE RIGHTS WILL NOT BE USED DURING 2007 SEASONS

5

T. 4N., R. 29E., W. M.

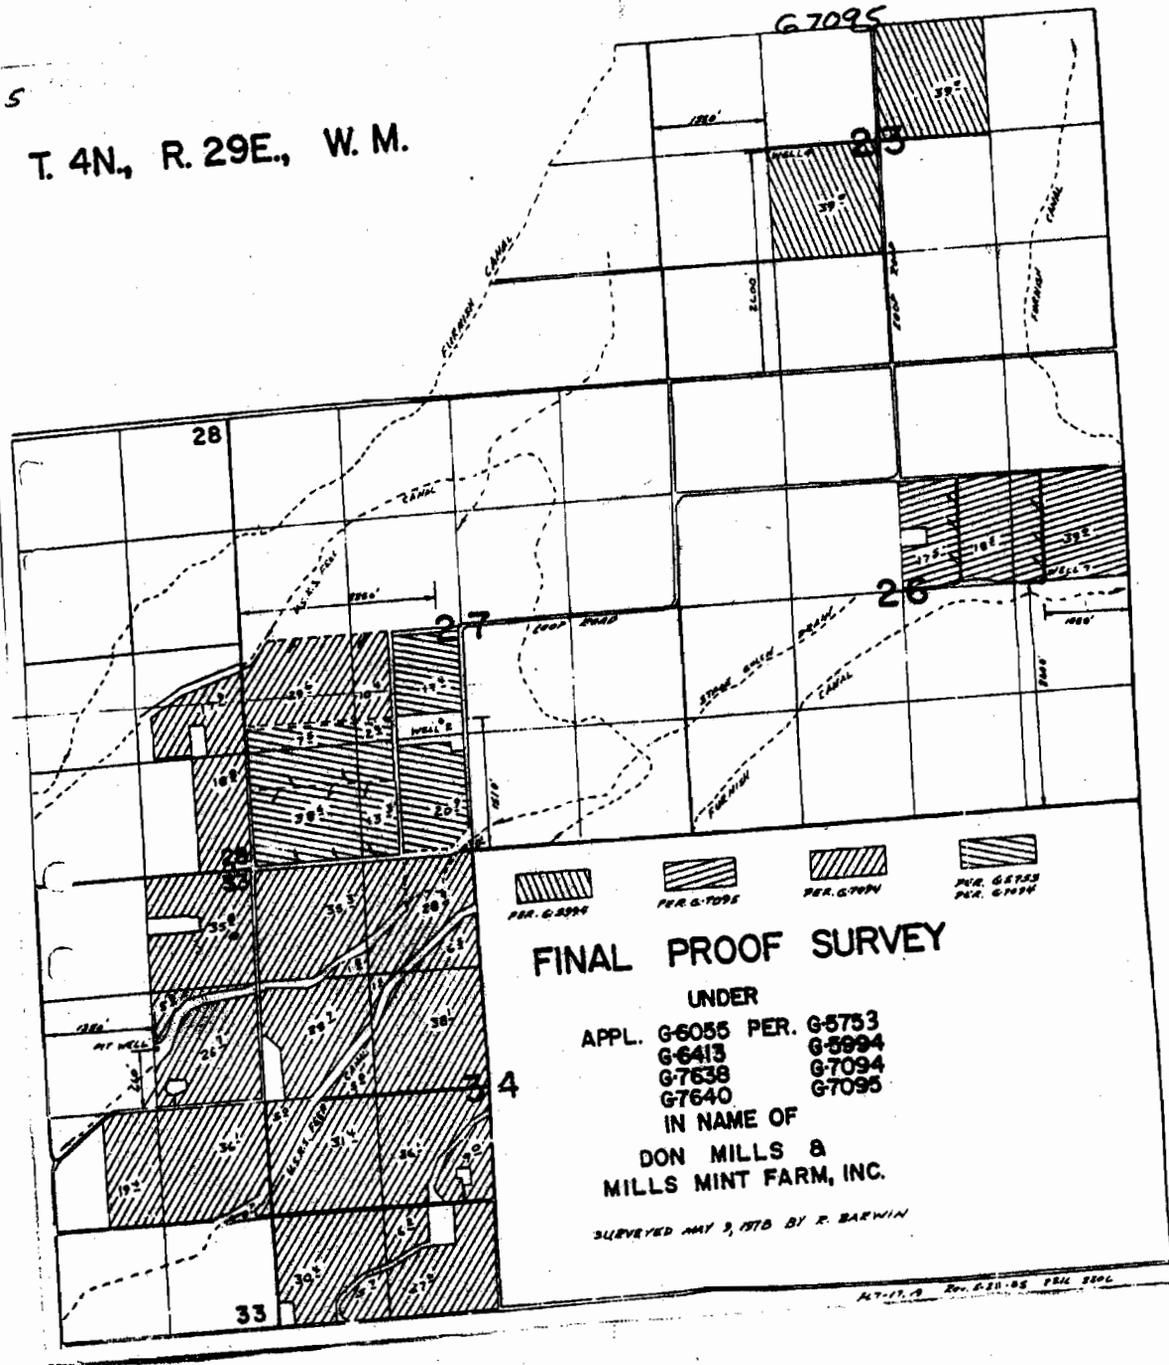

- PER. G-7095
- PER. G-7094
- PER. G-5753
PER. G-5994

FINAL PROOF SURVEY

UNDER

APPL. G-6055 PER. G-5753
 G-6413 G-5994
 G-7638 G-7094
 G-7640 G-7095

IN NAME OF

**DON MILLS &
MILLS MINT FARM, INC.**

SURVEYED MAY 9, 1970 BY R. BARWIN