


T. 2N, R. 4W, WM.

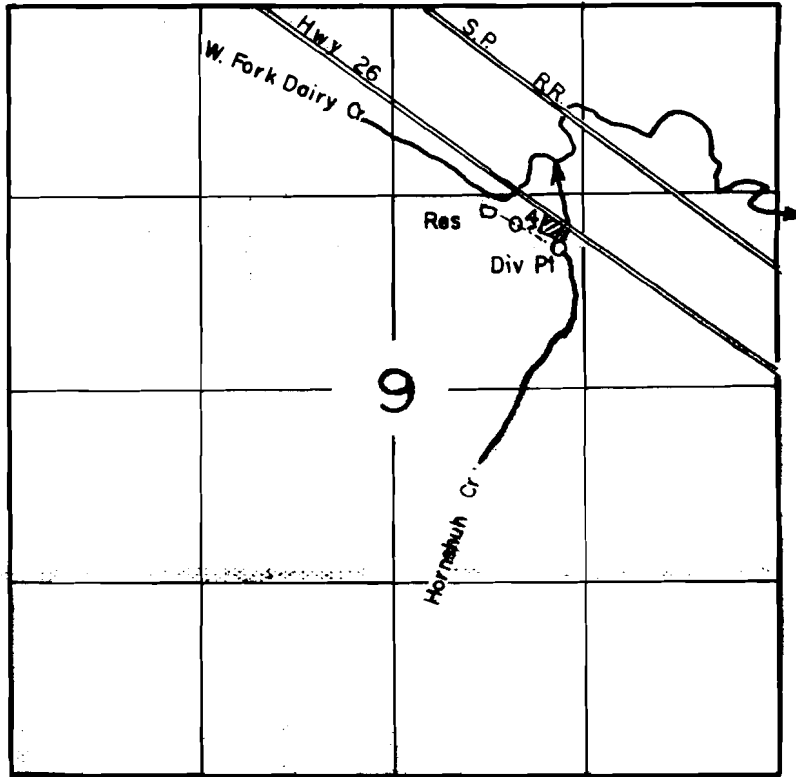

DIV. PT. LOCATED 1650' S & 1500' W FROM NE CORNER SECTION 9

SCALE: 1" = 1320'

FINAL PROOF SURVEY
UNDER

TRANSFER NO. 5513
R- 60566 R- 8257

Application No. 60567... Permit No. 45700.....

IN NAME OF

.....FRED.....HORNSHUH.....

Surveyed JULY 11... 1989., by I.M. WARREN.....