


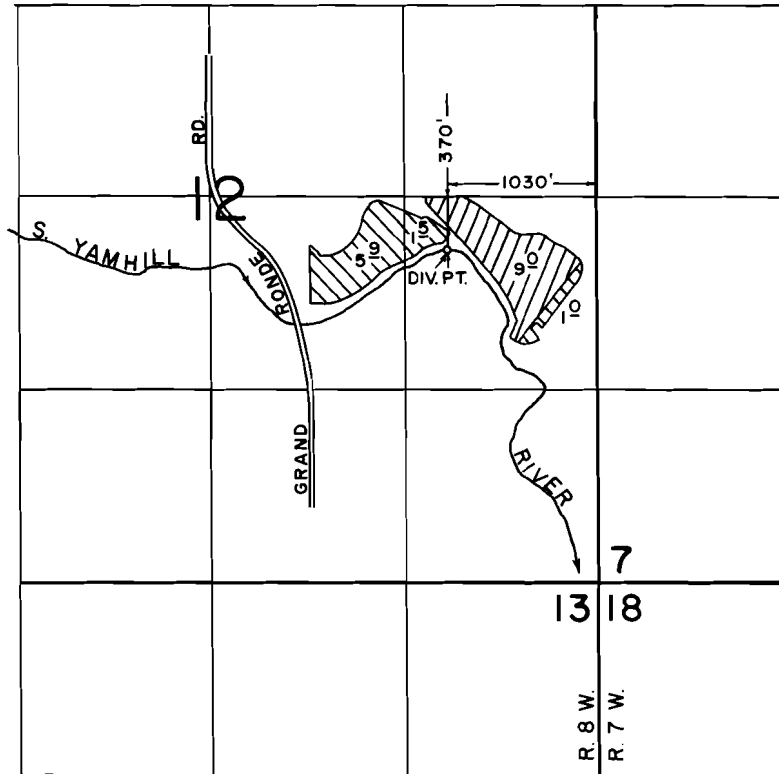

T. 6 S., R. 7 & 8 W., W.M.



**FINAL PROOF SURVEY**  
UNDER

T-4528

Application No. 60214 Permit No. 45093

IN NAME OF

KENT MICHAEL CORWIN

Surveyed APRIL 22 1987, by B.W. BISHOP



*gc*