


T.32S.,R.3E.,W.M.  
TAX LOT No. 32 3E 33 - 2500

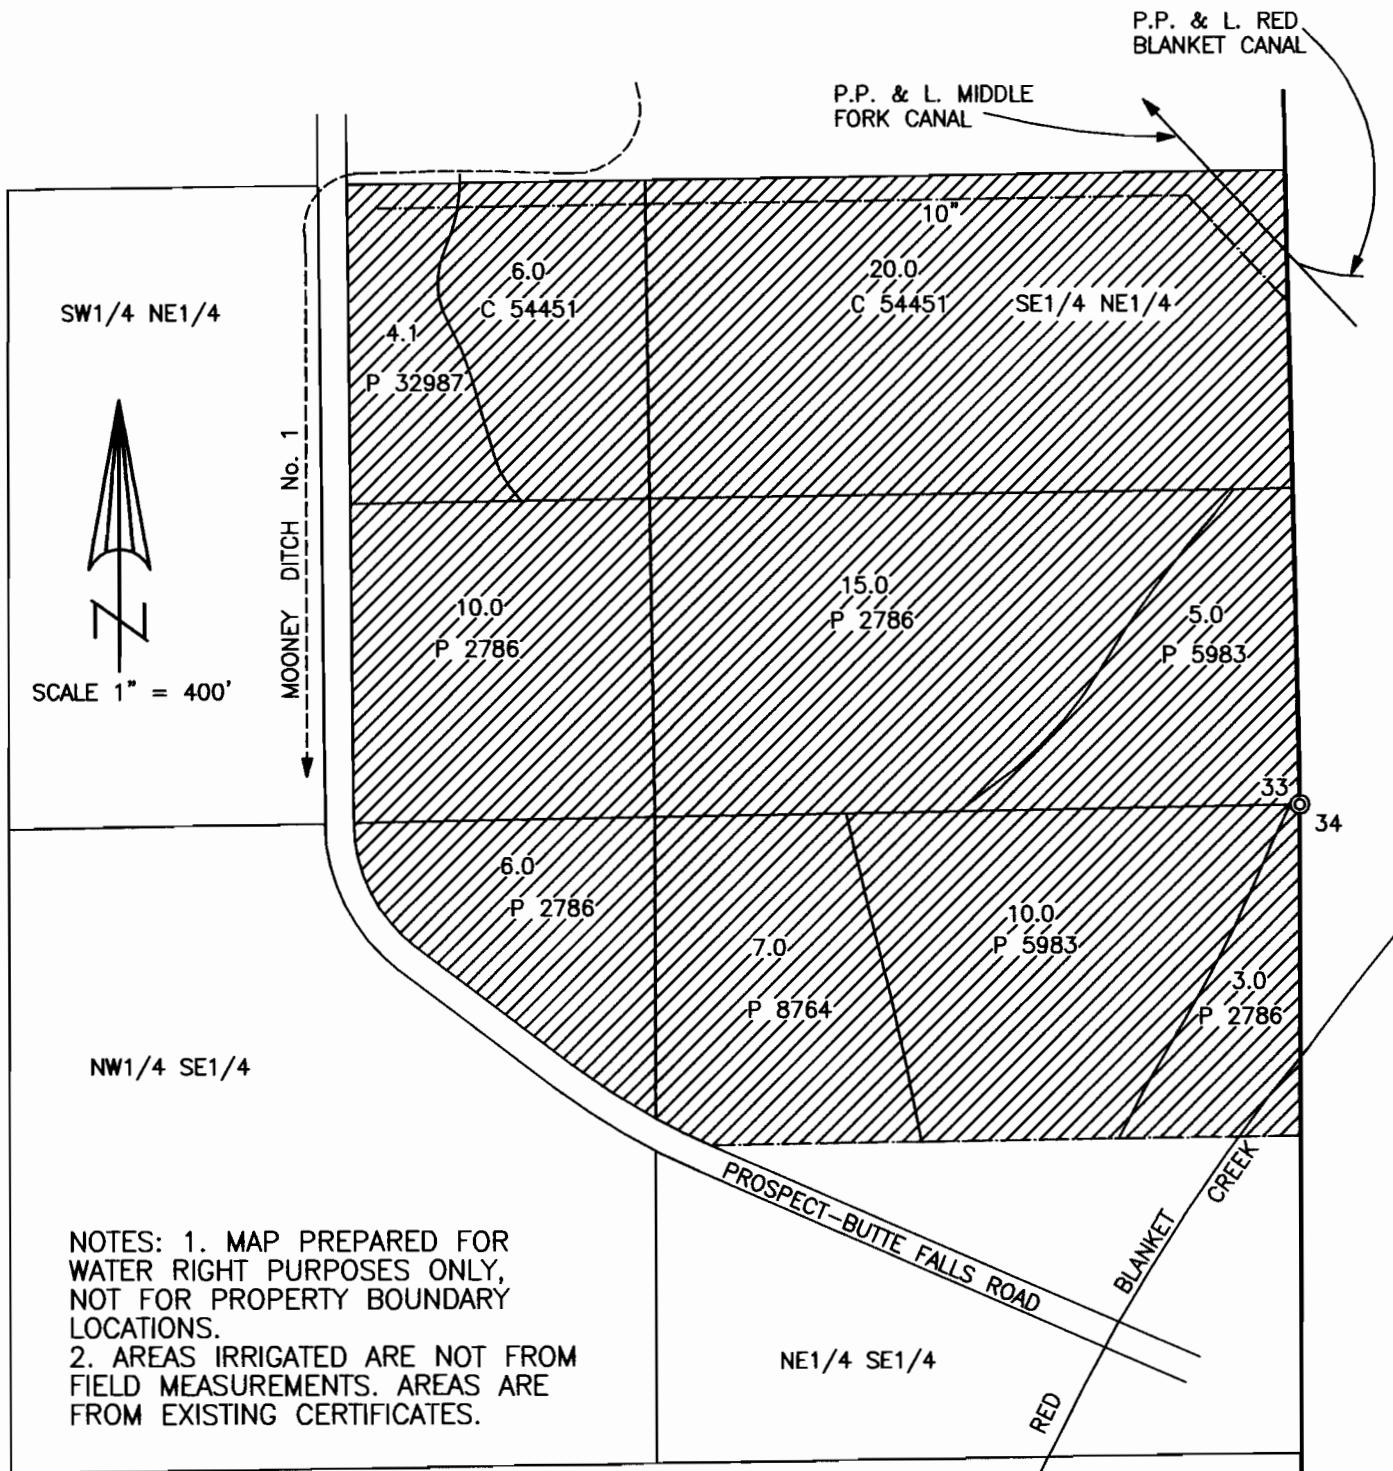


CLAIM OF BENEFICIAL USE MAP **RECEIVED**

APPLICATION No. T-8106

IN THE NAME OF:  
ALLEN AND KIM MARSHAL  
637 BUTTE FALLS - PROSPECT HIGHWAY  
PROSPECT, OR 97536



SEP 24 2007  
WATER RESOURCES DEPT  
SALEM OREGON

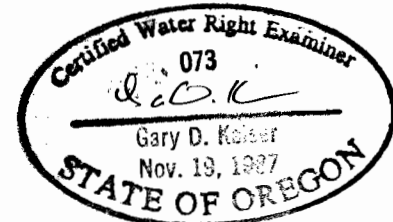

MAP PREPARED SEPTEMBER 6, 2007 BY GARY D. KAISER

T.32S.,R.3E.,W.M.  
TAX LOT No. 32 3E 34-500

SHEET

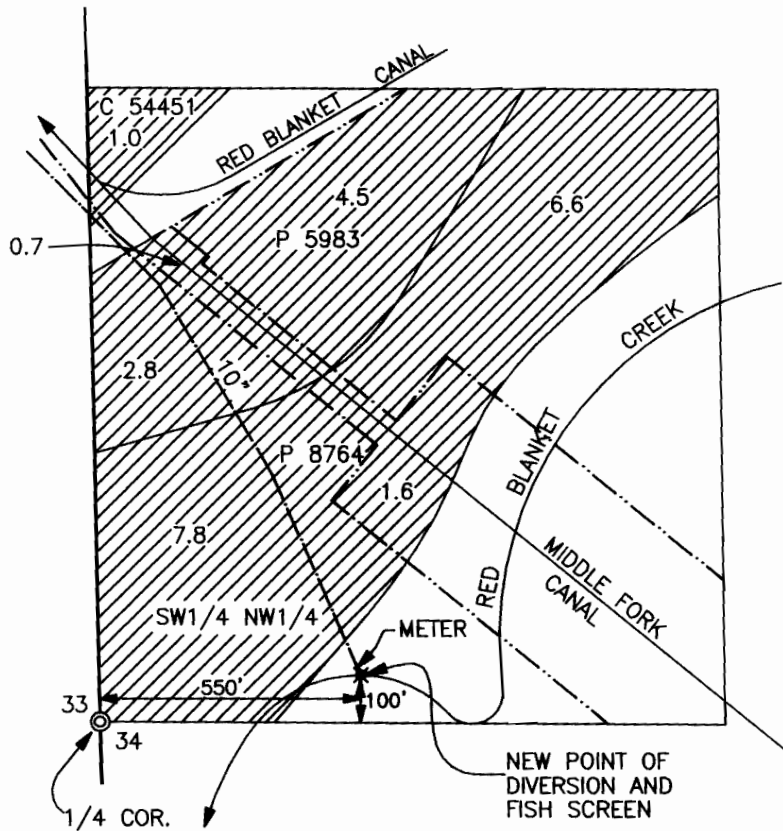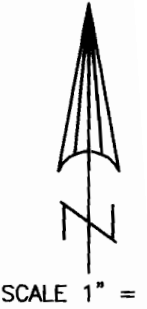

NOTES: 1. MAP PREPARED FOR WATER RIGHT PURPOSES ONLY, NOT FOR PROPERTY BOUNDARY LOCATIONS.  
2. AREAS IRRIGATED ARE NOT FR FIELD MEASUREMENTS. AREAS AR FROM EXISTING CERTIFICATES.


CLAIM OF BENEFICIAL USE MAP

APPLICATION No. T-8106

IN THE NAME OF:  
ALLEN AND KIM MARSHAL  
637 BUTTE FALLS - PROSPECT HIGHWAY  
PROSPECT, OR 97536

**RECEIVED**

SEP 24 2007  
WATER RESOURCES DEPT  
SALEM OREGON

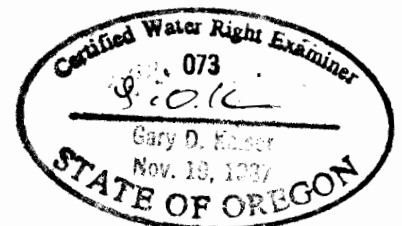

MAP PREPARED SEPTEMBER 6, 2007 BY GARY D. KAISER