26 & 35

6

T. 7 S. R. 19 E. W. M.

AREA irrig IN 2004

HALF OF field planted to spring wheat Irrigated through Aug. Hair summer fallowed by Wm

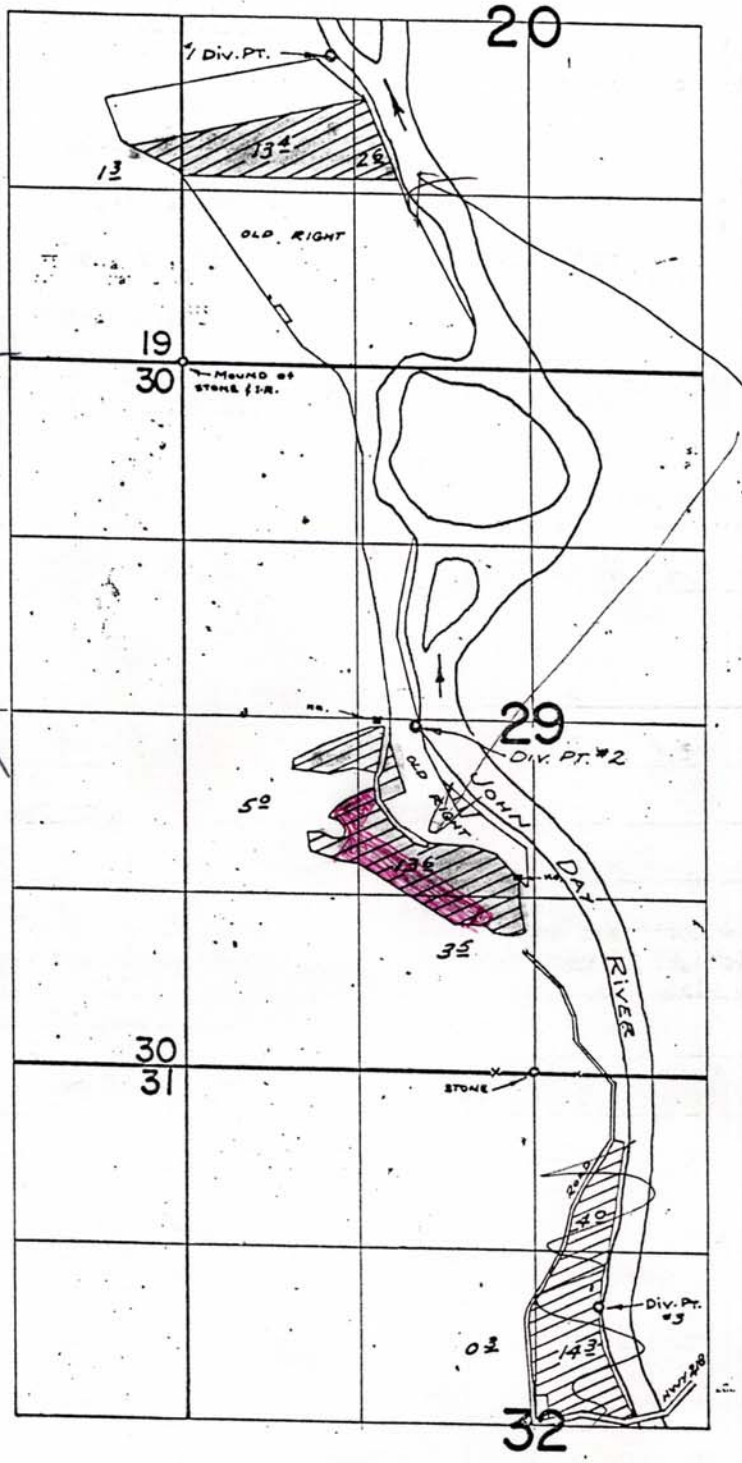

FINAL PROOF SURVEY

UNDER

Application No. 33448 Permit No. 26435

IN NAME OF

FRANK T. & EDNA JUNE THOMPSON