


T. 22S., R. 8W., W.M.

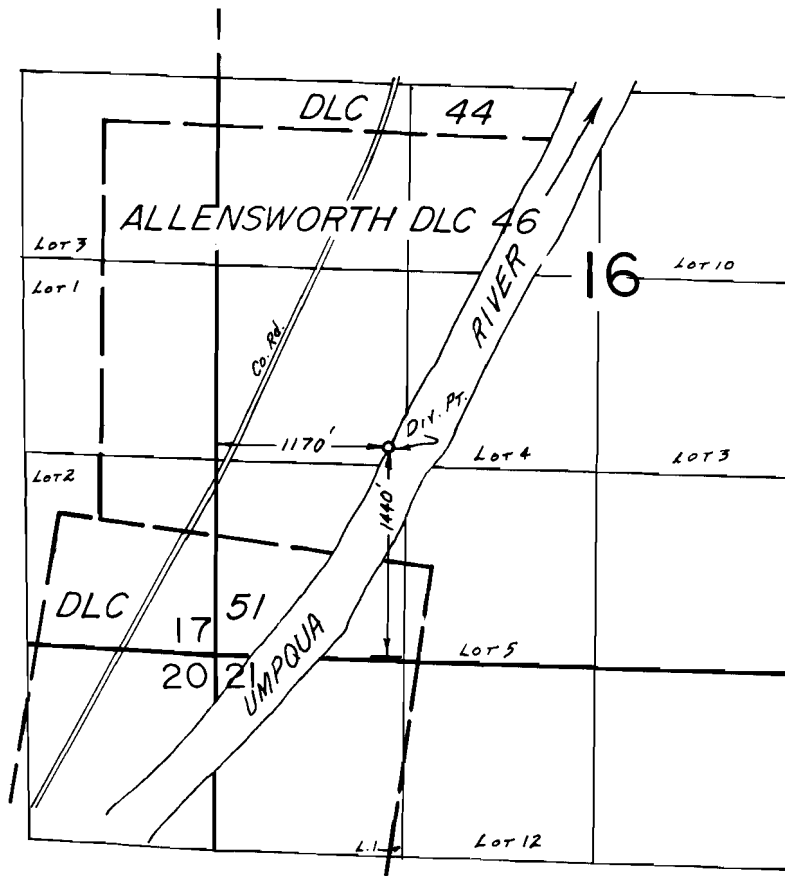

FINAL PROOF SURVEY
UNDER

Transfer No. 3813
Application No. Permit No.
IN NAME OF

.....**GEORGE E. & FRANCES G. FENN**.....

Surveyed JULY 28, 1980., by J.S. DONALDSON