


MAP TO ACCOMPANY APPLICATION TO TRANSFER WATER RIGHTS

JAMES R. STEWART
HC 60 BOX 1800
LAKEVIEW, OREGON 97630
(503) 947-2722

NE1/4 SECTION 32, TOWNSHIP 39 SOUTH, RANGE 19 EAST, W.M.

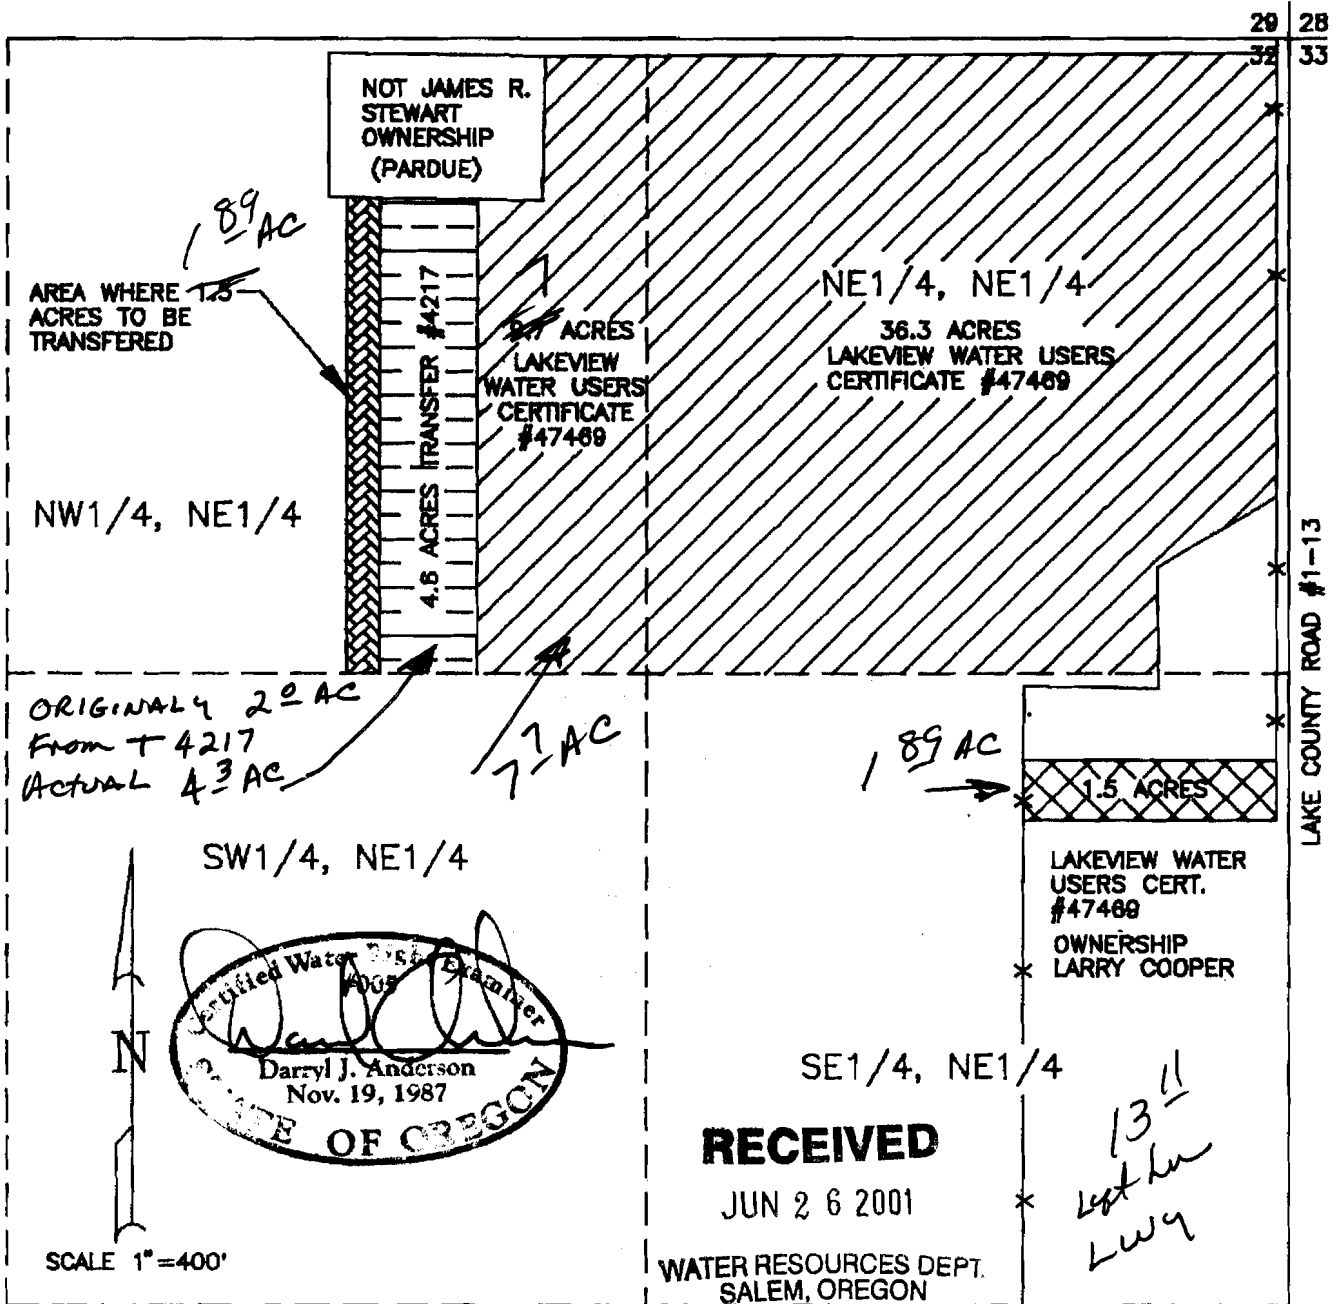

NOTE: JAMES R. STEWART BOUGHT 1.5 ACRES OF WATER RIGHTS FROM LAKEVIEW WATER USERS CERTIFICATE #47469 IN THE SE1/4 OF THE NE1/4 OF SECTION 32 AND IS TRANSFERRING THE 1.5 ACRES TO THE NW1/4 OF THE NE1/4 OF SECTION 32.

PREPARATION OF THIS MAP IS FOR IDENTIFYING PROPOSED WATER RIGHTS ONLY. IT HAS NO INTENT TO PROVIDE LOCATIONS OR DIMENSIONS OF PROPERTY BOUNDARIES.

PREPARED BY:
ANDERSON ENGINEERING
HC 64 BOX 24 - HWY. 395
LAKEVIEW, OREGON 97630
(503) 947-4407
MAY 13, 1994

13 1/2
LWY

T-7182

RECEIVED


SEP 27 2000

WATER RESOURCES DEPT.
SALEM, OREGON

FINAL PROOF SURVEY
TRANSFER T-7182
JAMES R. STEWART
HC 60 BOX 1800
LAKEVIEW, OREGON 97630
(541) 947-2722

NE1/4 SECTION 32, TOWNSHIP 39 SOUTH, RANGE 19 EAST, W.M.

29 | 28
32 | 33

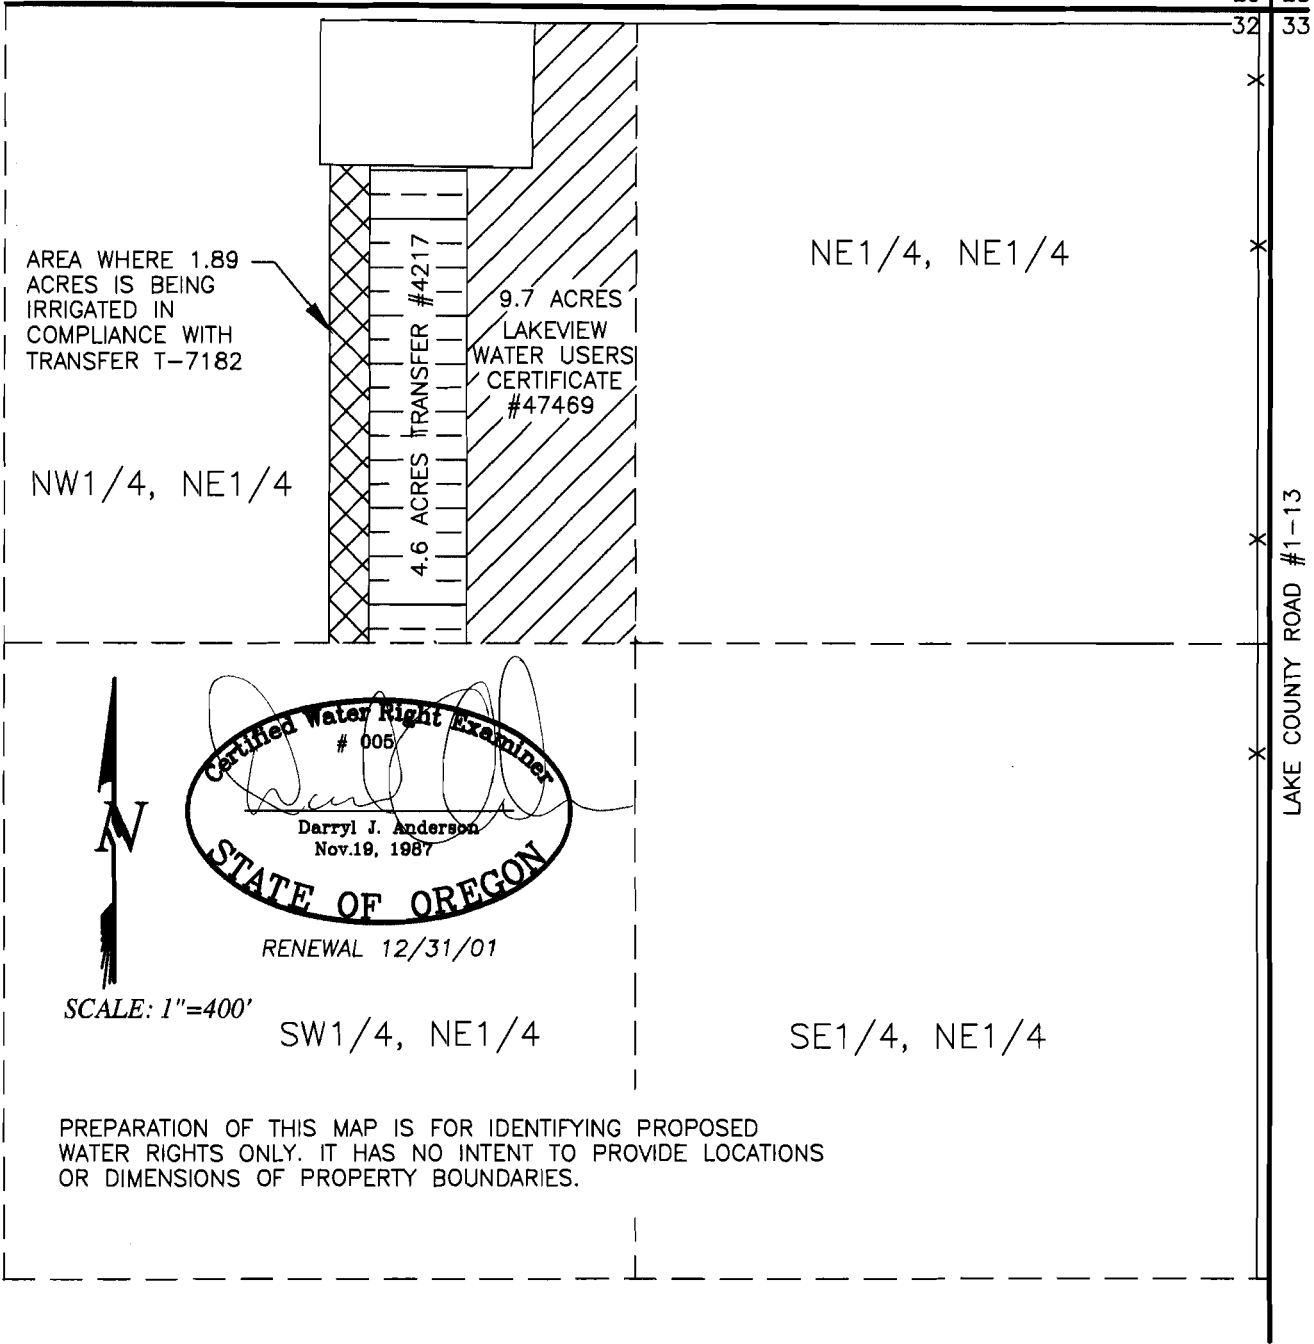

Certified Water Right Examiner
005
Darryl J. Anderson
Darryl J. Anderson
Nov.19, 1987
STATE OF OREGON
RENEWAL 12/31/01

PREPARATION OF THIS MAP IS FOR IDENTIFYING PROPOSED WATER RIGHTS ONLY. IT HAS NO INTENT TO PROVIDE LOCATIONS OR DIMENSIONS OF PROPERTY BOUNDARIES.

DATE: 9/18/2000
SCALE: 1"=400'
JOB: 94025
DWG. BY: M.J.B.
FILE: 94025FP
SHEET 1 OF 1

JAMES R. STEWART
HC 60 BOX 1800
LAKEVIEW, OREGON 97630
(541) 947-2722

**ANDERSON ENGINEERING
AND SURVEYING, INC.**
P.O. BOX 28 LAKEVIEW, OREGON 97630 (541) 947-4407 FAX 947-2321
P.O. BOX 419 REDMOND, OREGON 97756 (541) 923-4307 FAX 923-4308