FINAL PROOF SURVEY
FOR TRANSFER OF WATER RIGHTS
TRANSFER NO. T-6499

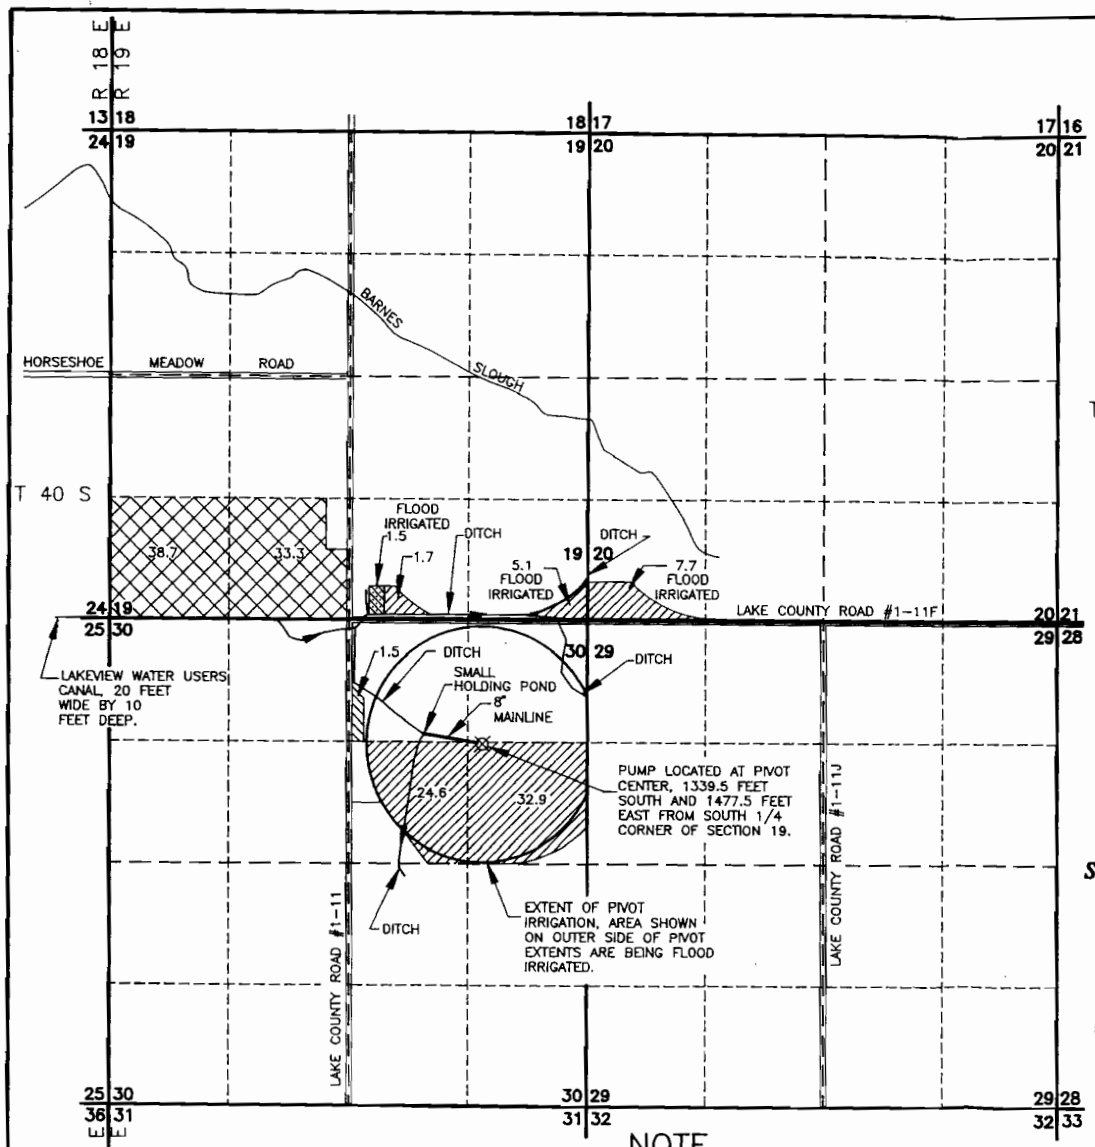

NOTE

SEE SITE REPORT FOR A MORE DETAILED DESCRIPTION OF THE IRRIGATION SYSTEM FOR THIS FINAL PROOF MAP.

LEGEND

- SECTION LINE
- 1/4 SECTION LINE
- 1/16 SECTION LINE
- EXISTING IRRIGATION DITCHES. WITH FLOW DIRECTION AS INDICATED. LAKEVIEW WATER USERS DITCH SYSTEM.
- PIVOT CENTER.

N

SCALE: 1"=1320'

CROSS HATCH DETAIL

FROM

- 70.0 ACRES UNDER EXISTING LAKEVIEW WATER USERS CERTIFICATE #47469.
- 1.5 ACRES UNDER EXISTING LAKEVIEW WATER USERS CERTIFICATE #47469.

TO

- AREA WHERE 70.0 ACRES TRANSFERRED TO.
- AREA WHERE 1.5 ACRES TRANSFERRED TO.

Certified Water Right Examiner # 005
Darryl J. Anderson
Nov.19, 1987
STATE OF OREGON
RENEWAL 12/31/99

NOTE: PREPARATION OF THIS MAP IS FOR IDENTIFYING PROPOSED WATER RIGHTS ONLY. IT HAS NO INTENT TO PROVIDE LOCATIONS OR DIMENSIONS OF PROPERTY BOUNDARIES.

REVISION	BY

ANDERSON ENGINEERING AND SURVEYING, INC.
P.O. BOX 28
LAKEVIEW, OREGON 97630
(541) 947-4407
FAX 947-2321
P.O. BOX 419
REDMOND, OREGON 97756
(541) 923-4307
FAX 923-4308

PREPARED FOR:
OTIS MOBLEY
HC 60 BOX 3250
LAKEVIEW, OR 97630

DATE: 7/13/98
SCALE: 1"=1320'
JOB: 98031
DWG. BY: R.F.C.
FILE: 9831TRAN
SHEET 1 OF 1