


T-4644

RECEIVED
NOV 20 1980
WATER RESOURCES DEPT
SALEM, OREGON

RECEIVED
NOV 13 1980
WATER RESOURCES DEPT
SALEM, OREGON


T 39 S, R 19 E, W.M.

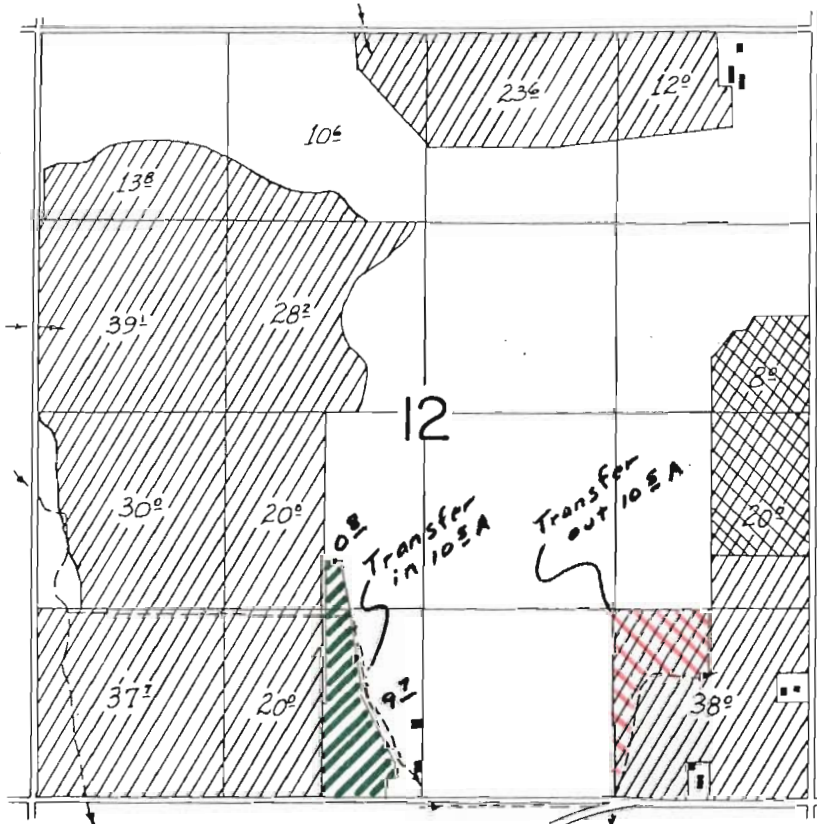

T-4644

RECEIVED
NOV 20 1980
WATER RESOURCES DEPT
SALEM, OREGON

T 39 S, R 19 E, W. 11.

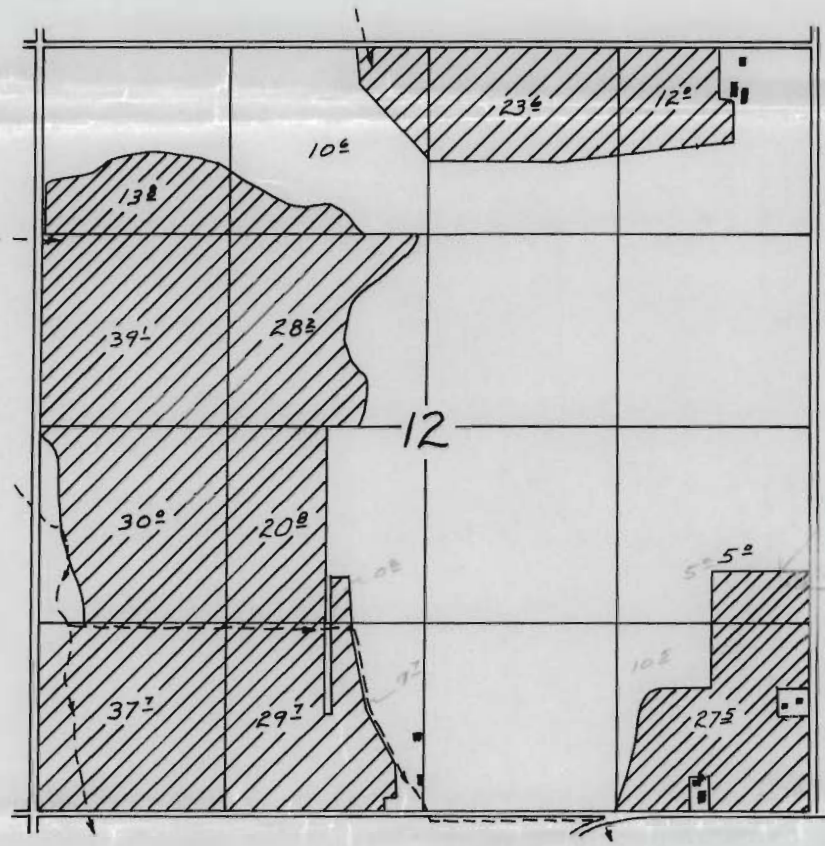

RECEIVED
NOV 13 1980
WATER RESOURCES DEPT
SALEM, OREGON