


RECORDED
OF A
STATE RE. & DEPT
SALEM, OREGON

1-4296

T 40 S, R 19 E, W.M.

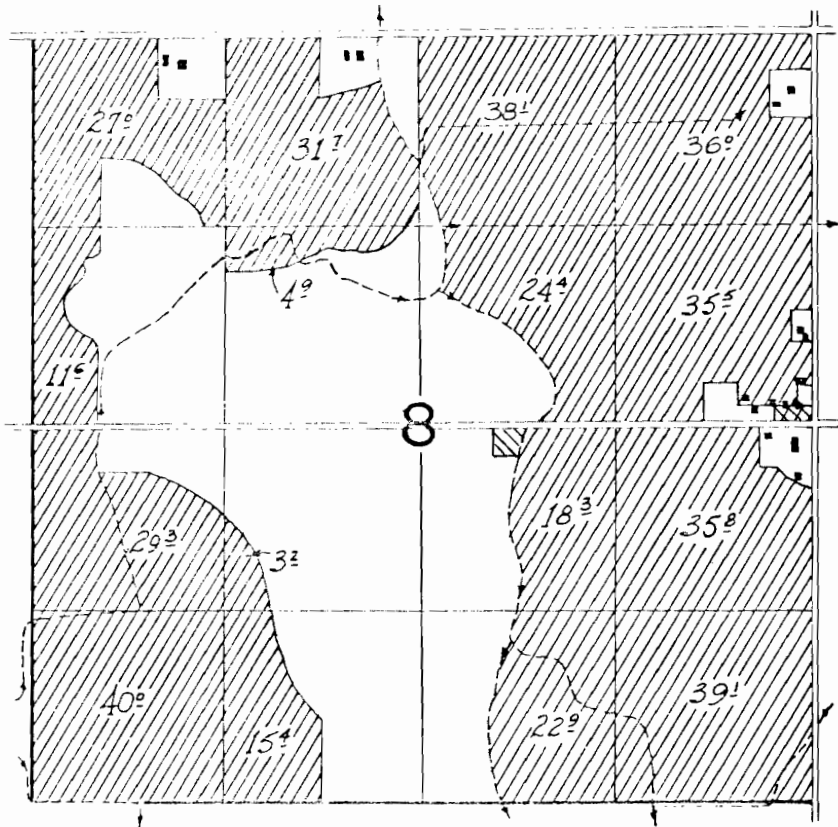

XXXX Transfer from SE¹/₄ NE¹/₄ to NW¹/₄ SE¹/₄
//// Transfer to NW¹/₄ SE¹/₄ from SE¹/₄ NE¹/₄