


35 36 R19E T38S  
 2 1 T39S

NW 1/4, NW 1/4

SW 1/4, NW 1/4

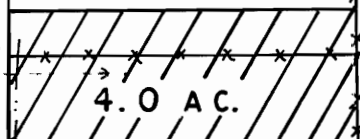

4.0 AC.

FENCE LINE

IRR. DITCH

DIV. POINT 2642'S. & 49'E  
 OF NW COR. SEC. 1

POINT OF DIVERSION FROM  
 WATER USERS SUPPLY DITCH

FLOOD IRRIGATION  
 DIRECTION

COUNTY ROAD

LAKE VIEW  
 WATER USERS  
 SUPPLY DITCH

WATER IRRIGATION IS  
 FOR PASTURE LAND.

FINAL PROOF SURVEY  
 UNDER  
 TRANSFER NO. T-6071  
 IN THE NAME OF  
 GEORGE JASKA

MAY 27, 1989



1" = 400'


IRRIGATION WATER SUPPLIED BY LAKEVIEW WATER USERS WHICH DIVERTS WATER FROM DREWS RESERVOIR AND COTTONWOOD RESERVOIR UNDER CERTIFICATE NO. 47468

POINTS OF DIVERSION LOCATION: DREWS - SW 1/4, SE 1/4, SECTION 5, TOWNSHIP 40 SOUTH, RANGE 18 EAST - CERTIFICATE NO. 47468.

COTTONWOOD - NW 1/4, SW 1/4, SECTION 29, TOWNSHIP 38 SOUTH, RANGE 19 EAST - CERTIFICATE NO. 47468.

ALSO SEE ENLARGEMENT PERMIT - R 7802 - FOR COTTONWOOD RESERVOIR.

SURVEYED BY: ANDERSON ENGINEERING & SURVEYING  
 618 SOUTH 1ST STREET  
 P.O. BOX 28  
 LAKEVIEW, OREGON 97630

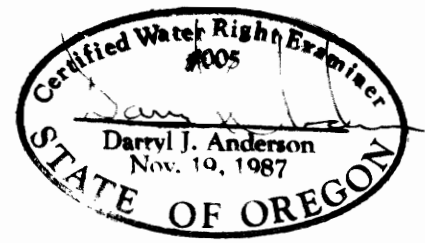

ABRAMSON-JASKA - TRANSFER  
 IN CONJUNCTION WITH  
 LAKEVIEW WATER USERS INC.

RANGE 19 E

RANGE 20 E

SHEET 1 OF 2

TOWNSHIP 38 S

TOWNSHIP 39 S

T-607

COUNTY ROAD 2-19

AREA WATER RIGHT IS  
 PROPOSED TO BE TRANSFERRED TO-  
 PROPOSED AREA IS 4 ACRES  
 APPROXIMATE DIMENSIONS 630' X 277'  
 LOCATED IN THE S<sup>1</sup>/<sub>2</sub>, NW<sup>1</sup>/<sub>4</sub>, SW<sup>1</sup>/<sub>4</sub>, NW<sup>1</sup>/<sub>4</sub>

SECTION 1

NORTH

SCALE 1" = 1320'

*Daniel L. Ch...*

NOTES:

1. MAP TO ACCOMPANY WATER RIGHT TRANSFER APPLICATION
2. TRANSFER OF 4 ACRES FROM ABRAMSON TO JASKA.
3. PROPOSED USE OF WATER IS IRRIGATION.
4. WATER IS DIVERTED AT DREWS AND COTTONWOOD RESERVOIRS AND TRANSPORTED TO THE AREA VIA THE NORTH CANAL, AS OPERATED BY THE LAKEVIEW WATER USERS INC.
5. WATER IS UNDER CONTROL OF THE LAKEVIEW WATER USERS INC. - SEE WATER RIGHT CERTIFICATE 47469.
6. PREPARATION OF THIS MAP IS FOR IDENTIFYING THE LOCATION OF THE PROPOSED WATER RIGHT TRANSFER AND HAS NO INTENT TO PROVIDE DIMENSIONS OR LOCATION OF PROPERTY LINES.

PREPARED BY: ANDERSON ENGINEERING AND SURVEYING  
 P.O. BOX 28 LAKEVIEW, OREGON 97630