

FINAL PROOF SURVEY

FOR ROBERT BOLTON TRANSFER T-7160 PLACE OF USE AND NEW POINT OF DIVERSION
 LOCATED IN SECTION 1 TOWNSHIP 40 SOUTH, RANGE 18 EAST, W.M.
 LAKE COUNTY, OREGON

RECEIVED

SEP 29 2000

WATER RESOURCES DEPT.
 SALEM, OREGON

36 31

CORNER SECTION 1 1
 FOUND A BRASS CAP

6

NEW POINT OF DIVERSION (GATE VALVE)
 LOCATED 234' SOUTH
 AND 10' EAST FROM
 THE NORTHWEST CORNER
 OF SECTION 1.
 AND SITUATED IN THE
 NW1/4 OF THE NW1/4

CORNER SECTION 1
 FOUND A 5/8" IRON ROD

35 36

2 1



SCALE: 1"=400'

FOUND 5/8 IN IRON ROD
 REFERENCING THE NORTH
 1/4 CORNER OF SECTION 1

FOUND 5/8" IRON ROD

20.98 Acres

12.52 Acres

29.3 Acres

NEW POINT OF DIVERSION (GATE VALVE)
 LOCATED 1422' SOUTH
 AND 1855' WEST FROM
 THE NORTHEAST CORNER
 OF SECTION 1.
 AND SITUATED IN THE
 NW1/4 OF THE NE1/4

DITCH

4.9 Acres

0.86 Acres

NEW POINT OF DIVERSION (PUMP)
 LOCATED 944' SOUTH
 AND 710' EAST FROM
 THE NORTHWEST CORNER
 OF SECTION 1.
 AND SITUATED IN THE
 NW1/4 OF THE NW1/4

5.9 Acres

2.1 Acres

13.3 Acres

19.3 Acres

39.1 Acres

12.5 Acres

EAST 1/4 CORNER SECTION 1
 FOUND A BRASS CAP

1

6


LEGEND

- SECTION LINE
- 1/4 SECTION LINE
- 1/16 SECTION LINE
- EXISTING FENCE

- FOUND SURVEY MONUMENT
- IRRIGATED REMAINING
- IRRIGATED TRANSFERED

CENTER 1/4 CORNER SECTION 1
 FOUND A LAKE COUNTY SURVEYOR
 BRASS CAP

NEW POINT OF DIVERSION (PUMP)
 LOCATED 457' NORTH
 AND 1811' WEST FROM
 THE EAST 1/4 CORNER
 OF SECTION 1.
 AND SITUATED IN THE
 SW1/4 OF THE NE1/4

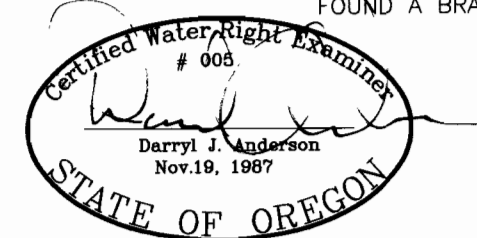

NOTE: PREPARATION OF THIS MAP IS FOR IDENTIFYING PROPOSED
 WATER RIGHTS ONLY. IT HAS NO INTENT TO PROVIDE LOCATIONS
 OR DIMENSIONS OF PROPERTY BOUNDARIES.

NOTE: SEE ACCOMPANYING SITE REPORT.

RENEWAL 12/31/2001

REVISION BY

ANDERSON ENGINEERING
 AND SURVEYING, INC.

P.O. BOX 419
 LAKEVIEW, OREGON 97630
 (541) 947-4407
 FAX 923-4307

P.O. BOX 28
 LAKEVIEW, OREGON 97630
 (541) 947-4407
 FAX 947-2321

PREPARED FOR:
ROBERT C. BOLTON

HC 60 BOX 2390
 LAKEVIEW, OR 97630
 PHONE (541) 947-2552

DATE: SEPT. 15, 2000

SCALE: 1"=400'

JOB: 9420FP

DWG. BY: M.J.B.

FILE: 9420FP

SHEET 1 OF 1